
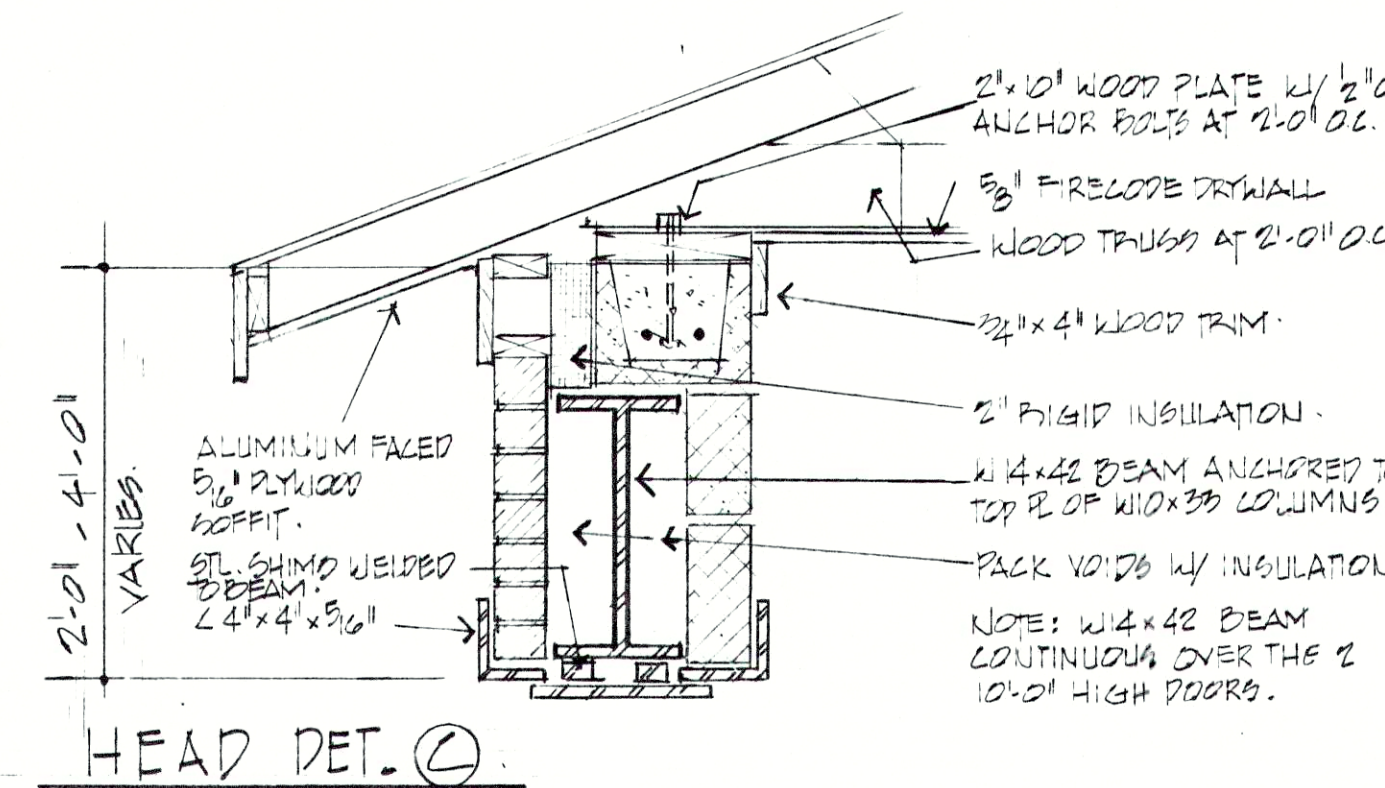
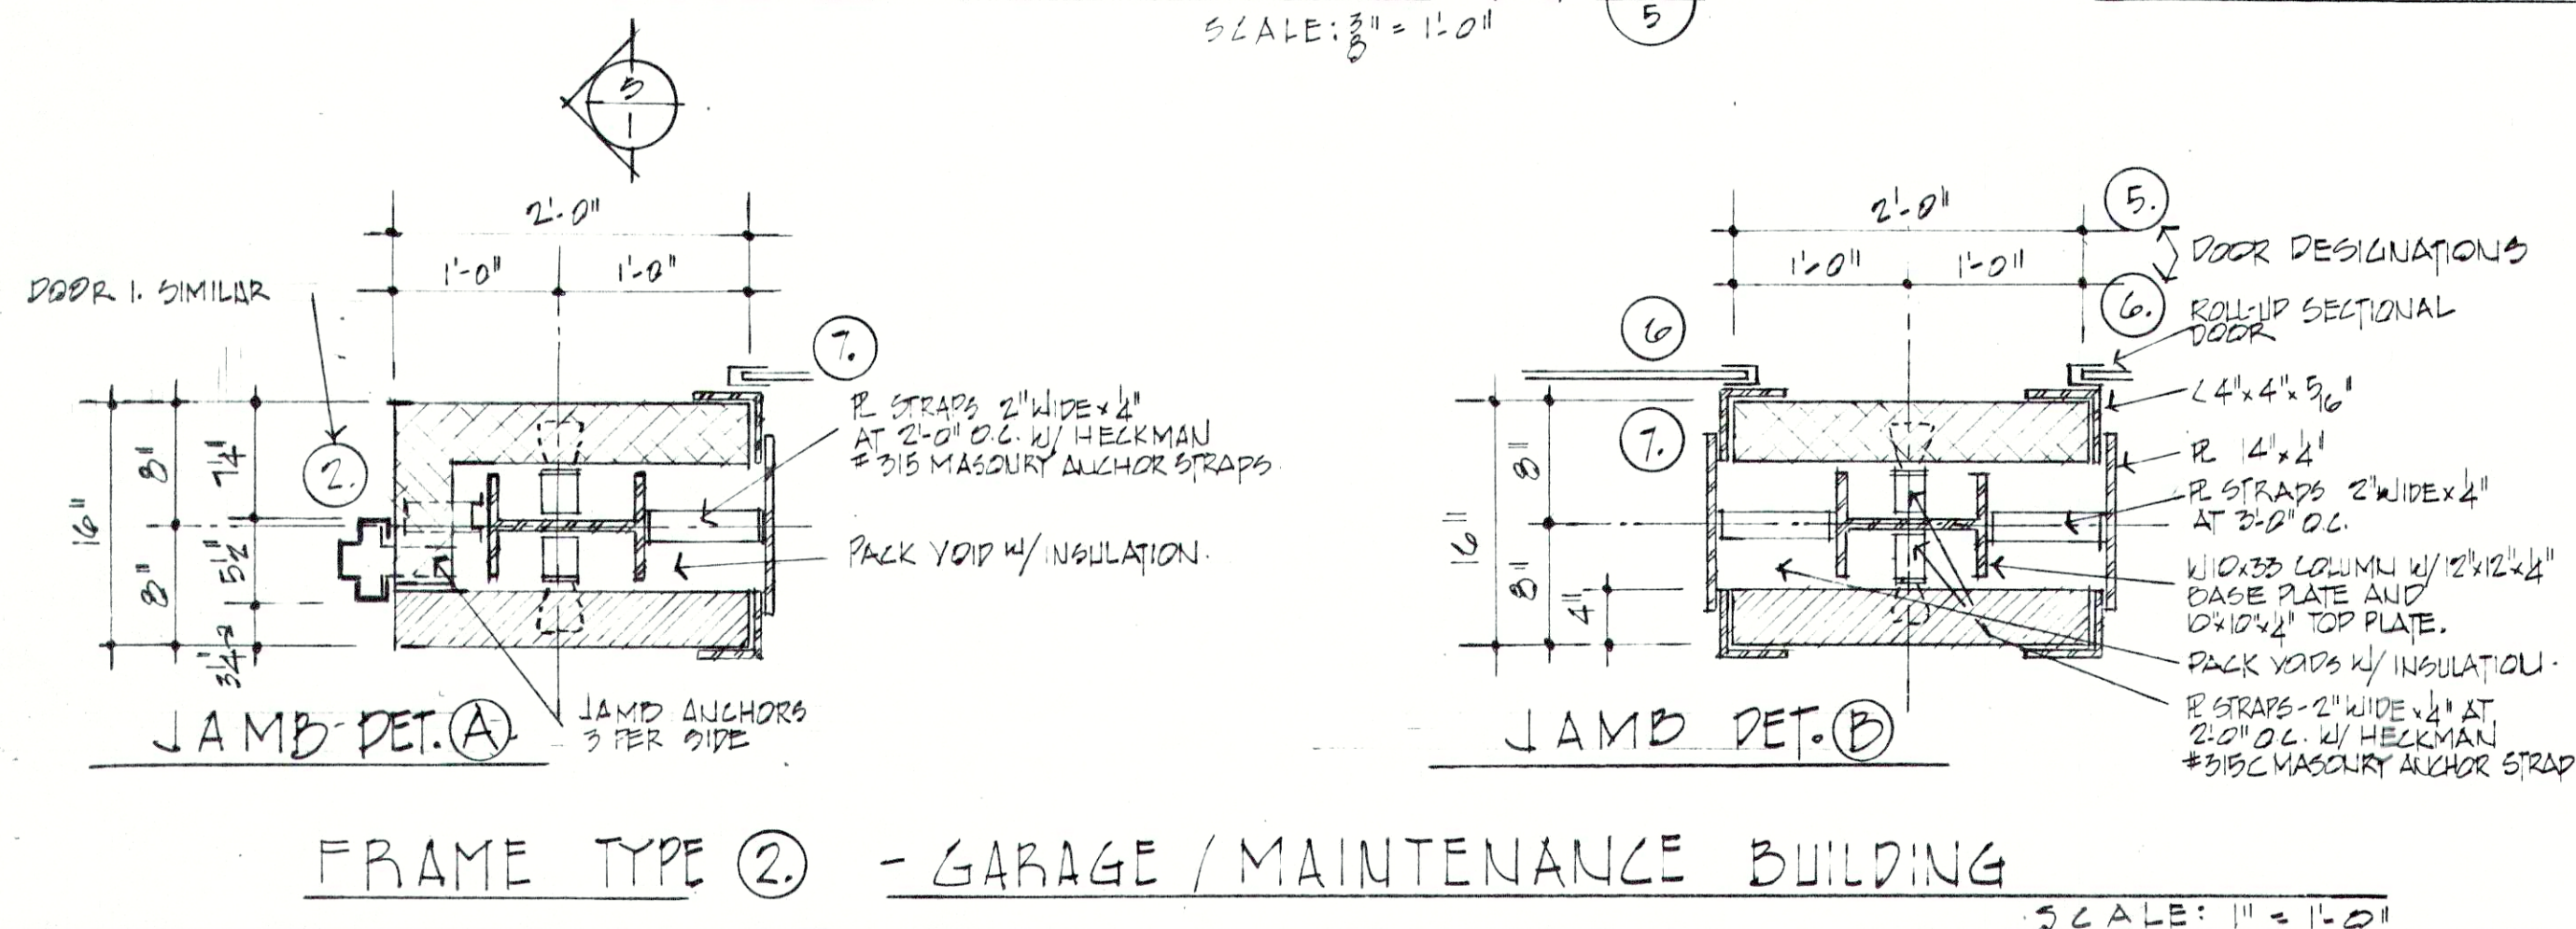
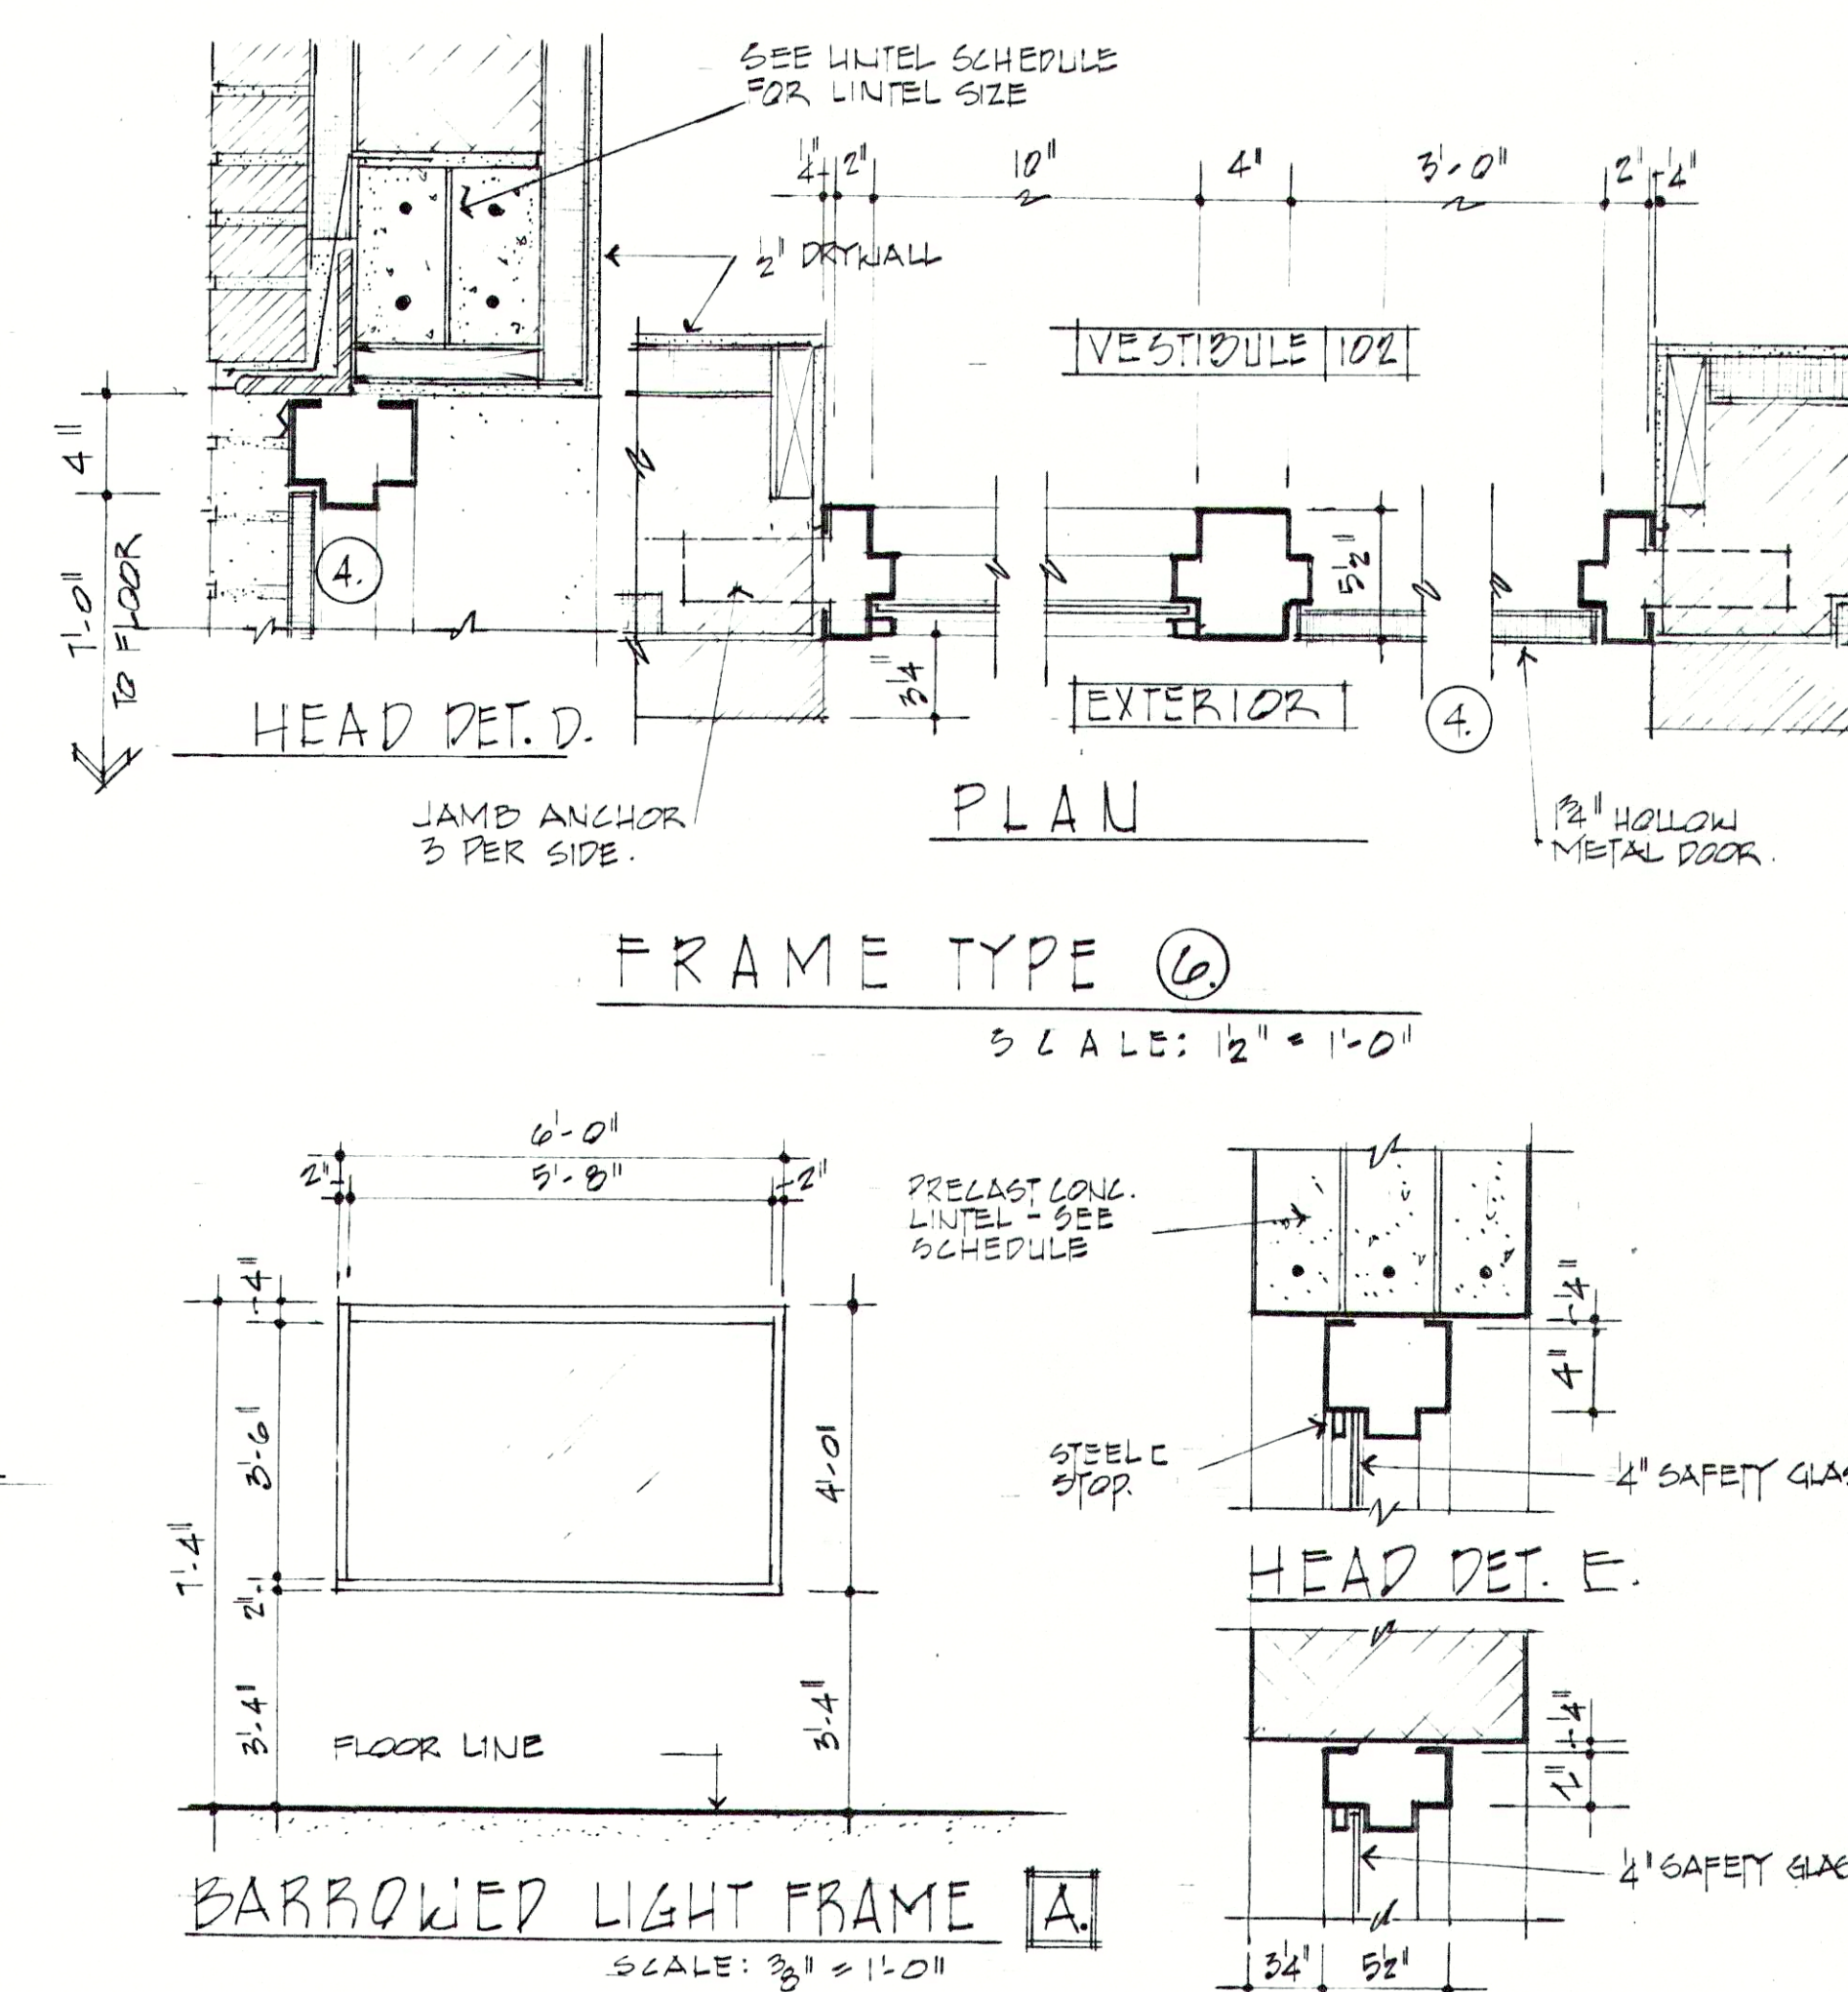
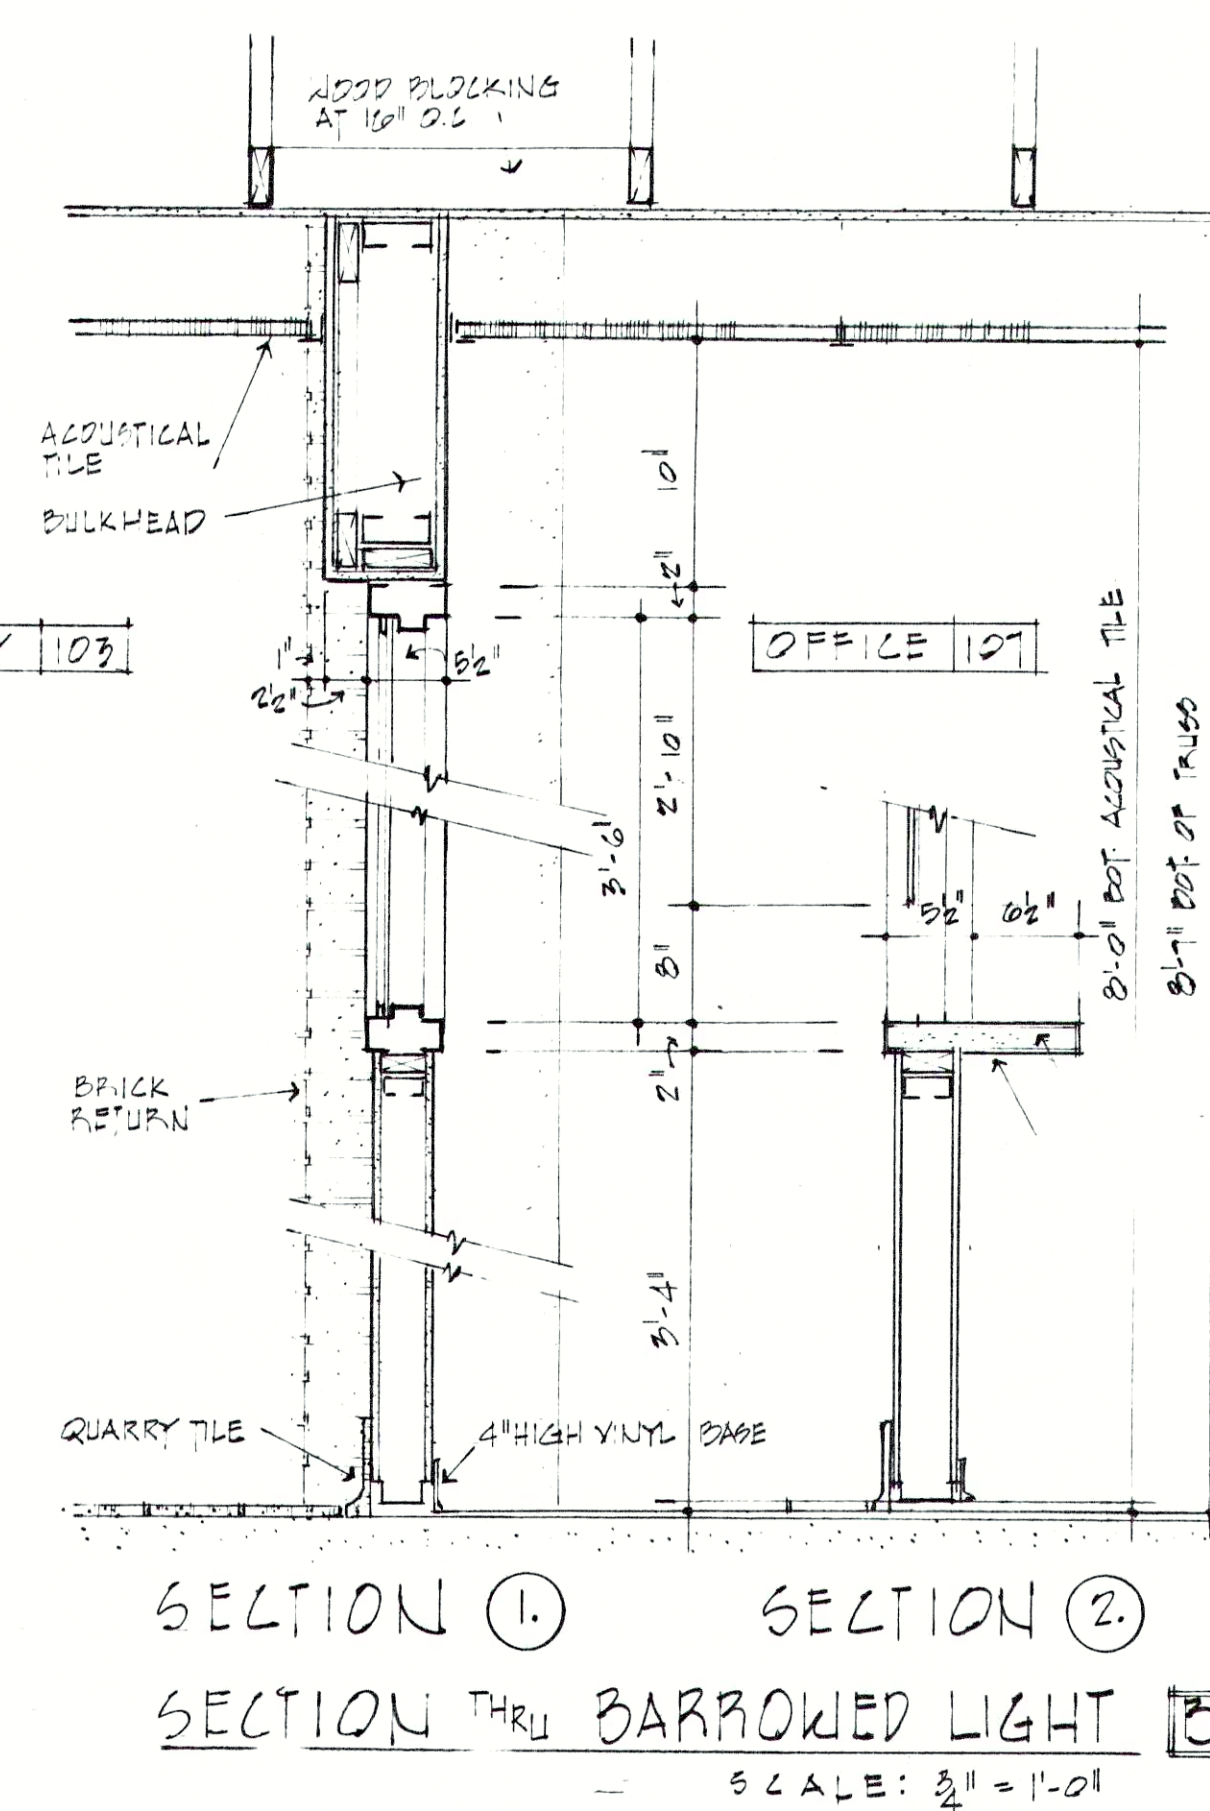
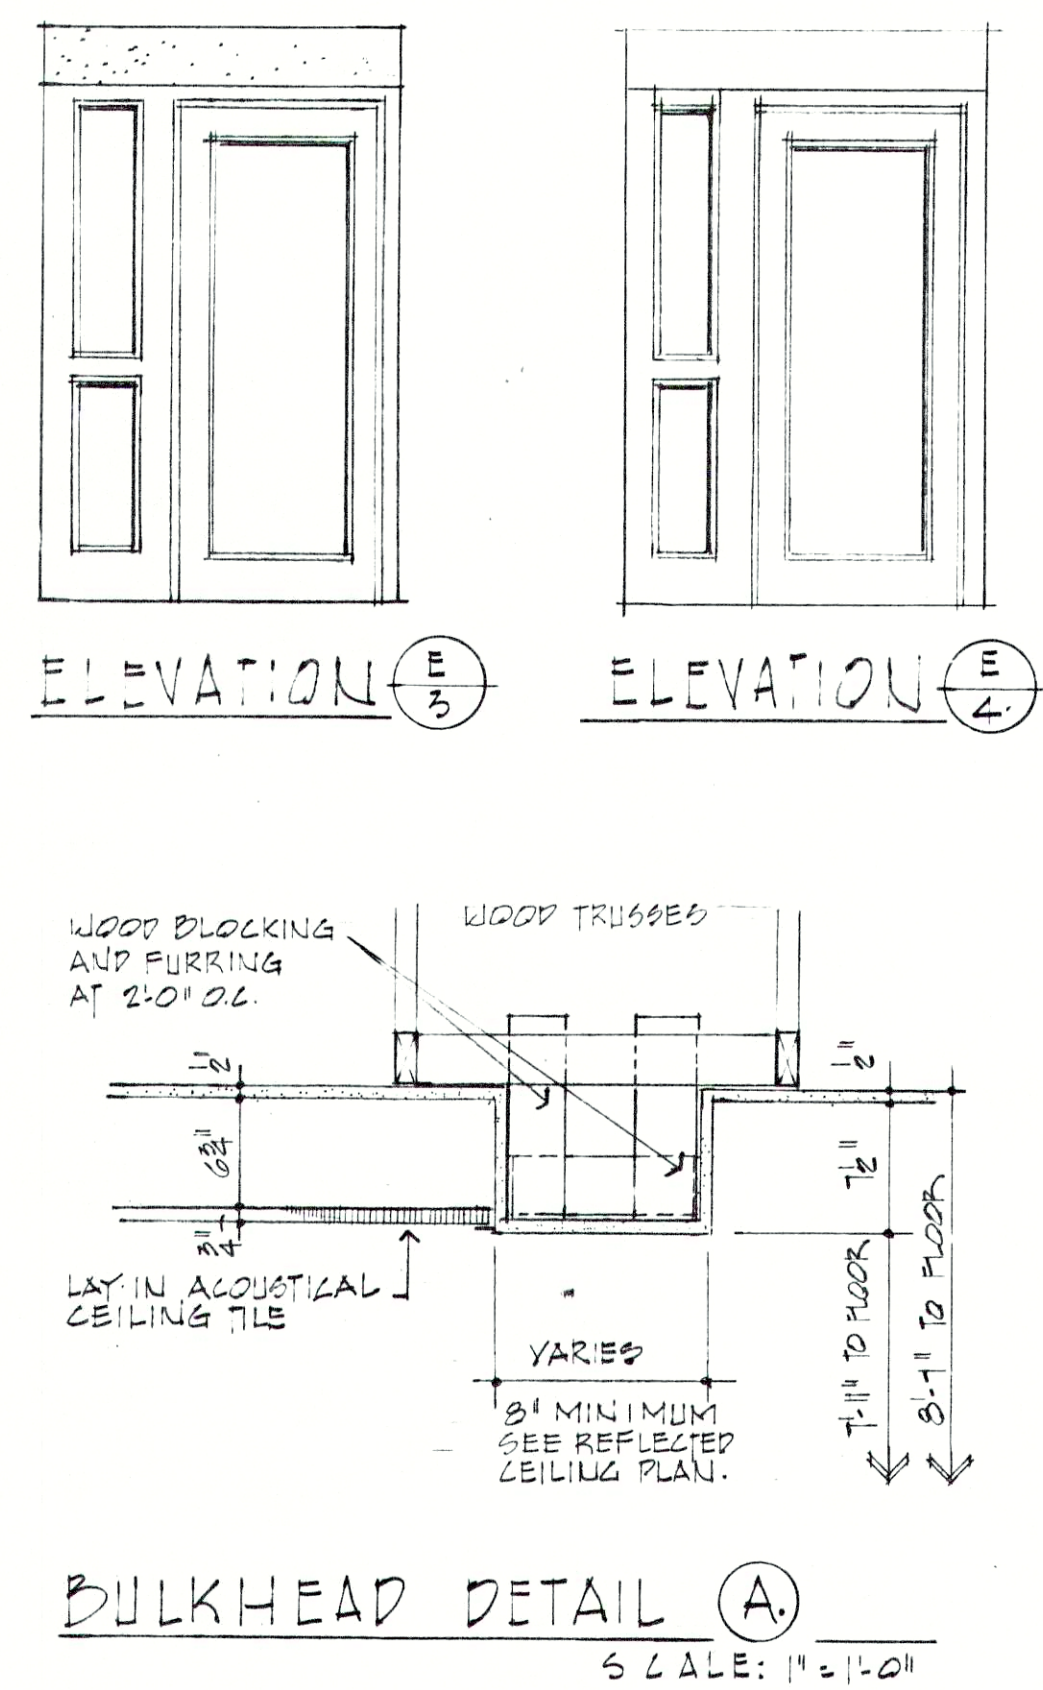
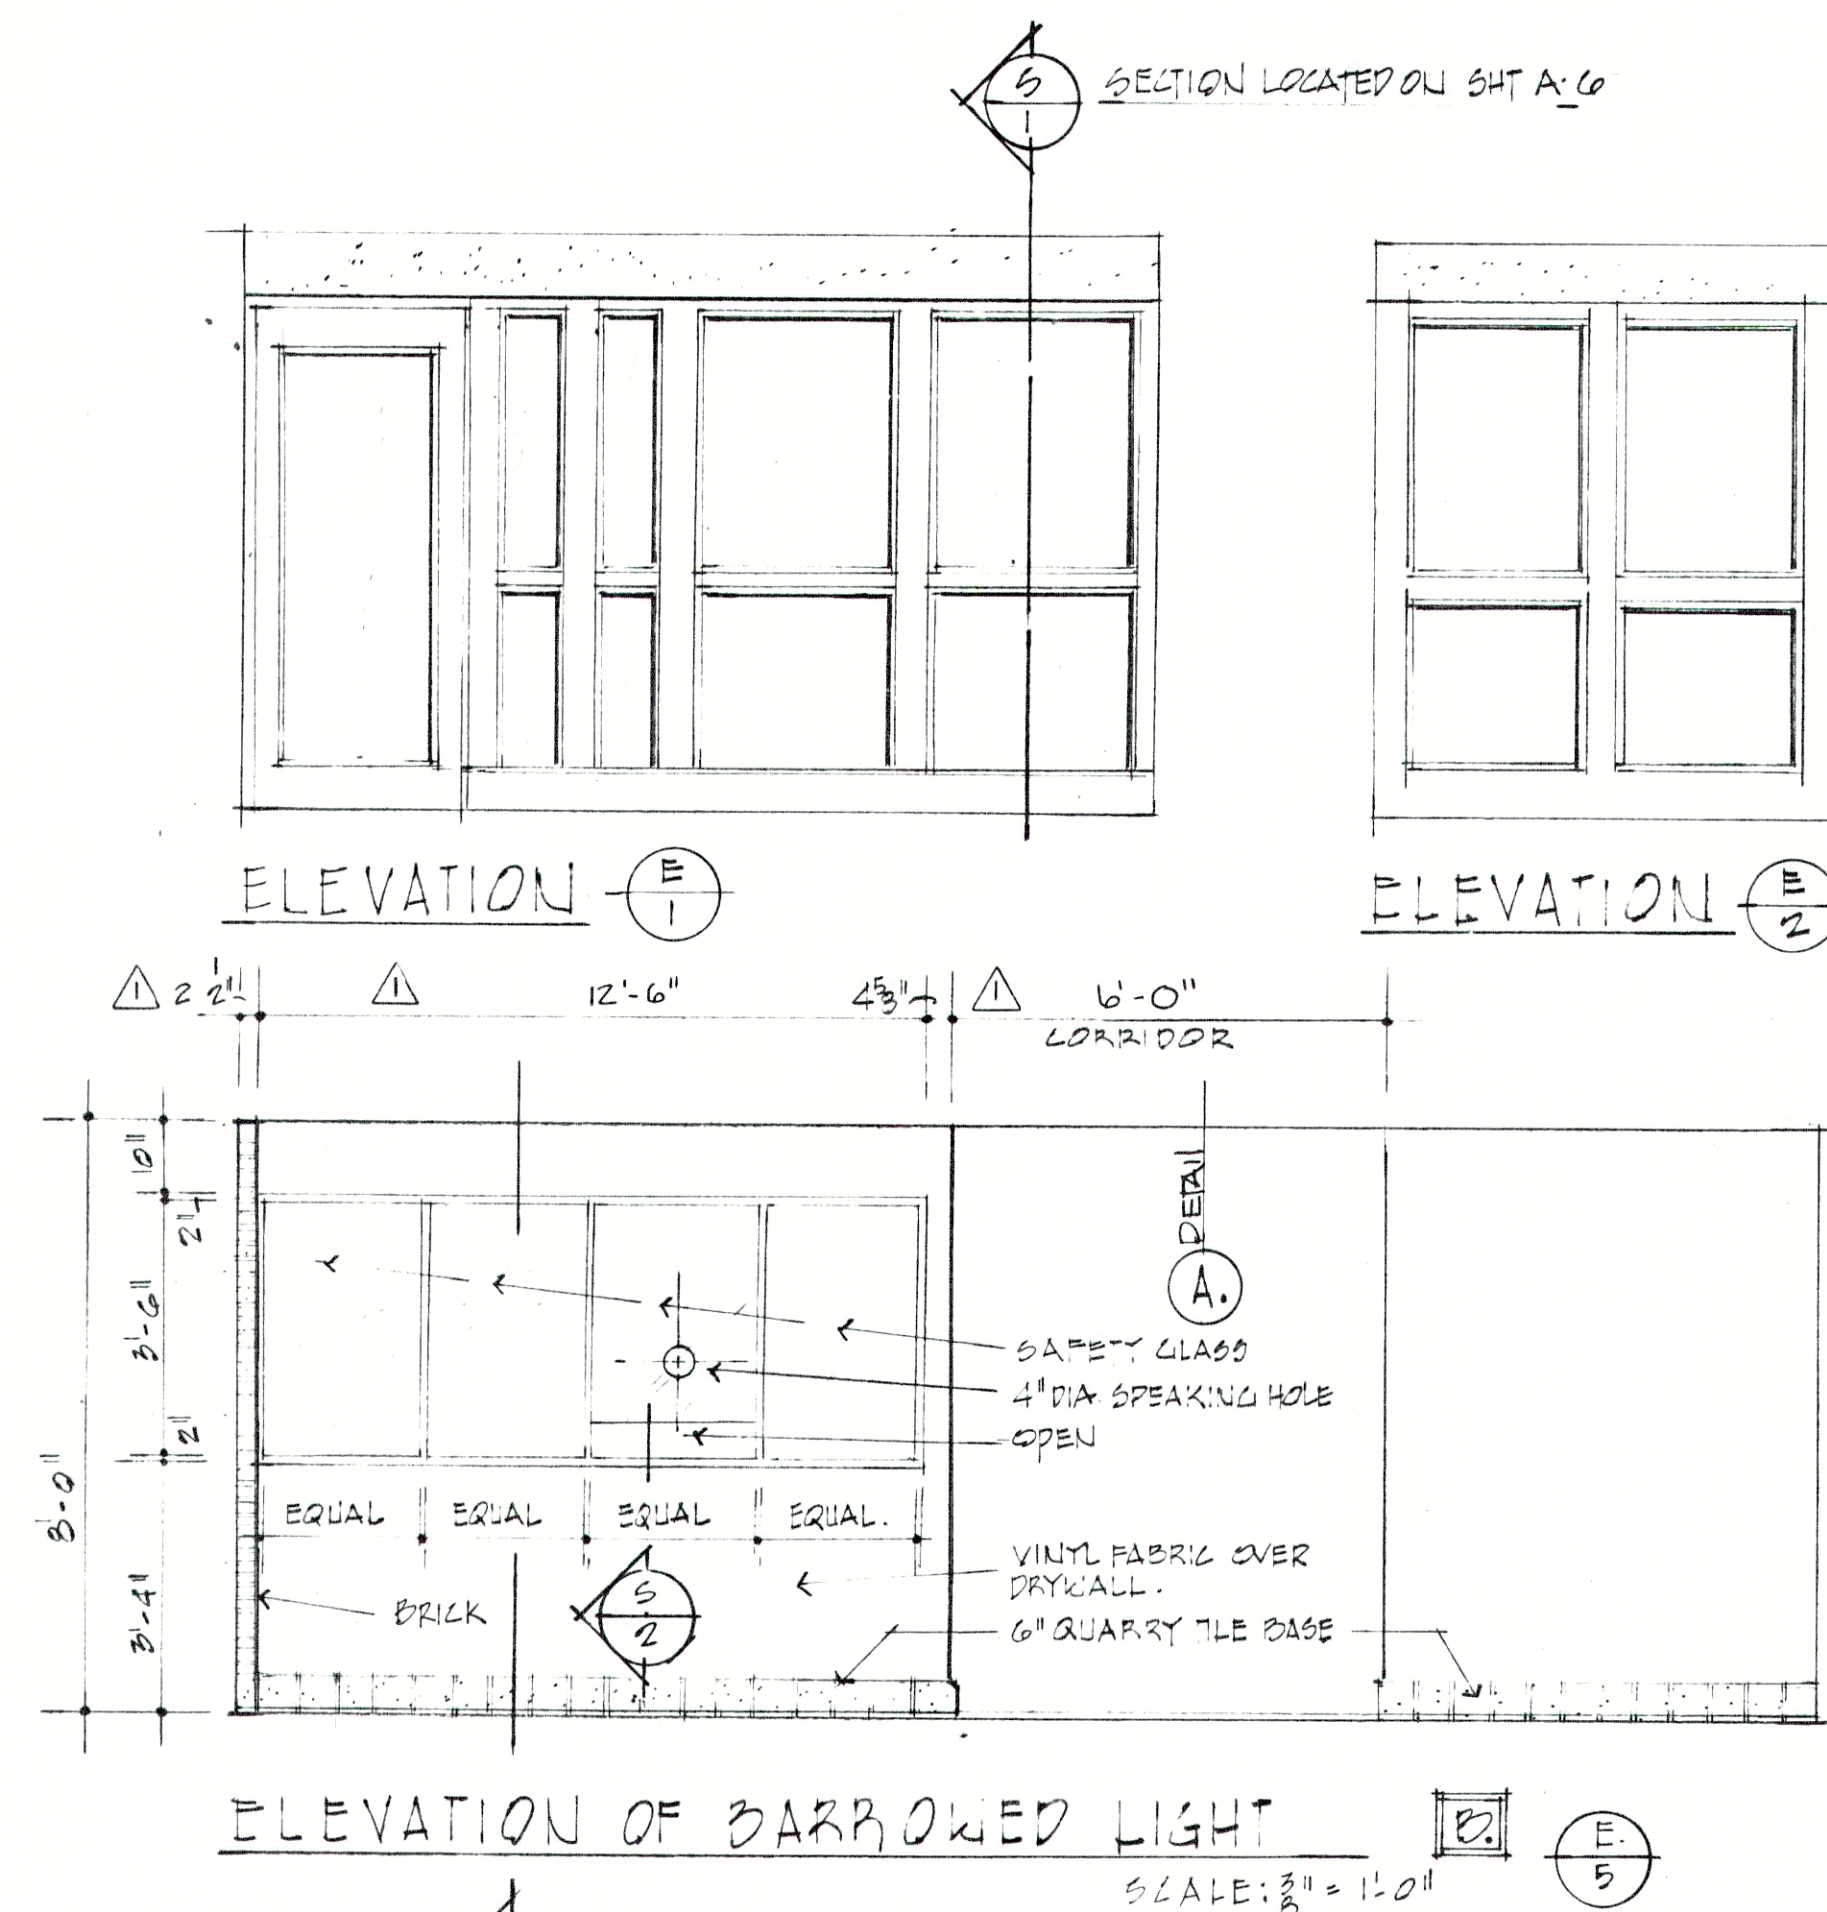
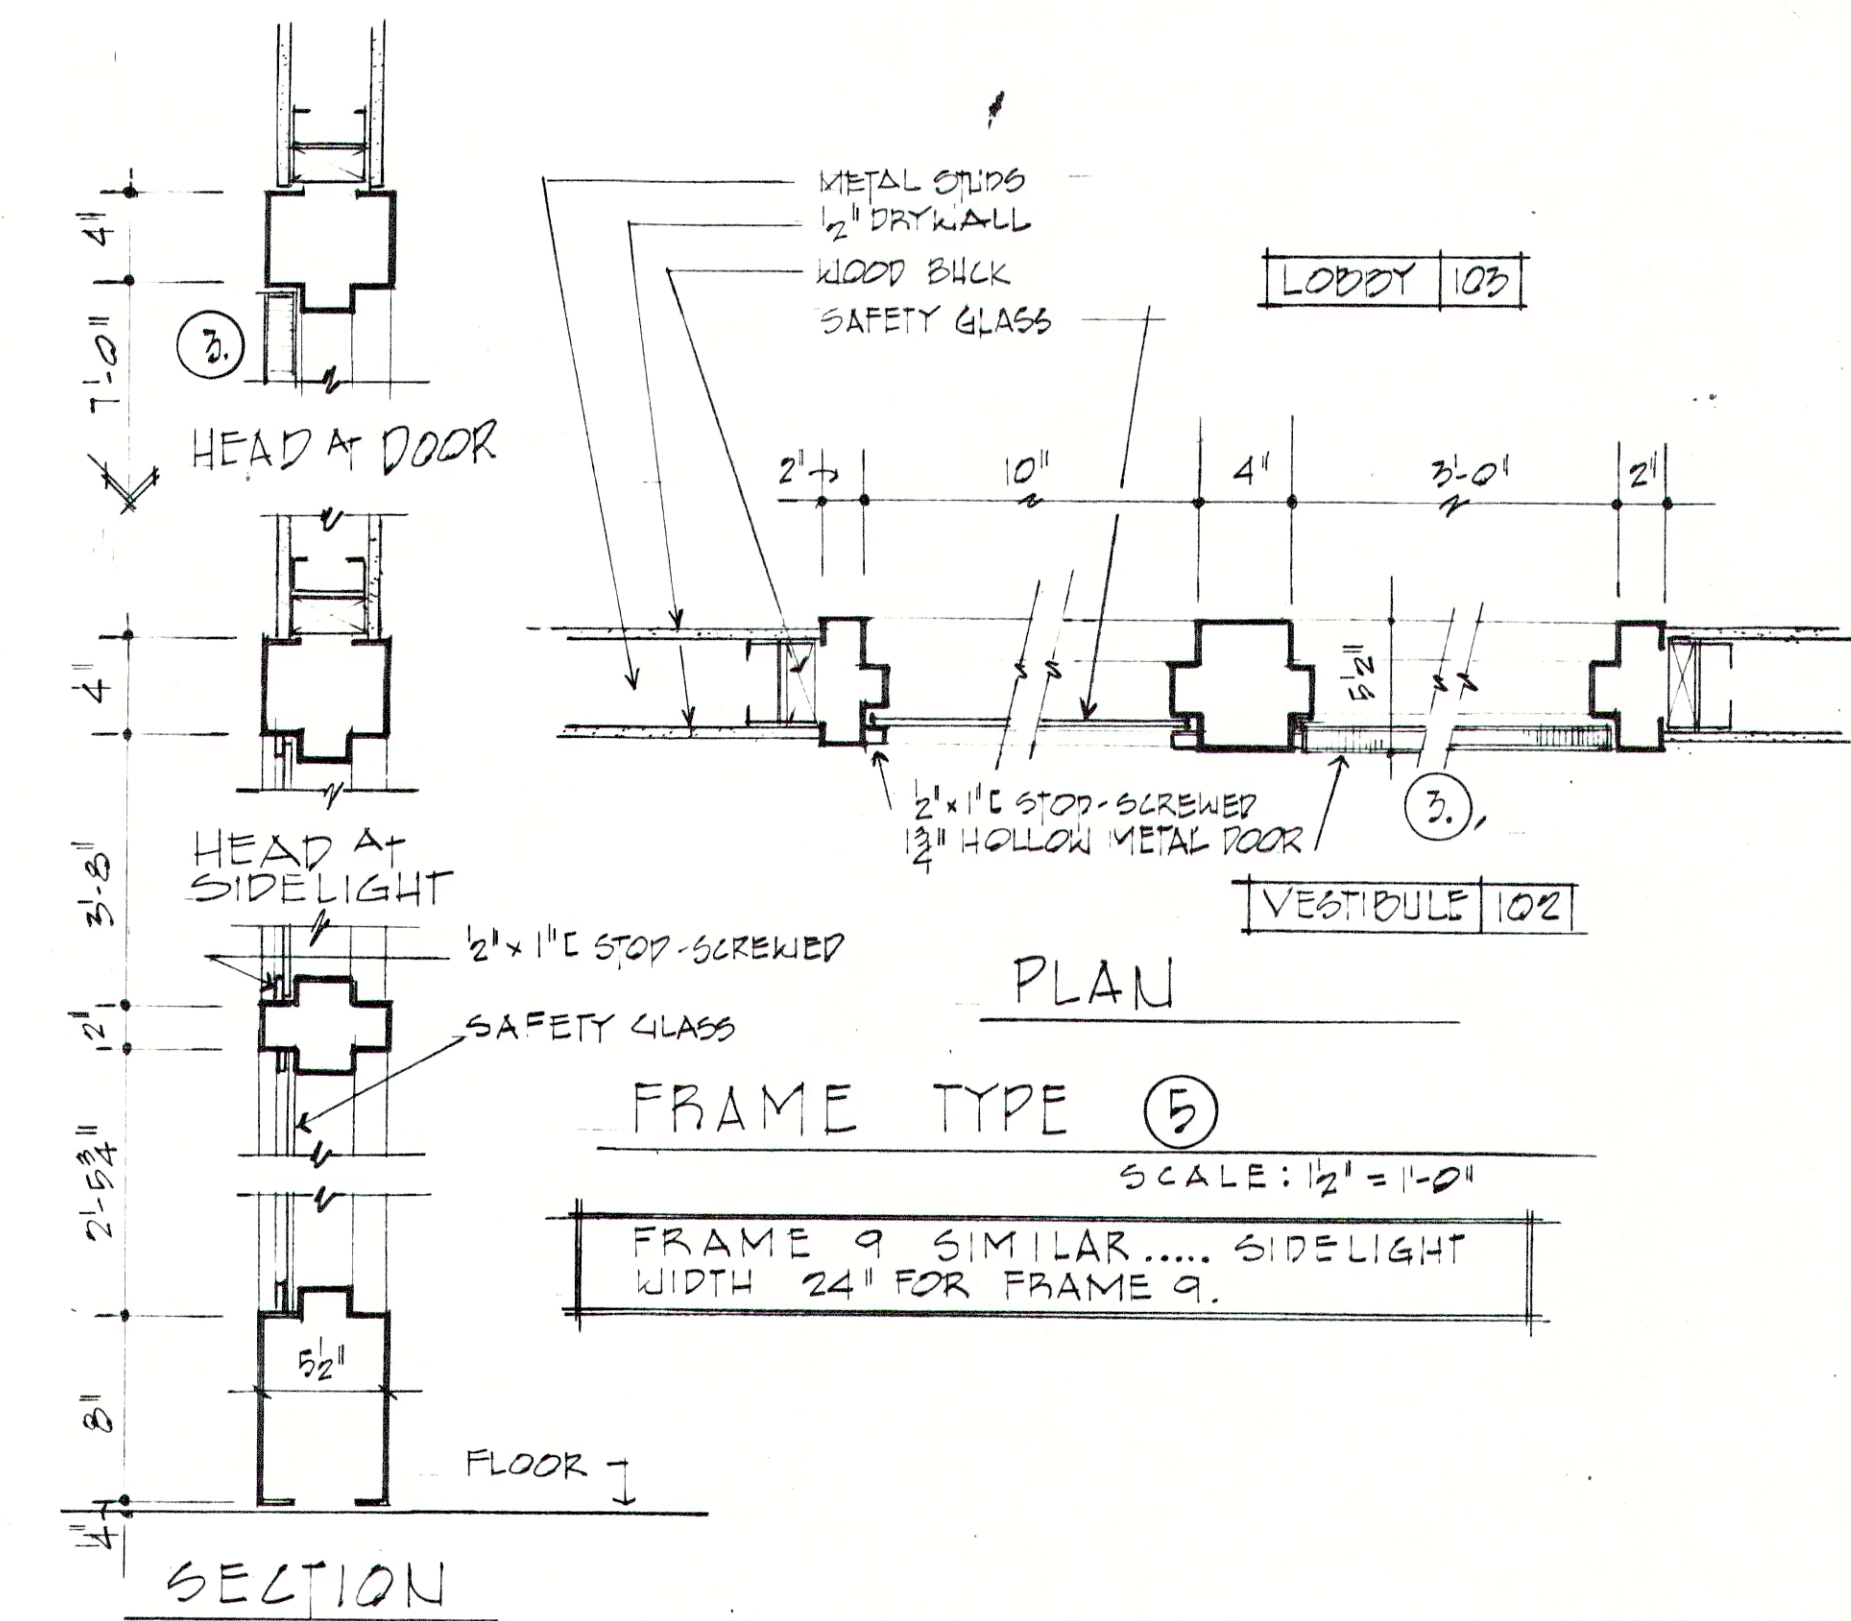
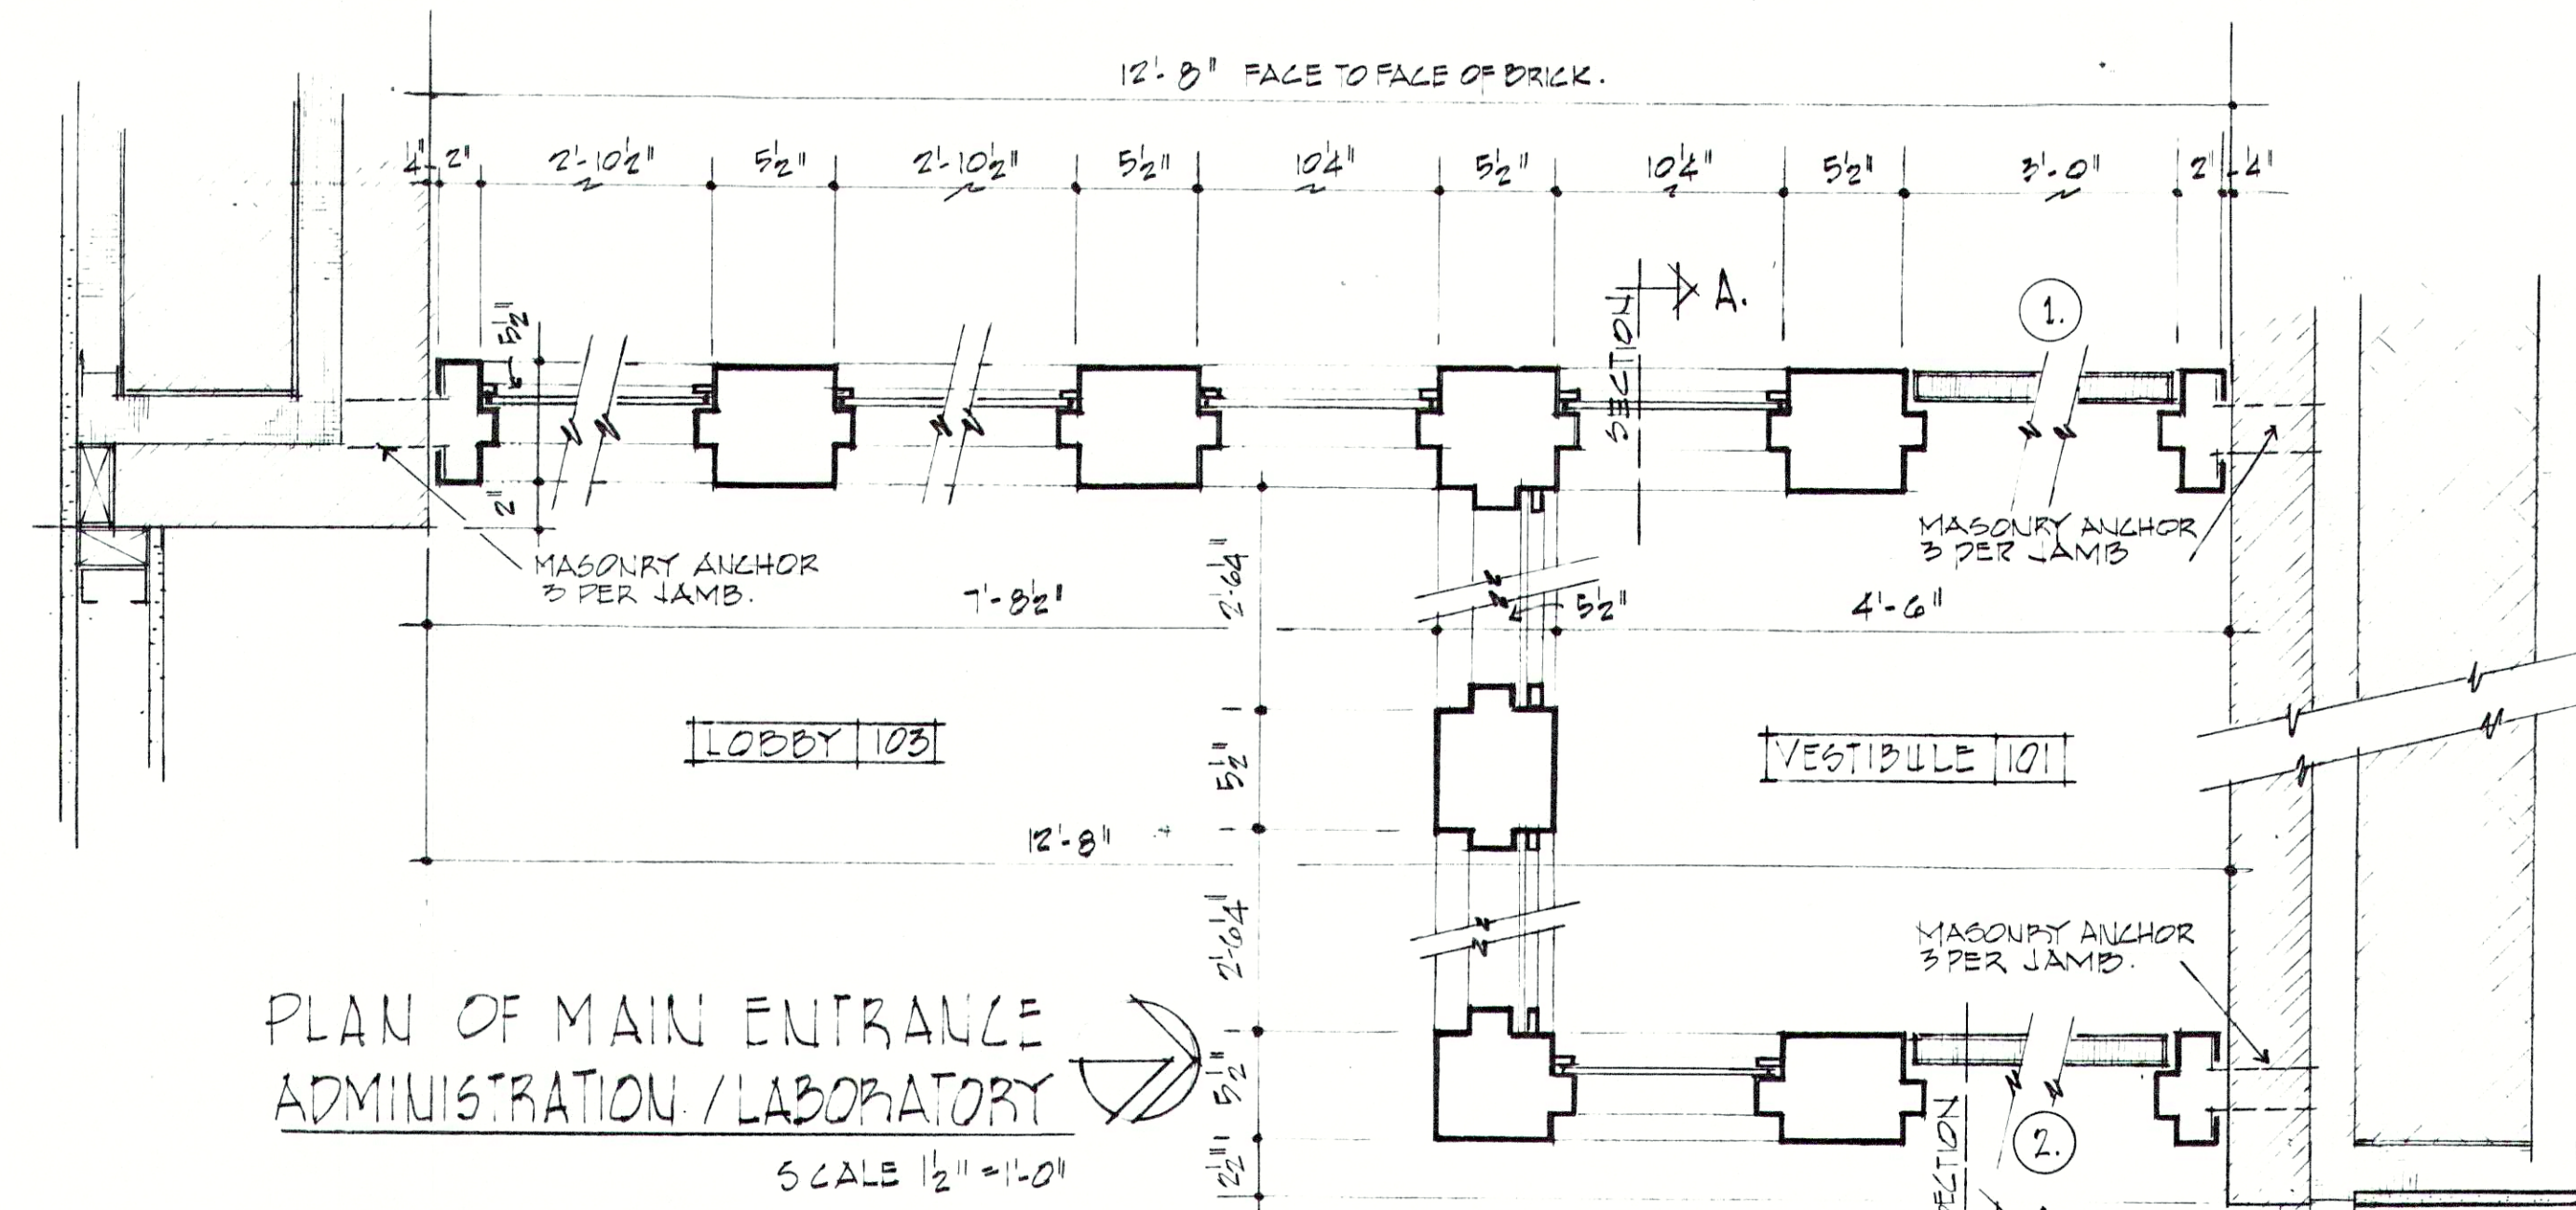


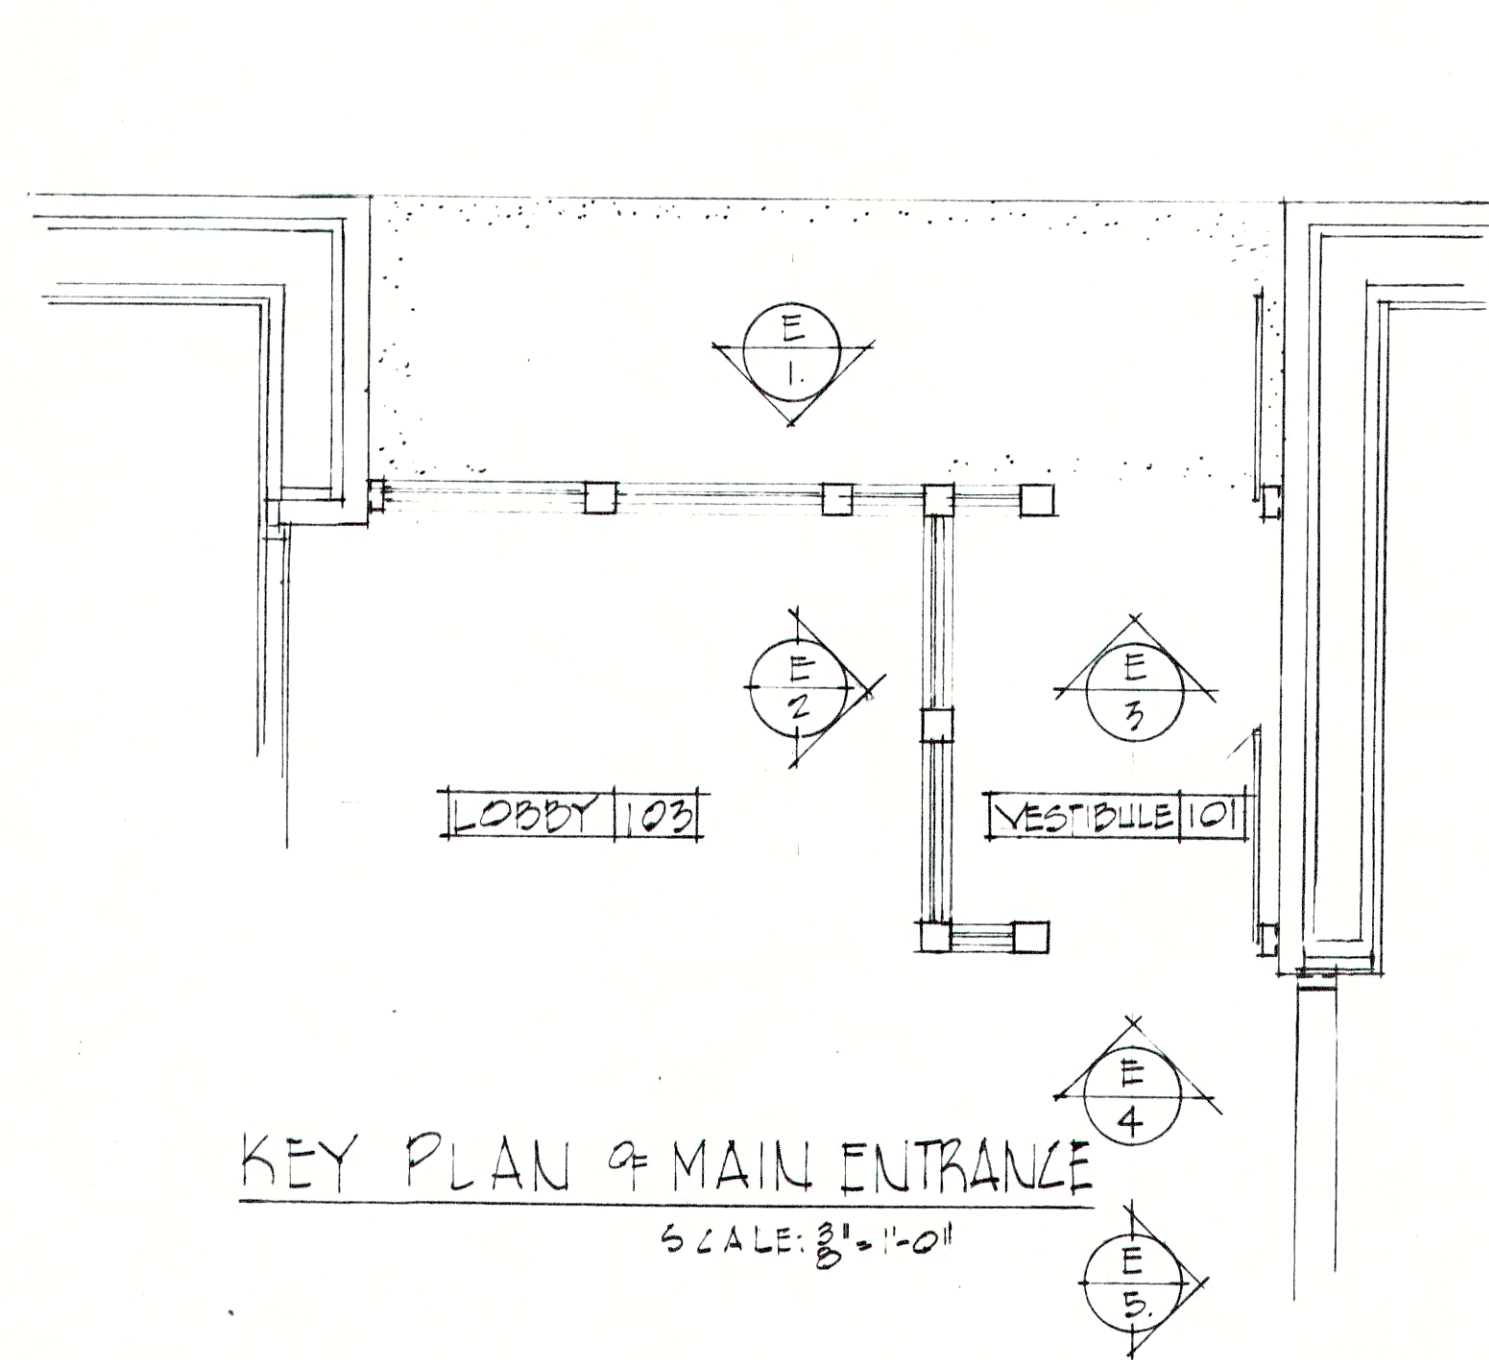

| REVISIONS |             |      |
|-----------|-------------|------|
| 1         | Rev 8-24-84 | B.O. |

PLEASE NOTE:  
BARROWED LIGHT FRAME A. OCCURS  
IN GARAGE / MAINTENANCE BLDG ONLY.

|                                                                                      |  |                                                                                                                                                        |                                   |
|--------------------------------------------------------------------------------------|--|--------------------------------------------------------------------------------------------------------------------------------------------------------|-----------------------------------|
| FALL CREEK REGIONAL<br>WASTE DISTRICT<br>WASTEWATER FACILITIES<br>PENDLETON, INDIANA |  | ed gibson and associates<br>ARCHITECTS<br>INDIANAPOLIS, INDIANA<br>DRAWN BY: RJO<br>CHECKED BY: EAG<br>DATE: 3-30-87<br>CERTIFIED BY: <i>Ed Gibson</i> | SHEET NO.<br><b>A-16</b><br>53 OF |
|--------------------------------------------------------------------------------------|--|--------------------------------------------------------------------------------------------------------------------------------------------------------|-----------------------------------|

RECORD DRAWING