



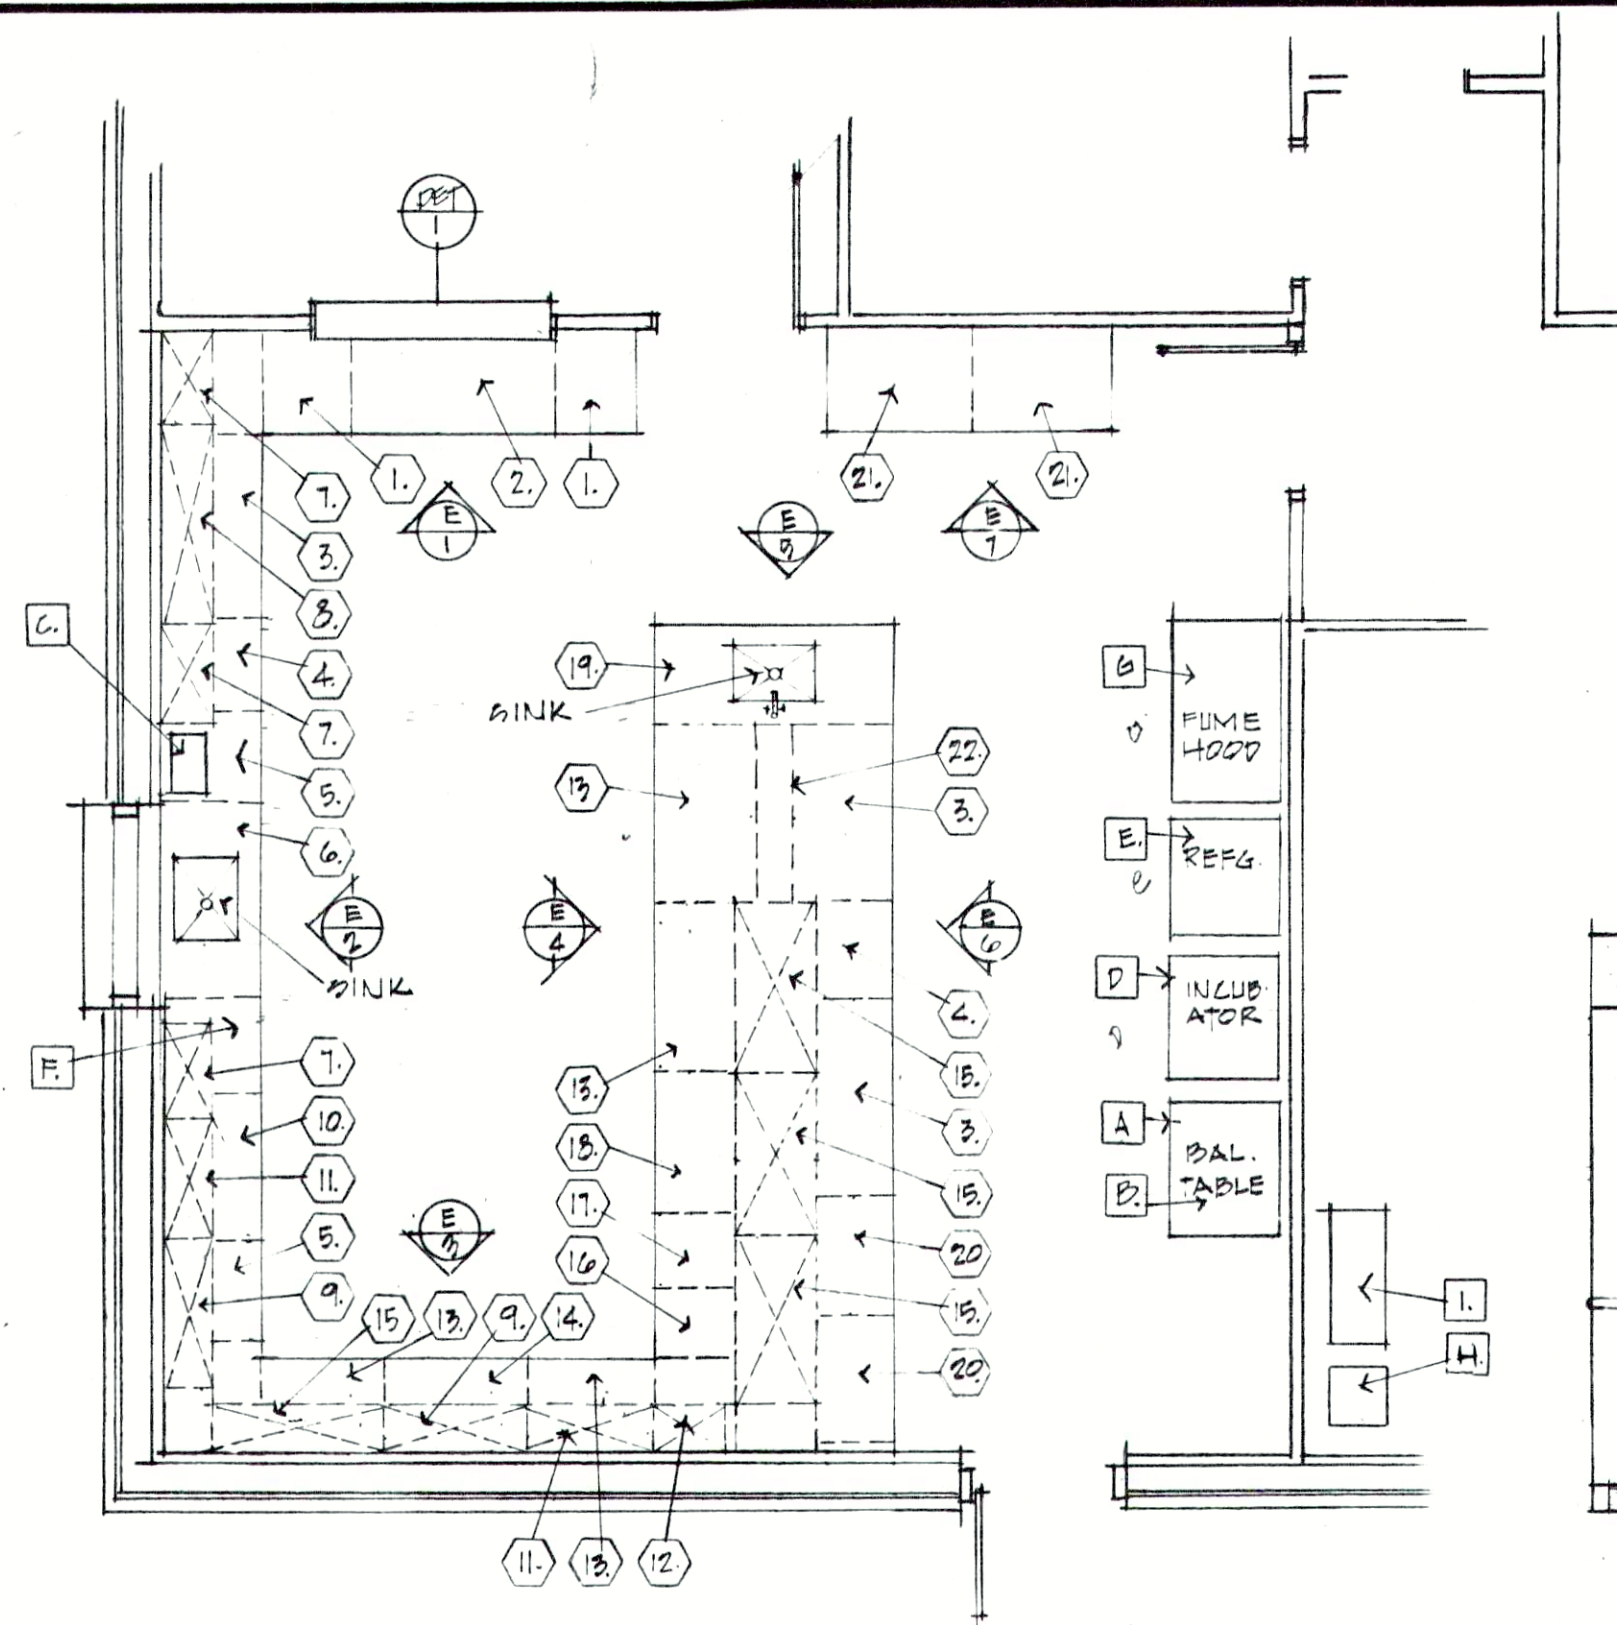

LABORATORY EQUIP. LAYOUT



SCALE: 1/4" = 1'-0"

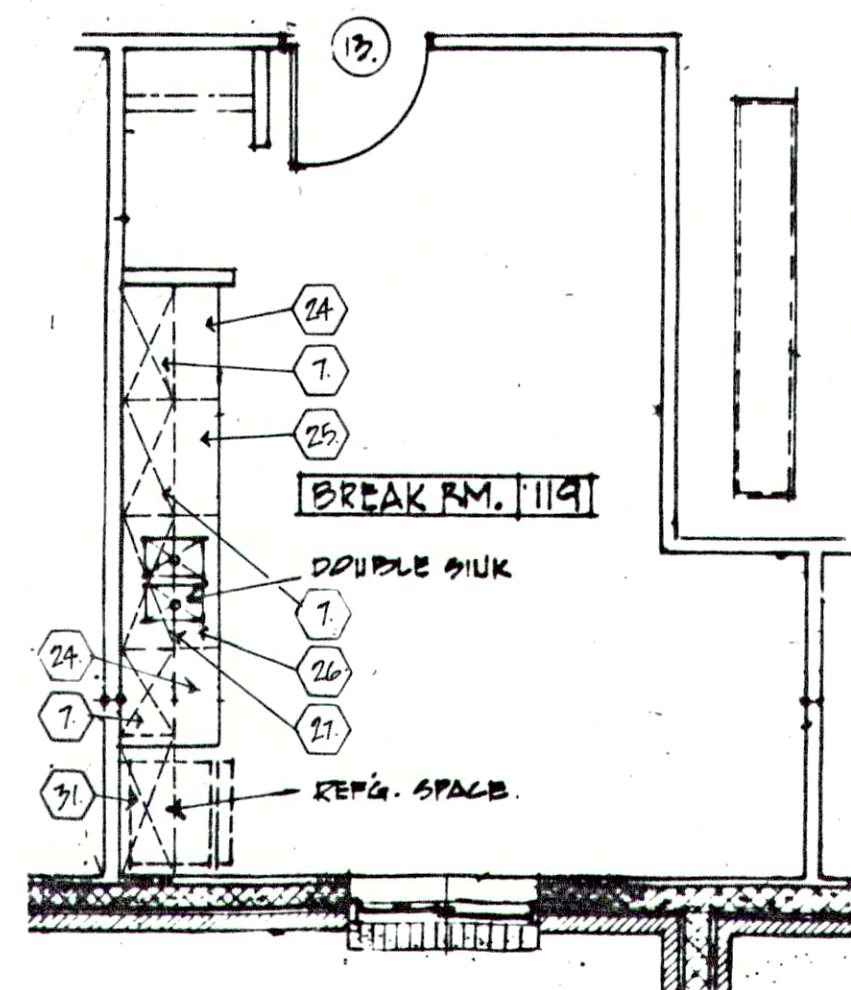

EQUIPMENT LAYOUT

ADMINISTRATION / LABORATORY BLDG.


SCALE: 1/4" = 1'-0"

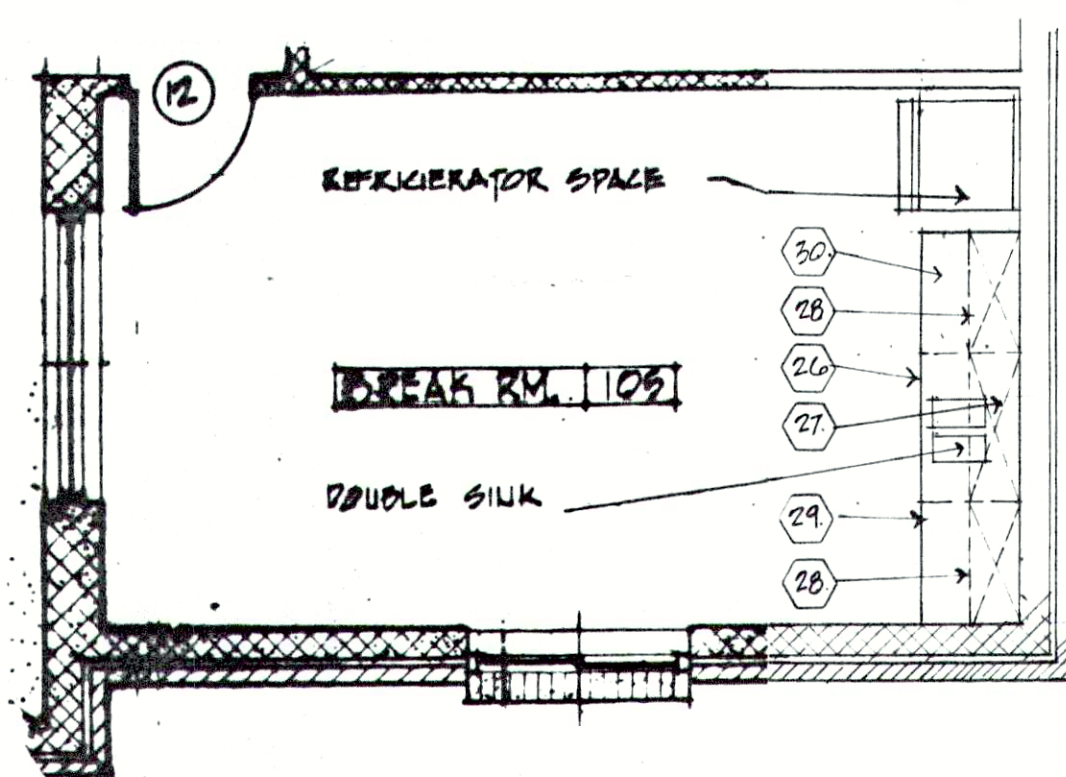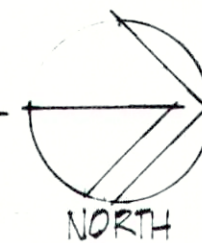


EQUIPMENT LAYOUT

GARAGE / MAINTENANCE BLDG.


SCALE: 1/4" = 1'-0"

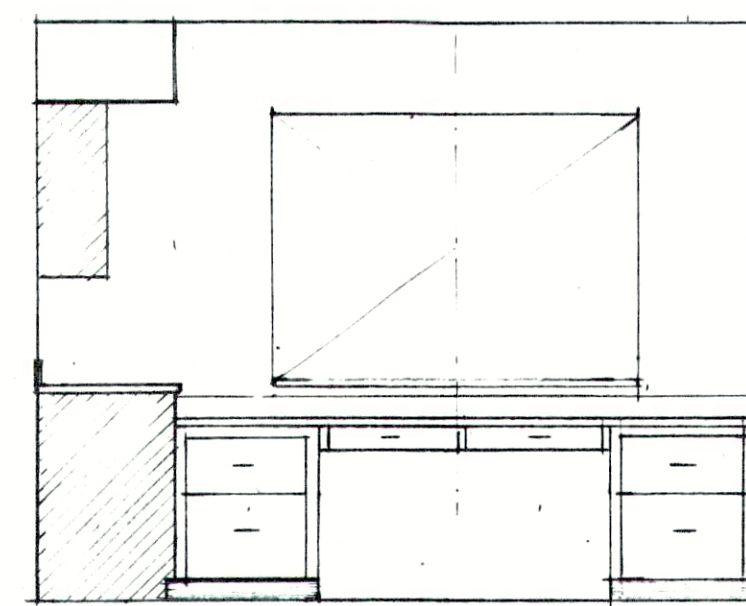


E1

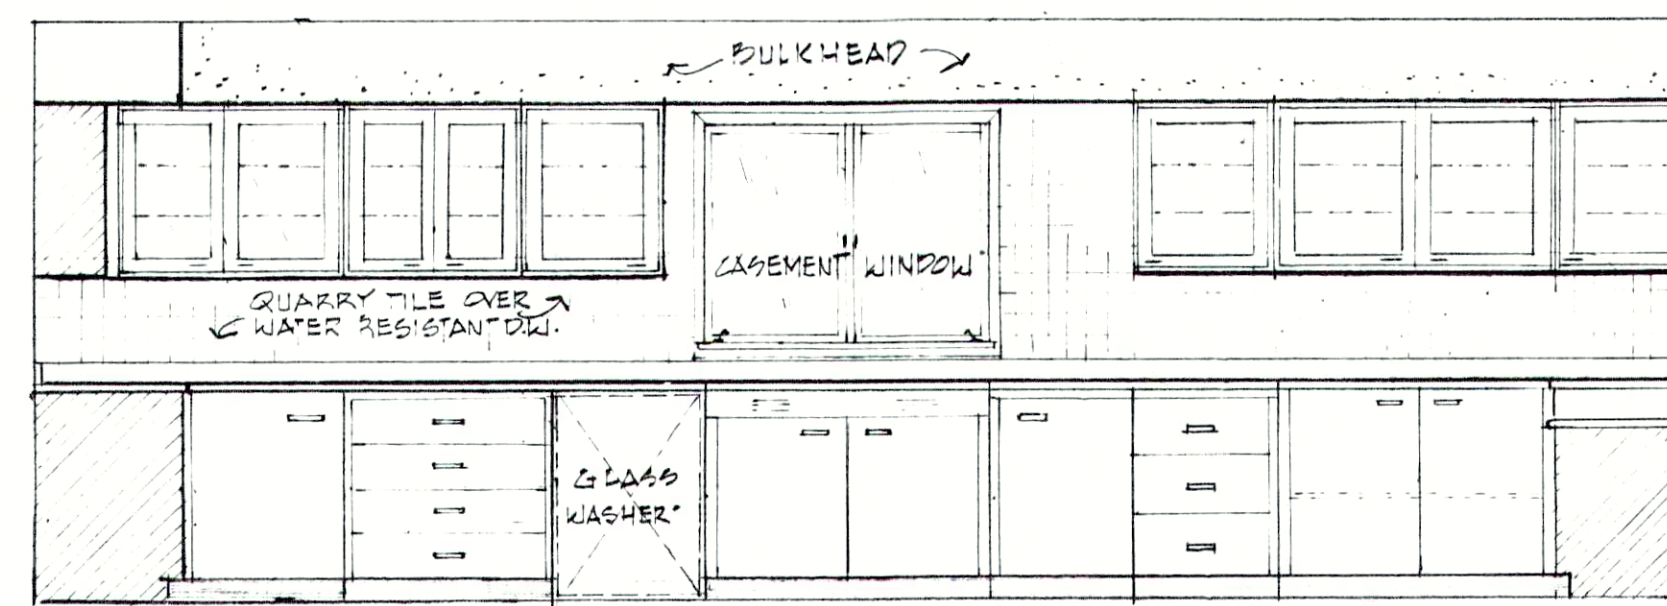


E2

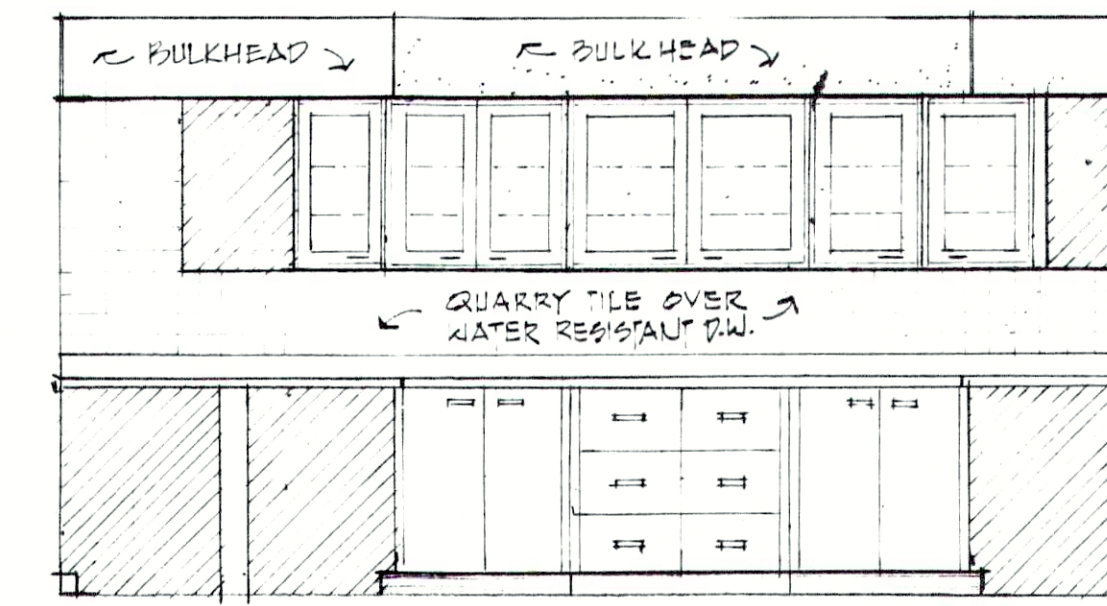


E3

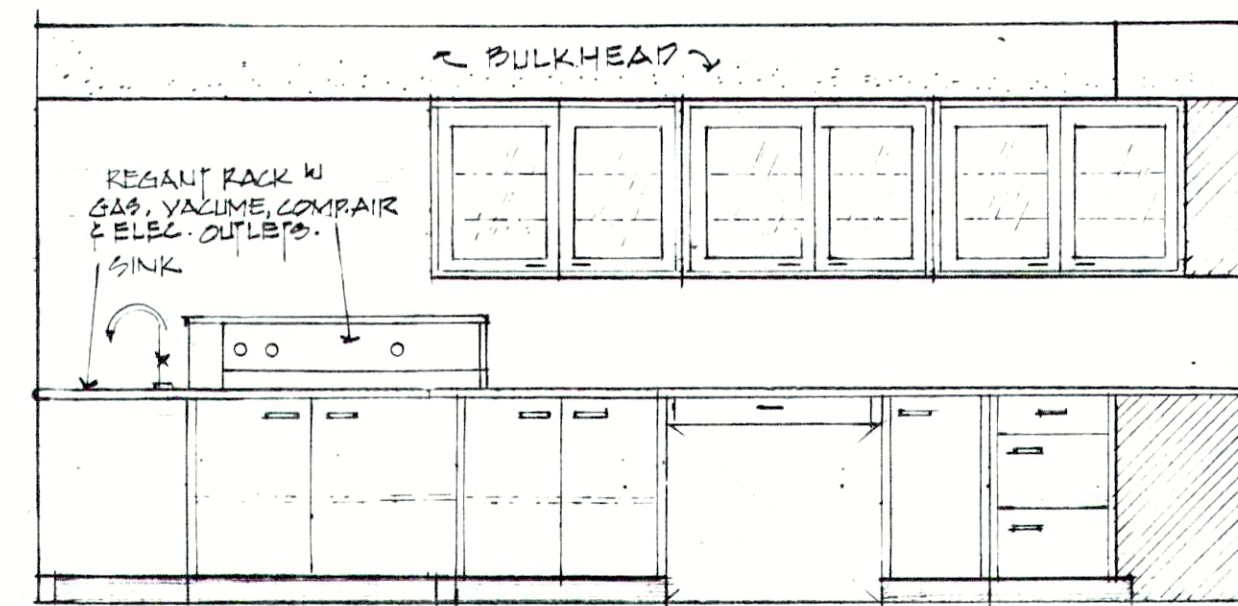


E4

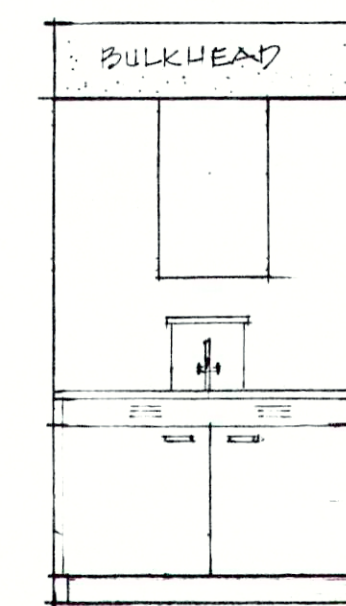

E5

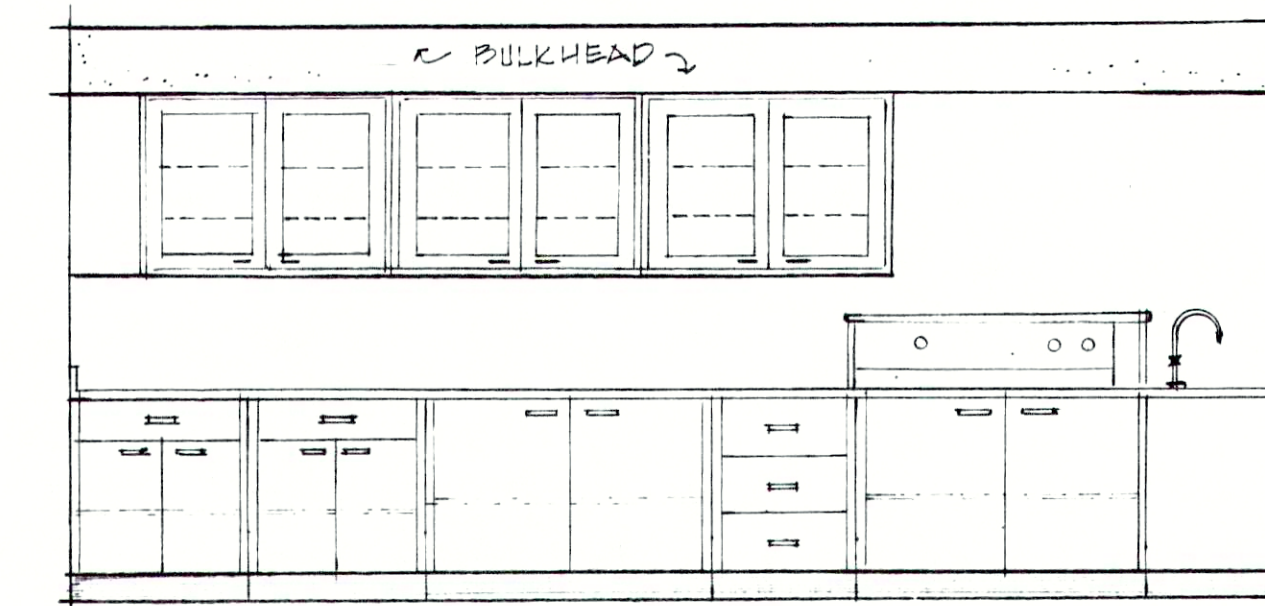

E6

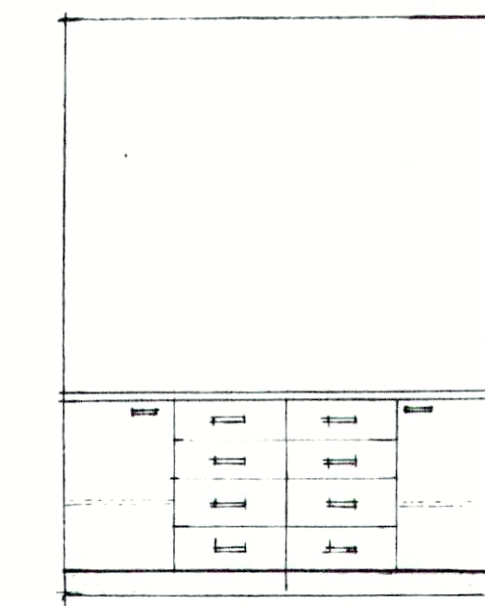

E7

LABORATORY CABINET ELEVATIONS

SCALE: 3/8" = 1'-0"

EQUIPMENT

- A. BALANCE TABLE.
- B. BEAM BALANCE.
- C. STILL.
- D. INCUBATOR.
- E. REFRIGERATOR.
- F. GLASSWARE WASHER.
- G. FUME HOOD.
- H. VACUUM PUMP.
- I. AIR COMPRESSOR.

CABINETRY


1. 24" WIDE X 28-3/8" HIGH - 2 DRAWER CABINET BASE.
2. 48" WIDE, 2 DRAWER - SUSPENDED DRAWER.
3. 48" WIDE CUPBOARD WITH FULL HEIGHT DOORS.
4. 24" WIDE, 3 DRAWER CABINET BASE.
5. 24" WIDE CUPBOARD WITH FULL HEIGHT DOOR.
6. 48" SINK CUPBOARD.
7. 24" WIDE WALL CASE.
8. 48" WIDE WALL CASE.
9. 36" WIDE WALL CASE.
10. 36" WIDE, 4 DRAWER CABINET BASE.
11. 30" WIDE WALL CASE.
12. 15" WIDE WALL CASE.
13. 30" WIDE CUPBOARD WITH FULL HEIGHT DOORS.
14. 36" WIDE, 6 DRAWER CABINET BASE.
15. 42" WIDE WALL CASE - 18" DEEP WITH DOORS BOTH SIDES.
16. 18" WIDE, 3 DRAWER CABINET BASE.
17. 18" WIDE CUPBOARD WITH FULL HEIGHT DOOR.
18. 36" WIDE, 1 DRAWER - SUSPENDED DRAWER.
19. 52" WIDE SINK CUPBOARD.
20. 30" WIDE CUPBOARD WITH ONE DRAWER.
21. 36" WIDE CUPBOARD/DRAWER - COMBINATION WITH FULL HEIGHT DOOR.
22. 48" LONG REAGENT RACK WITH FACING PANELS.
23. CABINET FILLER STRIP - TO MATCH CABINET FINISH.
24. 24" WIDE CUPBOARD WITH DRAWER COMBINATION.
25. 24" WIDE - 4 DRAWER CABINET BASE.
26. 36" WIDE - SINK CUPBOARD.
27. 36" WIDE, 18" HIGH WALL CASE.
28. 32" WIDE WALL CASE.
29. 32" WIDE, 4 DRAWER CABINET BASE.
30. 32" WIDE CUPBOARD WITH DRAWER COMBINATION.
31. 36" WIDE X 12" HIGH WALL CASE.

SPECIAL NOTE: ALL WALL CASES SHALL HAVE A HEIGHT OF 32", 3 ADJUSTABLE SHELVES PER CASE AND GLASS PANELS IN DOORS IN LABORATORY UNLESS OTHERWISE NOTED.

RECORD DRAWING

REVISIONS

FALL CREEK REGIONAL
WASTE DISTRICT
WASTEWATER FACILITIES
PENDLETON, INDIANA

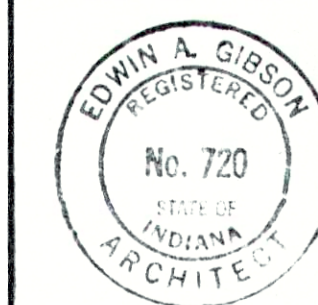

edgibson and associates
INCORPORATED
ARCHITECTS
INDIANAPOLIS, INDIANA
DRAWN BY: RJO
CHECKED BY: EAG
DATE: 8-30-87
CERTIFIED BY: Edwin A. Gibson

SHEET NO.
A-17
54
OF