

ANGLE ROAD
SHEET No. 2c of 3

INDEX SA-5


(A) STRUCTURE No. 27
INV. £ = 863.57

(B) STRUCTURE No. 28
INV. £ = 864.08

(C) STRUCTURE No. 28a
INV.(S) = 866.71
INV. £ = 866.09

(D) STRUCTURE No. 30
INV. £ = 872.95

— SAN —	=	PROPOSED SEWER
— X —	=	EXISTING CHAIN LINK FENCE
☐	=	EXISTING MAILBOX
— G —	=	EXISTING GAS LINE
— T —	=	EXISTING UNDERGROUND TELEPHONE
⚡	=	EXISTING POWERPOLE
— SC, 371'	=	AS-BUILT LATERAL LOCATION
4 40	=	<u>LATERAL DEPTH FROM GRADE</u> <u>PLUG DISTANCE FROM MAIN</u>

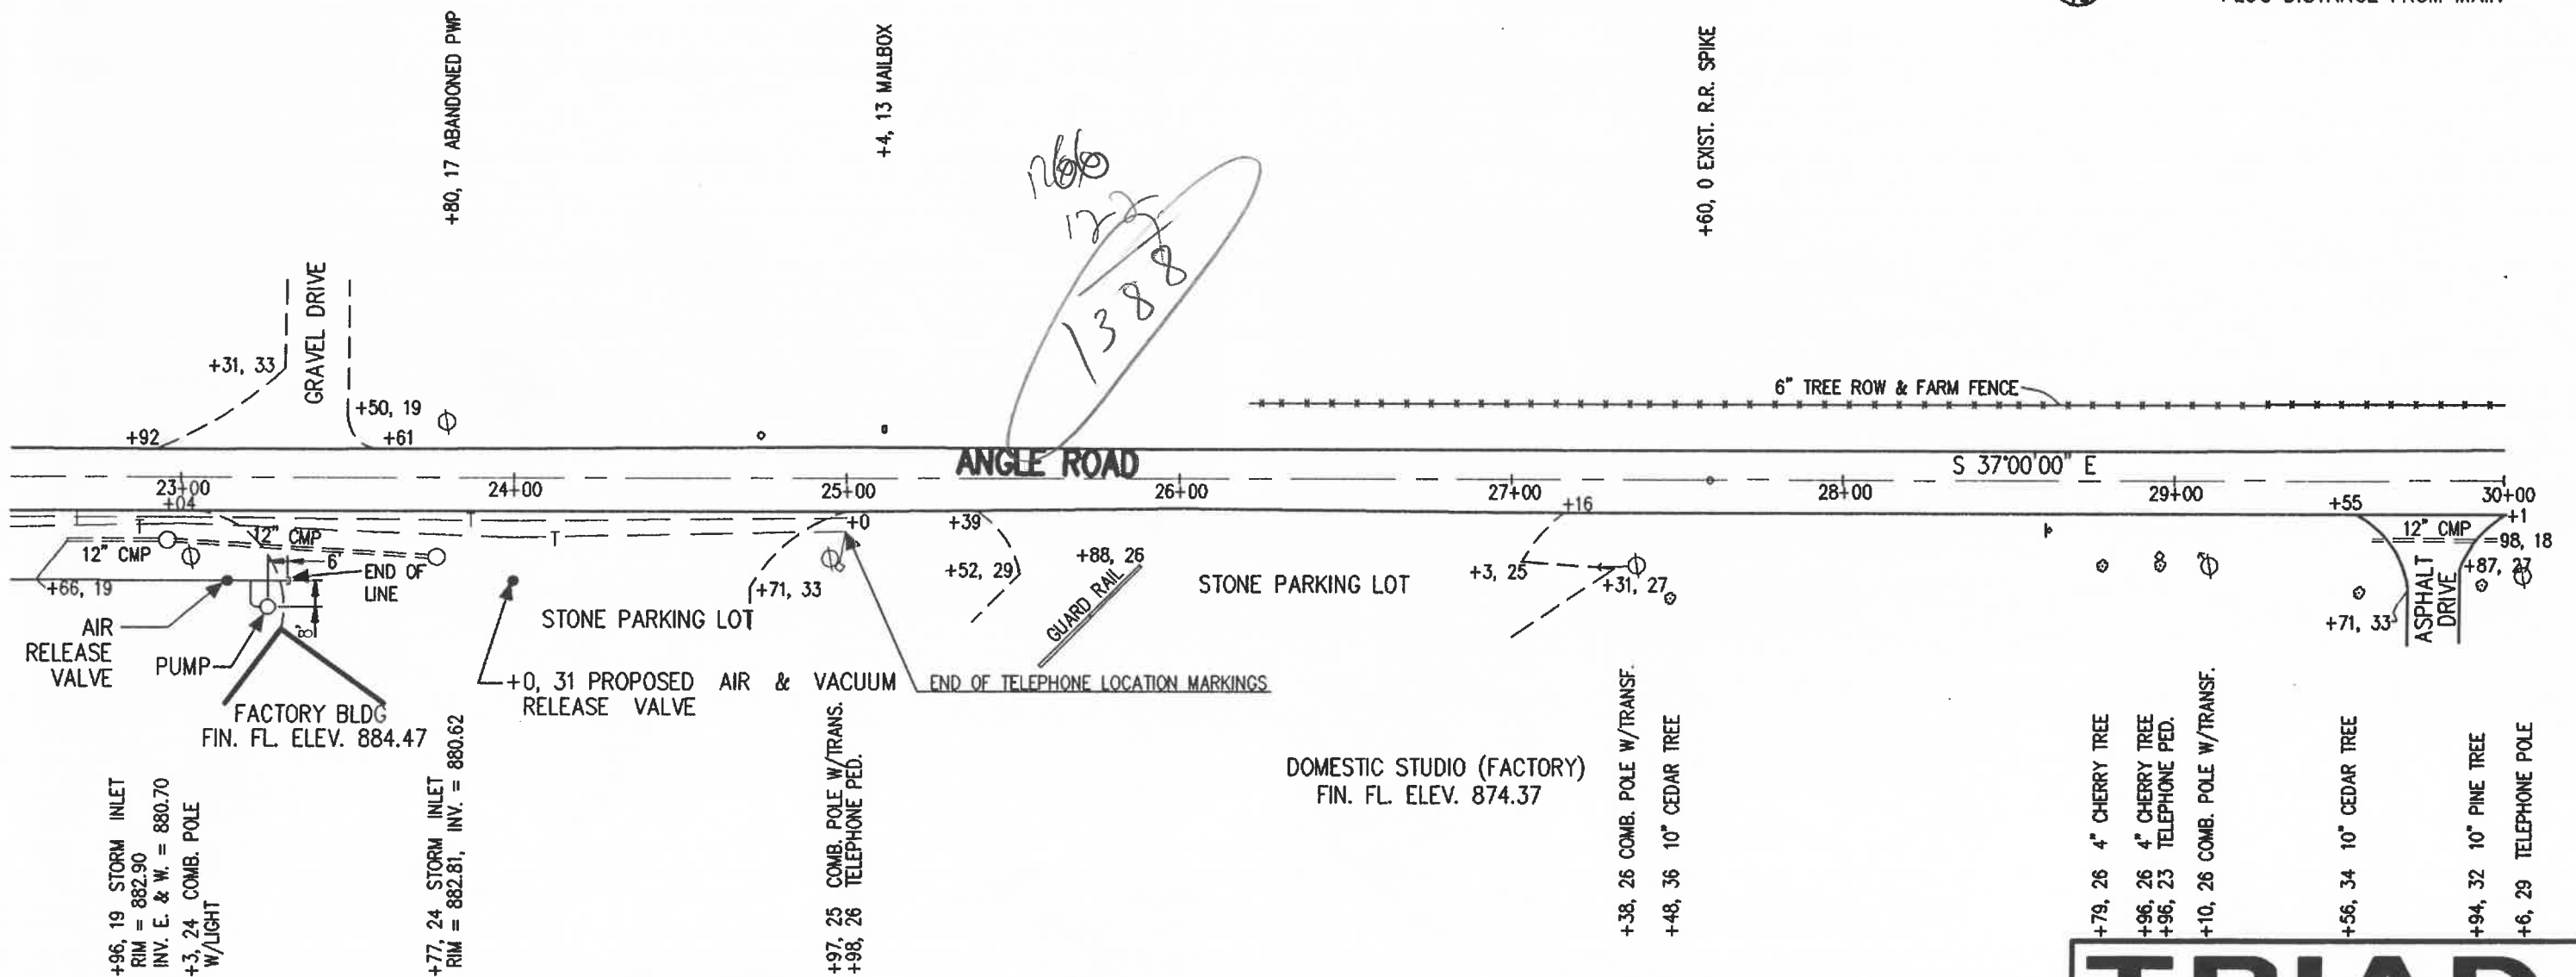

SCALE: 1" = 50'



TRIAD
ASSOCIATES
INC.

INDIANAPOLIS, INDIANA