


FALL CREEK REGIONAL WASTE DISTRICT

ANGLE ROAD

SHEET No. 2a of 3

INDEX SA-5

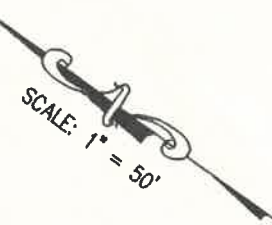

KEYNOTES

- (A) STRUCTURE No. 01
INV. ϕ = 861.32
- (B) STRUCTURE No. 02
INV. ϕ = 862.63
- (C) STRUCTURE No. 03
INV. ϕ = 862.63

STRUCTURE No. 01

NEW MANHOLE
TC = 873.5 $\pm$
INV.(W) = 865.52
INV.(N) = 865.54
INV.(S) = 865.56

STRUCTURE No. 02


NEW MANHOLE
TC = 873.8 $\pm$
INV.(S) = 866.99
INV.(N) = 867.01

STRUCTURE No. 03

NEW MANHOLE
TC = 873.0 $\pm$
INV.(S) = 868.21

LEGEND:

- SAN — = PROPOSED SEWER
- x — = EXISTING CHAIN LINK FENCE
- ☒ = EXISTING MAILBOX
- G — = EXISTING GAS LINE
- T — = EXISTING UNDERGROUND TELEPHONE
- ⚡ = EXISTING POWERPOLE
- SC, 371' — = AS-BUILT LATERAL LOCATION
- $\frac{4}{40}$ = LATERAL DEPTH FROM GRADE
PLUG DISTANCE FROM MAIN

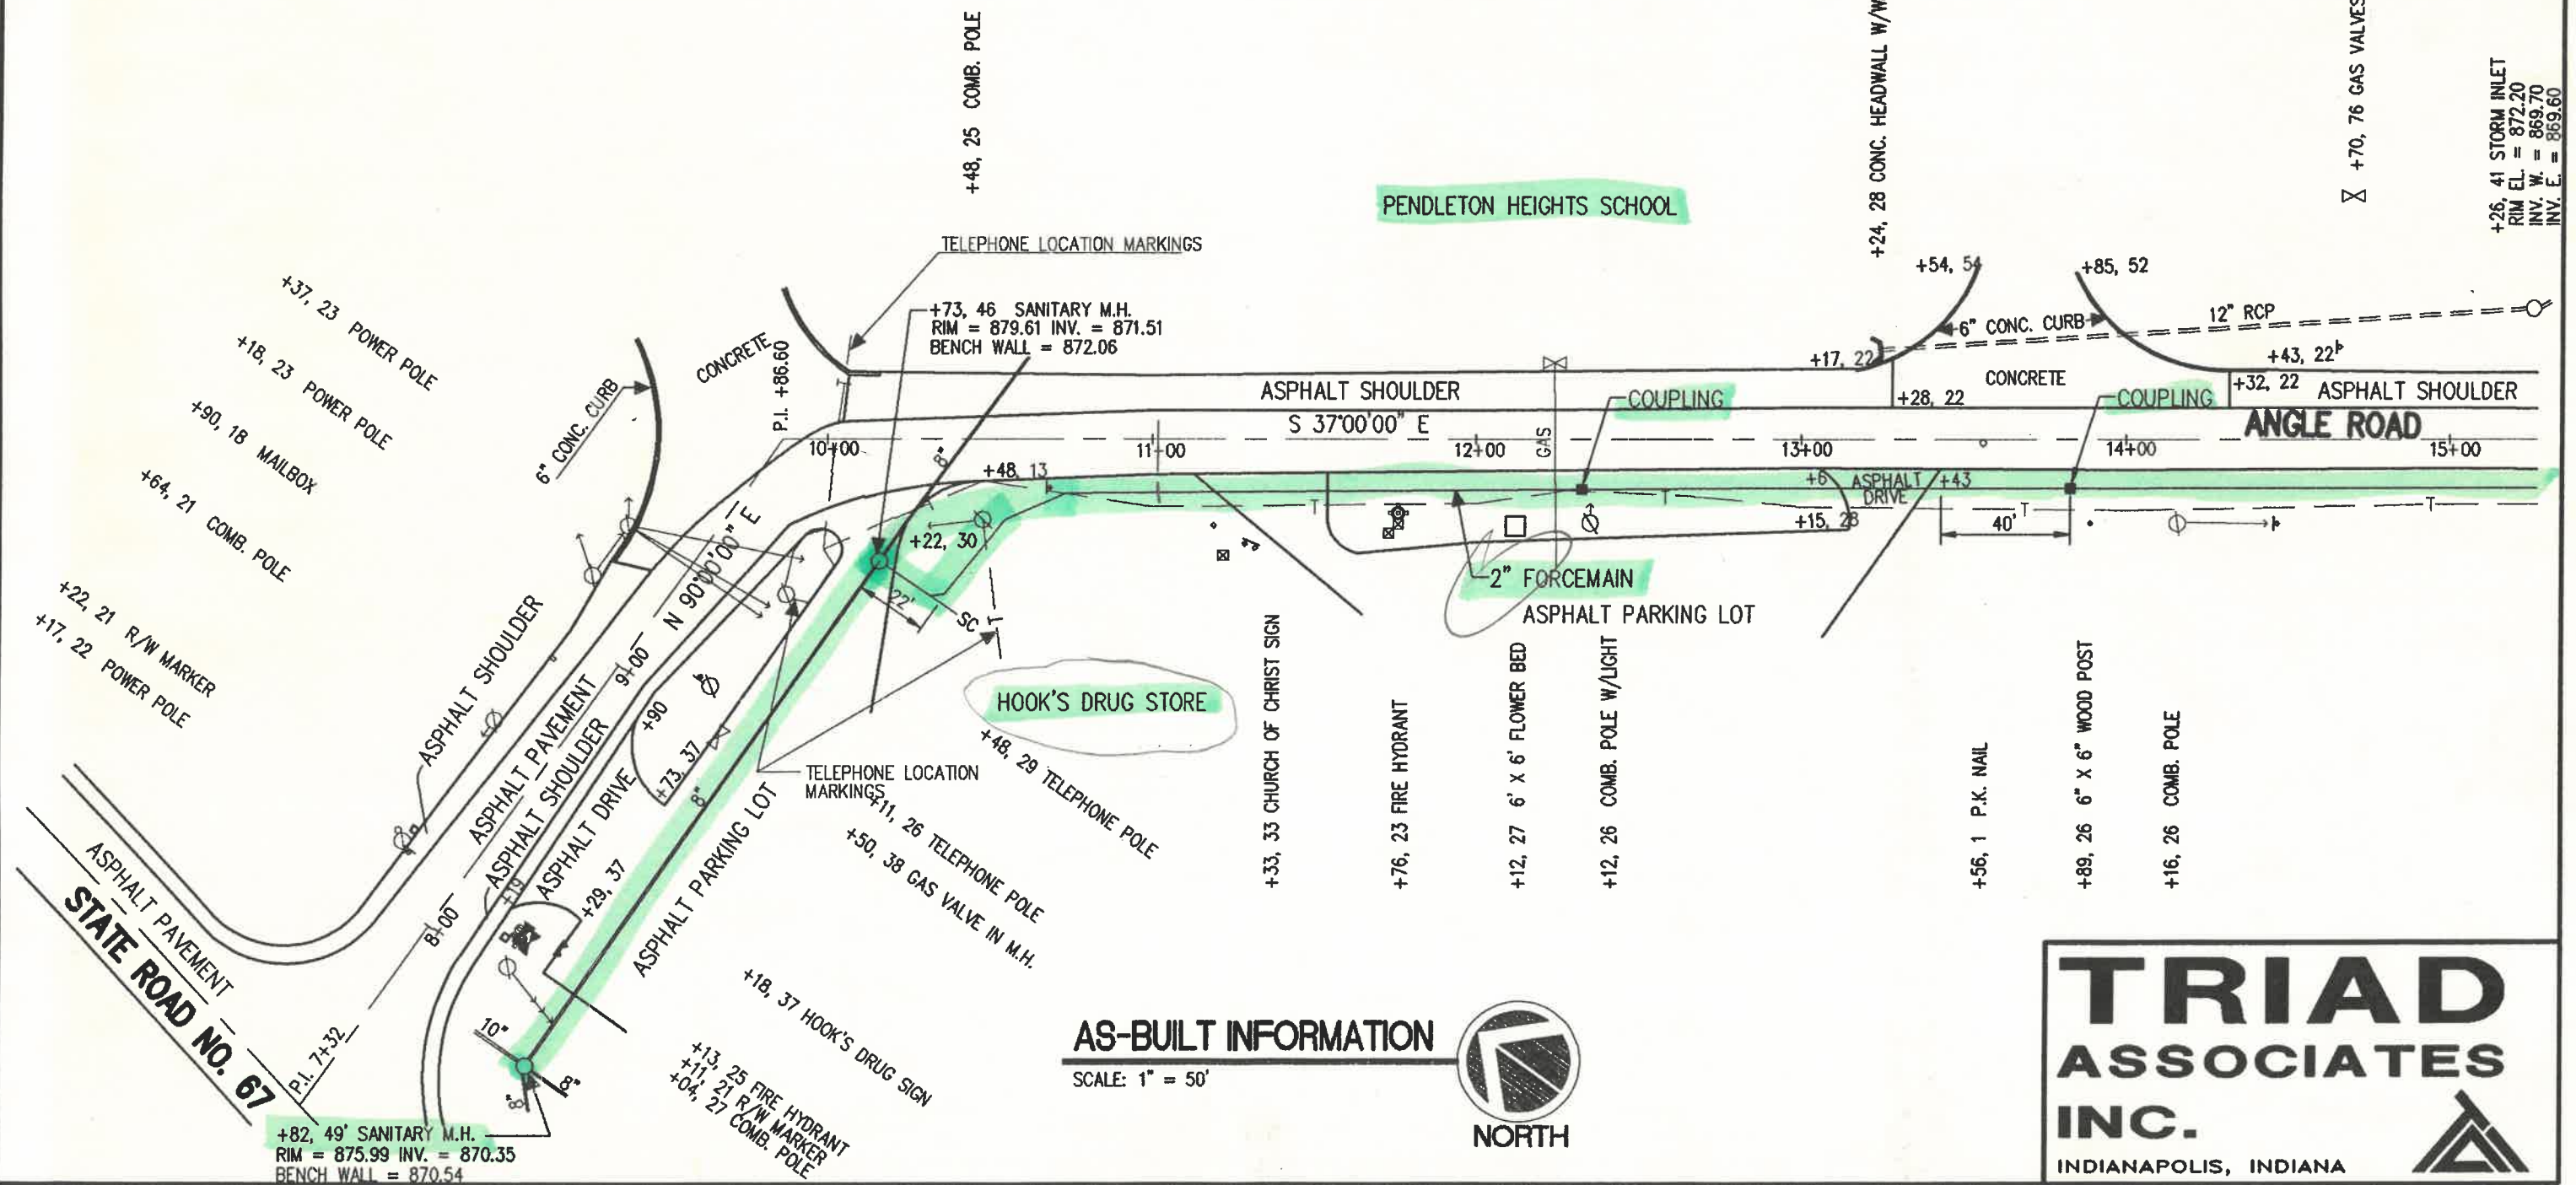

AS-BUILT INFORMATION

SCALE: 1" = 50'




TRIAD
ASSOCIATES
INC.
INDIANAPOLIS, INDIANA

FALL CREEK REGIONAL WASTE DISTRICT

ANGLE ROAD

SHEET No. 2b of 3

INDEX SA-5

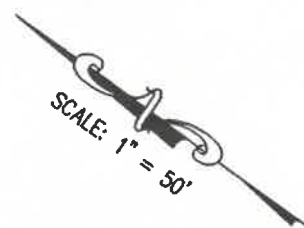


KEYNOTES

- (A) STRUCTURE No. 26
INV. ℓ = 862.63
- (B) STRUCTURE No. 27
INV. ℓ = 863.57

LEGEND:

- SAN — = PROPOSED SEWER
- x — = EXISTING CHAIN LINK FENCE
- = EXISTING MAILBOX
- G — = EXISTING GAS LINE
- T — = EXISTING UNDERGROUND TELEPHONE
- ⚡ = EXISTING POWERPOLE
- SC, 371' — = AS-BUILT LATERAL LOCATION
- ⊙ $\frac{4}{40}$ = LATERAL DEPTH FROM GRADE
PLUG DISTANCE FROM MAIN

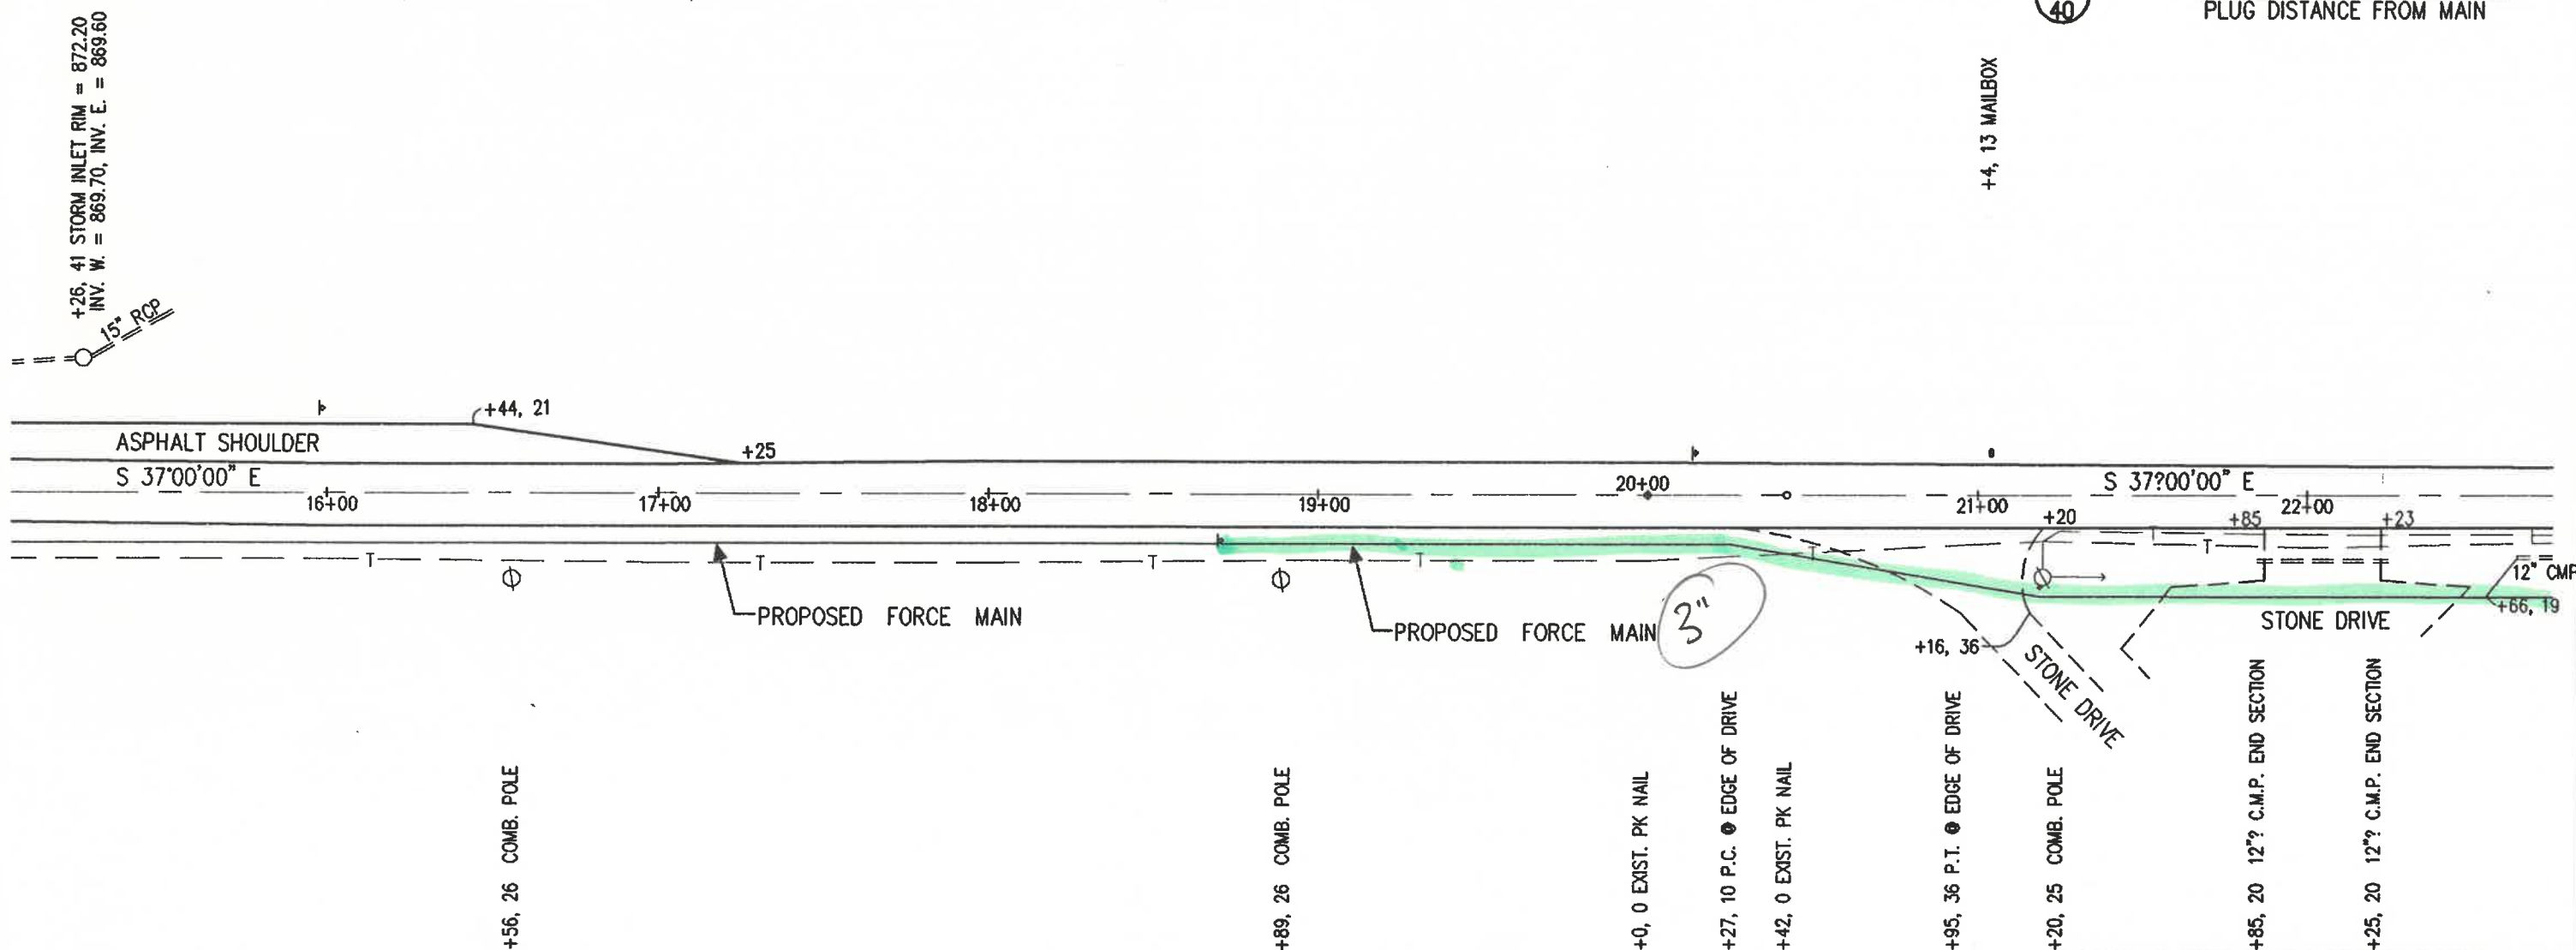

AS-BUILT INFORMATION

SCALE: 1" = 50'



**TRIAD
ASSOCIATES
INC.**

INDIANAPOLIS, INDIANA



FALL CREEK REGIONAL WASTE DISTRICT

ANGLE ROAD
SHEET No. 2c of 3


INDEX SA-5

KEYNOTES

- (A) STRUCTURE No. 27
INV. ϕ = 863.57
- (B) STRUCTURE No. 28
INV. ϕ = 864.08
- (C) STRUCTURE No. 28a
INV.(S) = 866.71
INV. ϕ = 866.09
- (D) STRUCTURE No. 30
INV. ϕ = 872.95

LEGEND:

- SAN — = PROPOSED SEWER
- x — = EXISTING CHAIN LINK FENCE
- = EXISTING MAILBOX
- G — = EXISTING GAS LINE
- T — = EXISTING UNDERGROUND TELEPHONE
- = EXISTING POWERPOLE
- SC, 371' — = AS-BUILT LATERAL LOCATION
- ⊙ = LATERAL DEPTH FROM GRADE
PLUG DISTANCE FROM MAIN

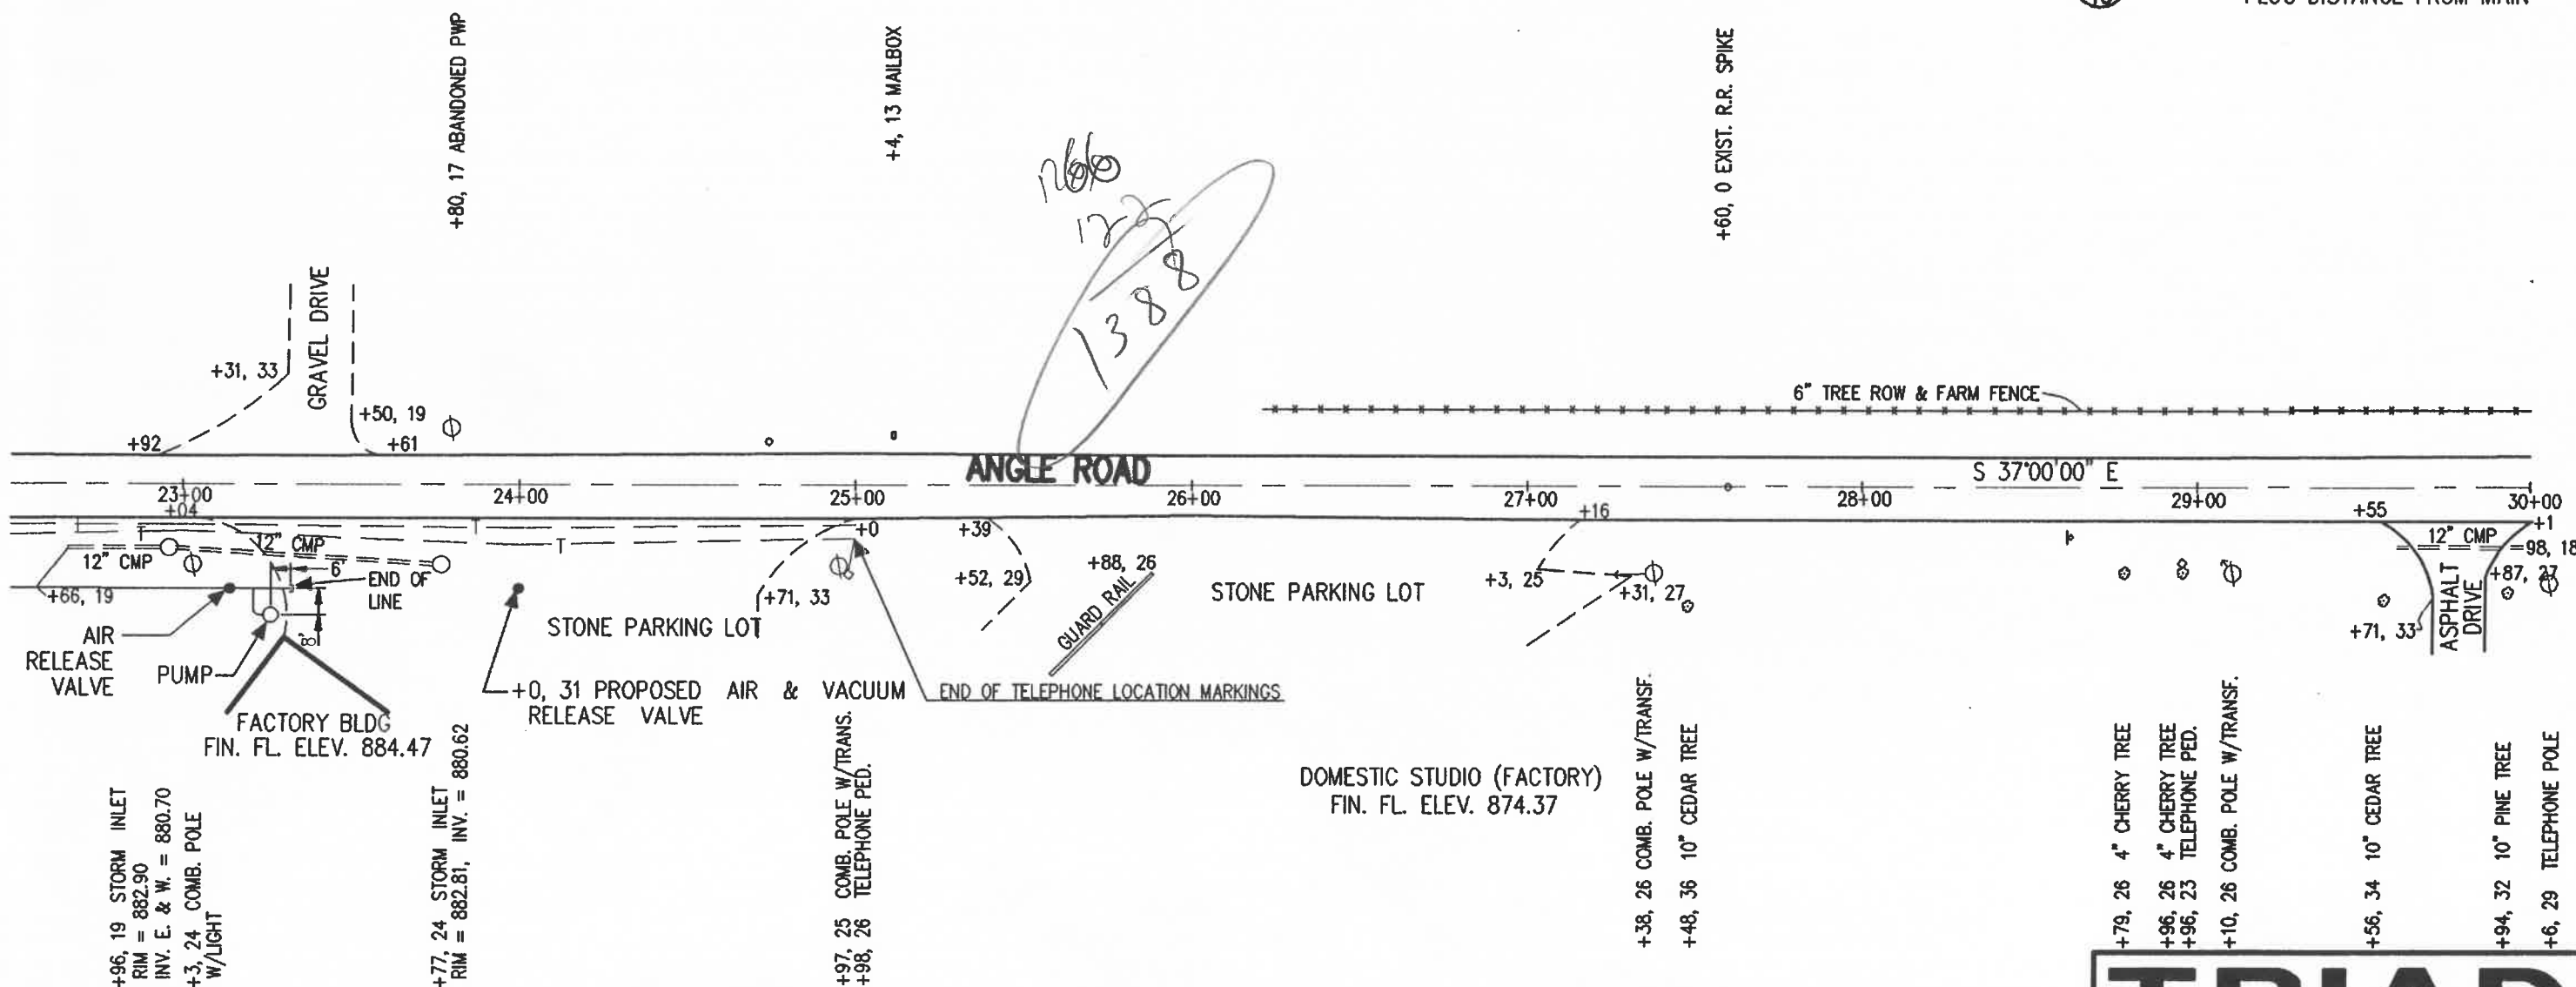

AS-BUILT INFORMATION

SCALE: 1" = 50'



**TRIAD
ASSOCIATES
INC.**

INDIANAPOLIS, INDIANA

