
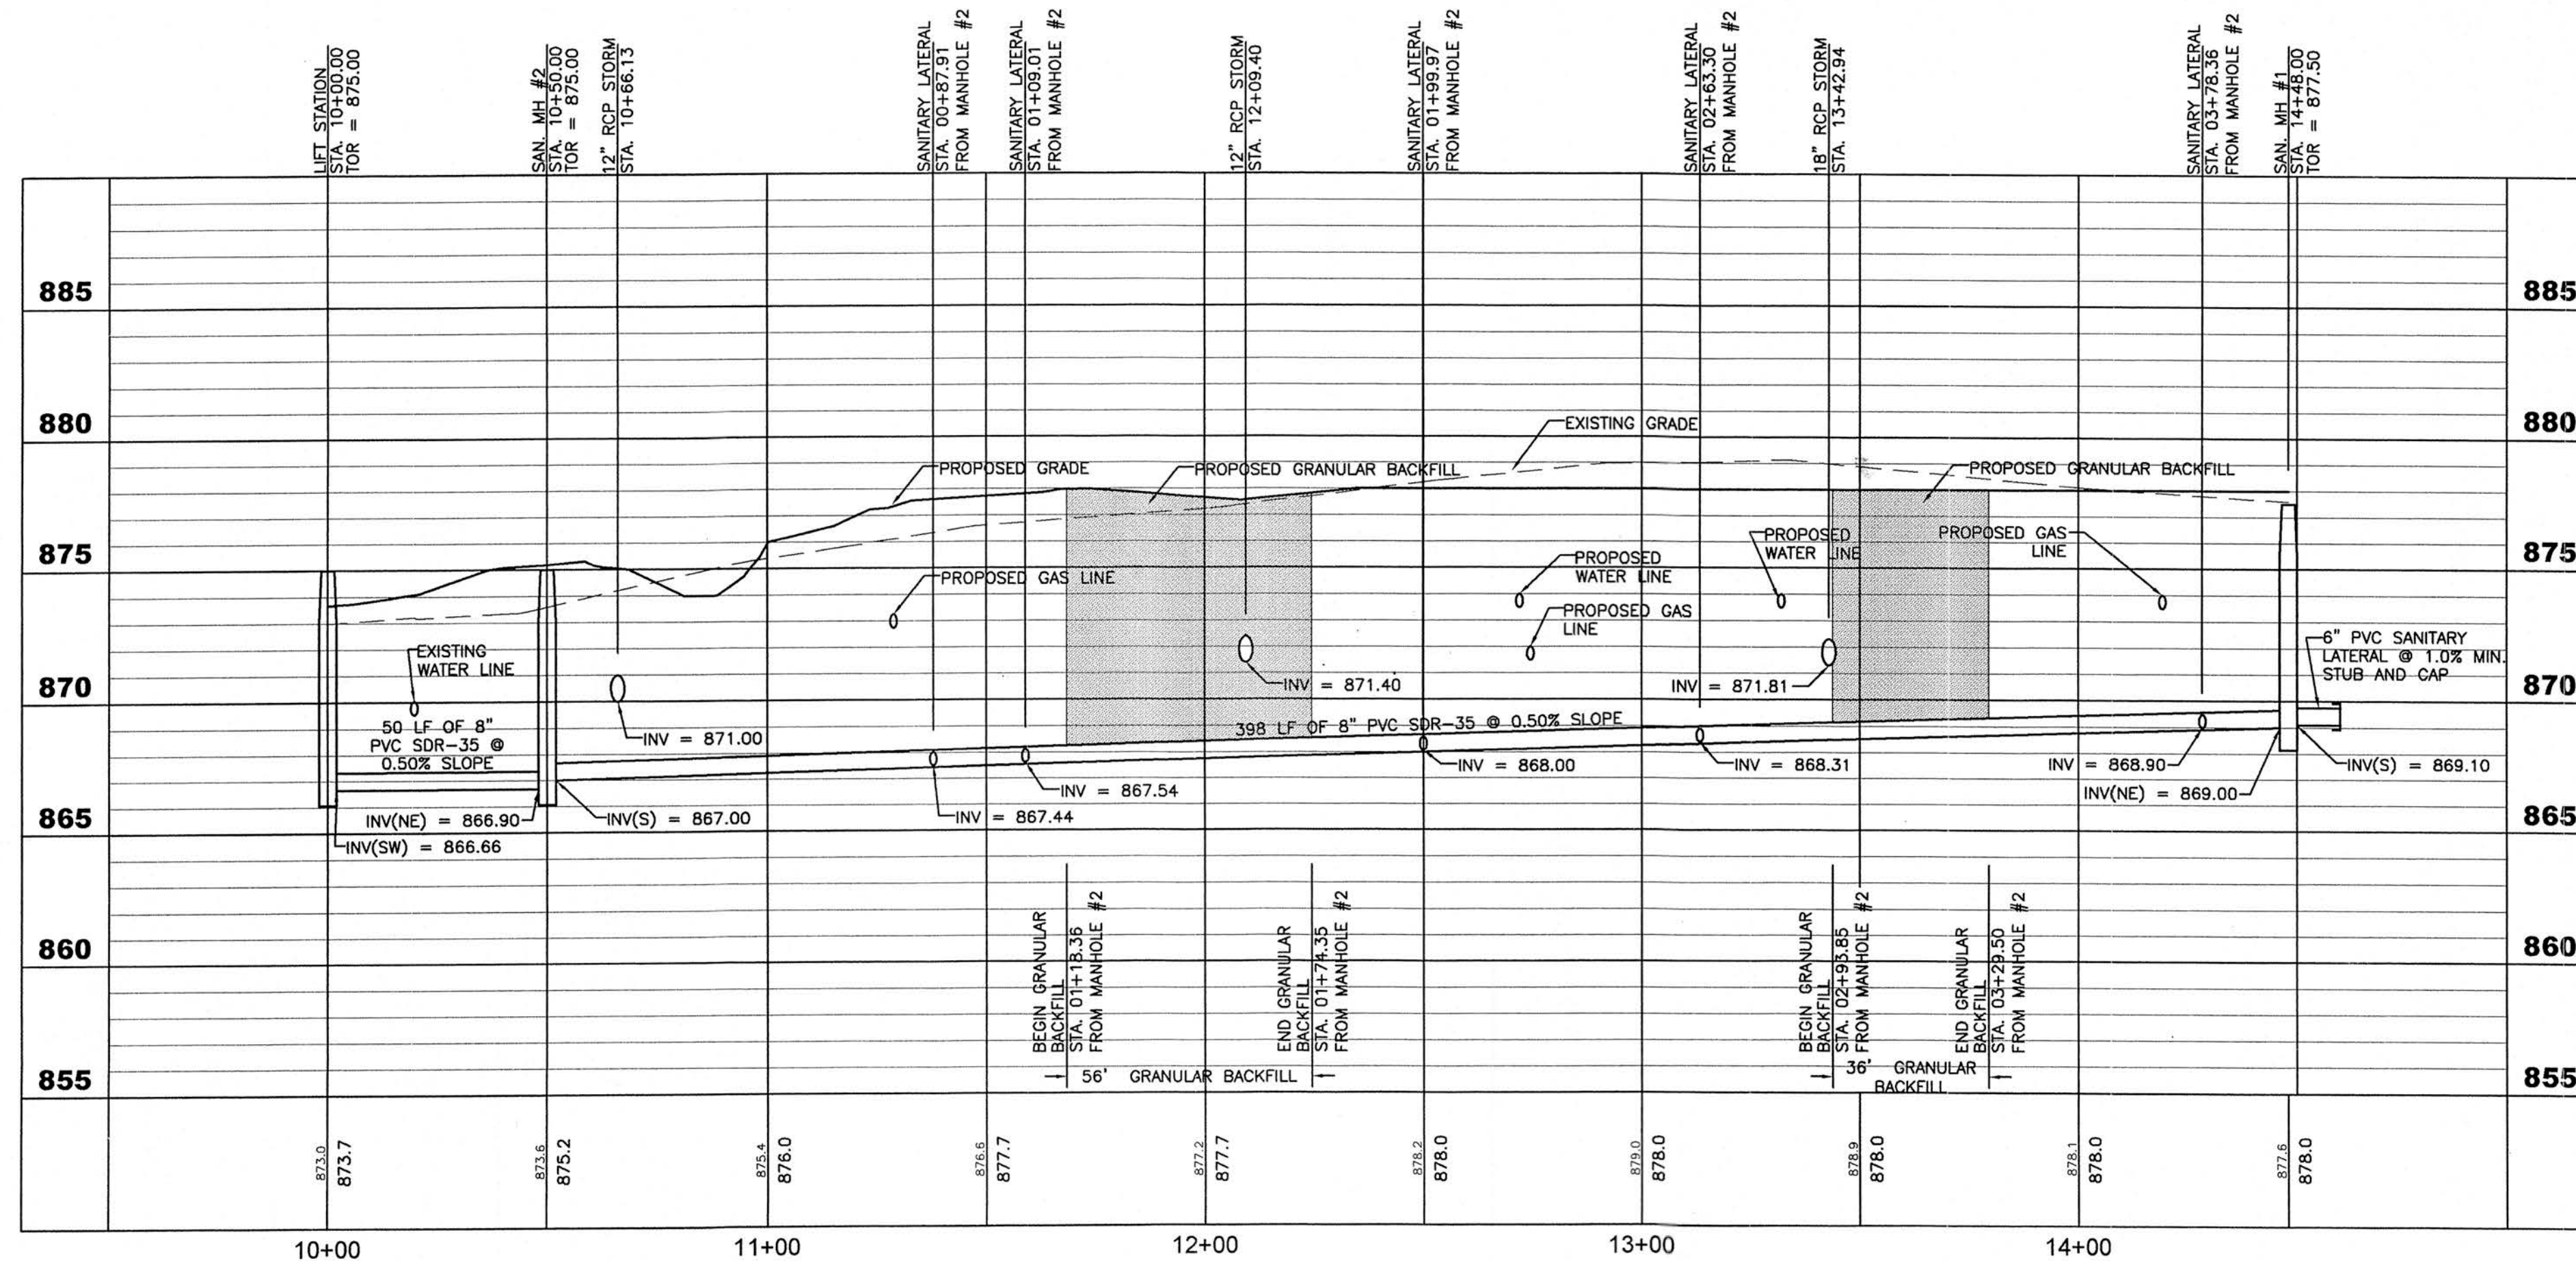
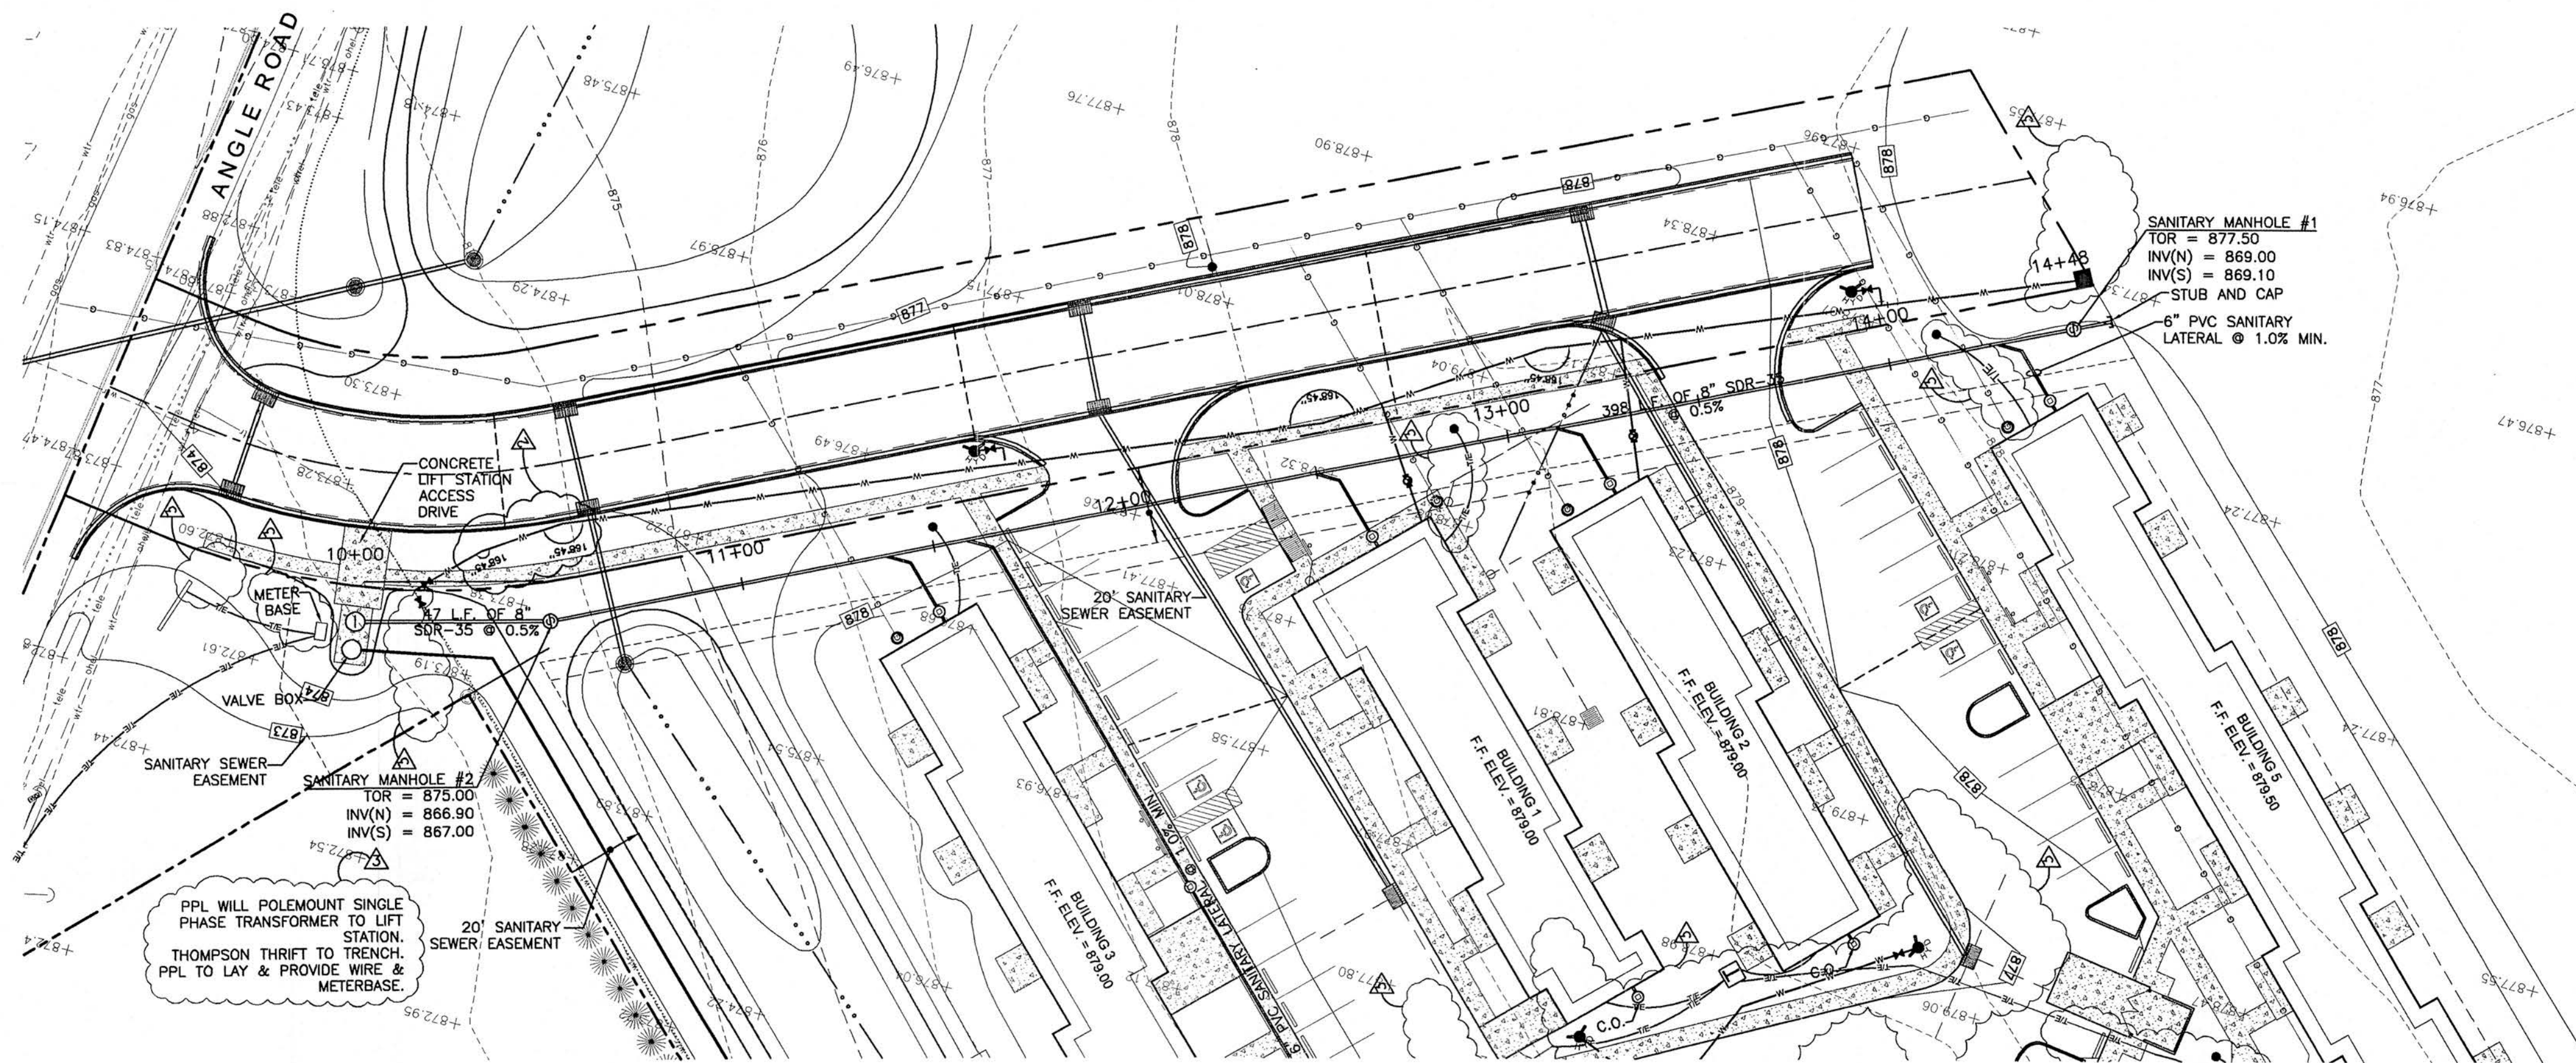



The underground utilities shown have been located from field survey information and existing drawings. The surveyor makes no guarantees that the underground utilities comprise all such utilities in the area, either in-service or abandoned. The surveyor further does not warrant that the underground utilities shown are in the exact location indicated although the surveyor does certify that they are located as accurately as possible from information available. The surveyor has not physically located the underground utilities.

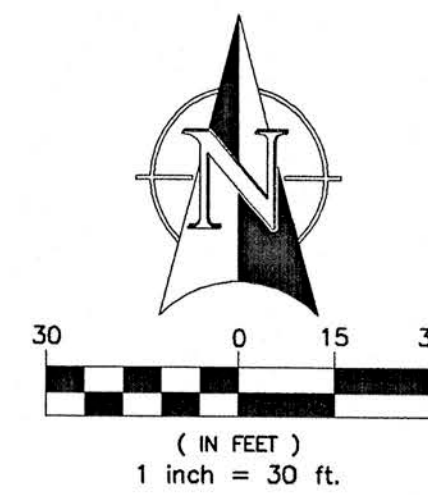


"DON'T
DIG
BLIND"

"HOLEY MOLEY"
SEZ:

"IT'S THE
LAW"


 
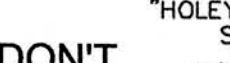 
A cartoon illustration of a mole wearing sunglasses and holding a shovel. The mole is positioned in the center, with its head tilted slightly to the right. It has a confident expression. The background is plain white. The text is arranged around the mole: "DON'T DIG BLIND" on the left, "HOLEY MOLEY" SEZ: above the mole's head, and "IT'S THE LAW" on the right.

INDIANA UNDERGROUND PROTECTION SERVICE INC.
CALL TWO WORKING DAYS BEFORE YOU DIG
1-800-382-5544
CALL TOLL FREE
1-800-428-5200
FOR CALLS OUTSIDE OF INDIANA

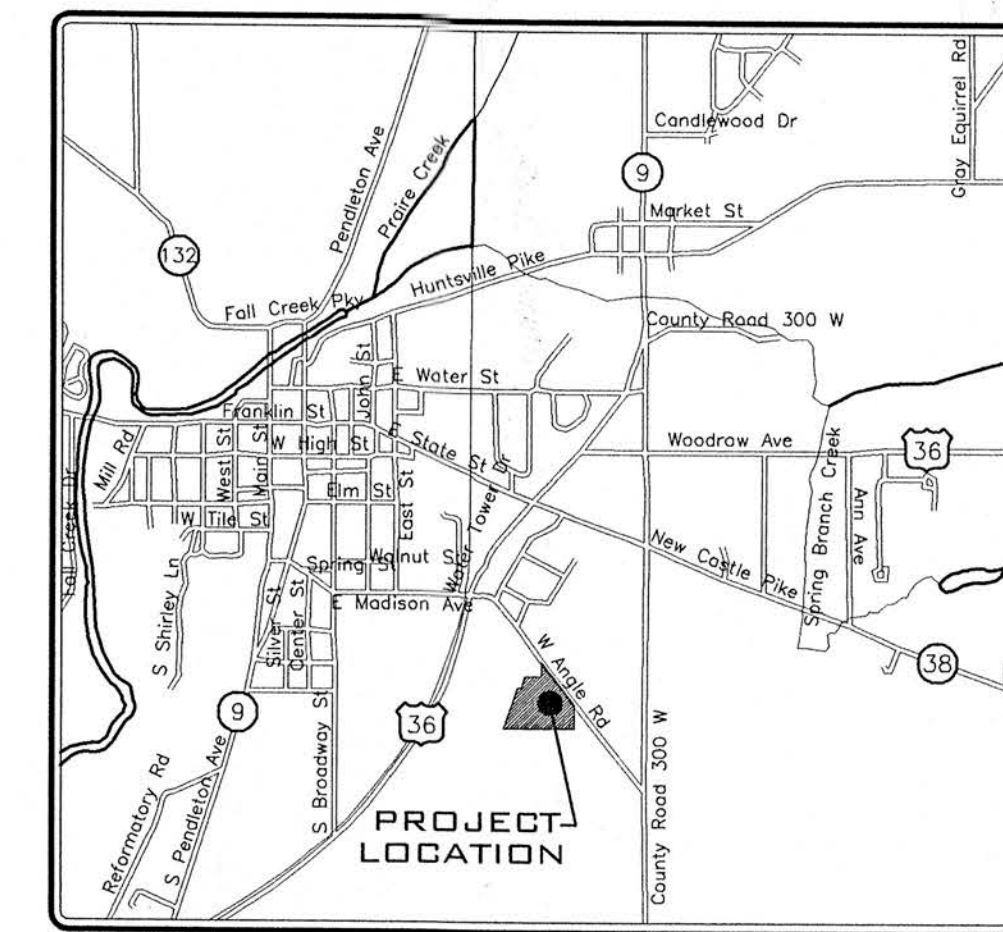

VICINITY MAP
NOT TO SCALE

LEGEND:	
DESCRIPTION:	DESCRIPTION:
	 WATER VALVE
	 FIRE HYDRANT
	 WATER METER
	 STAND PIPE
	 INLET
	 METAL END SECTION
	 DECIDUOUS TREE
	 CONIFEROUS TREE
	 OVERHEAD ELECTRIC LINE
	 UNDERGROUND ELECTRIC
	 UNDERGROUND TELEPHONE
	 WATER LINE
	 GAS LINE
	 FENCE
	

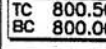PROPOSED GRADING LEGEND:		DETAIL #/SH. #	
DESCRIPTION:		ABBREVIATIONS	
	PROPOSED SPOT	EP =	EDGE OF PMVT.
	PROPOSED CURB ELEVATION	TC =	TOP OF CURB
	PROPOSED CONTOUR	BC =	BOTTOM OF CURB
	EXISTING CONTOUR	TOR =	TOP OF RIM
	PROPOSED GRADE BREAK	INV =	STORM INVERT
	PROPOSED FLOWLINE	FL =	FLOWLINE
	PROPOSED STORM SEWER	ME =	MATCH EXISTING
DESCRIPTION:			
	PROPOSED UNDERDRAIN	DETAIL	01/C7.1
	PROPOSED BEEHIVE INLET	DETAIL	02/C7.1
	PROPOSED CURB INLET	DETAIL	03/C7.1
	PROPOSED MANHOLE	DETAIL	04/C7.1
	PROPOSED INLET	DETAIL	05/C7.1
	CONCRETE END SECTION	DETAIL	06/C7.1

U.S.G.S. BM
BRONZE DISK SET IN CONCRETE POST @ SOUTHEAST CORNER OF S.R.
38 & CR 300 W (NAVD 88) ELEV = 877.47

CIVIL DESIGNS TRM#1
BOAT SPIKE SET IN SOUTHEAST SIDE OF POWERPOLE 23'±
SOUTHWEST OF @ OF ANGLE ROAD & 17'± EAST OF GRAVEL DRIVE
ELEV = 880.78

CIVIL DESIGNS TRM#2
BOAT SPIKE SET IN POWERPOLE 23'± SOUTHEAST OF @ OF ANGLE
ROAD & 73'± SOUTHEAST ALONG R/W FROM WATER MARKER.
ELEV = 875.12

CIVIL DESIGNS TRM#3
NORTH BUNNET BOLT ON TOP FLANGE OF FIRE HYDRANT 27'±
NORTHEAST OF @ OF ANGLE ROAD & 85'± NORTHWEST FROM @ OF
GRAVEL DRIVE AT THE WEST END OF THE SITE.
ELEV = 878.70

1. REV. 1 - 02/23/04 - ROLLED CURB @ LIFT STATION ENTRANCE
 2. REV. 2 - 03/15/04 - REVISED SETBACKS TO 15'; MOVED BLDGS 1, 2, 3, & 5, & PARKING TO NORTH; ADDED NEW WATER MAIN INFORMATION; ADDED BORING INFORMATION
 3. REV. 3 - 03/31/04 - REVISED WATER LINE: REMOVED 10" LOOP SOUTH OF BUILDING 5, REMOVED 8" LINES TO INTERIOR HYDRANTS & ADDED 10" LINE TO INTERIOR HYDRANTS. REVISED WATER CONNECTION TO EXISTING 6" LINE AT WEST PROPERTY LINE. ADDED METER BASE AT LIFT STATION. ADDED NOTE FOR TRANSFORMER AT LIFT STATION. CHANGED POWER REQUIREMENT FROM 3-PHASE TO SINGLE PHASE. UPDATED TRANSFORMER LOCATION AND ELECTRIC/TELEPHONE CONNECTIONS TO BUILDINGS.

BROAD RIPPLE DESIGN ASSOCIATES, L.L.C.
660 EAST 62ND STREET
INDIANAPOLIS, IN 46220-1870

AI CIVIL DESIGNS, LLP



ASHBURY POINTE APARTMENTS
ANGLE ROAD
PENDLETON, INDIANA

SANITARY SEWER PLAN & PROFILE

DWN BY:	KRC
CHKD. BY:	JMP
SCALE:	1" = 30'
DATE:	02/05/04

DESIGN PHASE CONSTRUCTION

PLAN NUMBER
SS1.1
SHEET OF