


BABY FARMS LIFT STATION AND FORCE MAIN IMPROVEMENTS

FALL CREEK REGIONAL WASTE DISTRICT - PENDLETON, INDIANA

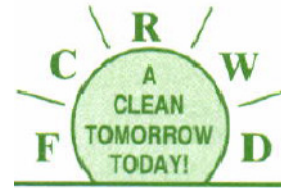

FCRWD MEMBERS

MARK A. JABLONSKI	- PRESIDENT
MICHELLE W. PATISHALL	- VICE PRESIDENT
GREGORY L. VALENTINE	- TREASURER
DAVID K. PADGETT	- SECRETARY
STEPHEN J. BILL	- DEPUTY SECRETARY/TREASURER
TIMOTHY E. GREEN	- BOARD MEMBER
KURT L. KAHL	- BOARD MEMBER
JACK C. WEIST	- BOARD MEMBER
ALBERT B. STEWART	- BOARD MEMBER
TERESA HUTTON	- GENERAL MANAGER
STEVE UNGER	- ATTORNEY





engineering | architecture | geospatial

www.grwinc.com

THIS RECORD DOCUMENT HAS BEEN PREPARED BASED ON INFORMATION PROVIDED BY THE CONSTRUCTION CONTRACTOR, GRW ENGINEERS, INC. HAS ATTEMPTED TO VERIFY THE ACCURACY AND/OR COMPLETENESS OF THIS INFORMATION BUT SHALL NOT BE RESPONSIBLE FOR ANY ERRORS OR OMISSIONS WHICH MAY BE INCORPORATED HEREIN AS A RESULT.

GRW
engineering | architecture | geospatial
ENGINEER/ARCHITECT: GEORGE LEWIS
CONSTRUCTION COMPANY: B.J. BROWN CONSTRUCTION
DATE: 11/2017

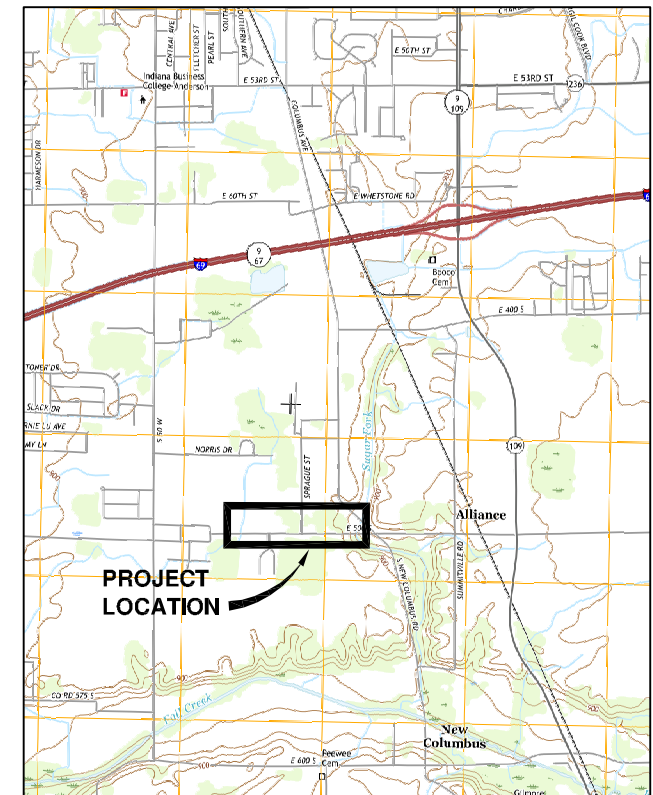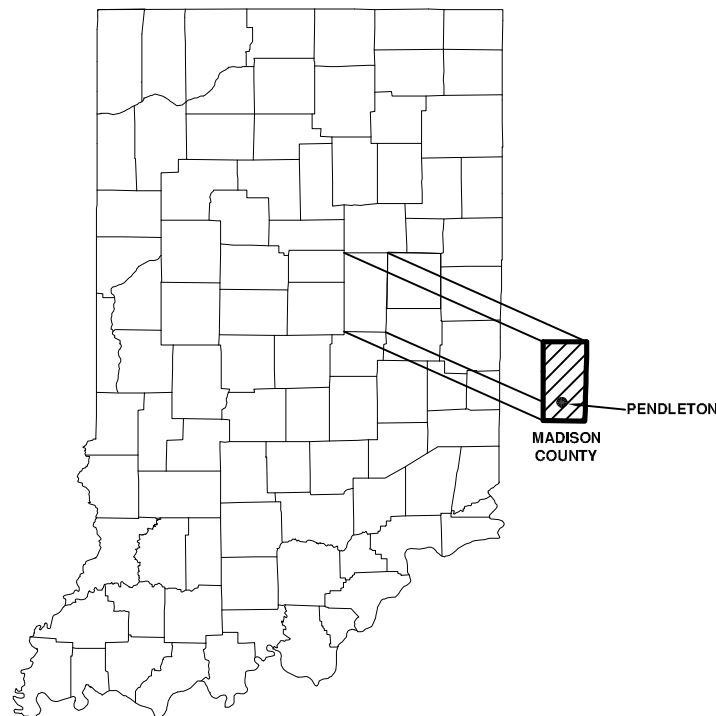

SCALE: 1" = 2,000'

PLAN SET IS FULL SCALE ON 24"X36"
AND HALF SCALE ON 12"X18"

FALL CREEK REGIONAL WASTE DISTRICT
DISTRICT OFFICE
9378 COUNTY ROAD SOUTH 650 WEST
PENDLETON, INDIANA 46064

This document, originally issued, sealed, and signed by George W. Lewis, Indiana Professional Engineer, No. 10403303, on 11.17.2017, shall not be used in lieu of a certified document.

This document, originally issued, sealed, and signed by Joseph P. Tierney, Indiana Professional Engineer, No. 19300407, on 11.17.2017, shall not be used in lieu of a certified document.

GEORGE W. LEWIS, P.E.
INDIANA REG. NO. 10403303

DATE: _____

JOSEPH P. TIERNEY, P.E.
INDIANA REG. NO. 19300407

DATE: _____

NOVEMBER 2017

GRW PROJECT NO. 4625
SRF PROJECT NO. WW16074803