**L.S. DEMOLITION NOTES**

- EXISTING WETWELL - CONTRACTOR SHALL REMOVE EXIST. PUMPING EQUIPMENT AND PIPING AND CONVERT TO MANHOLE AS SHOWN ON SHEET C-03. SEE SHT. C-03 FOR ADDITIONAL RECONSTRUCTION REQUIREMENTS.
- EXISTING VALVE VAULT - CONTRACTOR SHALL REMOVE ALL PIPING FROM STRUCTURE, PLUG PIPE OPENINGS AND REMOVE LID AT TOP OF STRUCTURE TO 2 FT BELOW GRADE AND BACKFILL WITH COMPACTED GRANULAR MATERIAL UP TO BOTTOM OF STONE PAVEMENT.
- REFER TO ELECTRICAL DRAWINGS FOR EXISTING PUMP ELECTRICAL CONTROLS DEMOLITION AND REPLACEMENT REQUIREMENTS.


**SHEET NOTES**

- EXISTING SURFACES SHALL BE RESTORED TO CONDITIONS EQUAL TO OR BETTER THAN ORIGINAL CONDITIONS USING NEW MATERIALS ONLY. ALL DISTURBED GRASS AREAS OUTSIDE OF PROPOSED PAVEMENT LIMITS SHALL BE RE-SEEDED PER SPECIFICATIONS.
- PROVIDE POSITIVE SURFACE WATER DRAINAGE RELIEF AROUND ALL LIFT STATION AND MANHOLE STRUCTURES.
- CONTRACTOR SHALL INSTALL TEMPORARY SILT FENCE AROUND ALL DISTURBED AREAS, INCLUDING STAGING AREAS. REFER TO SPEC. SECTION 02370 AND EROSION CONTROL DETAILS FOR EROSION CONTROL REQUIREMENTS.
- REFER TO ELECTRICAL DRAWINGS FOR SITE ELECTRICAL UPGRADES.

SITE LOCATION COORDINATES			
MARK	NORTHING	EASTING	DESCRIPTION
A	1743161.70	329629.05	PROPOSED VALVE VAULT CENTER
B	1743161.70	329639.05	PROPOSED WETWELL CENTER
C	1743189.12	329635.70	EXISTING VALVE VAULT CENTER
D	1743196.23	329641.51	EXISTING WETWELL CENTER

**Indiana Underground Plant Protection Service****CALL TWO WORKING DAYS  
BEFORE YOU DIG  
IT'S THE LAW  
811****SURFACE LEGEND**


	EXISTING FLOODPLAIN AREA
	EXISTING GRAVEL DRIVE AREA
	PROPOSED ADDITIONAL GRAVEL DRIVE AREA

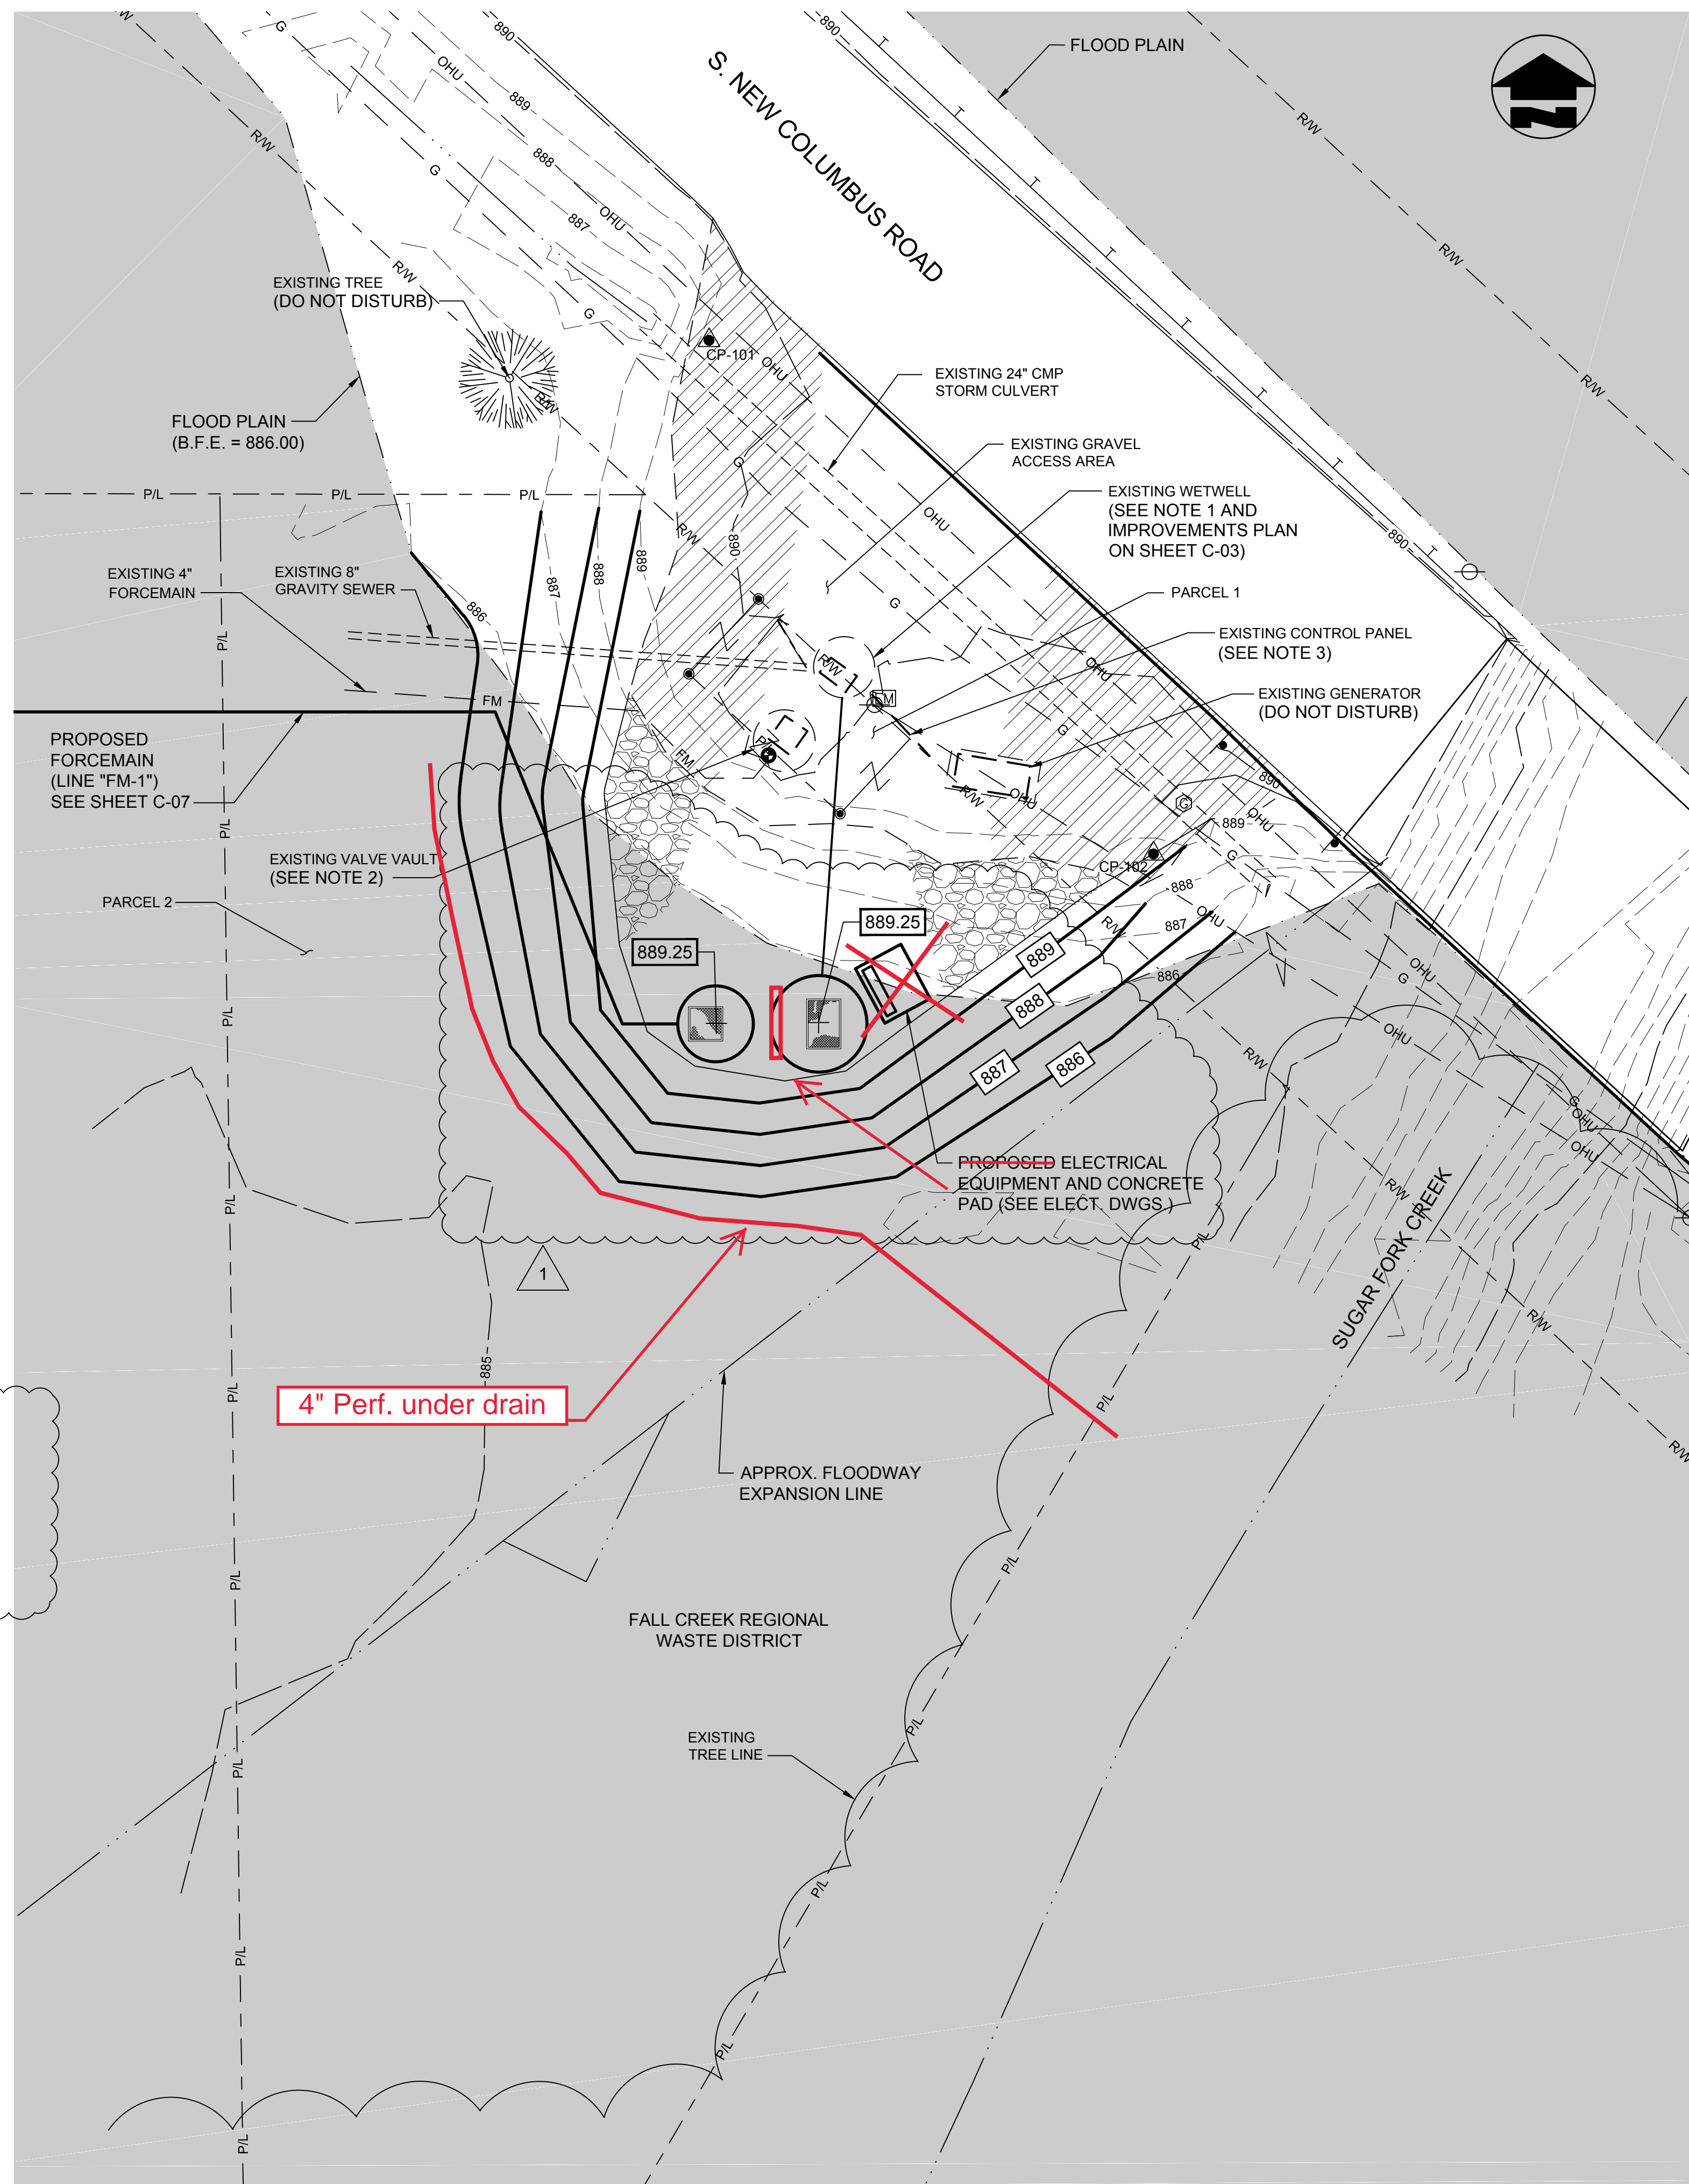

**1 LIFT STATION SITE PLAN**

SCALE: 1"=10'-0"

0 10' 20'

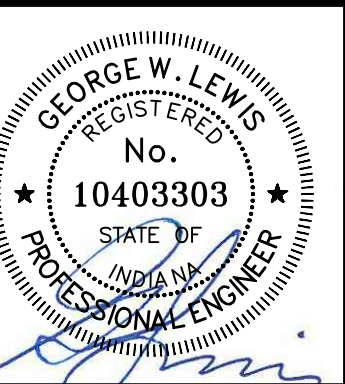

GRW PROJECT NO. 4625

CLIENT PROJECT NO. --

ALL RIGHTS RESERVED. NO PART OF THIS DOCUMENT SHALL BE REPRODUCED IN WHOLE OR IN PART WITHOUT THE WRITTEN PERMISSION OF GEORGE W. LEWIS & ASSOCIATES, INC. AND SHALL NOT BE USED FOR ANY OTHER PROJECT OTHER THAN THIS SPECIFIC PROJECT WITHOUT THE WRITTEN PERMISSION.



engineering | architecture | geospatial

www.grwinc.com

**SITE PLAN**

----

**BABY FARMS LIFT STATION AND FORCE MAIN IMPROVEMENTS**

**FALL CREEK REGIONAL WASTE DISTRICT**

DESIGNED	DATE	BY	DESCRIPTION	NO.	REVIEWED	APPROVED
GWL	1/2018	GWL	RELOCATE PROPOSED LIFT STATION	1		
JAJ						
JPT						
GWL						

DATE: NOVEMBER 2017

SCALE: 1"=10'

SHEET NO.

**C-02**