

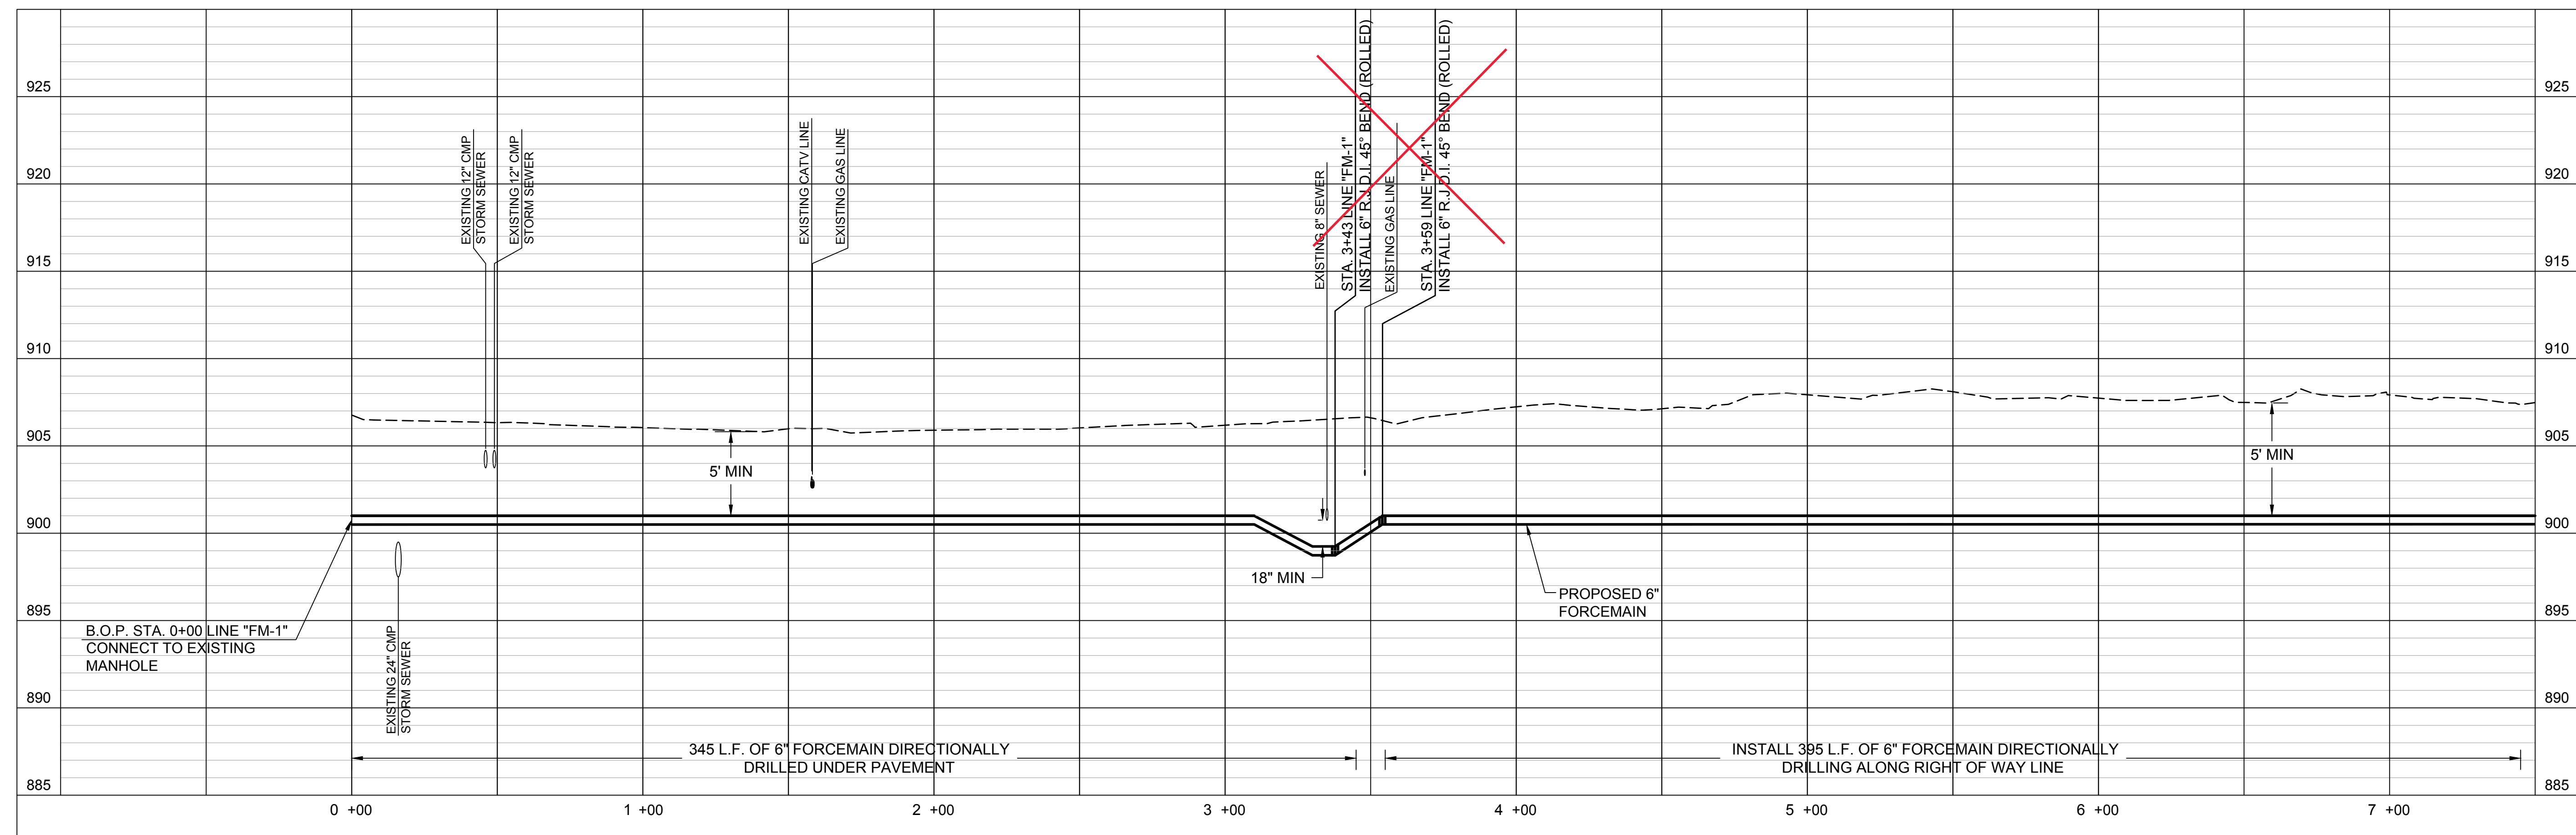
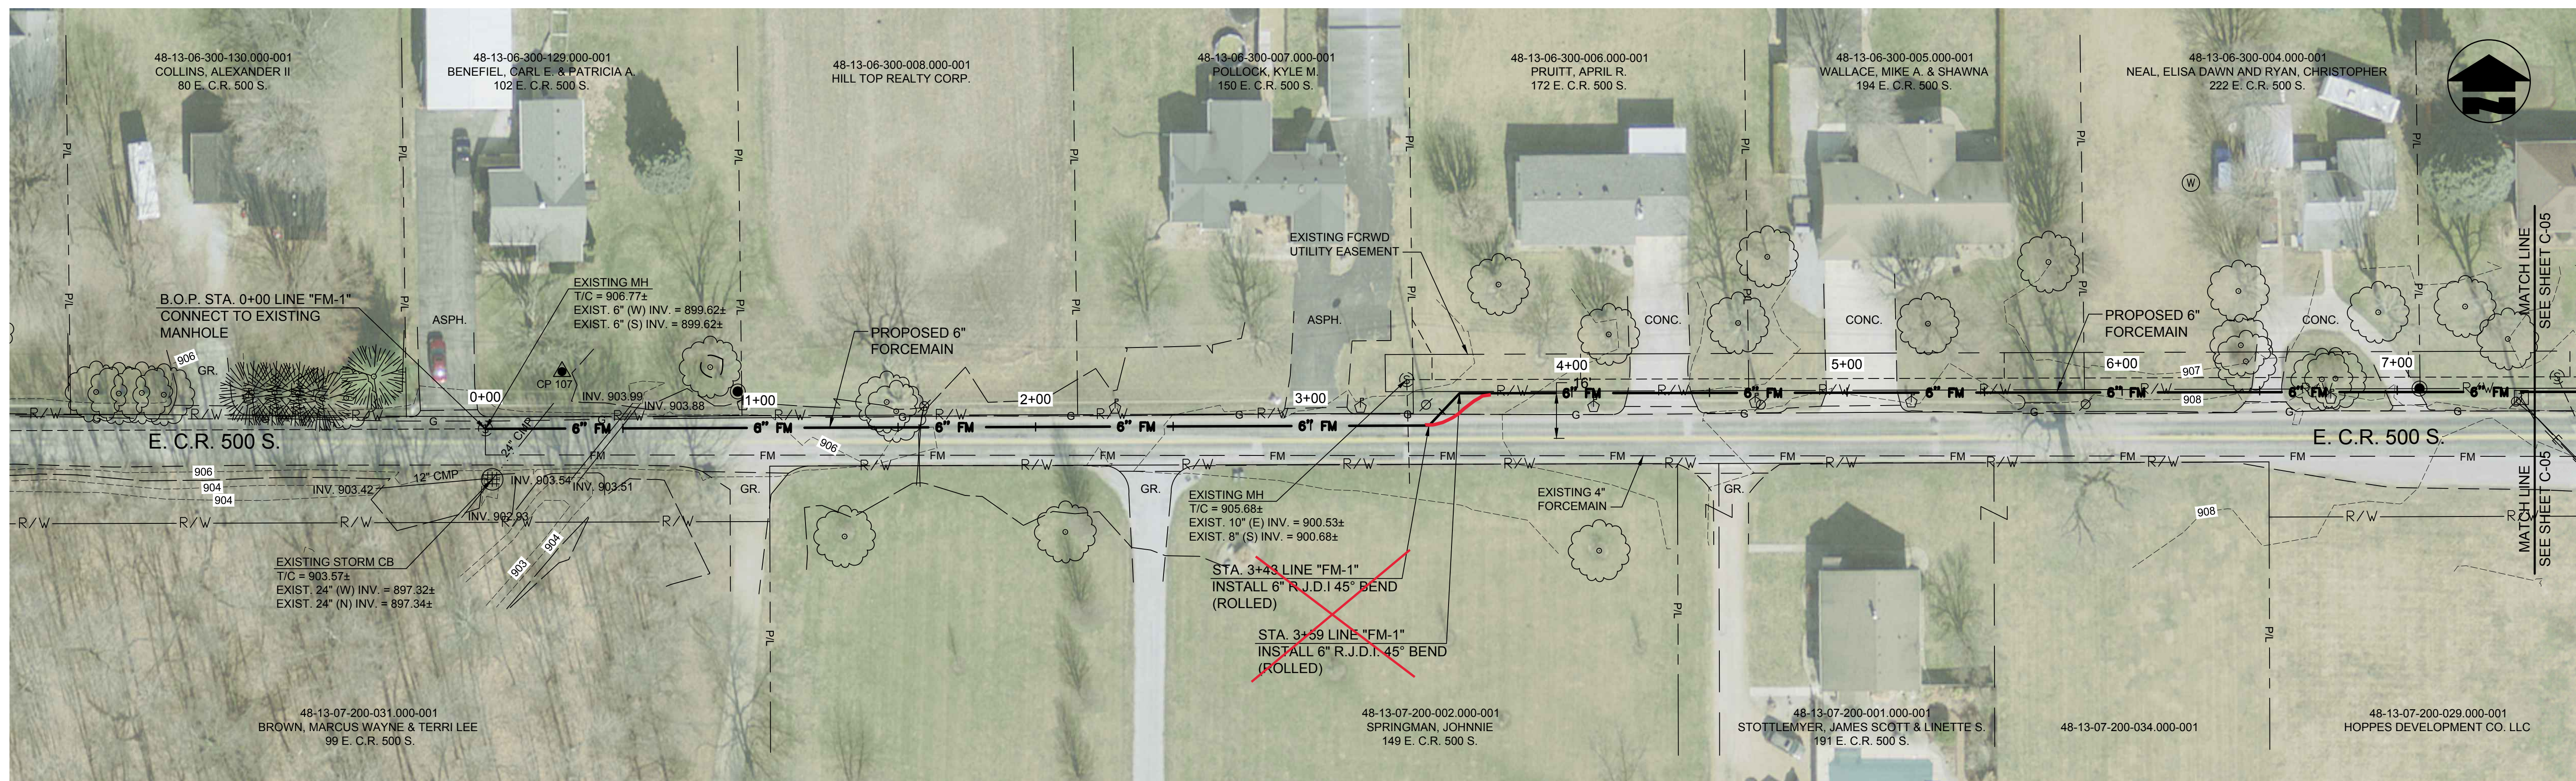


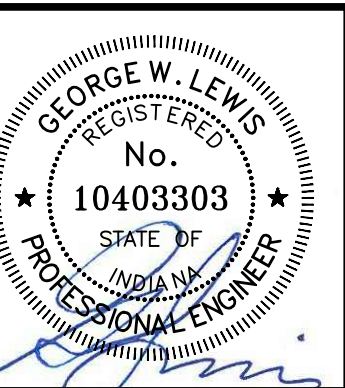


NOTE:
1. INSTALL FORCEMAIN FROM STA. 0+00 TO 21+50
AT CONSISTENT TOP OF PIPE ELEVATION = 901.00
TO AVOID CREATING HIGH POINTS

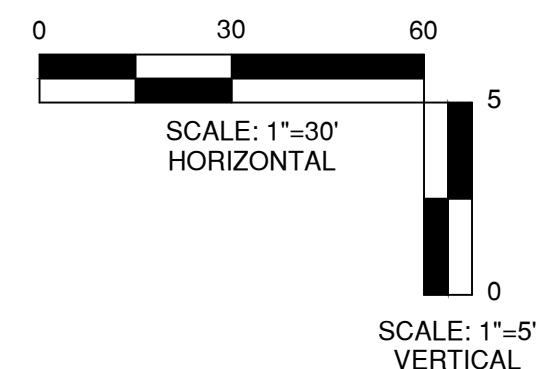

GRW PROJECT NO. 4625

CLIENT PROJECT NO. --

ALL RIGHTS RESERVED.
THIS DOCUMENT IS THE PROPERTY OF
GRW ENGINEERS, INC. AND SHALL NOT
BE REPRODUCED IN WHOLE OR IN PART
OR USED FOR CONSTRUCTION OF
OTHER THAN THIS SPECIFIC PROJECT
WITHOUT WRITTEN PERMISSION

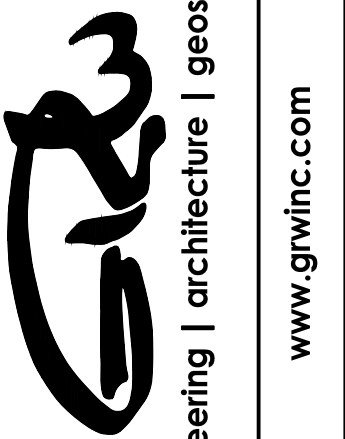

PLAN AND PROFILE

BABY FARMS LIFT STATION AND FORCE MAIN IMPROVEMENTS FALL CREEK REGIONAL WASTE DISTRICT

NO.		RESERVATION	DATE	BY	GWL
					SHAWAN
					JAJ
					JPT
APPROVED:					GWL
SCALE CHECK: _____					THIS MARK SHOULD MEASURE EXACTLY 1" WHEN TIGHT

DATE: NOVEMBER 2017
 TIME: 1:15=30' V: 1:15=5'
 SHEET NO. C-04