


BABY FARMS LIFT STATION AND FORCE MAIN IMPROVEMENTS

FALL CREEK REGIONAL WASTE DISTRICT - PENDLETON, INDIANA

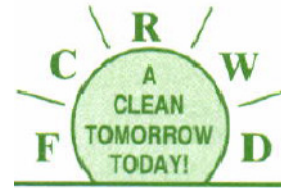

FCRWD MEMBERS

MARK A. JABLONSKI	- PRESIDENT
MICHELLE W. PATISHALL	- VICE PRESIDENT
GREGORY L. VALENTINE	- TREASURER
DAVID K. PADGETT	- SECRETARY
STEPHEN J. BILL	- DEPUTY SECRETARY/TREASURER
TIMOTHY E. GREEN	- BOARD MEMBER
KURT L. KAHL	- BOARD MEMBER
JACK C. WEIST	- BOARD MEMBER
ALBERT B. STEWART	- BOARD MEMBER
TERESA HUTTON	- GENERAL MANAGER
STEVE UNGER	- ATTORNEY




engineering | architecture | geospatial

www.grwinc.com

THIS RECORD DOCUMENT HAS BEEN PREPARED BASED ON INFORMATION PROVIDED BY THE CONSTRUCTION CONTRACTOR, GRW ENGINEERS, INC. HAS ATTEMPTED TO VERIFY THE ACCURACY AND/OR COMPLETENESS OF THIS INFORMATION BUT SHALL NOT BE RESPONSIBLE FOR ANY ERRORS OR OMISSIONS WHICH MAY BE INCORPORATED HEREIN AS A RESULT.

GRW
engineering | architecture | geospatial
ENGINEER/ARCHITECT: GEORGE LEWIS
CONSTRUCTION COMPANY: B.J. BROWN CONSTRUCTION
DATE: 11/2017

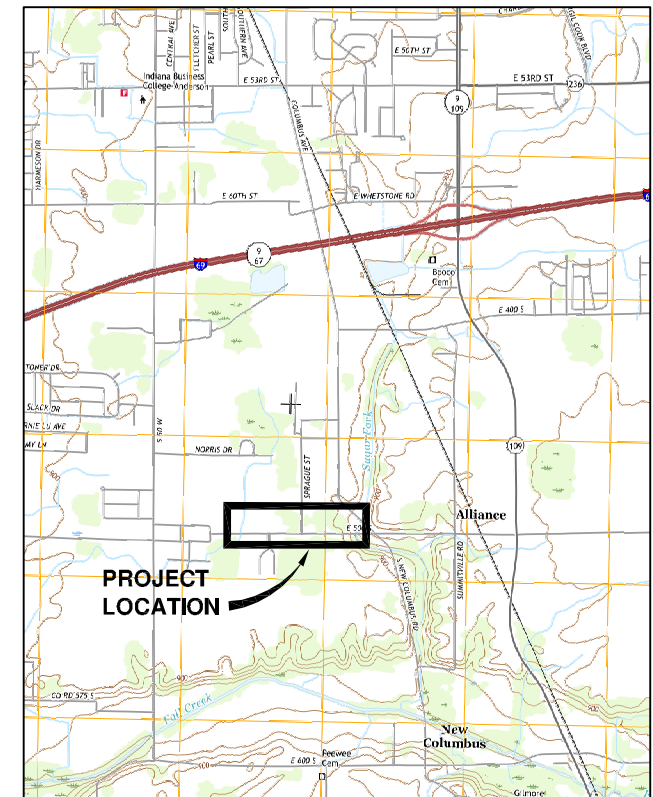

SCALE: 1" = 2,000'

PLAN SET IS FULL SCALE ON 24"X36"
AND HALF SCALE ON 12"X18"

FALL CREEK REGIONAL WASTE DISTRICT
DISTRICT OFFICE
9378 COUNTY ROAD SOUTH 650 WEST
PENDLETON, INDIANA 46064

This document, originally issued, sealed, and signed by George W. Lewis, Indiana Professional Engineer, No. 10403303, on 11.17.2017, shall not be used in lieu of a certified document.

This document, originally issued, sealed, and signed by Joseph P. Tierney, Indiana Professional Engineer, No. 19300407, on 11.17.2017, shall not be used in lieu of a certified document.

GEORGE W. LEWIS, P.E.
INDIANA REG. NO. 10403303

DATE: _____

JOSEPH P. TIERNEY, P.E.
INDIANA REG. NO. 19300407

DATE: _____

NOVEMBER 2017

GRW PROJECT NO. 4625
SRF PROJECT NO. WW16074803

THE FOLLOWING GENERAL NOTES ARE APPLICABLE TO THE ENTIRE SET OF PLANS, AND ARE NOT SHOWN ON EACH INDIVIDUAL SHEET. HOWEVER, THIS DOES NOT RELIEVE THE CONTRACTOR OF ANY RESPONSIBILITY FOR THESE ITEMS IN ALL AREAS.

1. THE UTILITIES AND THEIR LOCATIONS SHOWN ON THESE PLANS ARE APPROXIMATE. THE CONTRACTOR SHALL NOTIFY ALL UTILITY COMPANIES AND VERIFY ALL UTILITIES IN THE FIELD PRIOR TO CONSTRUCTION. THE CONTRACTOR SHALL BE RESPONSIBLE FOR SCHEDULING UTILITY WORK, INCLUDING POLE RELOCATION, AS REQUIRED TO MEET THE PROJECT SCHEDULE. IT SHALL BE THE CONTRACTOR'S RESPONSIBILITY TO AVOID EXISTING UTILITIES AND PERFORM ANY REQUIRED REPAIRS. IN ADDITION TO ALL UTILITY LINES, THE CONTRACTOR SHALL AVOID AND REPAIR ANY DAMAGE TO BURIED FIBER OPTIC CABLE, FIELD DRAINAGE TILES, AND PRIVATE IRRIGATION SYSTEMS. THE CONTRACTOR SHALL NOTIFY THE OWNER WHEN UTILITIES OR OTHER SUBSURFACE LINES ARE DAMAGED.

2. UTILITY POLES ARE SHOWN ON THE PLANS, BUT OVERHEAD LINES HAVE BEEN OMITTED FOR CLARITY. PRIOR TO THE COMMENCEMENT OF CONSTRUCTION, THE CONTRACTOR SHALL VERIFY THE LOCATION OF OVERHEAD OBSTRUCTIONS, ESPECIALLY OVERHEAD ELECTRIC LINES.

3. THE CONTRACTOR IS RESPONSIBLE FOR RELOCATING, ADJUSTING, AND/OR HOLDING ANY UTILITY LINE AND/OR ASSOCIATED SERVICE POLE, OR DOWN GUY AT HIS OWN EXPENSE. HE SHALL ALSO BE RESPONSIBLE TO CONTACT ANY UTILITY OWNER AS NECESSARY TO RESOLVE ALL UTILITY CONFLICTS INCURRED DURING THE COMPLETION OF HIS CONSTRUCTION OPERATIONS

4. UNLESS OTHERWISE NOTED, CONTRACTOR SHALL TAKE ALL NECESSARY PRECAUTIONS TO AVOID DISTURBANCE, DAMAGE, OR REMOVAL OF EXISTING TREES/VEGETATION WITHIN CONSTRUCTION LIMITS, INCLUDING CANOPIES, TRUNKS, AND ROOTS. IF DAMAGE OR REMOVAL IS NON-AVOIDABLE, CONTRACTOR SHALL OBTAIN APPROVAL FROM OWNER PRIOR TO INSTALLATION WITHIN AFFECTED AREA.

5. ALL DISTURBED GRASS AREAS SHALL BE RESTORED WITH TOPSOIL, SEED MIX AND STRAW AS PER SPECIFICATIONS SECTION 02920. ALL DISTURBED AREAS SHALL BE RESTORED TO EQUAL TO OR BETTER THAN ORIGINAL CONDITIONS. RESTORATION SHALL BE PERFORMED TO THE SATISFACTION OF THE OWNER, THE ENGINEER, OR THEIR REPRESENTATIVES.

6. ALL MATERIALS AND WORKMANSHIP SHALL COMPLY WITH ALL APPLICABLE CODES, SPECIFICATIONS, LOCAL ORDINANCES, INDUSTRY STANDARDS, AND UTILITY COMPANY REGULATIONS.

7. HORIZONTAL OR VERTICAL BENDS, WHERE NOTED ON THE DRAWINGS, ARE PROVIDED FOR CLARIFICATION PURPOSES ONLY, AND ARE NOT ALL-INCLUSIVE. CONTRACTOR SHALL BE RESPONSIBLE FOR DETERMINING QUANTITY, LOCATION, AND ORIENTATION OF BENDS AND OFFSETS ALONG FORCE MAIN ROUTE TO MAINTAIN ALIGNMENT, MINIMUM DEPTH OF COVER AND MINIMUM REQUIRED CLEARANCES FROM EXISTING AND PROPOSED UTILITIES. AS WELL AS MINIMUM PIPE BENDING RADIUS AND JOINT DEFLECTION REQUIREMENTS FOR THE PIPE AND FITTINGS BEING USED.

8. CONTRACTOR SHALL CLEAN STREETS OF CONSTRUCTION DEBRIS DAILY TO THE SATISFACTION OF THE OWNER AND ENGINEER. CONTRACTOR SHALL FURTHER ENSURE THAT AT LEAST ONE LANE OF TRAFFIC IS OPEN AT ALL TIMES DURING CONSTRUCTION ALONG ROADWAYS UNLESS THE CONTRACTOR HAS WRITTEN APPROVAL AND AN APPROVED TRAFFIC MAINTENANCE PLAN. CONTRACTOR SHALL NOT CLOSE ANY LANE OF A STATE HIGHWAY WITHOUT INDOT APPROVAL.

9. CONTRACTOR SHALL NOTIFY OWNER, ENGINEER, LAW ENFORCEMENT & EMERGENCY SERVICES, SCHOOL DISTRICT, TRASH PICK-UP SERVICE, AND AFFECTED RESIDENTS 48 HOURS PRIOR TO TEMPORARILY CLOSING ANY LANES OF TRAFFIC, INCLUDING PRIVATE DRIVEWAYS. PRIVATE DRIVEWAYS TO BE DISTURBED AND REPAIRED SHALL NOT BE SHUT DOWN LONGER THAN 8 HOURS. TRAFFIC SHALL BE BARRICADED FROM DRIVEWAY OR DRIVEWAY SHALL BE STEEL PLATE SPANNED TO ALLOW FOR MINIMUM CURING TIME. COMPLY WITH CITY REQUIREMENTS TO RECEIVE PERMIT APPROVAL FOR ALL WORK WITHIN CITY RIGHT-OF-WAY.

10. STREET LINES AND PROPERTY LINES SHOWN ON THIS PLAN ARE NOT THE RESULT OF DEED RESEARCH BUT TO BE CONSIDERED APPROXIMATE AND FOR REFERENCE ONLY.

11. UNLESS OTHERWISE NOTED, HORIZONTAL DIMENSIONING OF NEW FORCEMAINS ARE REFERENCED OFF THE EXISTING CENTERLINE OF ROAD (OR TRAIL OR RAILROAD) AND NEW FORCE MAIN SHALL BE INSTALLED AT THE UNIFORM HORIZONTAL DISTANCE BETWEEN SUCCESSIVE HORIZONTAL DIMENSIONS AS SHOWN ON THE PLANS. BASELINE STATIONING IS ALONG THE CENTERLINE OF THE NEW FORCEMAIN.

12. LIMITS OF CONSTRUCTION SHALL BE MAINTAINED WITHIN RIGHT-OF-WAY, DENOTED EASEMENTS AND PERMITTED AREAS. THERE ARE FOUR (4) DENOTED AREAS ALONG THE ROUTE OF THE 16" FORCEMAIN THAT ARE WITHIN IDENTIFIED ARCHEOLOGICAL AREAS. IN THESE AREAS THE CONTRACTOR SHALL ERECT SILT FENCES AT THE CONSTRUCTION LIMITS NOTED AND ONLY DISTURB THE SURFACE WITHIN THE CONSTRUCTION LIMIT AREA. THE CONTRACTOR SHALL INSURE THAT CONSTRUCTION DOES NOT DAMAGE ADJACENT PUBLIC OR PRIVATE PROPERTY. MAIN LINE EASEMENTS SHOWN ON THE DRAWINGS TYPICALLY INCLUDE TEMPORARY CONSTRUCTION EASEMENTS. OTHER TEMPORARY EASEMENTS, IF NECESSARY, SHALL BE THE RESPONSIBILITY OF THE CONTRACTOR.

13. VERTICAL DATUM = NAVD 1988, U. S. SURVEY FEET; HORIZONTAL DATUM = NAD 1983 INDIANA STATE PLANE COORDINATE SYSTEM, EAST ZONE, U. S. SURVEY FEET. ALL INFORMATION REGARDING HORIZONTAL AND VERTICAL CONTROL ARE BASED ON BEST INFORMATION AVAILABLE UTILIZING RECORD DRAWINGS OF THE SITE. THE ENGINEER DOES NOT GUARANTEE OR ASSURE THAT SUCH INFORMATION IS TRUE. THE CONTRACTOR SHALL DETERMINE WHICH CONTROLS CONFLICT WITH HIS WORK AND VERIFY THOSE ELEVATIONS, ETC. AND ADJUST HIS WORK ACCORDINGLY TO MAINTAIN PROPOSED ELEVATIONS RELATIVE TO THOSE VERIFIED, AND NOTIFY THE ENGINEER OF ANY SUCH CHANGE FOR APPROVAL.

14. CONTRACTOR SHALL COORDINATE ALL WORK WITH THE APPROPRIATE AGENCY HAVING AUTHORITY SUCH AS MADISON COUNTY HIGHWAY DEPARTMENT. AND ANY OTHER UNDERGROUND UTILITIES WITHIN THE PROJECT AREA.

15. UNLESS OTHERWISE NOTED ON THE PROFILE DRAWINGS AS A MINIMUM CLEARANCE, THE DEPTHS INDICATED ARE FOR REFERENCE ONLY. MINIMUM DEPTH OF COVER OF PROPOSED FORCEMAIN IS 5 FEET FOR ALL OPEN CUT INSTALLATIONS AND 5 FEET FOR ALL HORIZONTAL DIRECTIONAL DRILLING INSTALLATIONS. CONTRACTOR SHALL VARY DEPTH OF PROPOSED FORCEMAIN (NOT TO EXCEED 7 FT. MAX. COVER. DEPTH WITHOUT PRIOR APPROVAL FROM ENGINEER AND OWNER) AS NECESSARY TO AVOID EXISTING UTILITIES, TRANSITION BETWEEN OPEN CUT TO HORIZONTAL DIRECTIONAL DRILLING AND OTHERWISE AVOID CREATION OF HIGH SPOTS ALONG ROUTE, EXCEPT WHERE AIR RELEASE VALVES ARE SHOWN ON DRAWINGS.

16. CONTRACTOR SHALL BE RESPONSIBLE FOR MAINTAINING AN 18" MINIMUM VERTICAL SEPARATION OR A 10' MINIMUM HORIZONTAL SEPARATION BETWEEN STORM SEWER LINES, SANITARY SEWER LINES AND WATER MAINS, UNLESS OTHERWISE NOTED. PRIOR TO ANY COMPROMISE OF THESE REQUIREMENTS, WRITTEN APPROVAL SHALL BE OBTAINED FROM THE OWNER. IN THE EVENT THE SPECIFIED SPACING CANNOT BE IMPLEMENTED, PROPOSED JOINTS SHALL BE LOCATED AS FAR AS POSSIBLE FROM THE CONFLICT WHENEVER POSSIBLE. ALL UTILITY CROSSINGS SHOULD MAINTAIN MINIMUM 0 12" CLEARANCE..

17. ALL BENDS, VALVES, TEES AND FITTINGS SHALL BE RESTRAINED AS NEEDED PER THE FIELD CONDITIONS, SOIL TYPES AND PIPE MATERIAL BEING USED.

18. CONTRACTOR SHALL BE RESPONSIBLE FOR MONITORING FLOW AND PROVIDING BYPASS PUMPING AS REQUIRED DURING CONSTRUCTION OPERATIONS. SUCH FLOW SHALL BE MONITORED SO AS NOT TO ALLOW SEWAGE BACK-UP WHICH MAY CAUSE PROPERTY DAMAGE. THE CONTRACTOR IS FULLY RESPONSIBLE FOR ANY DAMAGE INCURRED AND MUST MAKE RESTITUTION WITH ANY AFFECTED PROPERTY OWNER(S).

19. THE EXISTING GRAVITY SEWERS, LIFT STATIONS & FORCEMAINS SHALL REMAIN IN CONTINUOUS SERVICE THROUGHOUT THE CONSTRUCTION PERIOD UNTIL SUCCESSFUL START-UP OF THE PROPOSED FACILITIES. CONTRACTOR SHALL PROVIDE CONTINUOUS ON-SITE SUPERVISION OF ANY BYPASS PUMPING OPERATIONS THAT OCCUR DURING CONSTRUCTION & NON-CONSTRUCTION HOURS. PROPOSED BYPASS SYSTEM SHALL INCLUDE EMERGENCY STANDBY/BACK-UP PROVISIONS AND SHALL BE APPROVED BY THE OWNER AT LEAST TWO (2) FULL WORKING DAYS IN ADVANCE OF INITIATING ANY BYPASS OPERATIONS. REFER TO SPEC. SECTION 0125.

20. EXISTING PIPELINE MATERIALS ARE NOT KNOWN FOR ALL LOCATIONS OF CONSTRUCTION. CONTRACTOR SHALL PROVIDE ALL NECESSARY FITTINGS, GASKETS, APPURTENANCE, ETC. WHICH ARE REQUIRED TO MAKE A COMPLETE CONNECTION.

21. FCRWD WILL BE RESPONSIBLE FOR CLOSING ALL VALVES ON EXISTING SYSTEM. THE CONTRACTOR SHALL COORDINATE ALL WORK EFFORTS WITH THE OWNER.

21. THE CONTRACTOR SHALL REPAIR ANY DAMAGES CAUSED BY CONSTRUCTION EQUIPMENT, TRUCKS, ETC. THIS INCLUDES BUT IS NOT LIMITED TO ASPHALT TRAIL, ROADS, SIDEWALKS, ETC.

ELECTRIC
CITY OF ANDERSON LIGHT AND POWER
765-648-6480

GAS
VECTREN ENERGY
1-800-227-1376

CABLE/PHONE/INTERNET
COMCAST
317-774-3384

AT&T DISTRIBUTION
260-358-4507

ROADS
MADISON CO HIGHWAY DEPT: 765-646-9240

SEWER
FALL CREEK REGIONAL WASTE DISTRICT
765-778-7544

SHEET NUMBER	SHEET TITLE
GENERAL	
--	COVER SHEET
G-00-002	GENERAL NOTES AND INDEX OF DRAWINGS
G-00-003	SYMBOLS LEGEND
CIVIL	
C-01	SURVEY CONTROL
C-02	SITE PLAN
C-03	LIFT STATION PLANS
C-04	PLAN AND PROFILE LINE "FM-1:
C-05	PLAN AND PROFILE LINE "FM-1:
C-06	PLAN AND PROFILE LINE "FM-1:
C-07	PLAN AND PROFILE LINE "FM-1:
C-08	STANDARD DETAILS
C-09	STANDARD DETAILS
C-10	EROSION CONTROL DETAILS
C-11	EROSION CONTROL DETAILS
ELECTRICAL	
E-001	STANDARD ELECTRICAL SYMBOLS
E-101	BABY FARMS LIFT STATION ELECTRICAL SITE PLAN
E-102	BABY FARMS LIFT STATION ELECTRICAL PLAN
E-501	MISCELLANEOUS ELECTRICAL DETAILS I
E-701	BABY FARMS LIFT STATION CIRCUIT CONTROLS I
E-702	BABY FARMS LIFT STATION CIRCUIT CONTROLS II
INSTRUMENTATION	
I-001	INSTRUMENTATION STANDARD SYMBOLS AND LEGEND
I-501	INSTRUMENTATION DETAILS
I-601	LOOP DIAGRAMS I




**CALL TWO WORKING DAYS
BEFORE YOU DIG
IT'S THE LAW
811**

GRW PROJECT NO. 4625

CLIENT PROJECT NO. --

ALL RIGHTS RESERVED:
THIS DOCUMENT IS THE PROPERTY OF
GRW ENGINEERS, INC. AND SHALL NOT
BE REPRODUCED IN WHOLE OR IN PART
OR USED FOR CONSTRUCTION OF
OTHER THAN THIS SPECIFIC PROJECT
WITHOUT WRITTEN PERMISSION

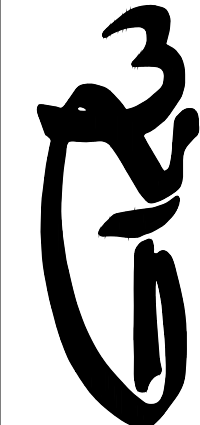

engineering | architecture | geospatial

www.grwinc.com

DRAWING INDEX AND GENERAL NOTES

BABY FARMS LIFT STATION AND FORCE MAIN IMPROVEMENTS FALL CREEK REGIONAL WASTE DISTRICT

REVISIONS				DESIGNED:
NO.	DESCRIPTION	DATE	BY	GWL
1	AS SHOWN			DRAWN
				JAJ
				REVIEWED
				JPT
				APPROVES
SCALE CHECK				GWL

DATE: NOVEMBER 2017

SCALE:

N.T.S.

SHEET NO.

G-01

ABBREVIATIONS


AB	ANCHOR BOLT	HB	HOSE BIBB
ABAND	ABANDONED	HCS	HOLLOW CORE SLAB
ABS	ABSOLUTE	HD	HEAD, HEAVY DUTY
ACoust	ACOUSTICAL	HDN	HARDEN
ADD	ADDENDUM	HDW	HARDWARE
ADDL	ADDITIONAL	HDWL	HEADWALL
ADM	ADMINISTRATION	HGR	HANGER
AFF	ABOVE FINISH FLOOR	HM	HOLLOW METAL
AGG	AGGREGATE	HOL	HOLLOW
AHR	ANCHOR	HORIZ	HORIZONTAL
AL	ALUMINUM	HP	HORSEPOWER
ALT	ALTERNATE	HPT	HIGH POINT
APPROX	APPROXIMATE	HR	HOOR
ARCH	ARCHITECTURAL	HT	HEIGHT
ASB	ASBESTOS	HTR	HEATER
AUX	AUXILIARY	HVY	HEAVY
AVG	AVERAGE	HW	HOT WATER
AWG	AMERICAN WIRE GAGE	HWL	HOT WATER LEVEL
		HWY	HIGHWAY
		HYD	HYDRAULIC
BC	BOLT CIRCLE	IAS	INTERCHANGE ACTIVATED SLUDGE
BD	BOARD	IASFM	INTERCHANGE ACTIVATED SLUDGE
BETW	BETWEEN	ID	FORCE MAIN
B'FLY	BUTTERFLY	IFMA	INSIDE DIAMETER
BHP	BRAKE HORSEPOWER	IFM	INFLUENT FORCE MAIN
BIT	BITUMINOUS	ILLUS	ILLUMINATE
BL	BASE LINE, BUILDING LINE	IN	ILLUSTRATE
BLDG	BUILDING	INCH	INCH
BLK	BLOCK	INCR	INCREASER
BM	BENCH MARK, BEAM	INFL	INFLUENT
BOT	BOTTOM	INSUL	INSULATION
BP	BASE PLATE	INT	INTERIOR
BRG	BEARING	INV	INVERT
BSMT	BASEMENT	ITI	INTERCHANGE TANK INFLUENT
BTU	BRITISH THERMAL UNIT	JT	JOINT
BU	BUILT UP	JCT	JUNCTION
BW	BOTH WAYS		
BYP	BYPASS		
C	CENTIGRADE	KG	KILOGRAM
CAP	CAPACITY	KM	KILOMETER
CB	CATCH BASIN	KV	KILOVOLT
CE	CLARIFIER EFFLUENT	KVA	KILOVOLT - AMPERE
CER	CERAMIC	KVAH	KILOVOLT - AMPERE HOUR
CFM	CUBIC FEET PER MINUTE	KW	KILOWATT
CFS	CUBIC FEET PER	KWH	KILOWATT HOUR
CHK	CHECK		
CHKR	CHECKERED		
CI	CLARIFIER INFLUENT	L	LEFT, LONG
CIP	CAST IRON PIPE	LAB	LABORATORY
CJ	CONSTRUCTION JOINT	LAM	LAMINATE
CL	CENTER LINE	LBS	POUNDS
CLG	CEILING	LDG	LOADING
CLO	CLOSET	LF	LINEAR FOOT
CLR	CLEAR	LG	LENGTH
CMU	CONCRETE MASONRY UNIT	LH	LEFT HAND
CO	COMPANY	LL	LIVE LOAD
COL	COLUMN	LLH	LONG LEG HORIZONTAL
CONC	CONCRETE	LLV	LONG LEG VERTICAL
CONSTR	CONSTRUCTION	LPT	LOW POINT
CONT	CONTINUOUS	LS	LUMP SUM
CONTR	CONTRACTOR	LW	LONG WAY
CPLG	COUPLING		
CJ	CONTROL JOINT	MATL	MATERIAL
CTR	CENTER	MAX	MAXIMUM
CU	CUBIC	ME	MATCH EXISTING
CV	CLOCKWISE	MECH	MECHANICAL
		MED	MEDIUM
D	DEPTH	MFR	MANUFACTURER
DBL	DOUBLE	MGD	MILLION GALLONS PER DAY
DET	DETAIL	MH	MANHOLE
DF	DRINKING FOUNTAIN	MIN	MINIMUM
DI	DUCTILE IRON	MISC	MISCELLANEOUS
DIA	DIAMETER	MJ	MECHANICAL JOINT
DIM	DIMENSION	MO	MASONRY OPENING
DIP	DUCTILE IRON PIPE	MP	MELTING POINT
DIR	DIRECTION	MTD	MOUNTED
DISTR	DISTRIBUTION	MTG	MOUNTING
DIV	DIVISION	MTL	METAL
DL	DEAD LOAD		
DN	DOWN	N	NORTH
DR	DRAIN	NATL	NATIONAL
DWG	DRAWING	NEG	NEGATIVE
		NET	NETWORK
E	EAST	NEUT	NEUTRAL
EA	EACH	NIC	NOT IN CONTRACT
EF	EACH FACE	NO	NUMBER
EFL	EFFLUENT	NOM	NOMINAL
EJ	EXPANSION JOINT	NPT	NATIONAL PIPE THREAD
ELEC	ELECTRIC	NPW	NON-POTABLE WATER
ELEV	ELEVATION	NR	NITRATE RECYCLE
ELL	ELBOW	NRFM	NITRATE RECYCLE FORCE MAIN
ENCL	ENCLOSE	NBS	NOT TO SCALE
EQ	EQUAL		
EQUIP	EQUIPMENT	OBS	OBSOLETE
EW	EACH WAY	OC	ON CENTER
EXIST	EXISTING	OD	OUTSIDE DIAMETER
EXP	EXPANSION	ODE	OXIDATION DITCH EFFLUENT
EXT	EXTERIOR	ODI	OXIDATION DITCH INFLUENT
		OF	OUTSIDE FACE
FD	FLOOR DRAIN	OH	OVAL HEAD
FDN	FOUNDATION	OPER	OPERATED
FIN	FINISH	OPNG	OPENING
FL	FLOOR	OPF	OPPOSITE
FLEX	FLEXIBLE	ORF	ORIFICE
FLG	FLANGE, FLANGED	ORG	ORIGINAL
FR	FRAME	OVHD	OVERHEAD
FT	FOOT	OVL	OVERLOAD
FTG	FOOTING	OZ	OUNCE
G	GROUNDED	PC	PIECE
GAL	GALLON	PCF	POUNDS PER CUBIC FOOT
GALV	GALVANIZED	PE	PLAIN END
GEN	GENERATOR	PEJ	PREMOLDED EXPANSION JOINT
GENL	GENERAL	PERM	PERMANENT
GL	GLASS	PERP	PERPENDICULAR
GND	GROUND	PH	PHASE
GR	GRADE	PI	PLANT INFLUENT
GRTG	GRATING	PKG	PACKING
GSKT	GASKET	PL	PLATE
GYP	GYP SUM	PNEU	PNEUMATIC
GYP	GYP SUM WALLBOARD		

PO	PUSH ON	RAN	RANGE
POL	POLISH	RAD	RADIUS
POS	POSITION	RAS	RETURN ACTIVATED SLUDGE
PREFAB	PREFABRICATED	RASFM	RETURN ACTIVATED SLUDGE
PRESS	PRESSURE	RASFMA	RETURN ACTIVATED SLUDGE
PRI	PRIMARY	RCPT	RECEPTACLE
PS	PUMP STATION	RD	ROOF DRAIN
PSF	POUNDS PER SQUARE FOOT	RDCR	REDUCER
PSI	POUNDS PER SQUARE INCH	RECD	RECEIVED
PSIG	POUNDS PER SQUARE INCH GAUGE	REF	REFERENCE
PT	POINT	REFG	REFRIGERATOR
PTD	PAINTED	REINF	REINFORCE
PVC	POLYVINYL CHLORIDE	REM	REMAINDER
PWR	POWER	REPL	REPLACE
		REQD	REQUIRED
QT	QUART	RESIL	RESILIENT
QTY	QUANTITY	REV	REVISION
		RJ	RESTRAINED JOINT
		RM	ROOM
		RND	ROUND
		RPM	REVOLUTIONS PER MINUTE
S	SOUTH	SC	SCUM
SC	SCUM	SCFM	SCUM FORCE MAIN
SCFM	SCUM FORCE MAIN	SCH	SCHEDULE
SCH	SCHEDULE	SEC	SECOND
SEC	SECOND	SECT	SECTION
SECT	SECTION	SEQ	SEQUENCE
SFT	SHAFT	SHT	SHIELD
SHLD	SHIELD	SIM	SIMILAR
SHT	SHEET	SK	SKETCH
SIM	SIMILAR	SOL	SOLENOID
SK	SKETCH	SPCS	SPACES
SOL	SOLENOID	SPEC	SPECIFICATIONS
SPCS	SPACES	SP GR	SPECIFIC GRAVITY
SPEC	SPECIFICATIONS	SP HT	SPECIFIC HEAT
SP GR	SPECIFIC GRAVITY	SPRT	SUPPORT
SP HT	SPECIFIC HEAT	SQ	SQUARE
SUPPORT	SUPPORT	SST	STAINLESS STEEL
SQ	SQUARE	S/S	SERVICE SINK
SST	STAINLESS STEEL	SS	SANITARY SEWER
S/S	SERVICE SINK	STA	STATION
SS	SANITARY SEWER	STD	STANDARD
STA	STATION	STIR	STIRRUP
STD	STANDARD	STL	STEEL
STIR	STIRRUP	STM	STORM
STL	STEEL	STRUCT	STRUCTURE
STM	STORM	SUSP	SUSPENDED
STRUCT	STRUCTURE	SW	STORM WATER
SUSP	SUSPENDED	SYM	SYMBOL
SW	STORM WATER	SYMM	SYMMETRICAL
SYM	SYMBOL		
SYMM	SYMMETRICAL		
T	TOP		
T&B	TOP AND BOTTOM		
TECH	TECHNICAL		
TEMP	TEMPERATURE, TEMPERED		
THEO	THEORETICAL		
THD	THREAD		
THRES	THRESHOLD		
THRU	THROUGH		
TOF	TOP OF FOOTING		
TOL	TOLERANCE		
TOS	TOP OF STEEL		
TOT	TOTAL		
TRANS	TRANSFER		
TW	TOP OF WALL		
TYP	TYPICAL		
UNIF	UNIFORM		
UON	UNLESS OTHERWISE NOTED		
UV	ULTRAVIOLET		
V	VOLT		
VAC	VACUUM		
VCT	VINYL COMPOSITION TILE		
VCP	VITRIFIED CLAY PIPE		
VERT	VERTICAL		
VISC	VISCOSITY		
VLR	VERTICAL LOOP REACTOR		
VLR	VERTICAL LOOP REACTOR EFFLUENT		
VS	VERSUS		
VTR	VENT THROUGH ROOF		
W	WEST, WIDTH		
W/	WITH		
WAS	WASTE ACTIVATED SLUDGE		
WD	WOOD		
WDW	WINDOW		
WG	WIRE GAGE		
WL	WATER LEVEL		
WPG	WATERPROOFING		
WR	WATER RESISTANT		
WS	WASTE SLUDGE		
WSDR	WASTE SLUDGE DRAIN		
WSE	WATER SURFACE ELEVATION		
WWF	WELDED WIRE FABRIC		
YD	YARD		
YP	YIELD POINT		
YR	YEAR		

MATERIALS - PLAN/SECTION

	EARTH
	CRUSHED STONE
	STRUCTURAL CONCRETE
	GROUT, PLASTER OR SAND
	ASPHALT PAVEMENT

BUBBLE & SECTIONING CONVENTIONS

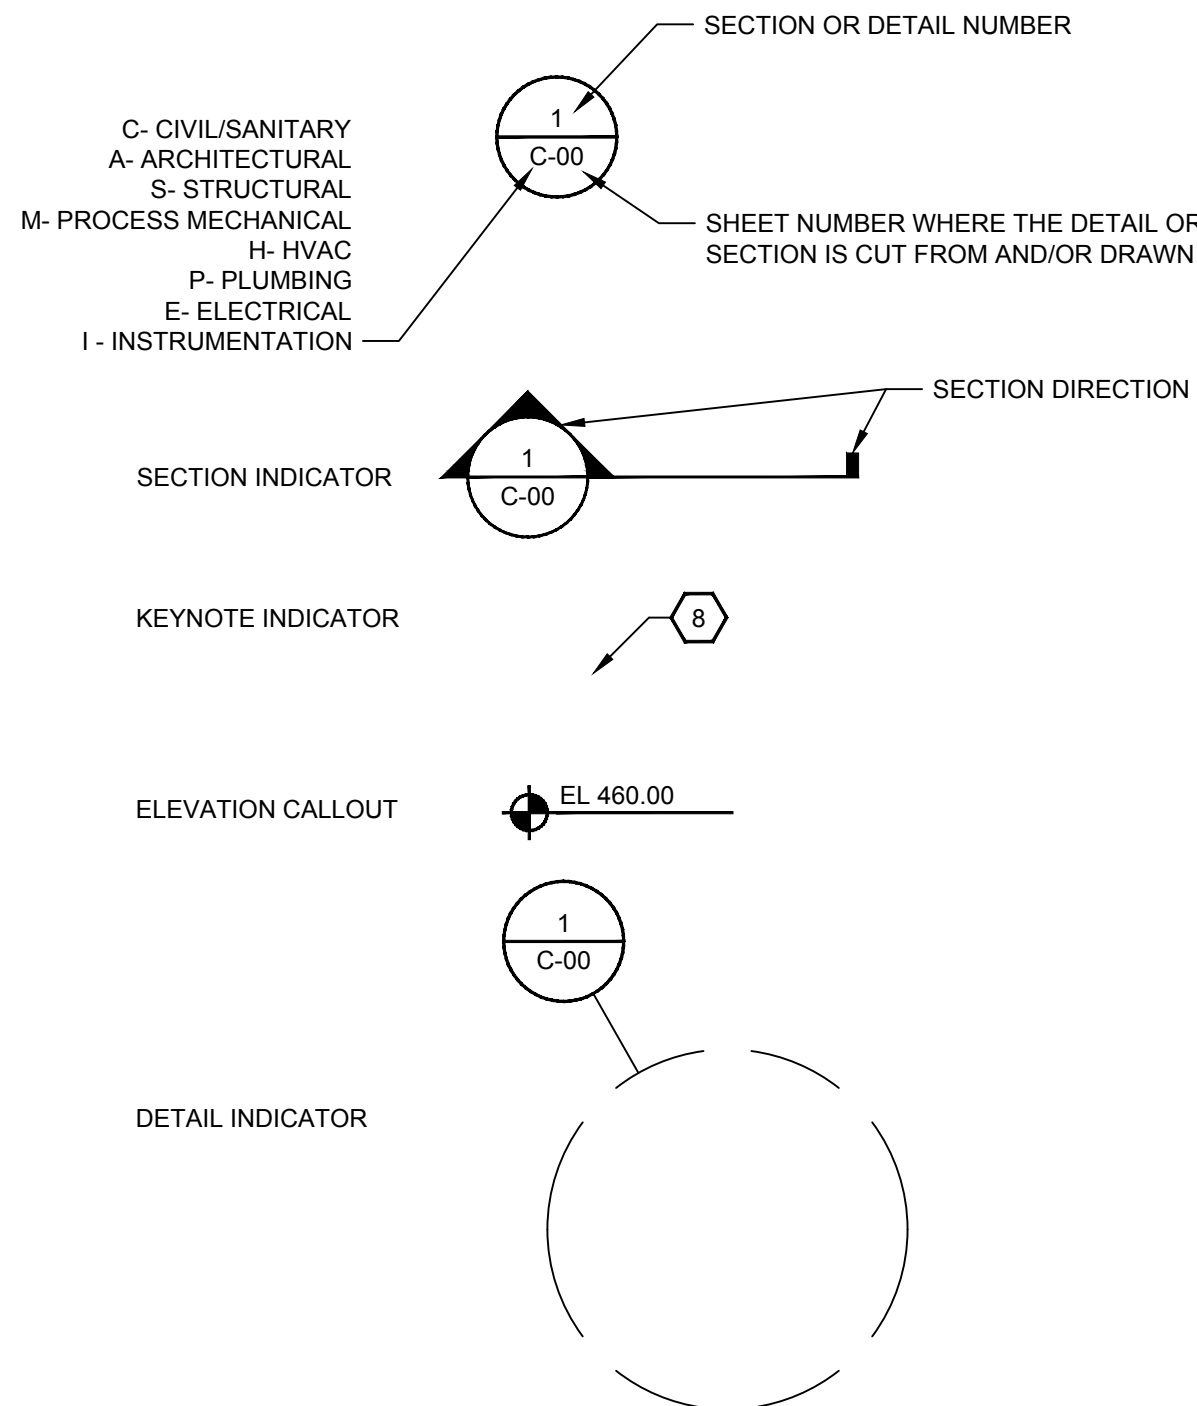

NOTE: SYMBOLS, MATERIALS AND ABBREVIATIONS MAY NOT BE ALL-INCLUSIVE. SYMBOLS USED BUT NOT LISTED HEREIN MAY BE DEFINED ELSEWHERE. IF NOT, CONTACT THE ENGINEER FOR CLARIFICATION PRIOR TO BIDDING. SYMBOLS, MATERIALS AND ABBREVIATIONS MISSING FROM THE DRAWINGS DO NOT EXCUSE THE CONTRACTOR FROM PROVIDING THE WORK.

LINETYPES

	EXISTING	NEW
FENCE	— X — X —	—○—○—
PROPERTY LINE	— — — P/L — — —	
RIGHT OF WAY	— — — R/W — — —	
UNDERGROUND ELECTRIC	— — — UGE — — —	
OVERHEAD UTILITY LINE	— — — OHU — — —	
UNDERGROUND COMMUNICATION	— — — T — — —	
UNDERGROUND FIBER OPTICS	— — — F/O — — —	
CREEK / SWALE	- - - - -	
SILT FENCE		— SF —
NATURAL GAS	— — — G — — —	
RAILROAD TRACKS	— — — — —	— — — — —
SANITARY SEWERS	— — — — —	— — — — —
STORM SEWERS	— — — — —	— — — — —
WATER LINE	— — — W — — —	
CONTOUR LINE	— — — 800 — — —	— — — 800 — — —
SPOT ELEVATION	+ 800.00	+ 800.00
YARD PIPING	— — — — —	— — — — —
STORM CULVERT	— — — — —	
PERMANENT EASEMENT	— — — — —	
EXISTING YARD PIPING TO BE ABANDONED IN PLACE	- X - X - X - X - X - X - X - X -	

SYMBOLS

	EXISTING	NEW	EXISTING	NEW
WATER METER				
LIFT STATION				
FIRE HYDRANT				
AIR RELEASE VALVE				
BLOW OFF VALVE				
WATER MAIN BEND				
WATER MAIN CAP/PLUG				
WATER MAIN TEE				
WATER MAIN CROSS				
REDUCER				
WATER VALVE				
WATER MAIN MARKER				
PUMP STATION				
WATER SERVICE				
IN LINE CONTROL VALVE				
SANITARY MANHOLE				
CORPORATION STOP				
SANITARY SEWER MARKER				
SANITARY SEWER VALVE				
SANITARY SEWER VALVE VAULT				
SANITARY SEWER WET WELL				
SEPTIC TANK				
CLEAN OUT				
CATCH BASIN				
DOUBLE CATCH BASIN				
CURB INLET				
CIRCULAR INLET				
STORM SEWER MANHOLE				
NATURAL GAS METER				
NATURAL GAS PRESSURE VALVE				
NATURAL GAS STOP				
NATURAL GAS VALVE				
NATURAL GAS MARKER				
NATURAL GAS VENT				
NATURAL GAS WELL				
ELECTRIC MANHOLE				
ELECTRIC METER				
ELECTRIC PEDESTAL				
ELECTRIC TRANSFORMER PAD				
ELECTRIC HAND HOLE BOX				
DOWN GUY WIRE				
LIGHT POLE				
UTILITY POLE				
ELECTRIC MARKER				
UNDERGROUND FIBER MARKER				
FIBER MANHOLE				
COMMUNICATIONS PEDESTAL				
UNDERGROUND TELEPHONE MARKER				
TELEPHONE MANHOLE				
TELEPHONE PEDESTAL				
BOLLARD				
SECTION CORNER				

PROPERTY LEGAL DESCRIPTION

PARCEL ONE:
 A PART OF LOT 19 IN BABY FARMS SUBDIVISION, A SUBDIVISION IN THE EAST HALF OF THE SOUTHWEST QUARTER AND IN THE WEST HALF OF THE SOUTHEAST QUARTER, ALL IN SECTION 6, TOWNSHIP 18 NORTH, RANGE 8 EAST, MADISON COUNTY, INDIANA, THE PLAT OF WHICH SUBDIVISION IS RECORDED IN PLAT BOOK 7, PAGE 100, IN THE OFFICE OF THE RECORDER OF MADISON COUNTY, INDIANA, DESCRIBED AS FOLLOWS:

 BEGINNING ON THE NORTHEASTERN LINE OF SAID LOT 19 AT A POINT 14.51 FEET SOUTHEASTERLY OF THE NORTHEAST CORNER OF SAID LOT; THENCE SOUTHEASTERLY 20.00 FEET ALONG SAID NORTHEASTERN LINE; THENCE SOUTHWESTERLY 10.00 FEET AT RIGHT ANGLES TO SAID NORTHEASTERN LINE; THENCE NORTHWESTERLY 20.00 FEET PARALLEL TO SAID NORTHEASTERN LINE; THENCE NORTHEASTERLY 10.00 FEET AT RIGHT ANGLES TO SAID NORTHEASTERN LINE TO THE POINT OF BEGINNING AND CONTAINING 0.005 ACRES, MORE OR LESS.

PARCEL TWO:
 A PART OF LOT 19 OF BABY FARMS SUBDIVISION, THE PLAT OF WHICH IS RECORDED IN PLAT BOOK 7, PAGE 100 IN THE OFFICE OF THE RECORDER OF MADISON COUNTY, INDIANA, DESCRIBED AS FOLLOWS:

 BEGINNING AT THE NORTHWEST CORNER OF SAID LOT 19; THENCE SOUTH 89 DEGREES 53 MINUTES 20 SECONDS EAST (BASIS OF BEARINGS IS THE INDIANA STATE PLANE COORDINATE SYSTEM - EAST ZONE) 41.50 FEET ALONG THE NORTH LINE OF SAID LOT TO THE NORTHEAST CORNER THEREOF; THENCE SOUTH 47 DEGREES 14 MINUTES 27 SECONDS EAST 14.51 FEET ALONG THE NORTHEASTERN LINE OF SAID LOT TO THE NORTHEAST CORNER OF THE TRACT OF LAND CONVEYED TO FALL CREEK REGIONAL WASTE DISTRICT BY THE WARRANTY DEED RECORDED IN DEED BOOK 616, PAGE 152 IN THE OFFICE OF SAID RECORDER; THENCE SOUTH 42 DEGREES 45 MINUTES 33 SECONDS WEST 10.00 FEET ALONG THE NORTHWESTERN LINE OF SAID TRACT TO THE NORTHWEST CORNER THEREOF; THENCE SOUTH 47 DEGREES 14 MINUTES 27 SECONDS EAST 20.00 FEET ALONG THE SOUTHWESTERN LINE OF SAID TRACT OF LAND TO THE SOUTHWEST CORNER THEREOF; THENCE NORTH 42 DEGREES 45 MINUTES 33 SECONDS EAST 10.00 FEET ALONG THE SOUTHEASTERN LINE OF SAID TRACT TO THE SOUTHEAST CORNER THEREOF AND THE NORTHEASTERN LINE OF SAID LOT 19; THENCE SOUTH 47 DEGREES 14 MINUTES 27 SECONDS EAST 50.00 FEET ALONG SAID NORTHEASTERN LINE; THENCE SOUTH 30 DEGREES 25 MINUTES 05 SECONDS WEST 198.28 FEET TO THE WEST LINE OF SAID LOT 19; THENCE NORTH 00 DEGREES 47 MINUTES 28 SECONDS WEST 228.47 FEET ALONG SAID WEST LINE TO THE POINT OF BEGINNING, CONTAINING 0.292 ACRES, MORE OR LESS.



BENCHMARK INFORMATION

TBM-201 TEMPORARY BENCHMARK
 ELEVATION: 890.35 FEET (NAVD 88)

 CHISELED "X" ON TOP SLAB WEST SIDE OF EXISTING VALVE VAULT

SHEET NOTES

- CONSTRUCTION ACCESS DRIVE FOR ALL CONSTRUCTION PERSONNEL, VEHICLES, AND DELIVERIES. CONTRACTOR SHALL NOT BE ALLOWED TO ACCESS EXISTING PARKING LOT OR ACCESS DRIVE BEYOND LIMITS SHOWN (DENOTED BY "XXXX") WITHOUT PRIOR AUTHORIZATION FROM OWNER.
- CONTRACTOR STAGING AREA, EQUIPMENT STOCKPILES, AND TRAILERS. RESTORE AREA TO ORIGINAL CONDITION FOLLOWING CONSTRUCTION OPERATIONS.

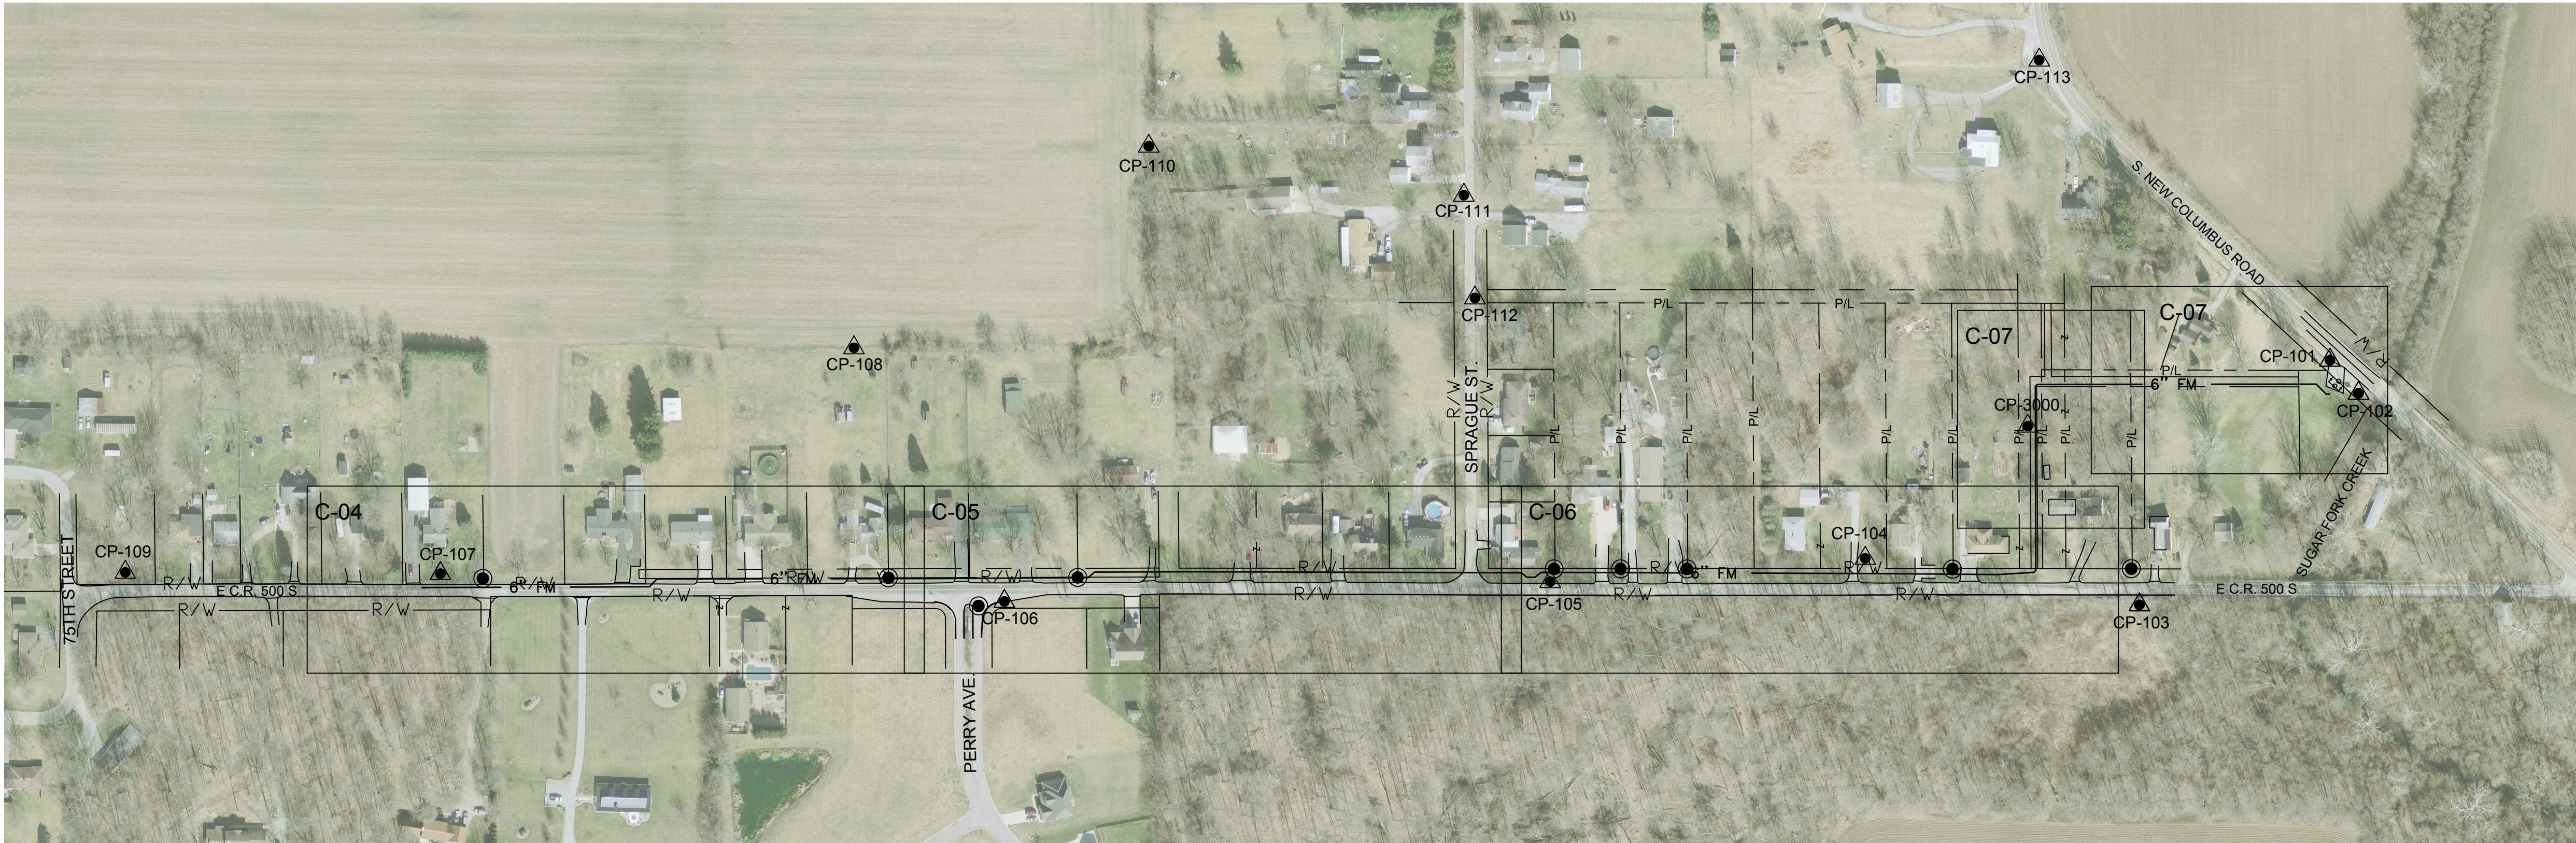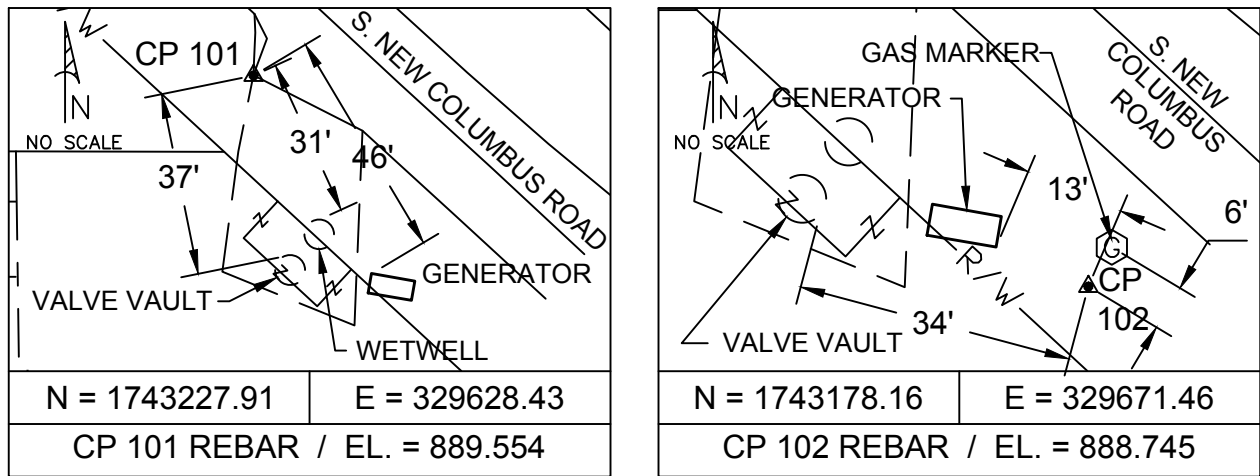

SURVEY CONTROL

NOT TO SCALE

Indiana 811
 Indiana Underground Plant Protection Service
 CALL TWO WORKING DAYS
 BEFORE YOU DIG
 IT'S THE LAW
 811

GEORGE W. LEWIS
 No. 10403303
 STATE OF INDIANA
 PROFESSIONAL ENGINEER

GRW PROJECT NO. 4625

CLIENT PROJECT NO. --

ALL RIGHTS RESERVED. NO PART OF THIS DOCUMENT MAY BE REPRODUCED IN WHOLE OR IN PART WITHOUT THE WRITTEN PERMISSION OF GRW ENGINEERS, INC. AND SHALL NOT BE USED FOR ANY OTHER PROJECT OTHER THAN THIS SPECIFIC PROJECT WITHOUT WRITTEN PERMISSION.

www.grwinc.com

SURVEY CONTROL

BABY FARMS LIFT STATION AND FORCE MAIN IMPROVEMENTS

FALL CREEK REGIONAL WASTE DISTRICT


DESIGNED	GWL	DRAWN	JAJ	REVIEWED	JPT	APPROVED	GWL
NO.							
DATE							
DESCRIPTION							

SCALE CHECK: _____ THIS MARK SHOULD MEASURE EXACTLY 1" WHEN PLOTTED

DATE: NOVEMBER 197

SCALE: 1"=150'

SHEET NO. C-01

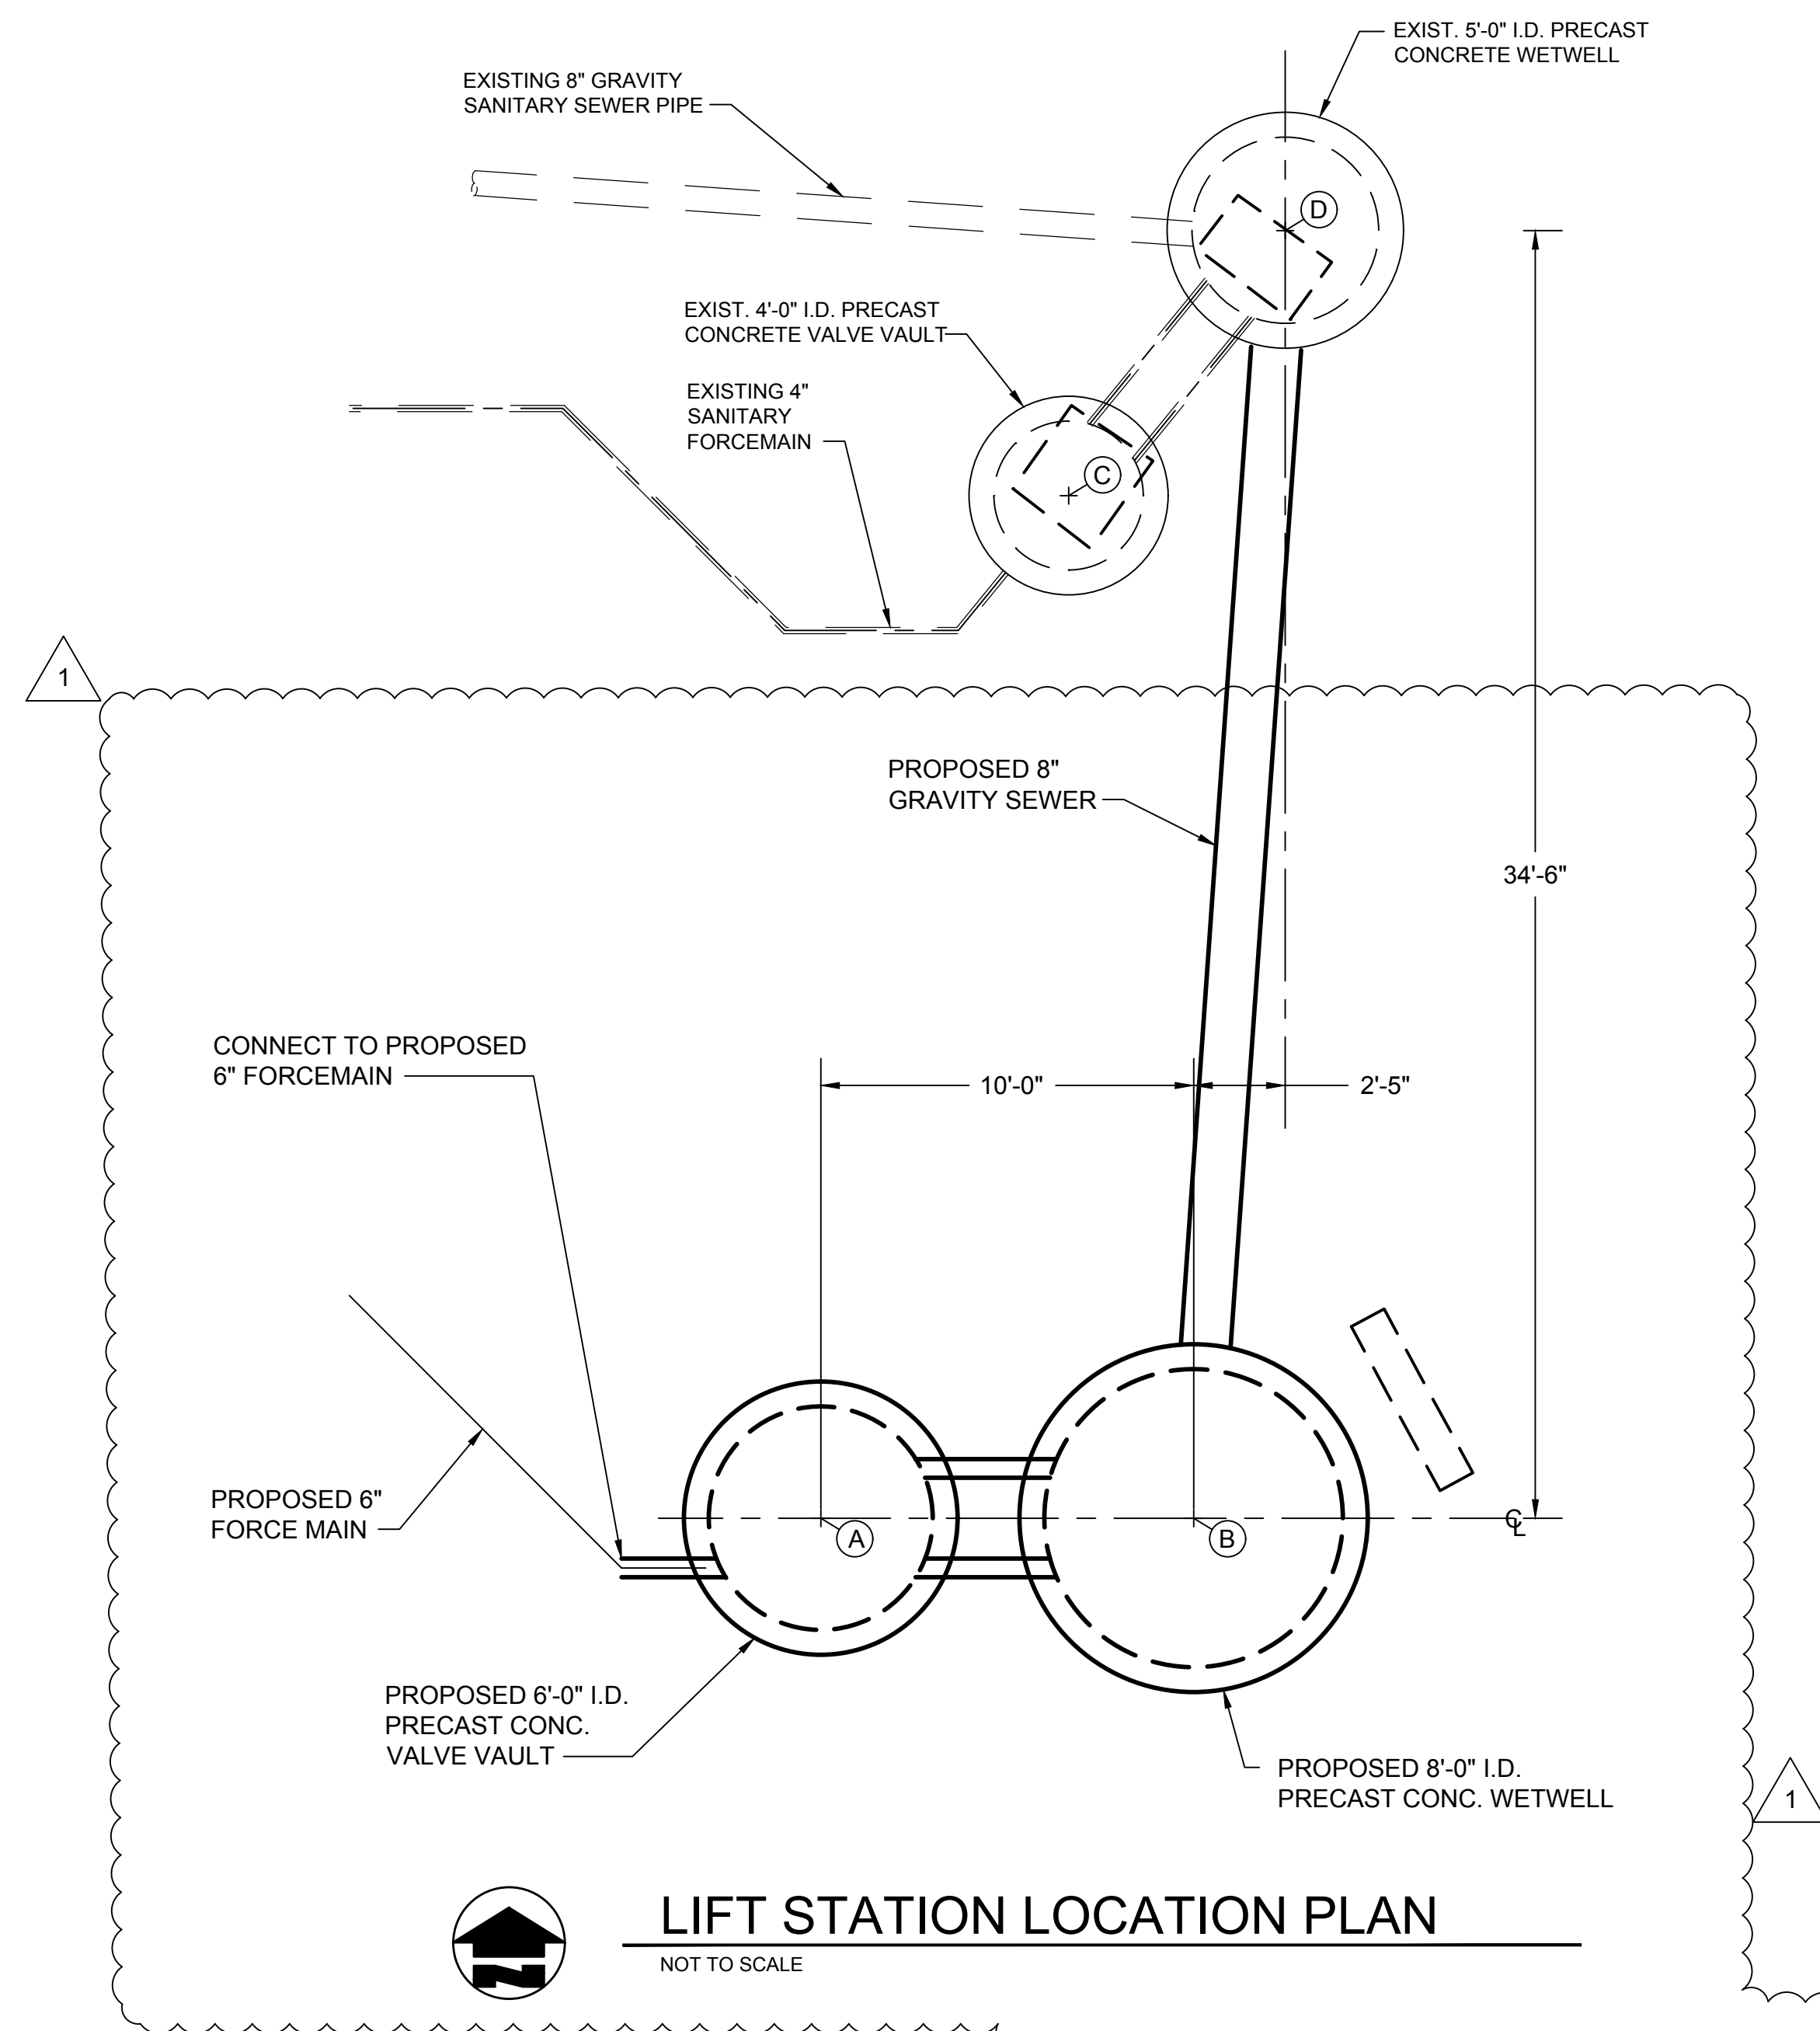**L.S. DEMOLITION NOTES**

- EXISTING WETWELL - CONTRACTOR SHALL REMOVE EXIST. PUMPING EQUIPMENT AND PIPING AND CONVERT TO MANHOLE AS SHOWN ON SHEET C-03. SEE SHT. C-03 FOR ADDITIONAL RECONSTRUCTION REQUIREMENTS.
- EXISTING VALVE VAULT - CONTRACTOR SHALL REMOVE ALL PIPING FROM STRUCTURE, PLUG PIPE OPENINGS AND REMOVE LID AT TOP OF STRUCTURE TO 2 FT BELOW GRADE AND BACKFILL WITH COMPACTED GRANULAR MATERIAL UP TO BOTTOM OF STONE PAVEMENT.
- REFER TO ELECTRICAL DRAWINGS FOR EXISTING PUMP ELECTRICAL CONTROLS DEMOLITION AND REPLACEMENT REQUIREMENTS.


SHEET NOTES

- EXISTING SURFACES SHALL BE RESTORED TO CONDITIONS EQUAL TO OR BETTER THAN ORIGINAL CONDITIONS USING NEW MATERIALS ONLY. ALL DISTURBED GRASS AREAS OUTSIDE OF PROPOSED PAVEMENT LIMITS SHALL BE RE-SEEDED PER SPECIFICATIONS.
- PROVIDE POSITIVE SURFACE WATER DRAINAGE RELIEF AROUND ALL LIFT STATION AND MANHOLE STRUCTURES.
- CONTRACTOR SHALL INSTALL TEMPORARY SILT FENCE AROUND ALL DISTURBED AREAS, INCLUDING STAGING AREAS. REFER TO SPEC. SECTION 02370 AND EROSION CONTROL DETAILS FOR EROSION CONTROL REQUIREMENTS.
- REFER TO ELECTRICAL DRAWINGS FOR SITE ELECTRICAL UPGRADES.

○ SITE LOCATION COORDINATES			
MARK	NORTHING	EASTING	DESCRIPTION
A	1743161.70	329629.05	PROPOSED VALVE VAULT CENTER
B	1743161.70	329639.05	PROPOSED WETWELL CENTER
C	1743189.12	329635.70	EXISTING VALVE VAULT CENTER
D	1743196.23	329641.51	EXISTING WETWELL CENTER

**Indiana Underground Plant Protection Service****CALL TWO WORKING DAYS
BEFORE YOU DIG
IT'S THE LAW
811****SURFACE LEGEND**


	EXISTING FLOODPLAIN AREA
	EXISTING GRAVEL DRIVE AREA
	PROPOSED ADDITIONAL GRAVEL DRIVE AREA

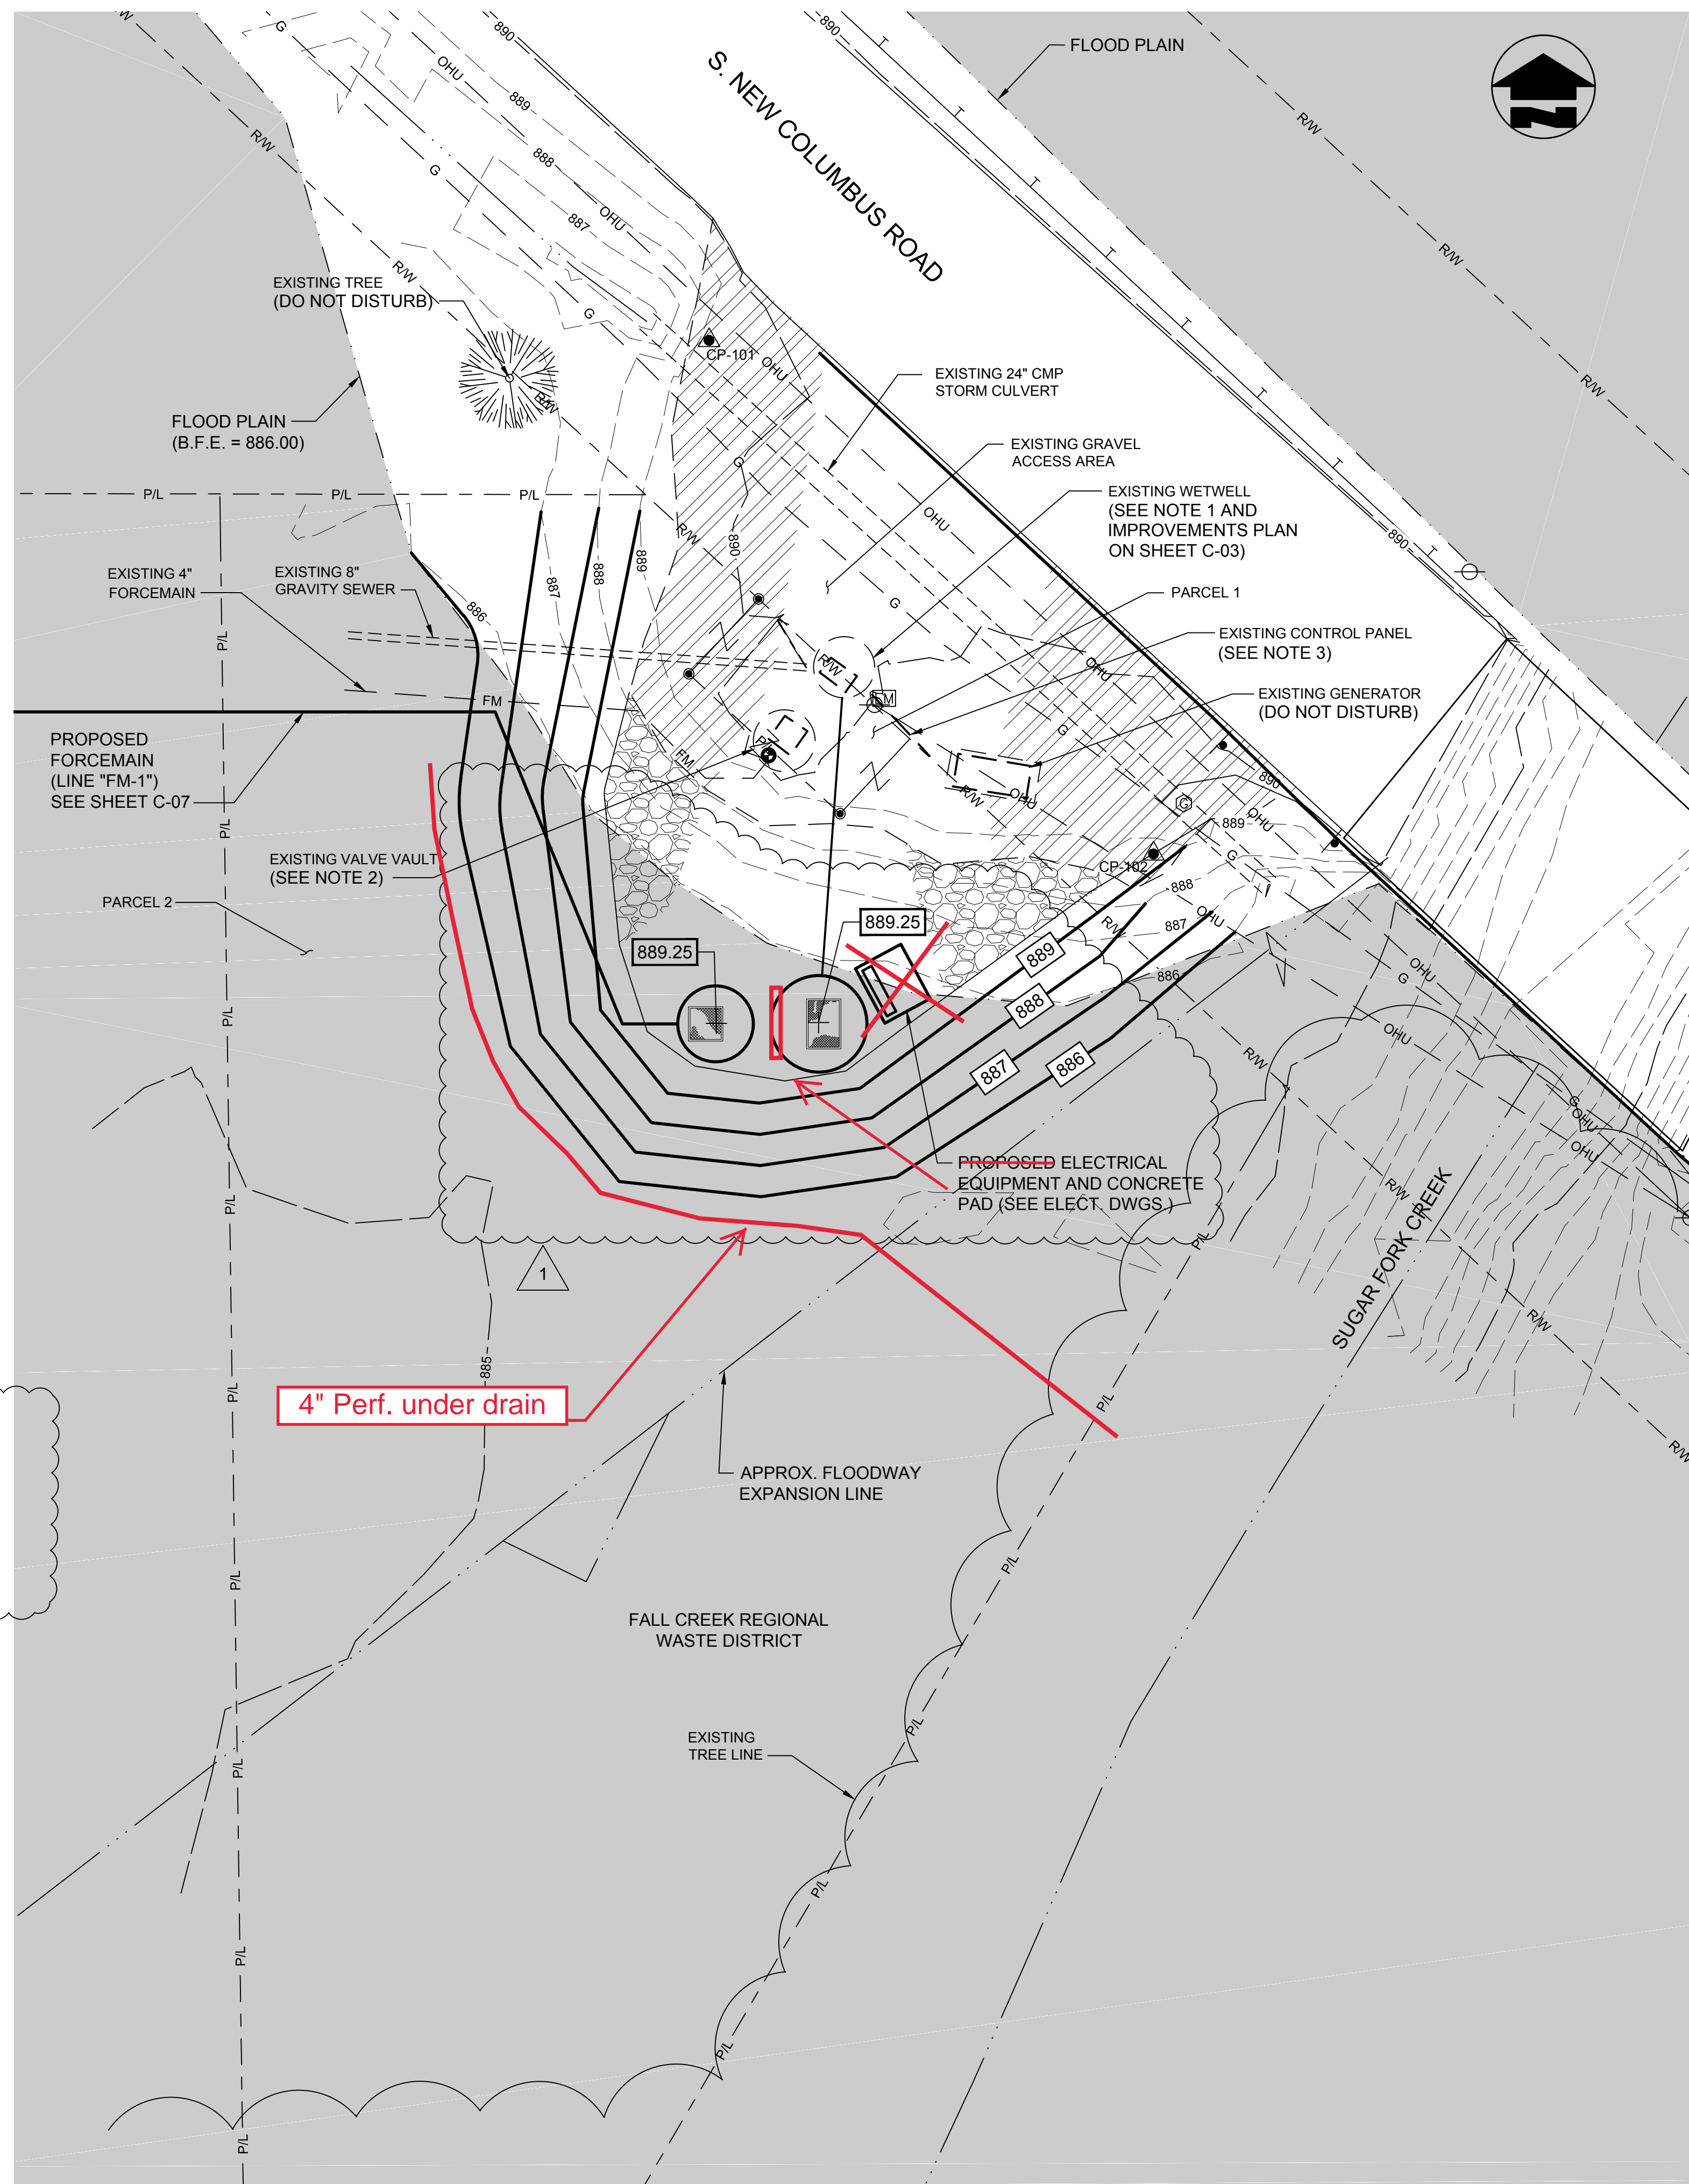

1 LIFT STATION SITE PLAN

SCALE: 1"=10'-0"

0 10' 20'

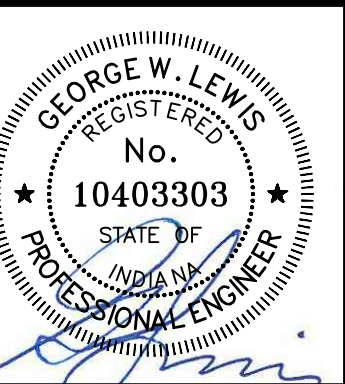

GRW PROJECT NO. 4625

CLIENT PROJECT NO. --

ALL RIGHTS RESERVED. NO PART OF THIS DOCUMENT SHALL BE REPRODUCED IN WHOLE OR IN PART WITHOUT THE WRITTEN PERMISSION OF GEORGE W. LEWIS & ASSOCIATES, INC. AND SHALL NOT BE USED FOR ANY OTHER PROJECT OTHER THAN THIS SPECIFIC PROJECT WITHOUT THE WRITTEN PERMISSION.



engineering | architecture | geospatial

www.grwinc.com

SITE PLAN

BABY FARMS LIFT STATION AND FORCE MAIN IMPROVEMENTS

FALL CREEK REGIONAL WASTE DISTRICT

NO.	REVISIONS	DATE	BY	DESCRIPTION	DESIGNED	DRAWN	REVIEWED	APPROVED	SCALE
1	RELOCATE PROPOSED LIFT STATION	1/2018	GWL		GWL	GAJ	JPT	GWL	

DATE: NOVEMBER 2017

SCALE: 1"=10'

SHEET NO.

C-02



NOT TO SCALE





NOT TO SCALE

- 1



NOT TO SCALE

- *** COORDINATE/VERIFY WITH PUMP MANF. RECOMMENDATIONS;
ADJUST REMAINING FLOATS TO MAINTAIN ELEVATION
DIFFERENCE SHOWN IN SCHEDULE.



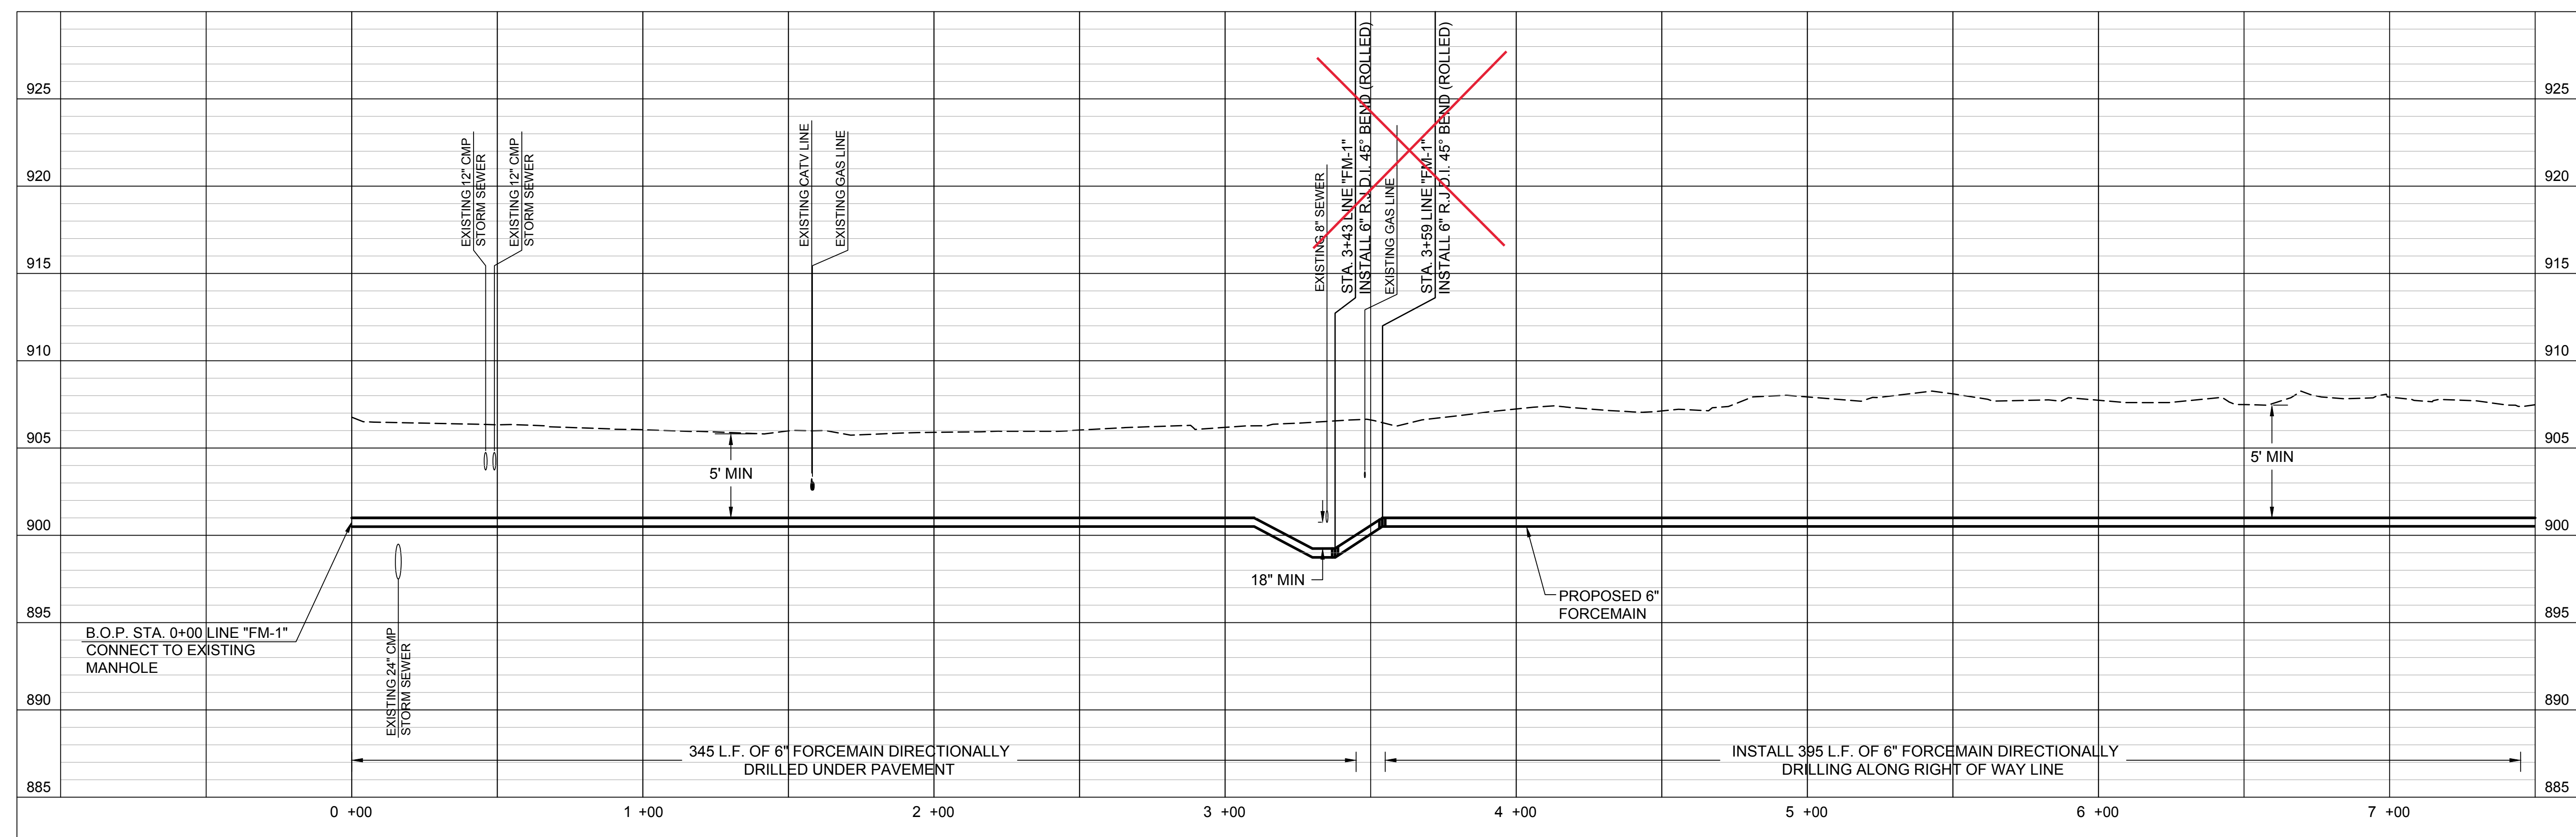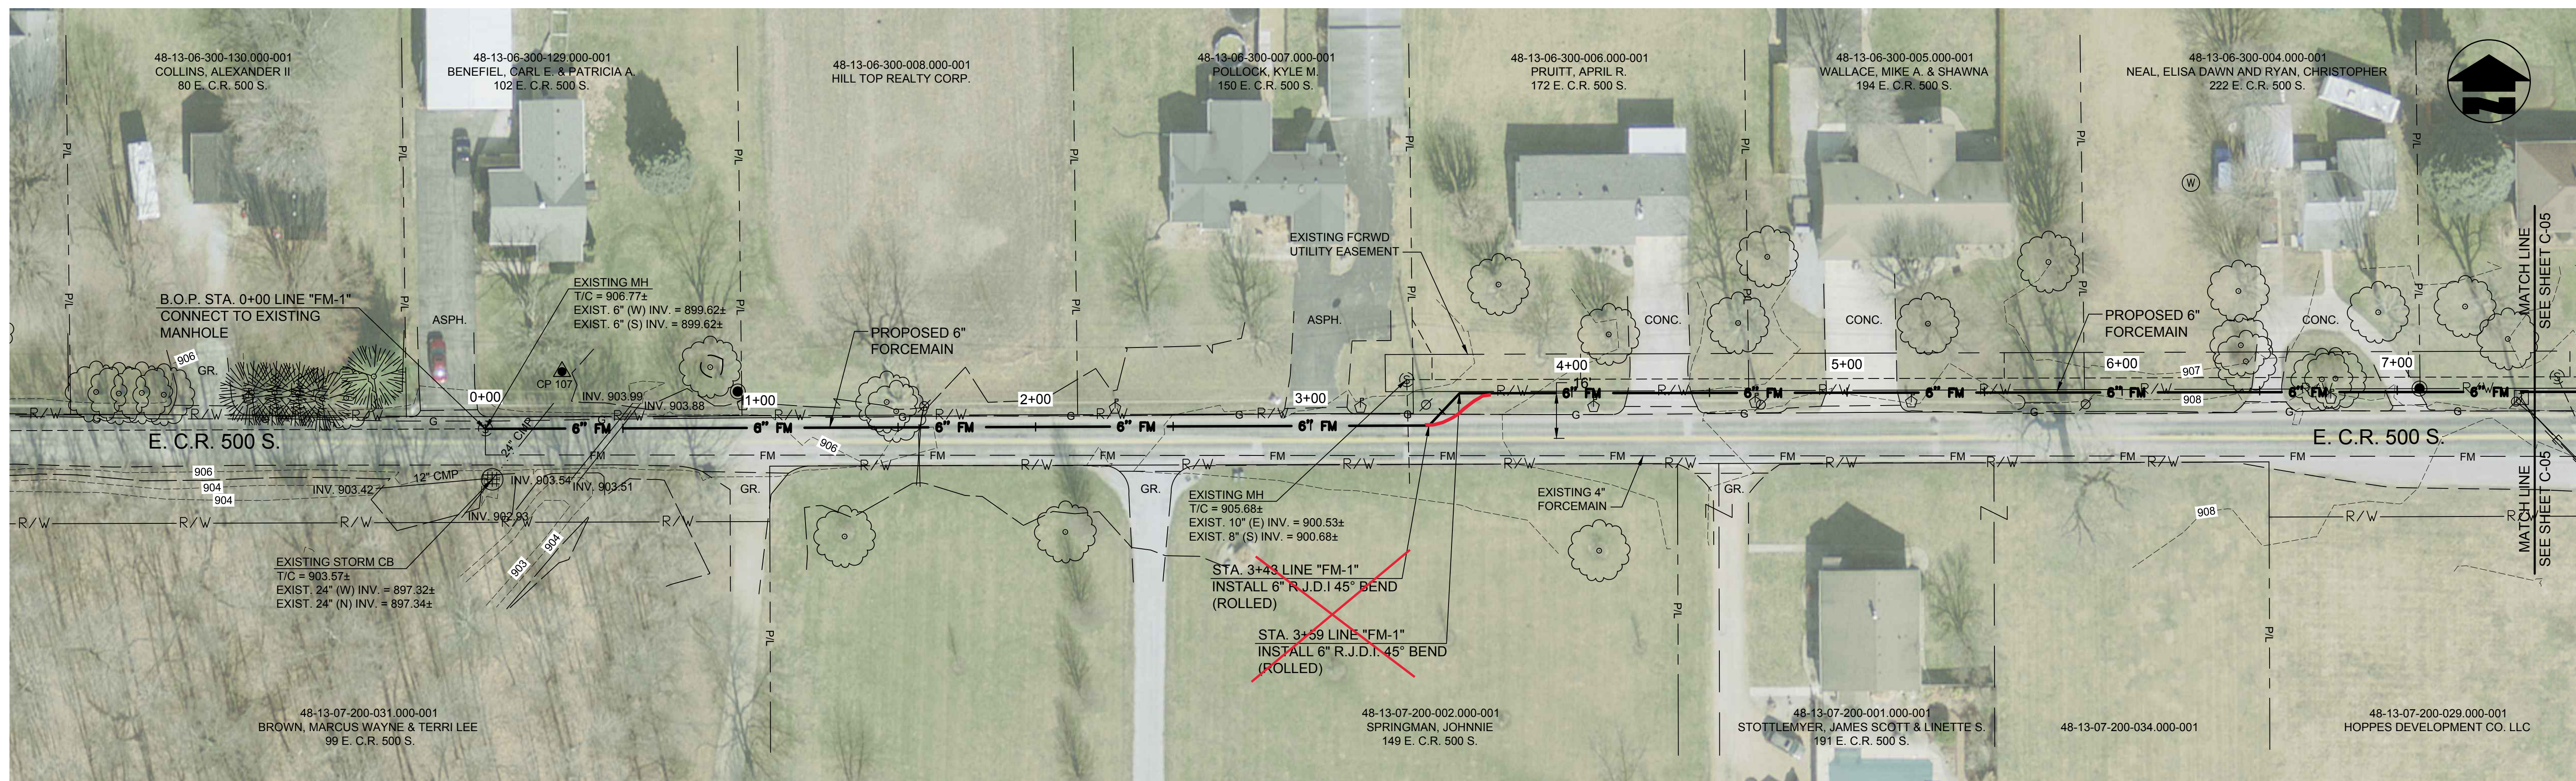


NOTE:
1. INSTALL FORCEMAIN FROM STA. 0+00 TO 21+50
AT CONSISTENT TOP OF PIPE ELEVATION = 901.00
TO AVOID CREATING HIGH POINTS

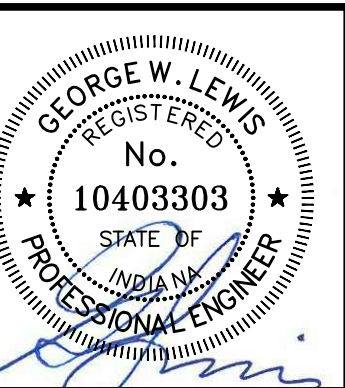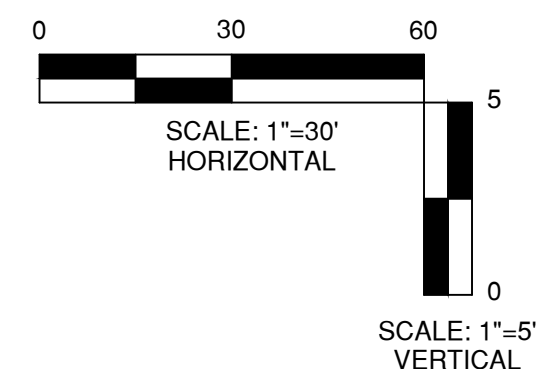

GRW PROJECT NO. 4625

CLIENT PROJECT NO. --

ALL RIGHTS RESERVED:
THIS DOCUMENT IS THE PROPERTY OF
GRW ENGINEERS, INC. AND SHALL NOT
BE REPRODUCED IN WHOLE OR IN PART
OR USED FOR CONSTRUCTION OF
OTHER THAN THIS SPECIFIC PROJECT
WITHOUT WRITTEN PERMISSION

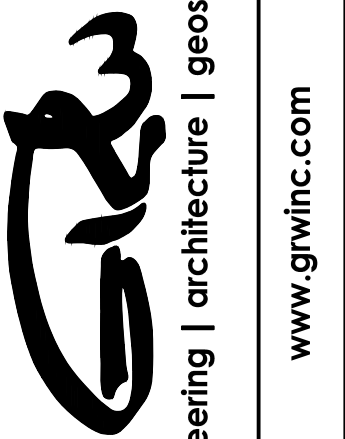

PLAN AND PROFILE


BABY FARMS LIFT STATION AND FORCE MAIN IMPROVEMENTS FALL CREEK REGIONAL WASTE DISTRICT

NOVEMBER 2017				GWL	
DATE	BY	DRAWN		JAJ	
		REVIEWED		JPT	
APPROVED				GWL	
SCALE CHECK: _____ THIS MARK SHOULD MEASURE EXACTLY 1" WHEN PLOTTED					


PRINTED: 11/2/2018 @ 8:05AM

FILE NAME: G:\4625-FCRWD-BFLS\Working Drawings\AutoCAD\4625-C-06.dwg

PLOTTED BY: jolson

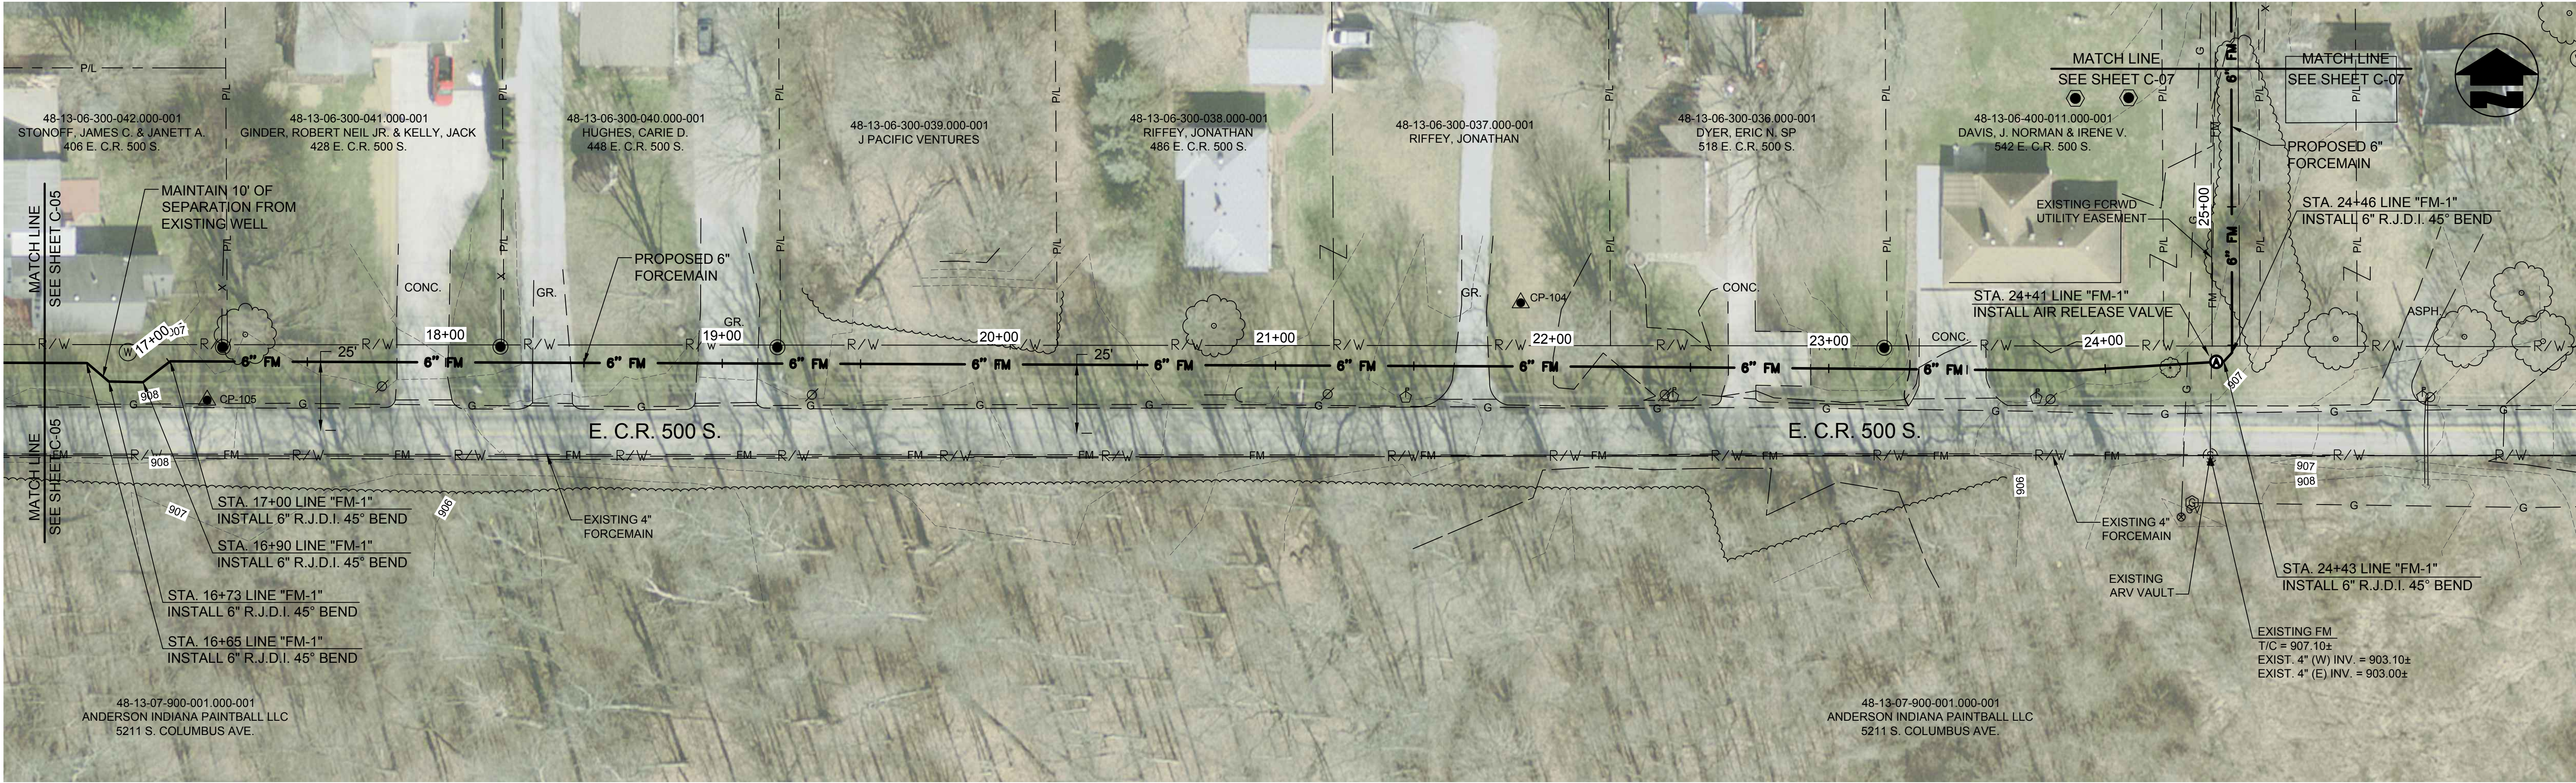


PLAN VIEW - STA. 16+50 TO STA. 25+50 LINE "FM-1"

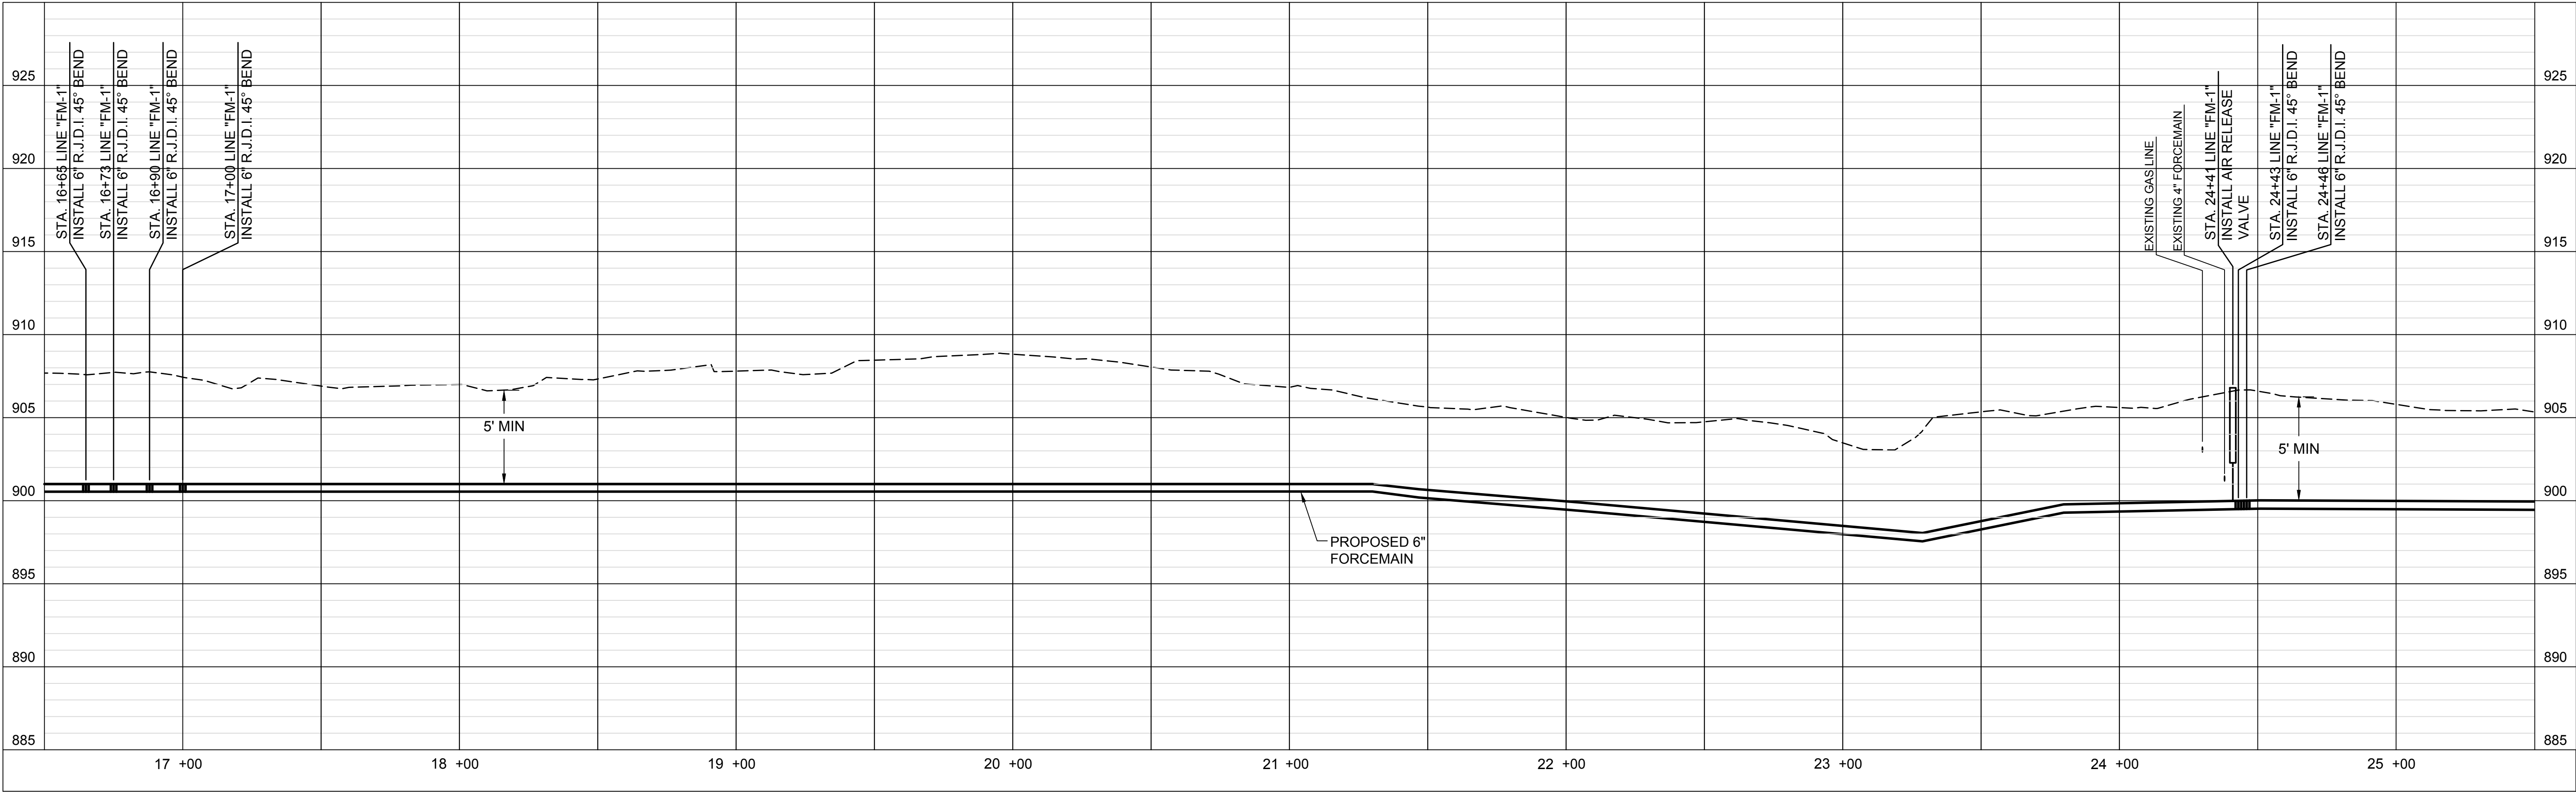


PROFILE VIEW - STA. 16+50 TO STA. 25+50 LINE "FM-1"

NOTE:
1. INSTALL FORCEMAIN FROM STA. 0+00 TO 21+50
AT CONSISTENT TOP OF PIPE ELEVATION = 901.00
TO AVOID CREATING HIGH POINTS

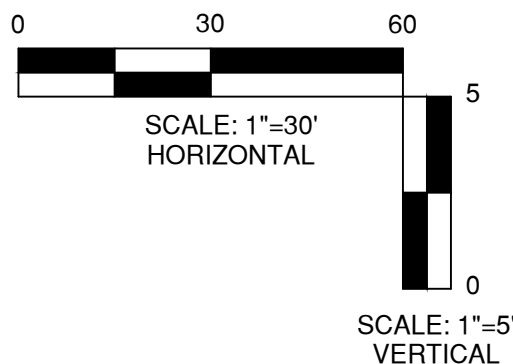

GEORGE W. LEIS
REGISTERED
No. 10403303
STATE OF INDIANA
PROFESSIONAL CHARTERED

GRW PROJECT NO. 4625
CLIENT PROJECT NO. -
ALL RIGHTS RESERVED.
THIS DOCUMENT IS THE PROPERTY OF
GEOGRAPHIC INFORMATION SYSTEMS
AND SHALL BE REPRODUCED IN WHOLE OR IN PART
WITHOUT WRITTEN PERMISSION



engineering | architecture | geospatial
www.grwinc.com

PLAN AND PROFILE






BABY FARMS LIFT STATION AND FORCE MAIN IMPROVEMENTS
FALL CREEK REGIONAL WASTE DISTRICT


DESIGNED	BY	DATE	REVIEWED	DATE	APPROVED
GWL	JAU		JPT		GWL

REVISIONS
NO. DESCRIPTION
1. THIS MARK SHOULD MEASURE EXACTLY 1" WHEN PLOTTED

DATE: NOVEMBER 2017
SCALE: H: 1"=30' V: 1"=5'
SHEET NO.

C-06

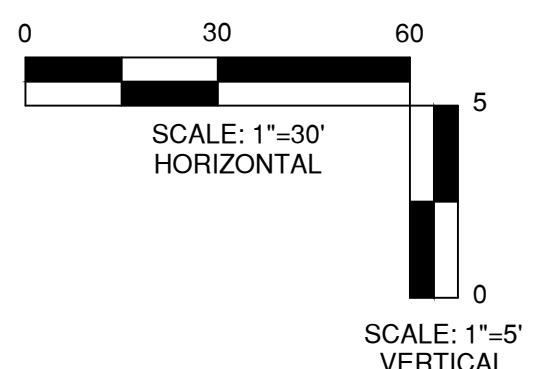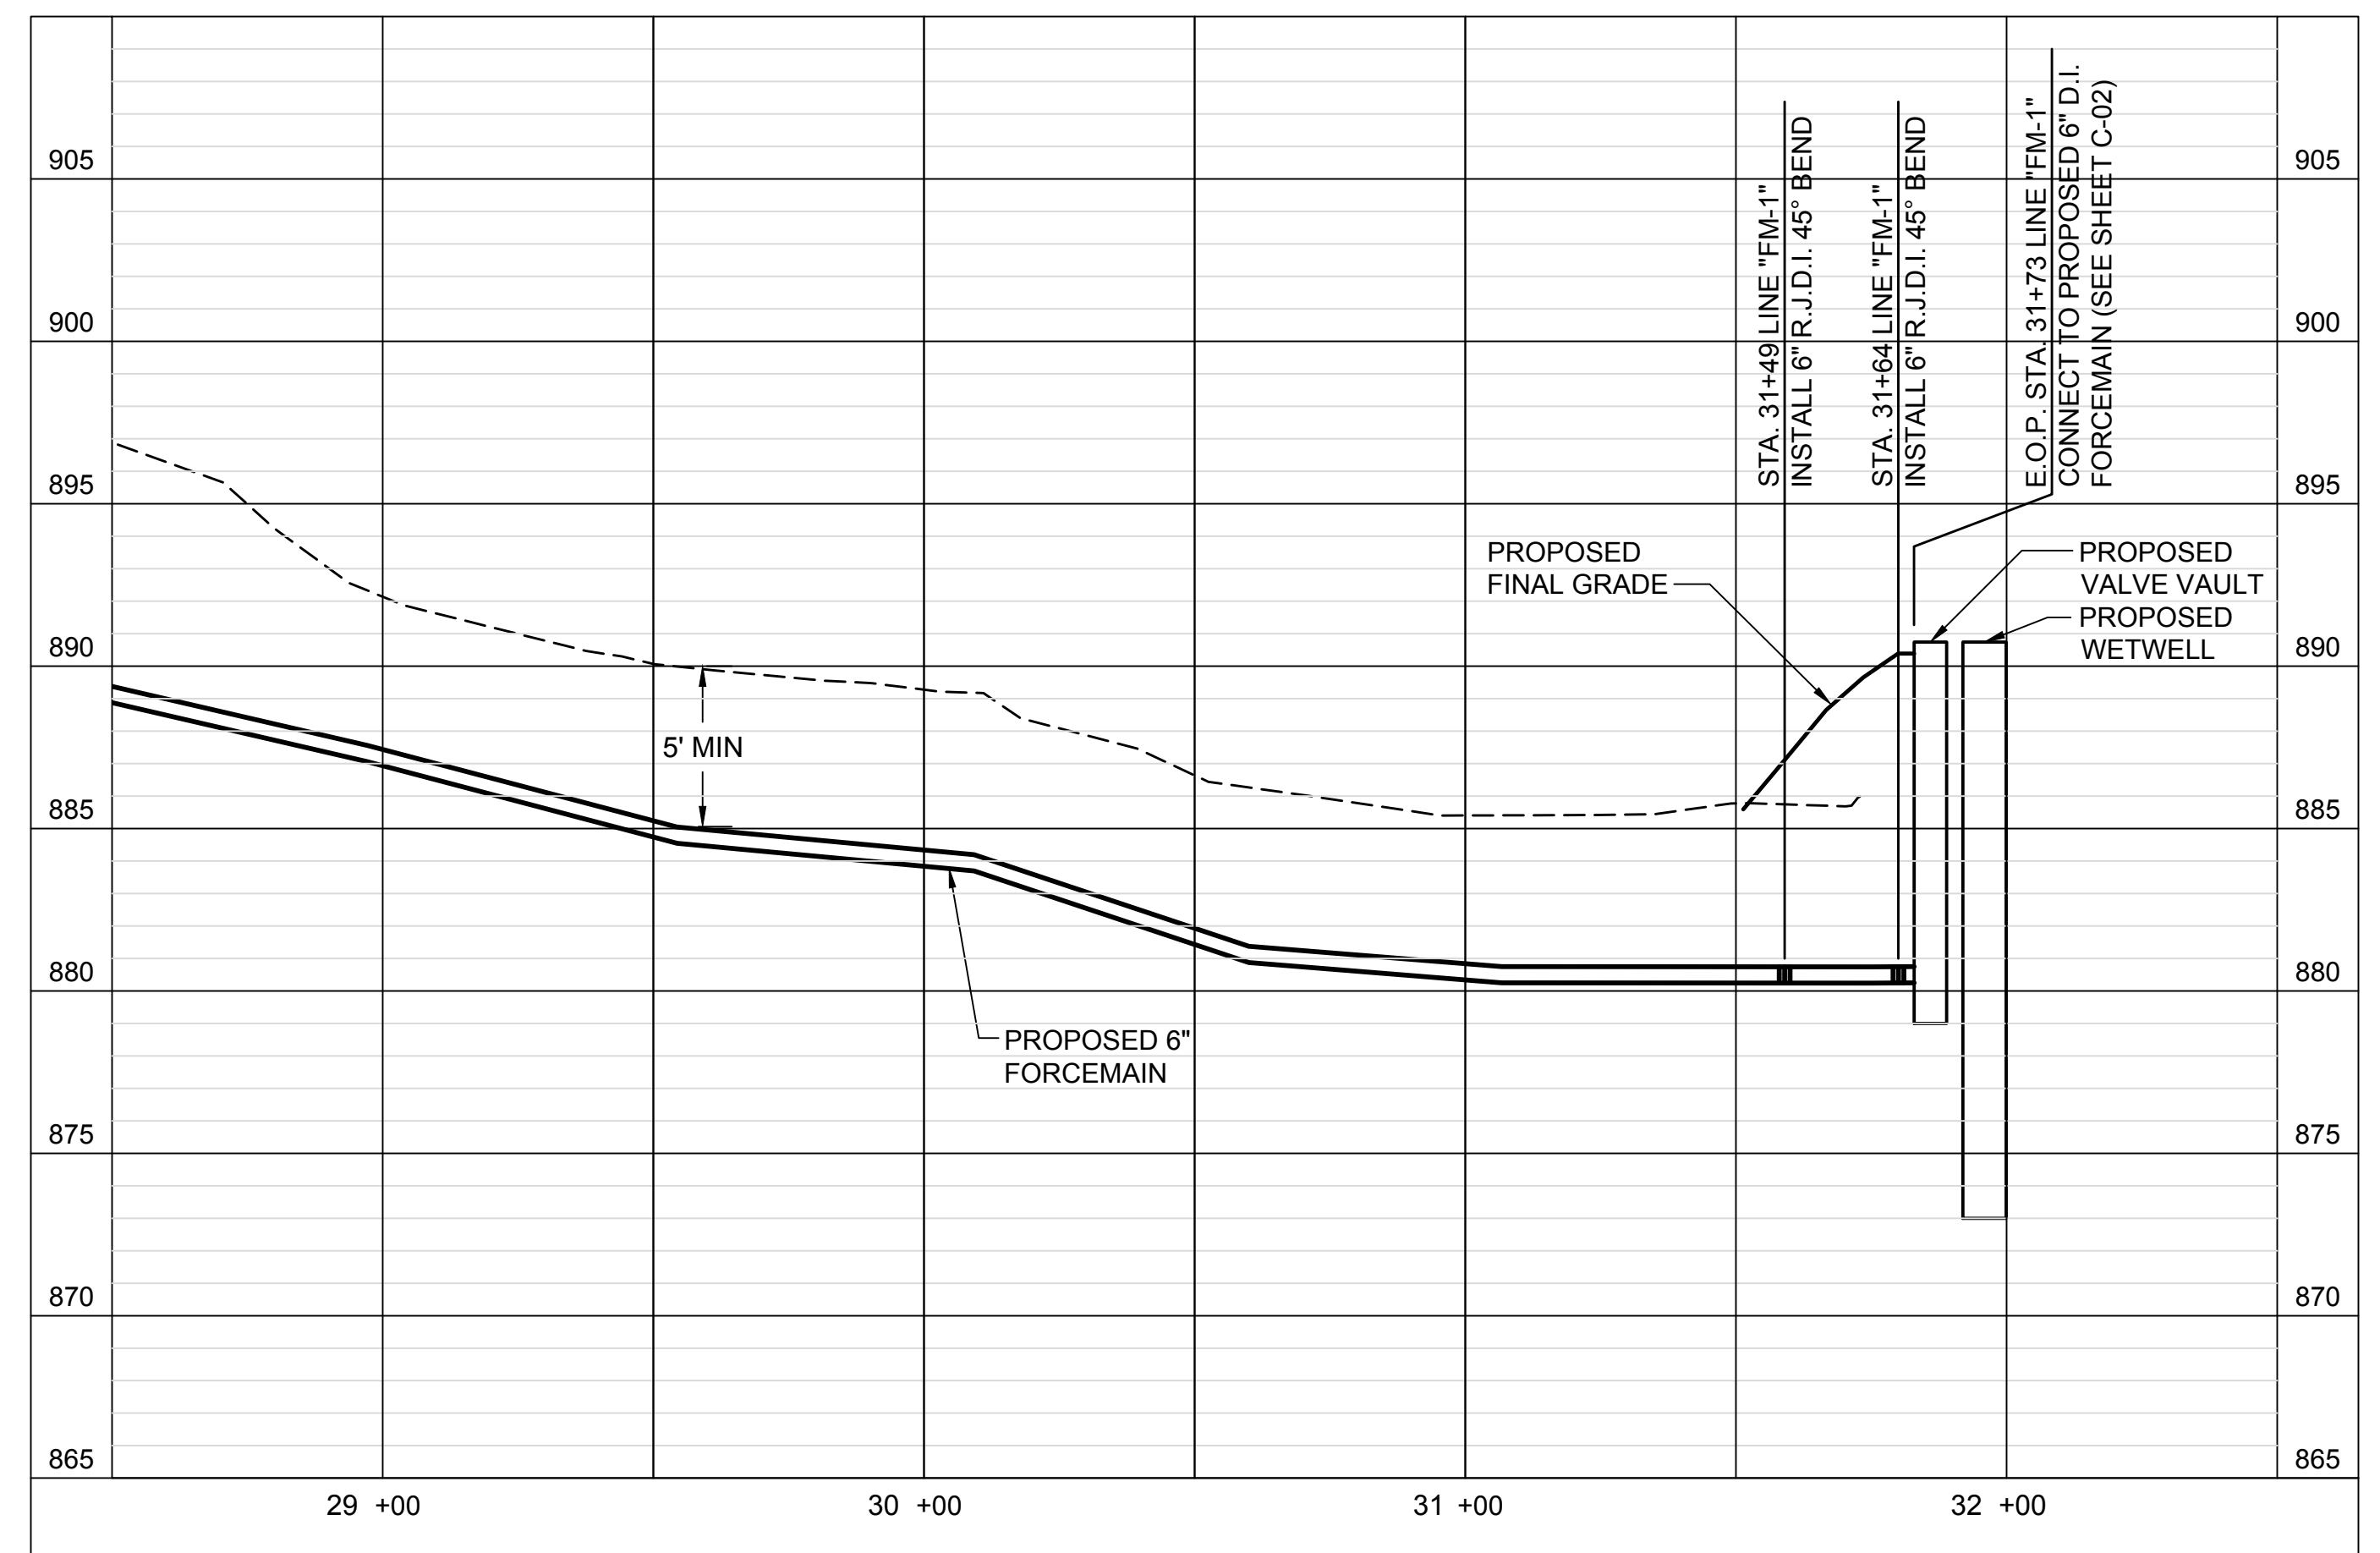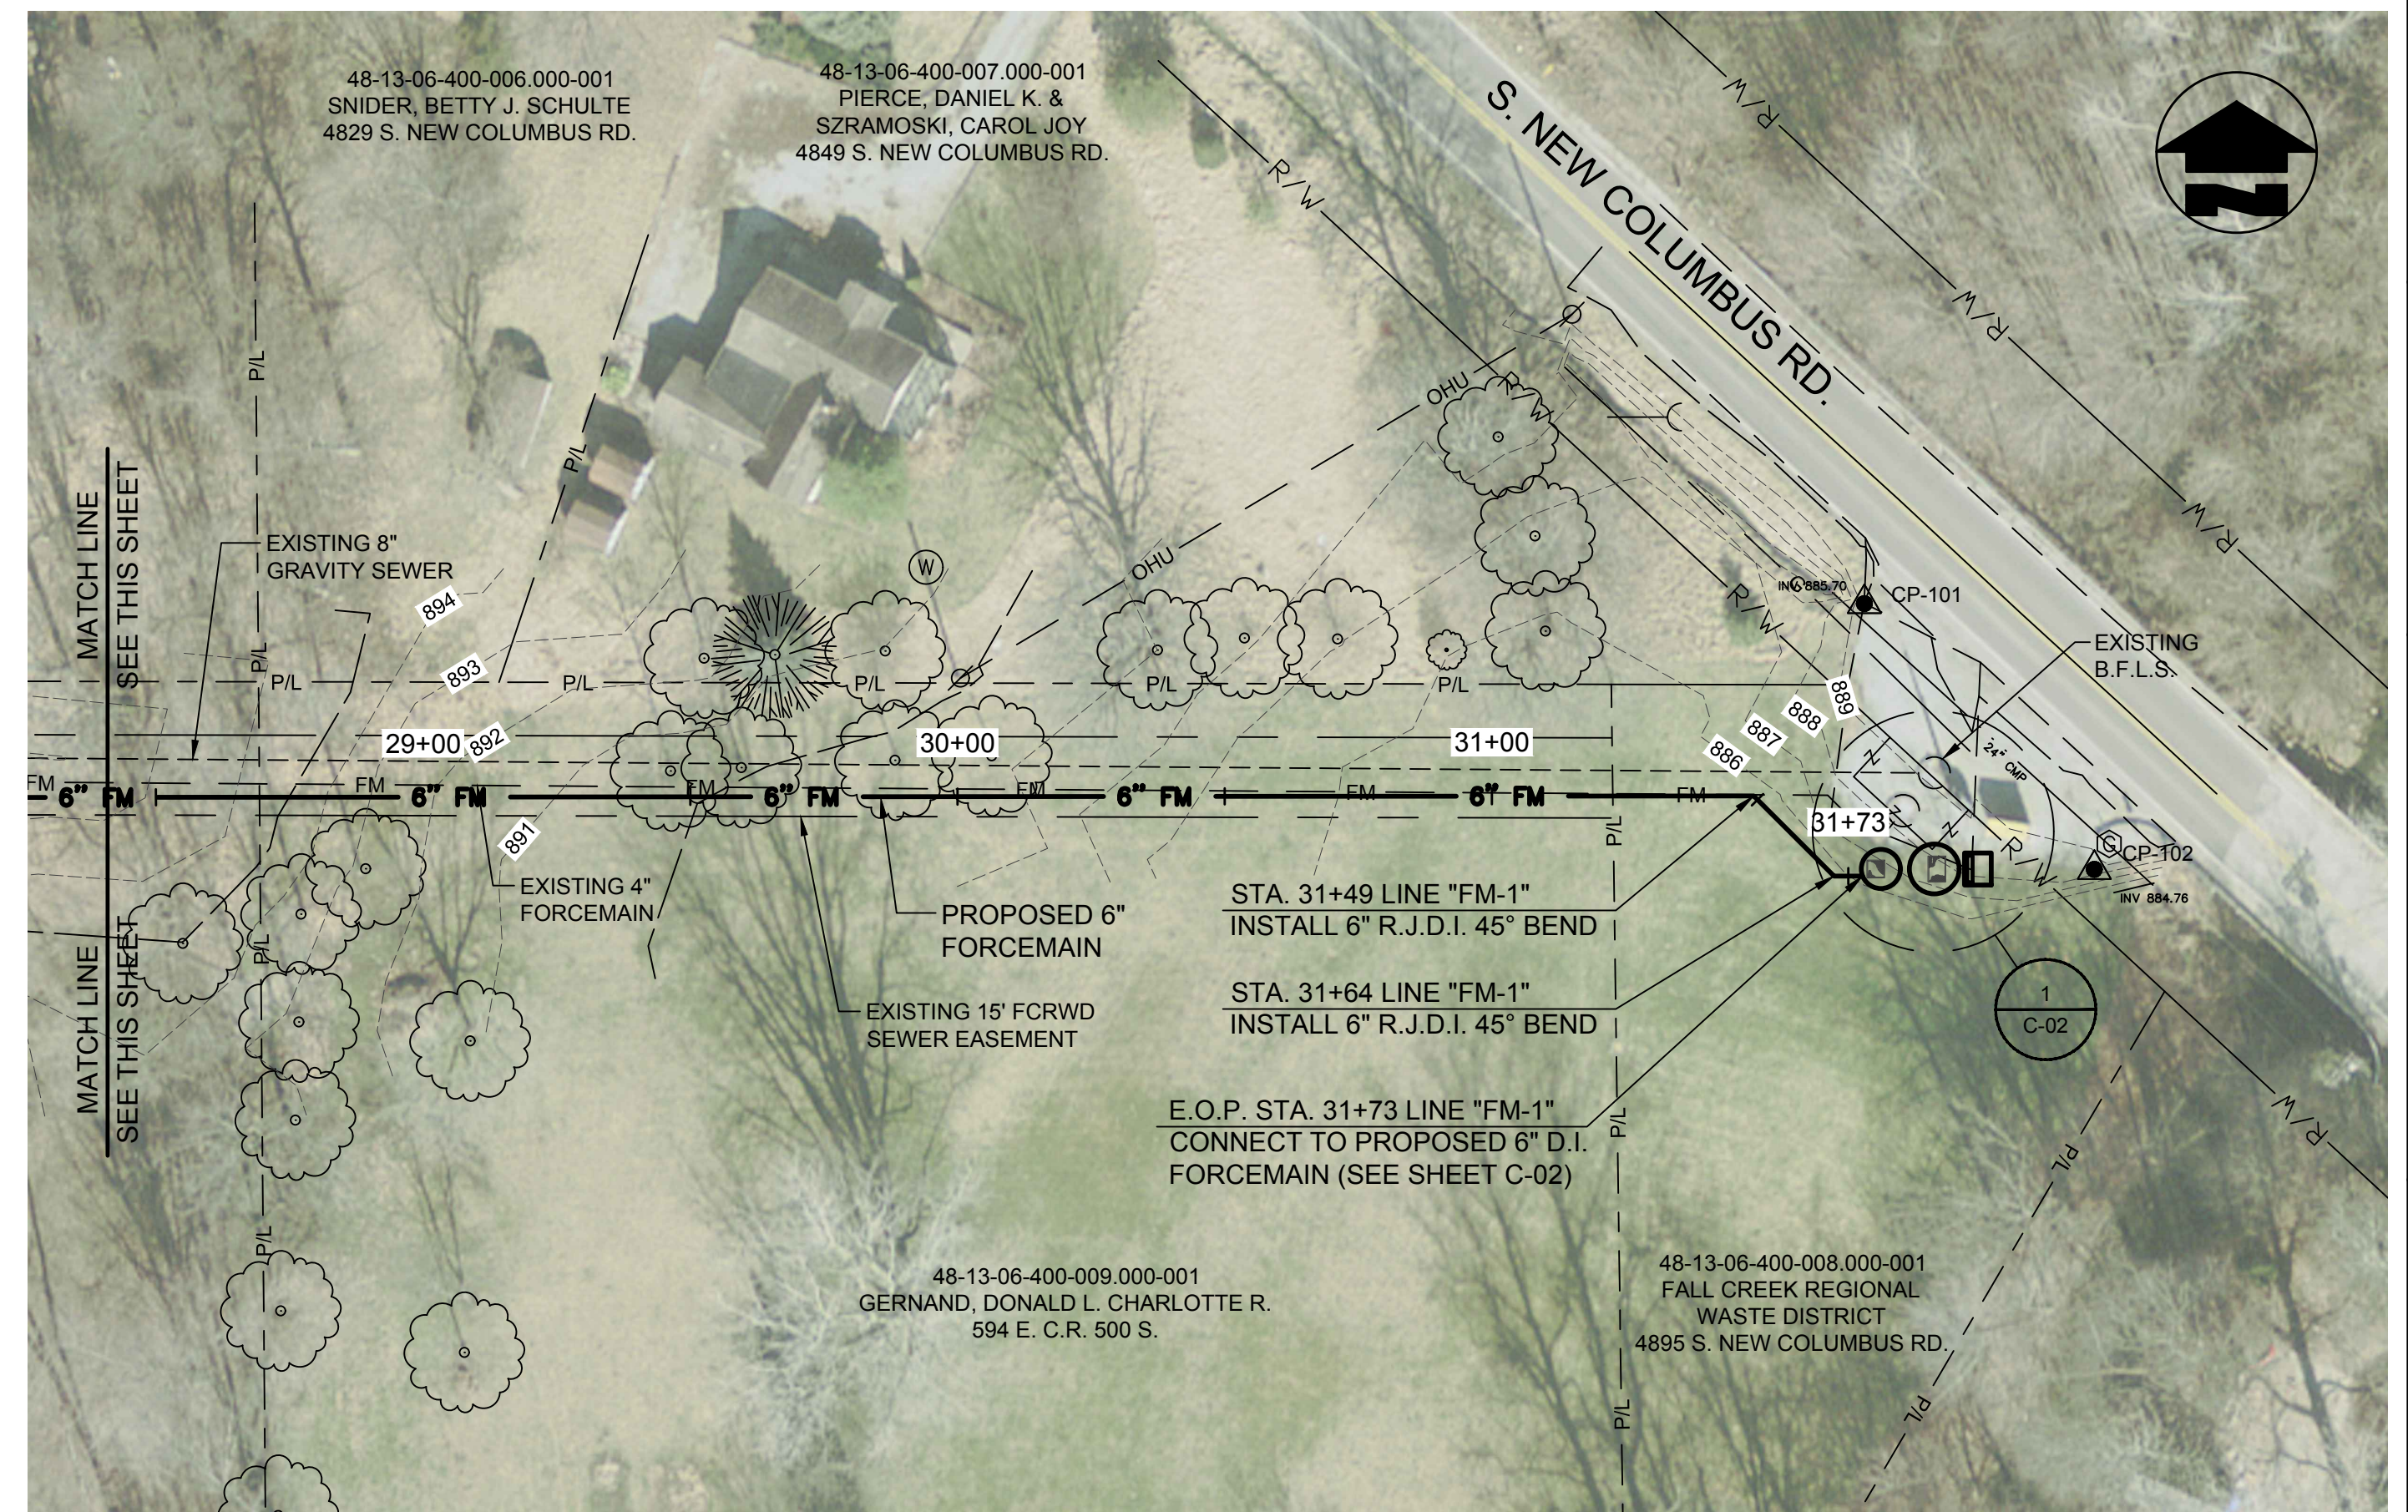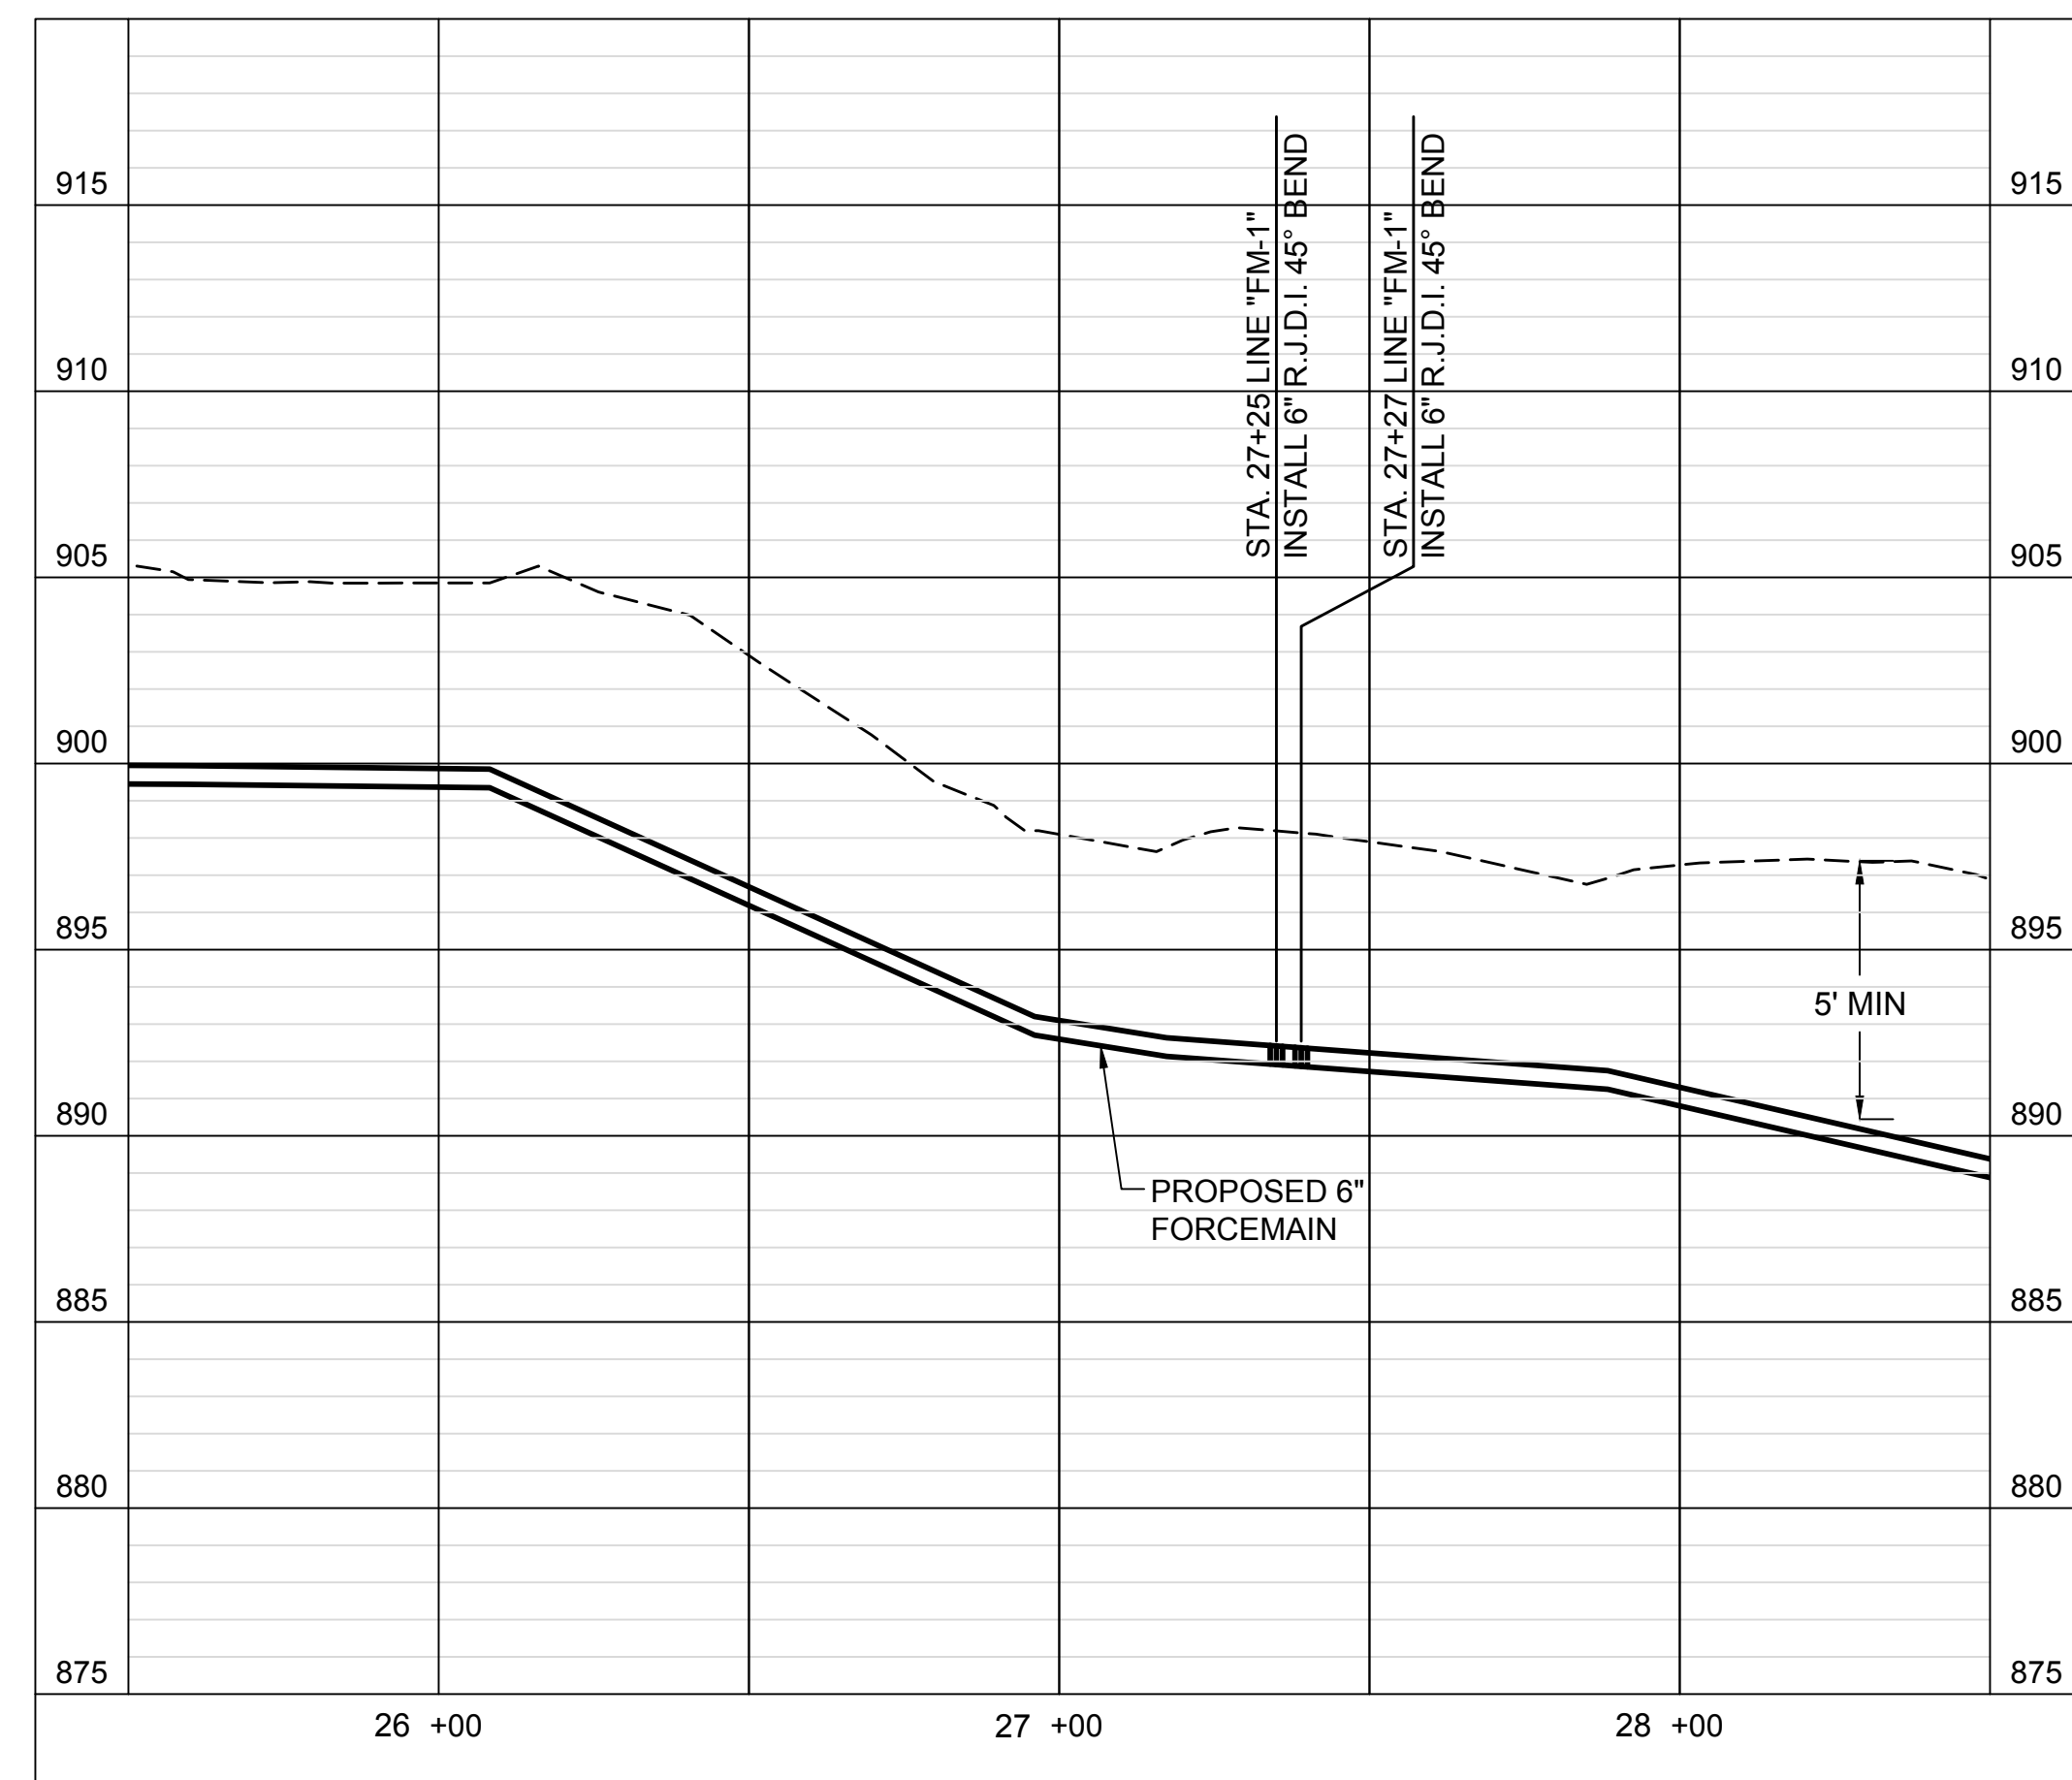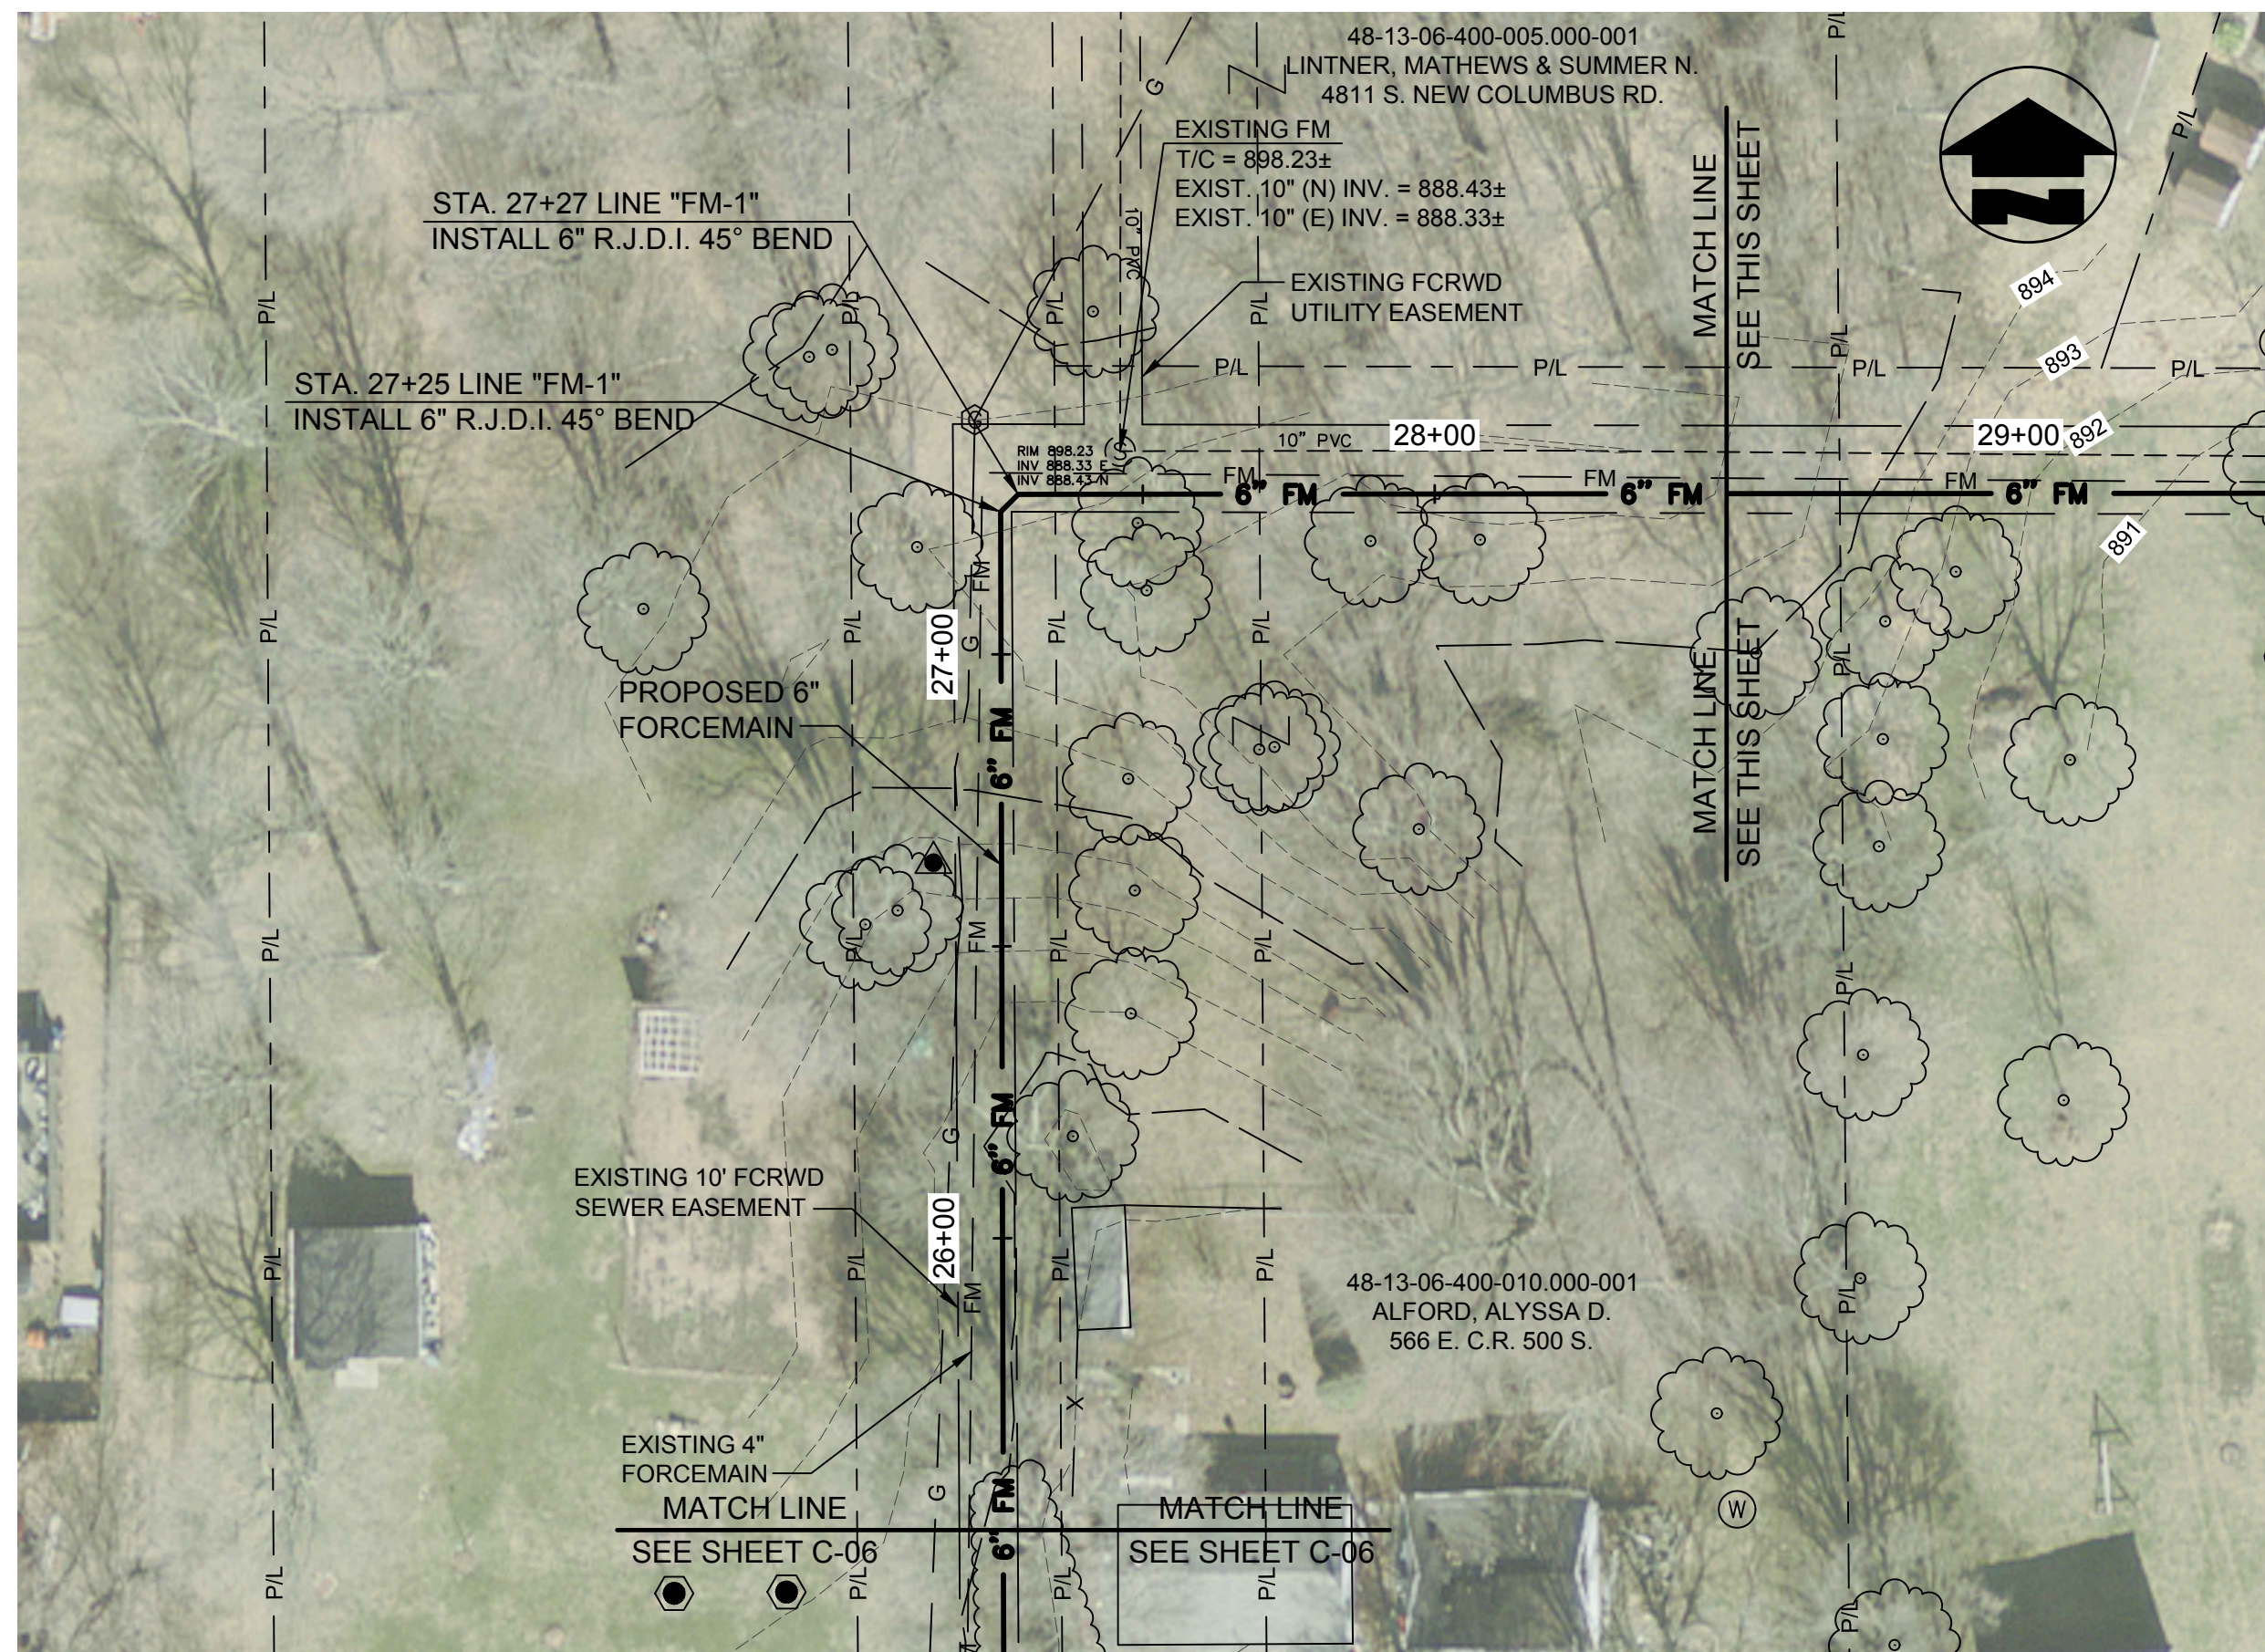

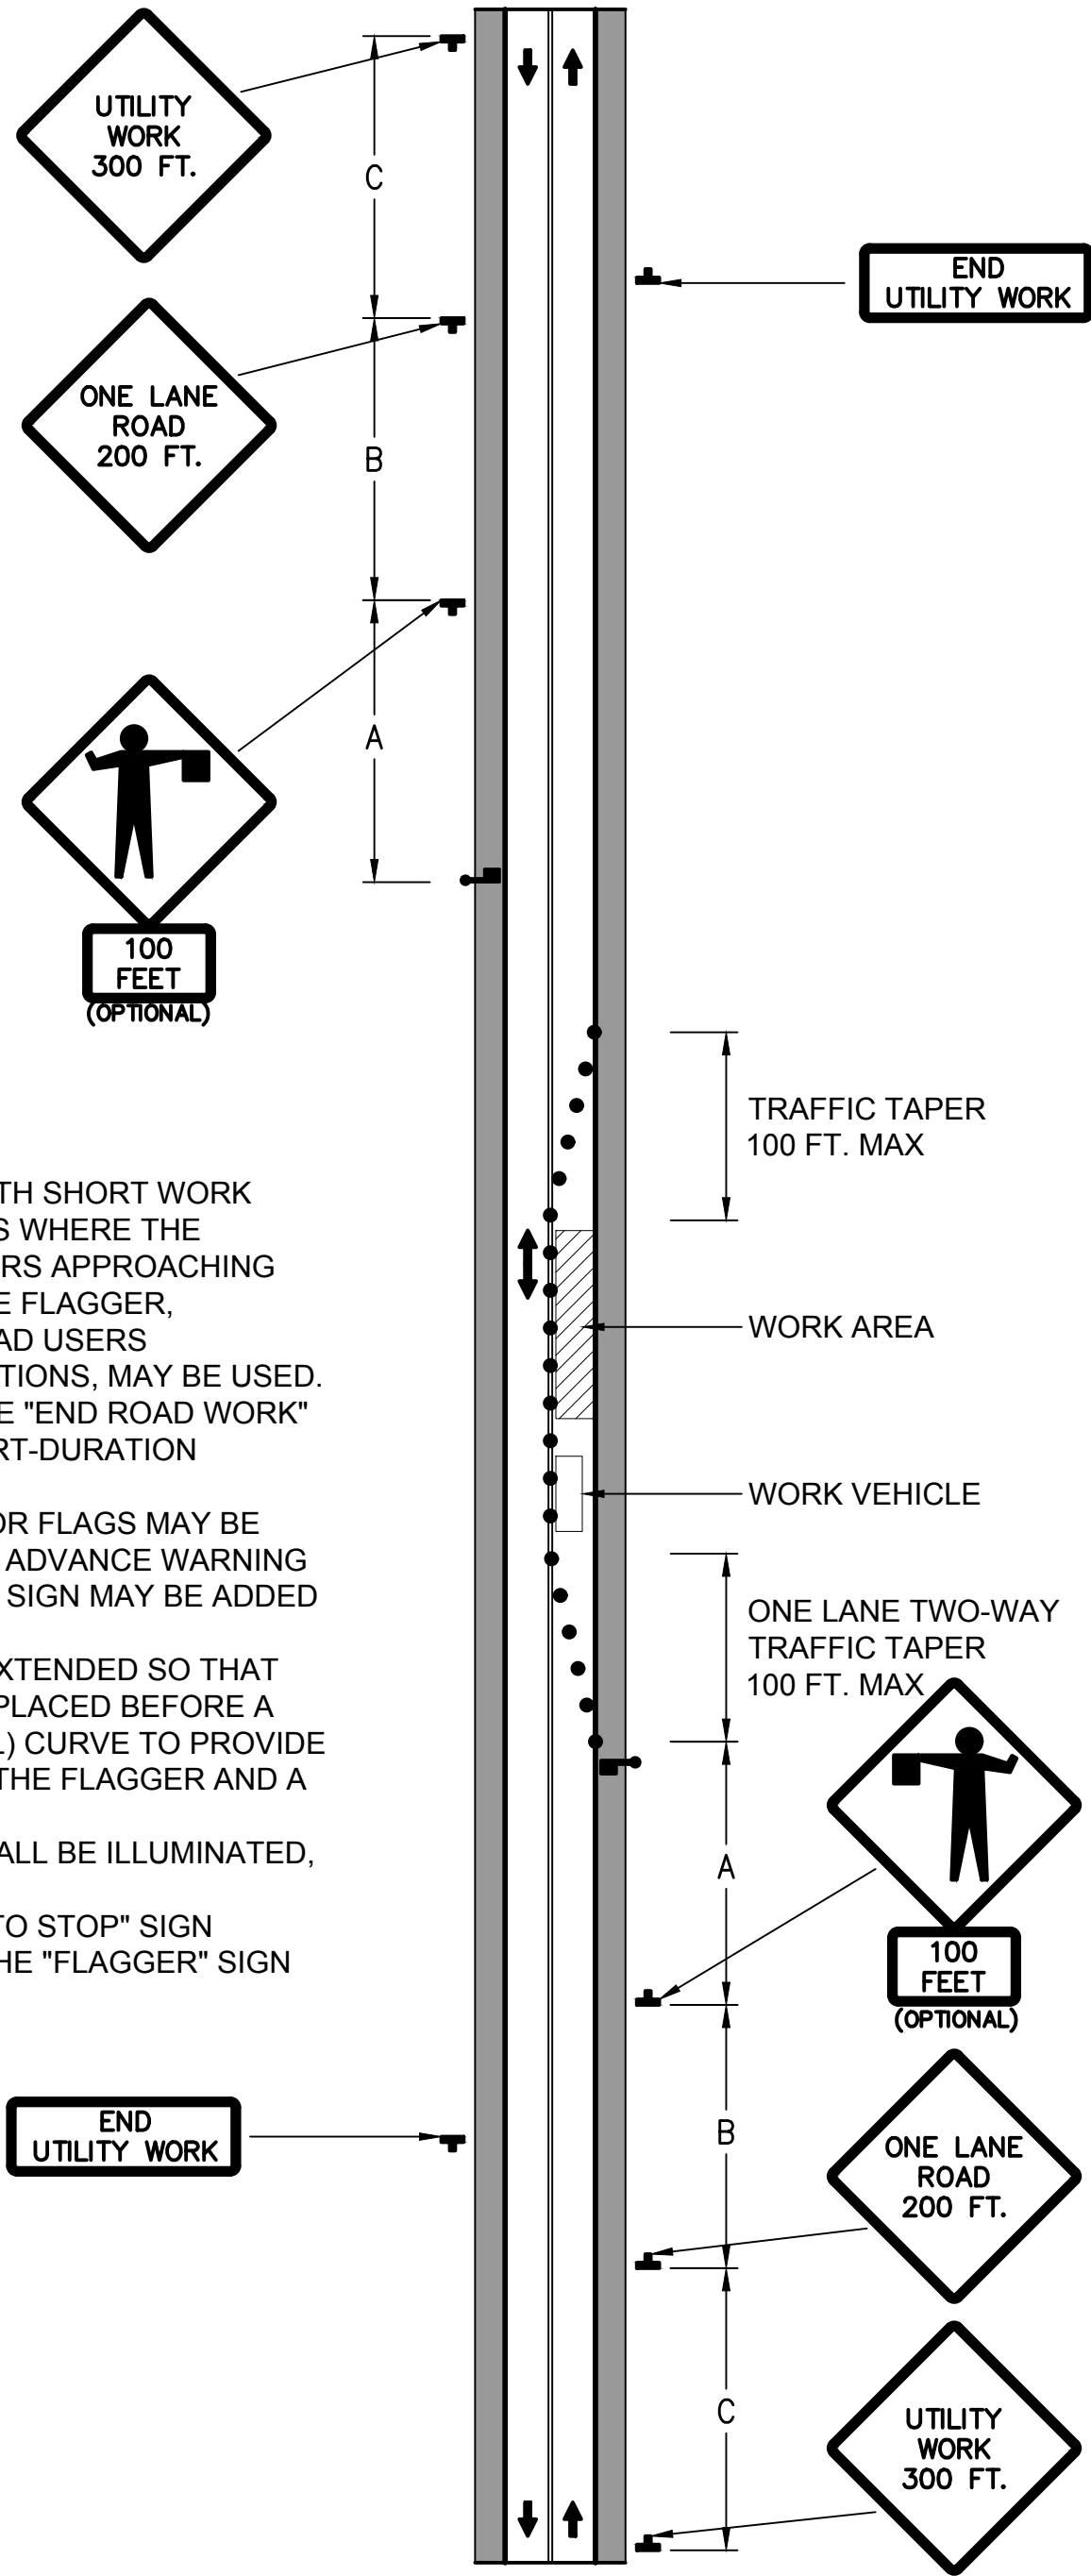

NOTES:

- FOR LOW-VOLUME SITUATIONS WITH SHORT WORK ZONES ON STRAIGHT ROADWAYS WHERE THE FLAGGER IS VISIBLE TO ROAD USERS APPROACHING FROM BOTH DIRECTIONS, A SINGLE FLAGGER, POSITIONED TO BE VISIBLE TO ROAD USERS APPROACHING FROM BOTH DIRECTIONS, MAY BE USED.
- THE "ROAD WORK AHEAD" AND THE "END ROAD WORK" SIGNS MAY BE OMITTED FOR SHORT-DURATION OPERATIONS.
- FLASHING WARNING LIGHTS AND/OR FLAGS MAY BE USED TO CALL ATTENTION TO THE ADVANCE WARNING SIGNS. A "BE PREPARED TO STOP" SIGN MAY BE ADDED TO THE SIGN SERIES.
- THE BUFFER SPACE SHOULD BE EXTENDED SO THAT THE TWO-WAY TRAFFIC TAPER IS PLACED BEFORE A HORIZONTAL (OR CREST VERTICAL) CURVE TO PROVIDE ADEQUATE SIGHT DISTANCE FOR THE FLAGGER AND A QUEUE OF STOPPED VEHICLES.
- AT NIGHT, FLAGGER STATIONS SHALL BE ILLUMINATED, EXCEPT IN EMERGENCIES.
- WHEN USED, THE "BE PREPARED TO STOP" SIGN SHOULD BE LOCATED BETWEEN THE "FLAGGER" SIGN AND THE "ONE LANE ROAD" SIGN.


FOR LOW SPEED URBAN CONDITIONS

A=100 FT.
B=100 FT.
C=100 FT.

DETAIL - TRAFFIC CONTROL PLAN

NOT TO SCALE


NOTE: TRAFFIC CONTROL PLANS ARE GUIDELINES ONLY. ALL TRAFFIC CONTROL PLANS AND LANE CLOSURES MUST BE APPROVED BY THE OWNER AND ENGINEER.

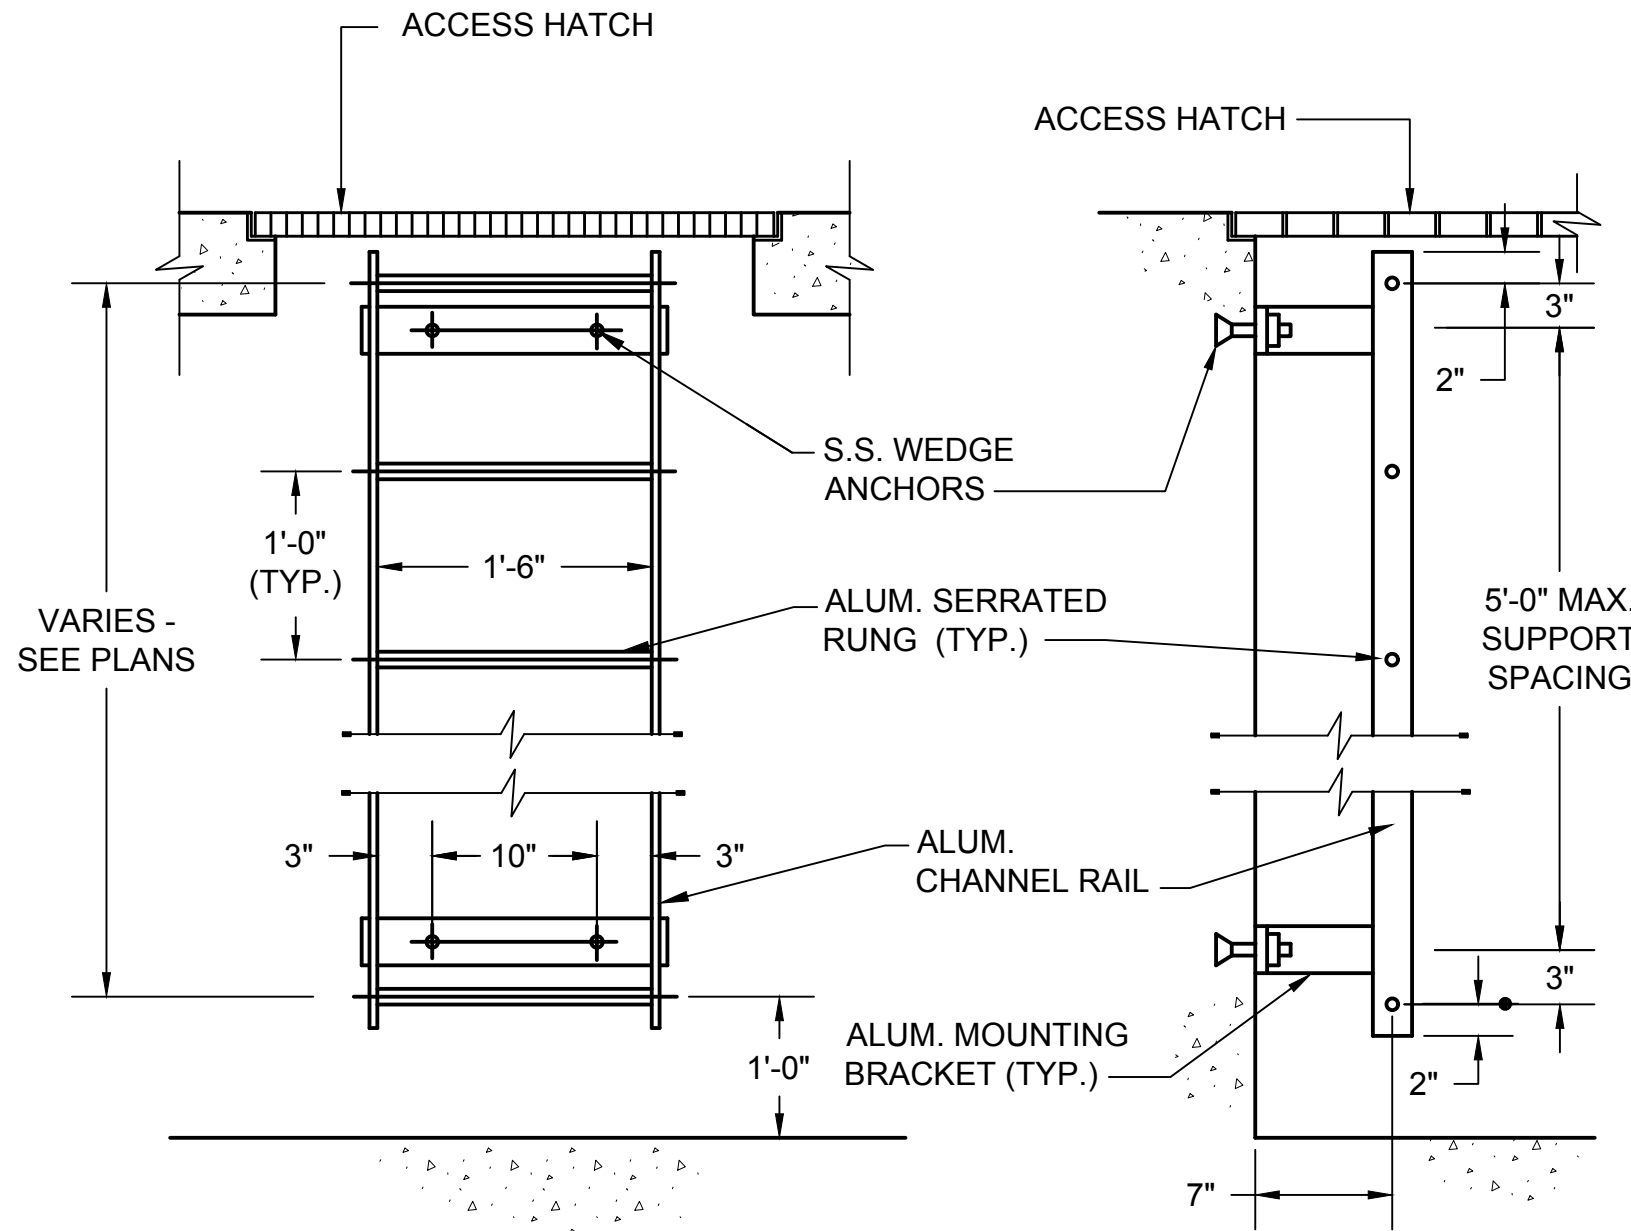

NOTE:
LADDER SHALL BE SUPPLIED WITH ALUM. LADDER SAFETY EXTENSION

DETAIL - ACCESS LADDER

NOT TO SCALE

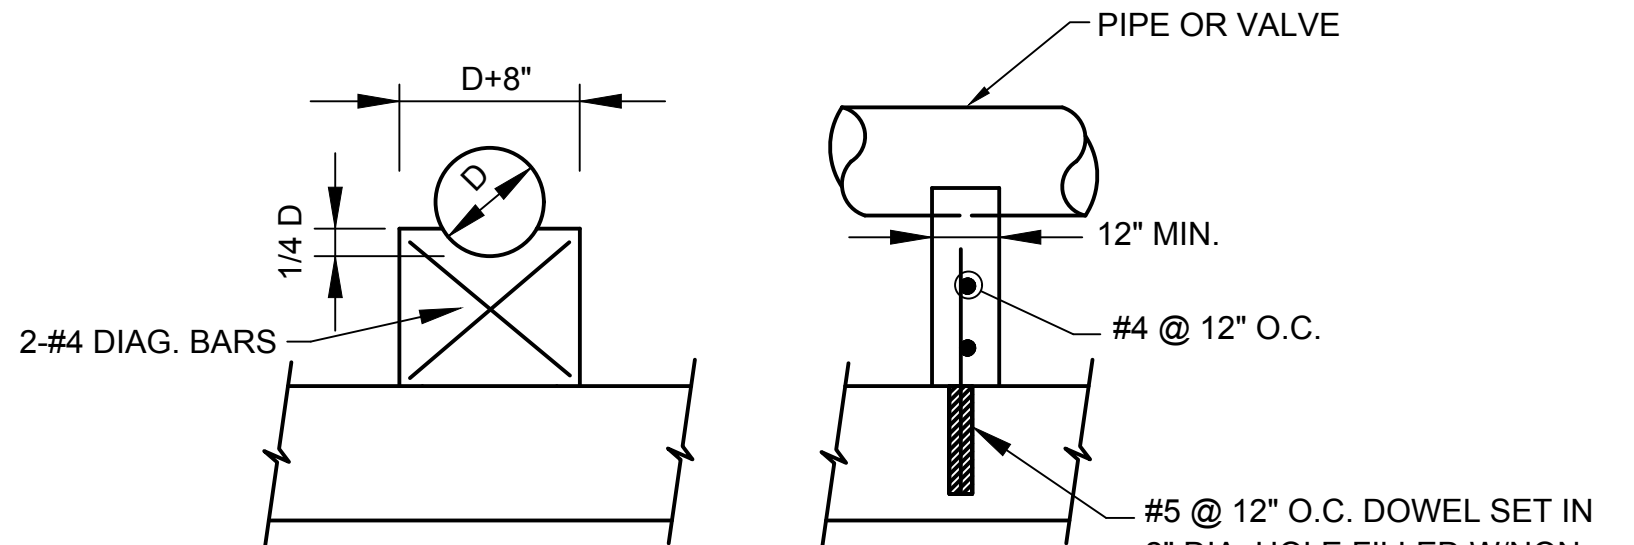


NOTES:

- FOR VALVES AND FITTINGS, SUPPORT WIDTH BASED ON SIZE OF ITEM BEING SUPPORTED AS APPROVED BY THE ENGINEER. FOR WIDTHS GREATER THAN 12" PROVIDE TWO ROWS OF REINFORCING STEEL.
- COAT PIPE/VALVE WITH BOND BREAKER WHERE IT COMES IN CONTACT WITH CONCRETE


DETAIL - VALVE & PIPE SUPPORT

NOT TO SCALE

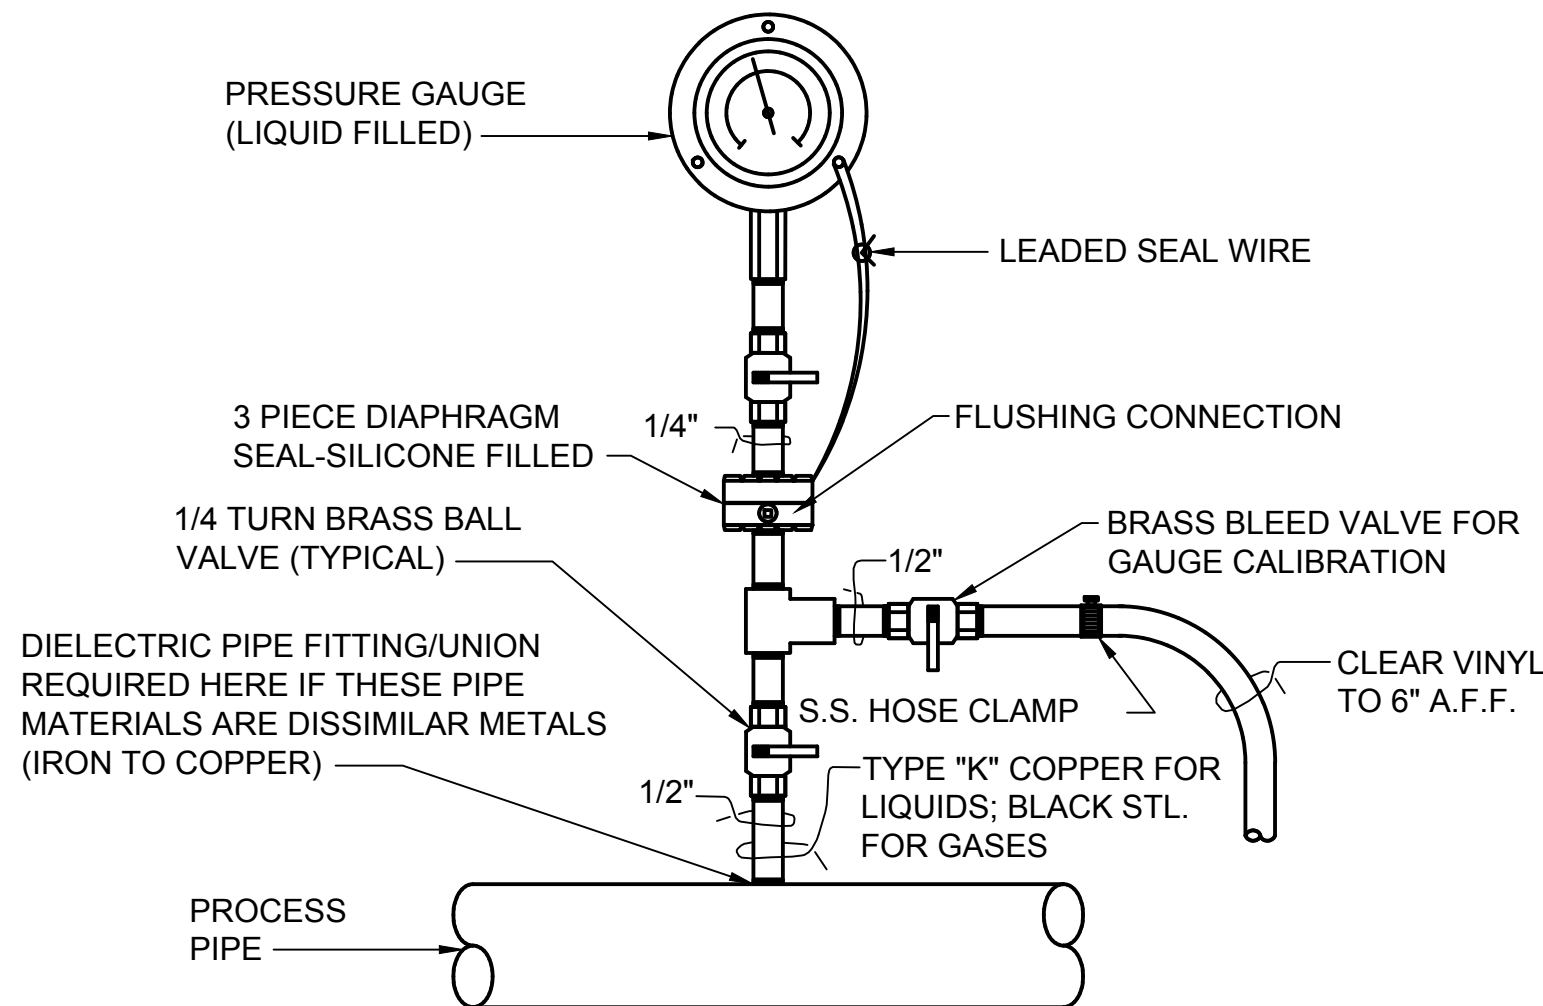

DETAIL - PRESSURE GAUGE

NOT TO SCALE

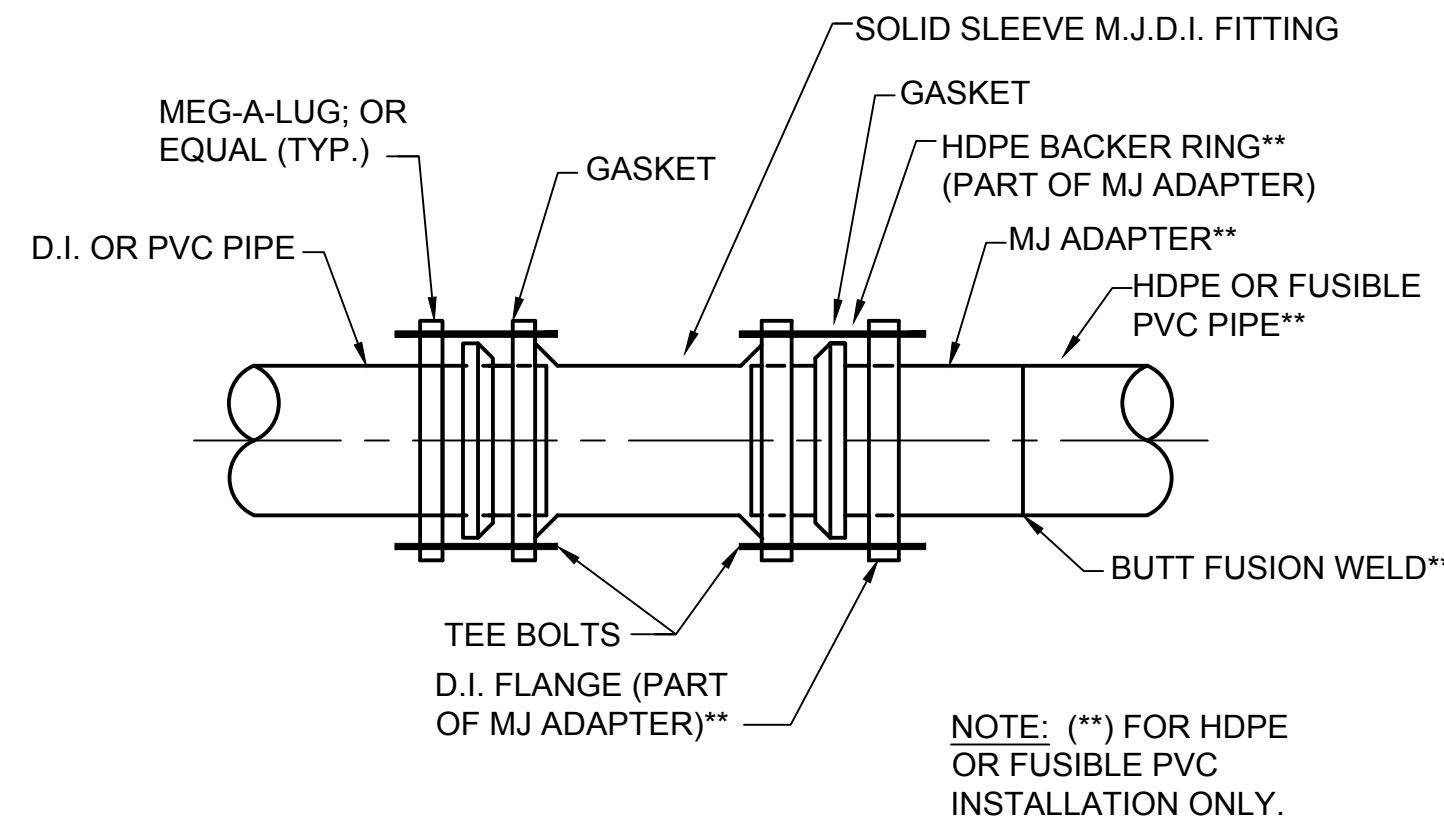

DETAIL - RESTRAINED PIPE TRANSITION COUPLING

NOT TO SCALE


LENGTH IN FT. TO BE RESTRAINED ON EACH SIDE OF FITTING FOR 6" PVC PIPE					
TYPE OF BEND	90° BEND	45° BEND	22 1/2° BEND	11 1/4° BEND	DEADENDS
HORIZ. BEND	12	5	3	2	34
VERT. BEND	---	14 UPPER 4 LOWER	7 UPPER 2 LOWER	4 UPPER 1 LOWER	

RESTRAINED JOINT NOTES

- CONTRACTOR SHALL INSTALL RJDI FITTINGS FOR ALL VERTICAL AND HORIZONTAL BENDS.
- RESTRAINED LENGTHS WERE CALCULATED ASSUMING A 1.5 FACTOR OF SAFETY, TYPE 5 TRENCH CONDITIONS, "SM" SOIL CLASSIFICATION, 5 FT. MIN. DEPTH OF BURY, AND 150 PSI HYDROSTATIC TEST PRESSURE (SOURCE: EBAA IRON RESTRAINT DESIGN CALCULATION SOFTWARE v.6.0).
- ALL FORCEMAIN APPURTENANCES WITHIN RJDI LIMITS MUST BE RESTRAINED AT EACH JOINT.

RESTRAINED JOINT CALCULATIONS

NOT TO SCALE

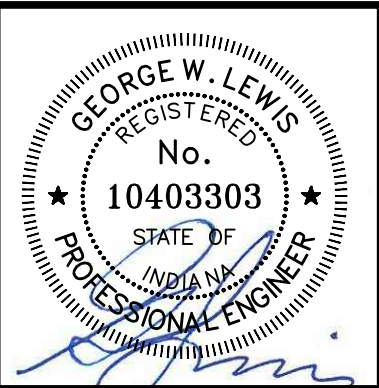

GRW PROJECT NO. 4625
CLIENT PROJECT NO. --
ALL RIGHTS RESERVED. NO PART OF THIS DOCUMENT MAY BE REPRODUCED IN WHOLE OR IN PART WITHOUT THE WRITTEN PERMISSION OF GRW ENGINEERS, INC. AND SHALL NOT BE USED FOR ANY OTHER PROJECT OTHER THAN THIS SPECIFIC PROJECT WITHOUT WRITTEN PERMISSION.



STANDARD DETAILS

BABY FARMS LIFT STATION AND FORCE MAIN IMPROVEMENTS
FALL CREEK REGIONAL WASTE DISTRICT

DESIGNED	GWL	DRAWN	JAJ	REVIEWED	JPT	APPROVED	GWL
NO.	---	---	---	---	---	---	---
DATE	---	---	---	---	---	---	---
DESCRIPTION	---	---	---	---	---	---	---
SCALE CHECK	---	---	---	---	---	---	---

DATE: NOVEMBER 197
SCALE: N.T.S.
SHEET NO.

EROSION CONTROL NOTES

1.

THE IDEM RULE 5 PERMIT REQUIRES THAT THE PERMITTEE SHALL MINIMIZE DISTURBANCE AND THE PERIOD OF TIME THAT THE DISTURBED AREA IS WITHOUT STABILIZATION PRACTICES.
2.

FINAL STABILIZATION SHALL BEGIN WITHIN 14 DAYS ON AREAS OF THE SITE WHERE CONSTRUCTION ACTIVITIES HAVE PERMANENTLY CEASED OR HAVE BEEN SUSPENDED FOR MORE THAN 180 DAYS. WHEN SNOW COVER CAUSES DELAYS, STABILIZATION SHALL BEGIN AS SOON AS POSSIBLE. STABILIZATION PRACTICES INCLUDE SEEDING, MULCHING, PLACING SOD, PLANTING TREES OR SHRUBS, AND USING GEOTEXTILE FABRICS AND OTHER APPROPRIATE MEASURES. SEEDING RATES, DATES AND MATERIALS MAY BE OBTAINED FROM THE LOCAL NATURAL RESOURCES CONSERVATION SERVICE FIELD OFFICE.
3.

FOR ALL CRITICAL AREAS (WITHIN 25' OF A STREAM), SOIL STABILIZATION TECHNIQUES SHALL BE IMPLEMENTED WITHIN 24 HOURS OR AS SOON AS PRACTICABLE AFTER COMPLETION OF GRADING OR DISTURBANCE. TEMPORARY STABILIZATION PRACTICES SHALL BE INITIATED WITHIN 14 DAYS OF CESSATION OF CONSTRUCTION ACTIVITIES.
4.

A STORMWATER POLLUTION PREVENTION PLAN (SWPPP) SHALL BE DEVELOPED AND IMPLEMENTED AS OUTLINED IN THE IDEM RULE 5 STORMWATER PERMIT REQUIREMENTS, IF NOT ALREADY INCLUDED IN THE SPECIFICATIONS. FOR THE LIFT STATION, SITE EROSION CONTROL MEASURES ARE SHOWN BELOW. FOR THE FORCE MAIN INSTALLATION, THE CONTRACTOR SHALL IMPLEMENT MEASURES AS NEEDED DEPENDING ON CONSTRUCTION SEQUENCE AND METHOD.
5.

SEDIMENT BASINS (DEBRIS BASINS, DESILTING BASINS, OR SEDIMENT TRAPS) SHALL BE PROPERLY DESIGNED.
6.

SEDIMENT BASINS (DEBRIS BASINS, DESILTING BASINS, OR SEDIMENT TRAPS) SHALL BE INSTALLED DURING INITIAL GRADING AT LOCATIONS THAT WILL PROVIDE THE BEST PROTECTION FROM OFF-SITE DAMAGES.
7.

ALL SLOPES EXCEEDING 3:1 SHALL HAVE TURF REPLACEMENT MAT INSTALLED PER MANUFACTURER'S RECOMMENDATIONS.
8.

INLET PROTECTION IS REQUIRED TO MINIMIZE DISCHARGE OF SEDIMENT LADEN WATER.
9.

SITE PERIMETER CONTROLS ARE REQUIRED AND SHALL BE INSTALLED TO PREVENT THE DEPOSIT OF SOIL AND DEBRIS FROM GRADED SURFACES ONTO PUBLIC STREETS, INTO DRAINAGE CHANNELS OR SEWERS, OR ONTO ADJOINING LAND.
10.

EROSION CONTROL MEASURES SHOWN ARE THE MINIMUM REQUIRED. CONTRACTOR SHALL PROVIDE ADDITIONAL CONTROLS AND REVISE THE CONTROLS AS NEEDED.

INSPECTIONS AND MAINTENANCE

1.

ALL EROSION CONTROL MEASURES, DISCHARGE LOCATIONS, VEHICLE EXITS, DISTURBED AREAS OF THE SITE, AND MATERIALS STORAGE AREAS SHALL BE INSPECTED WEEKLY AND WITHIN 24 HOURS OF THE END OF A STORM THAT IS 0.5 INCHES OR GREATER. EACH INSPECTION MUST BE DOCUMENTED IN ACCORDANCE WITH THE IDEM GENERAL PERMIT FOR STORMWATER POINT SOURCE DISCHARGES FROM CONSTRUCTION ACTIVITIES.
2.

SEDIMENT ACCUMULATED AT THE SILT FENCES, INLET PROTECTION AREAS, AND OTHER SILT CHECK DEVICES SHOULD BE REMOVED NO LATER THAN WHEN IT REACHES 1/3 HEIGHT OF THE FENCE OR 9 INCHES MAXIMUM.

3.

SEDIMENT MUST BE REMOVED FROM ANY SEDIMENT BASINS WHEN THE NO MORE THAN 1/3 OF THE VOLUME HAS BEEN FILLED WITH COLLECTED SEDIMENT.
4.

ALL REQUIRED REPAIRS ARE TO BE MADE IMMEDIATELY.
5.

REMOVED SEDIMENT MUST BE SPREAD AND VEGETATED OR OTHERWISE STABILIZED IN A MANNER THAT DOES NOT RESULT IN MUDDY RUNOFF TO NEARBY DITCHES AND WATERBODIES.
6.

INSPECT THE CONSTRUCTION ENTRANCE DAILY TO ENSURE NO TRACKING OF DIRT ONTO LOCAL ROADWAYS. ALL SEDIMENT SPILLED, DROPPED, WASHED OR TRACKED ONTO PUBLIC ROAD MUST BE REMOVED IMMEDIATELY. SEE NOTE 3 FOR HANDLING OF REMOVED SEDIMENT.
7.

MAINTAIN THE ENTRANCE AS NECESSARY TO PREVENT TRACKING OF DIRT.
8.

UNTIL THE OWNER PERFORMS A FINAL INSPECTION AND THE LAND DISTURBING PERMIT IS CLOSED, THE PERSON RESPONSIBLE SHALL TAKE SUCH MEASURES AS ARE NECESSARY TO PREVENT EROSION OF GRADED STREETS, INTO DRAINAGE CHANNELS OR SEWERS, OR ONTO ADJOINING LAND.

SEQUENCE OF EROSION CONTROL PLAN ACTIVITIES

1.

IDENTIFY AND FLAG OFF AREAS NOT TO BE DISTURBED AND/OR COMPACTED.
2.

CONSTRUCT STABILIZED CONSTRUCTION ENTRANCE.
3.

INSTALL UPGRADIENT DIVERSION SWALES AND BERMS.
4.

INSTALL SEDIMENT BARRIERS (SILT FENCES).
5.

CONSTRUCT OTHER SWALES.
6.

CONSTRUCT STORM CONVEYANCE SYSTEM (INLETS AND STORM SEWERS)
7.

BEGIN CLEARING AND GRADING FOR THE ROADS, BUILDINGS, TANKS, OR PIPES.
8.

STABILIZE BARE AREAS AFTER FINAL GRADE IS REACHED.
9.

CONSTRUCT ROADS, BUILDINGS, TANKS, OR PIPES.
10.


INSTALL LANDSCAPING.
11.

DREDGE SEDIMENT BASIN AND INSTALL TEMPORARY EROSION CONTROL BLANKET ON ALL SLOPES.
12.

REMOVE ALL CONTROLS ONCE THE SITE HAS BEEN FULLY STABILIZED.
13.


FINAL INSPECTION FOR LAND DISTURBANCE PERMIT.
14.

TEMPORARY DIVERSION DITCHES MAY BE REQUIRED DURING CONSTRUCTION TO MITIGATE EROSION OF THE DISTURBED CONSTRUCTION AREA, BY DIRECTING OFF-SITE DRAINAGE AROUND THE DISTURBANCE AREAS.

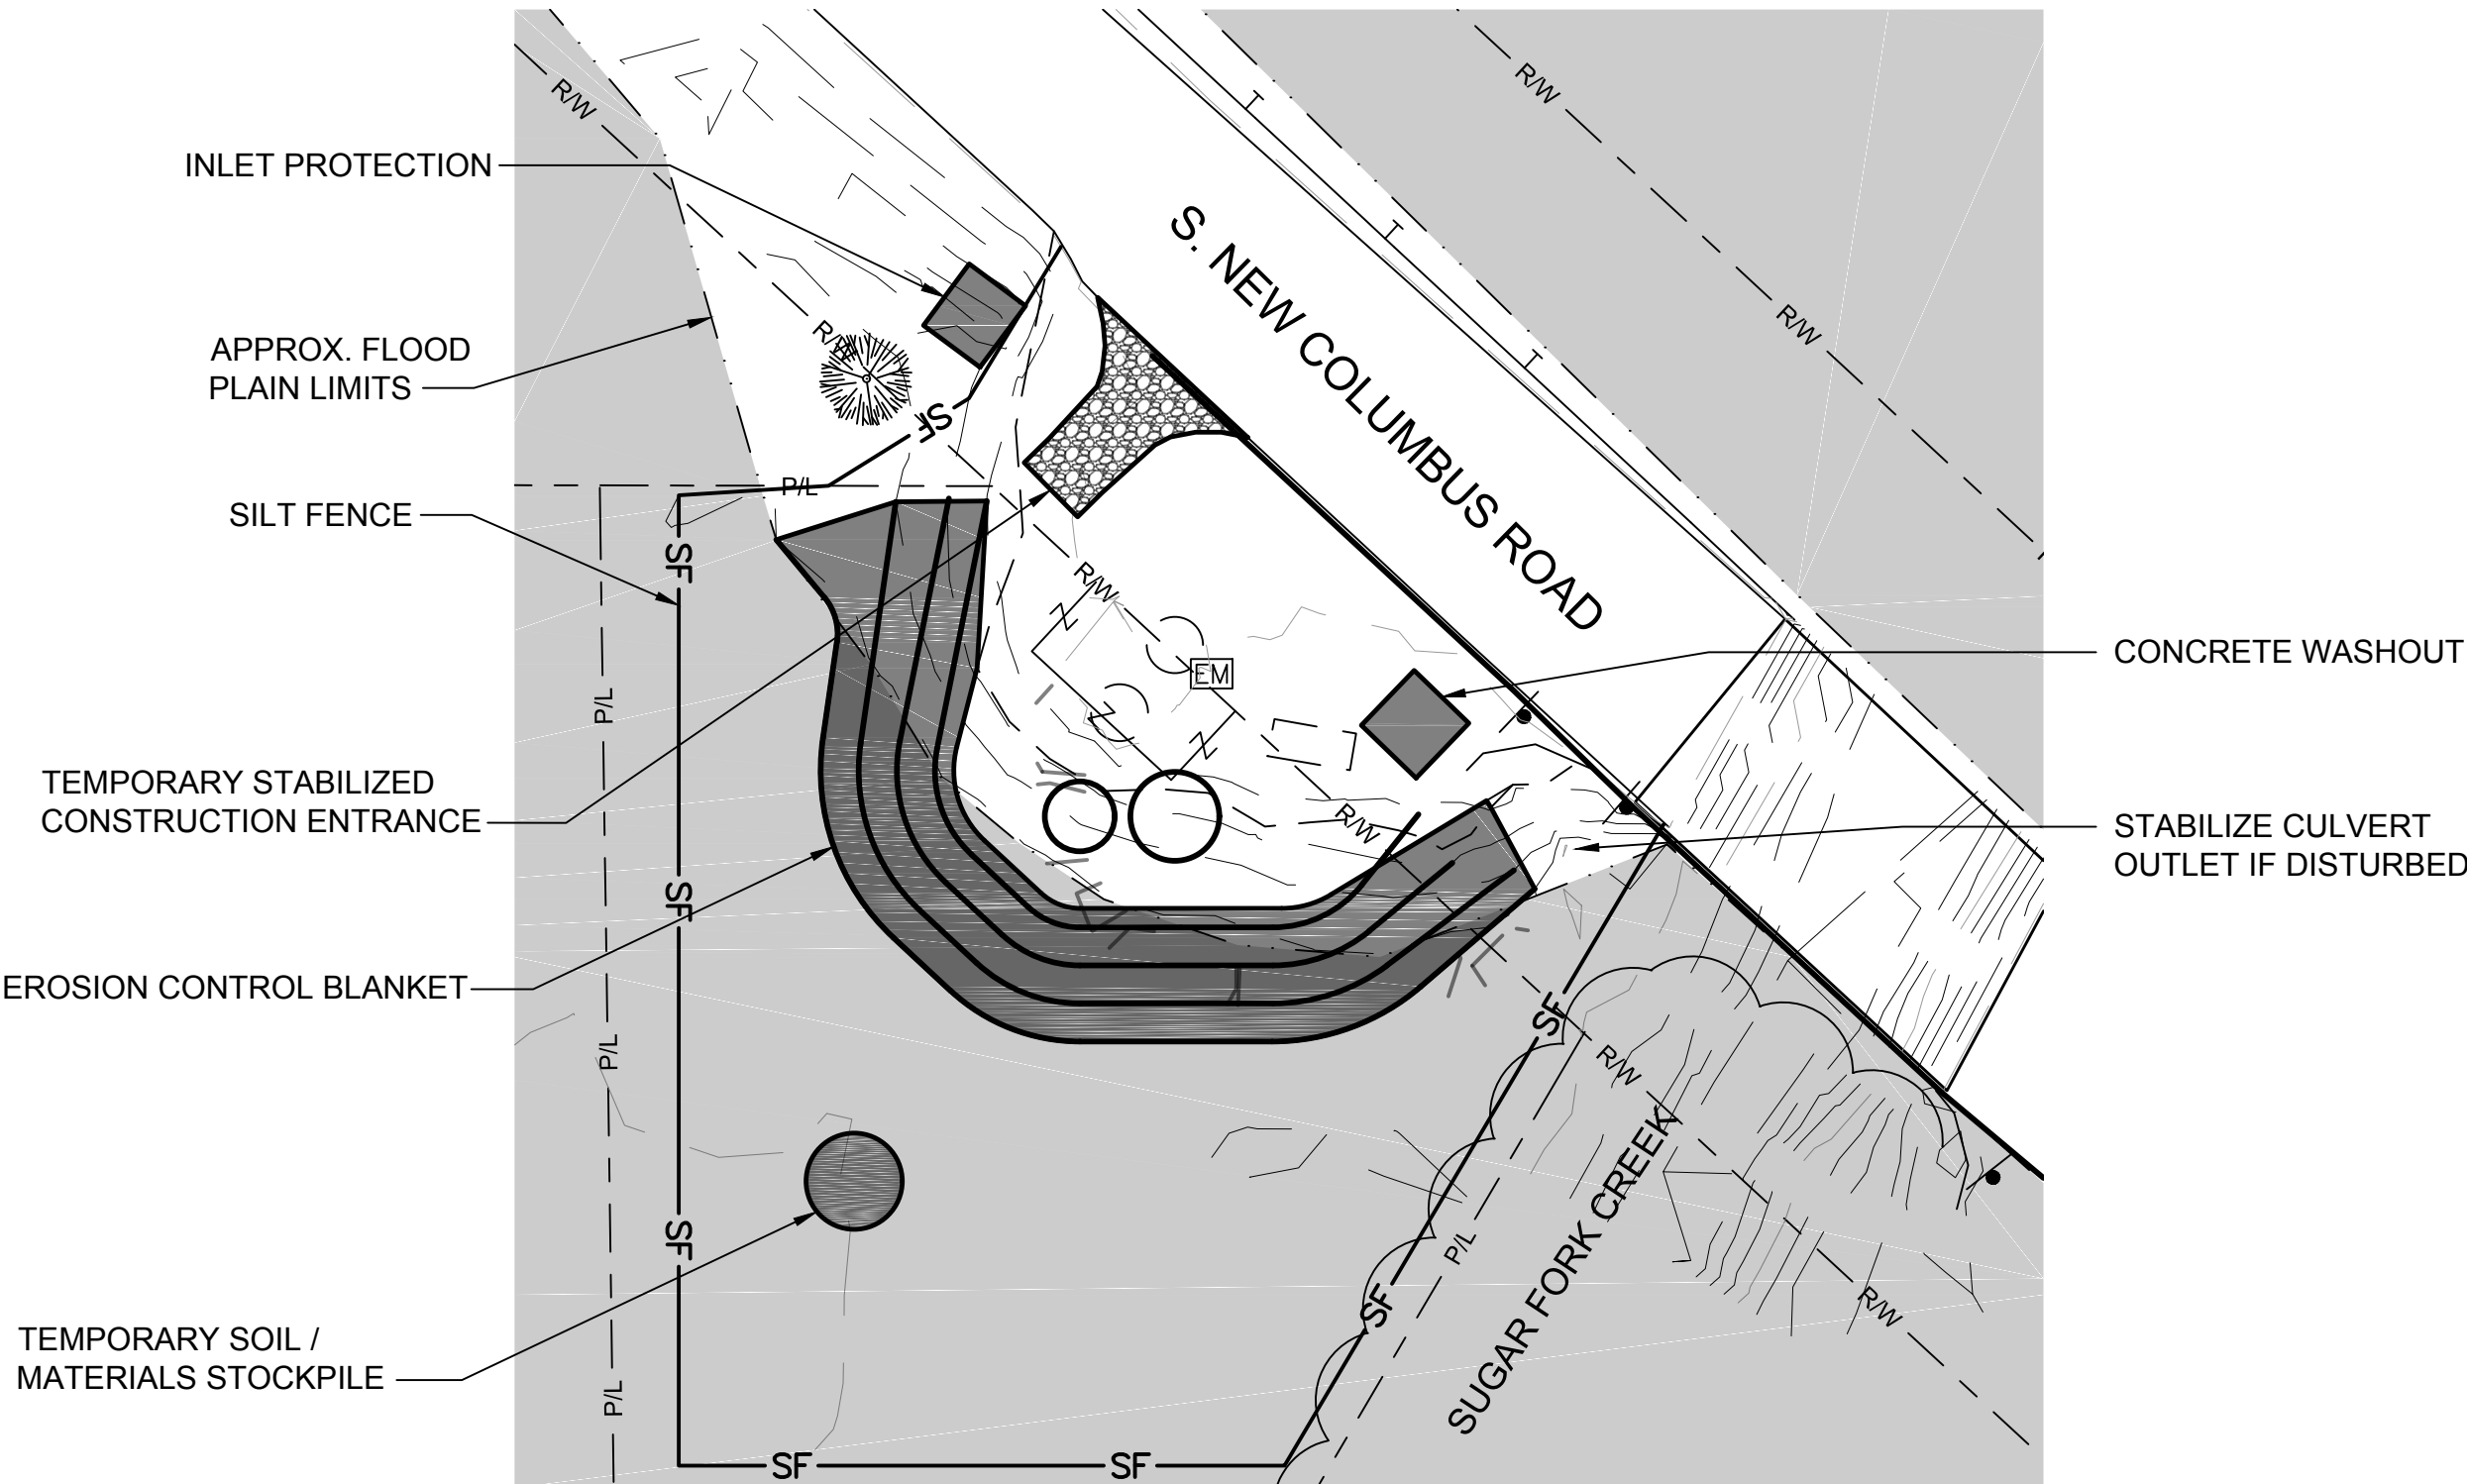

EROSION CONTROL LIFT STATION SITE

SCALE: 1"=20'-0"

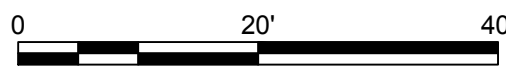

LEGEND

SF SILT FENCE

STABILIZATION PRACTICE	JAN.	FEB.	MAR.	APR.	MAY	JUN.	JUL.	AUG.	SEP.	OCT.	NOV.	DEC.
PERMANENT SEEDING							*/////////*					
DORMANT SEEDING												
TEMPORARY SEEDING												
SODDING **							*/////////*					
MULCHING												


NOTE:
SEEDING TYPES AND MIXTURES SHALL BE PER INDIANA STORMWATER QUALITY MANUAL. NO TALL FESCUE SHALL BE USED IN FLOODPLAIN AREAS.

//// IRRIGATION NEEDED DURING JUNE, JULY, AND/OR AUGUST.

** IRRIGATION NEEDED FOR 2 TO 3 WEEKS AFTER APPLYING SOD.


SEASONAL SOIL PROTECTION CHART

NOT TO SCALE

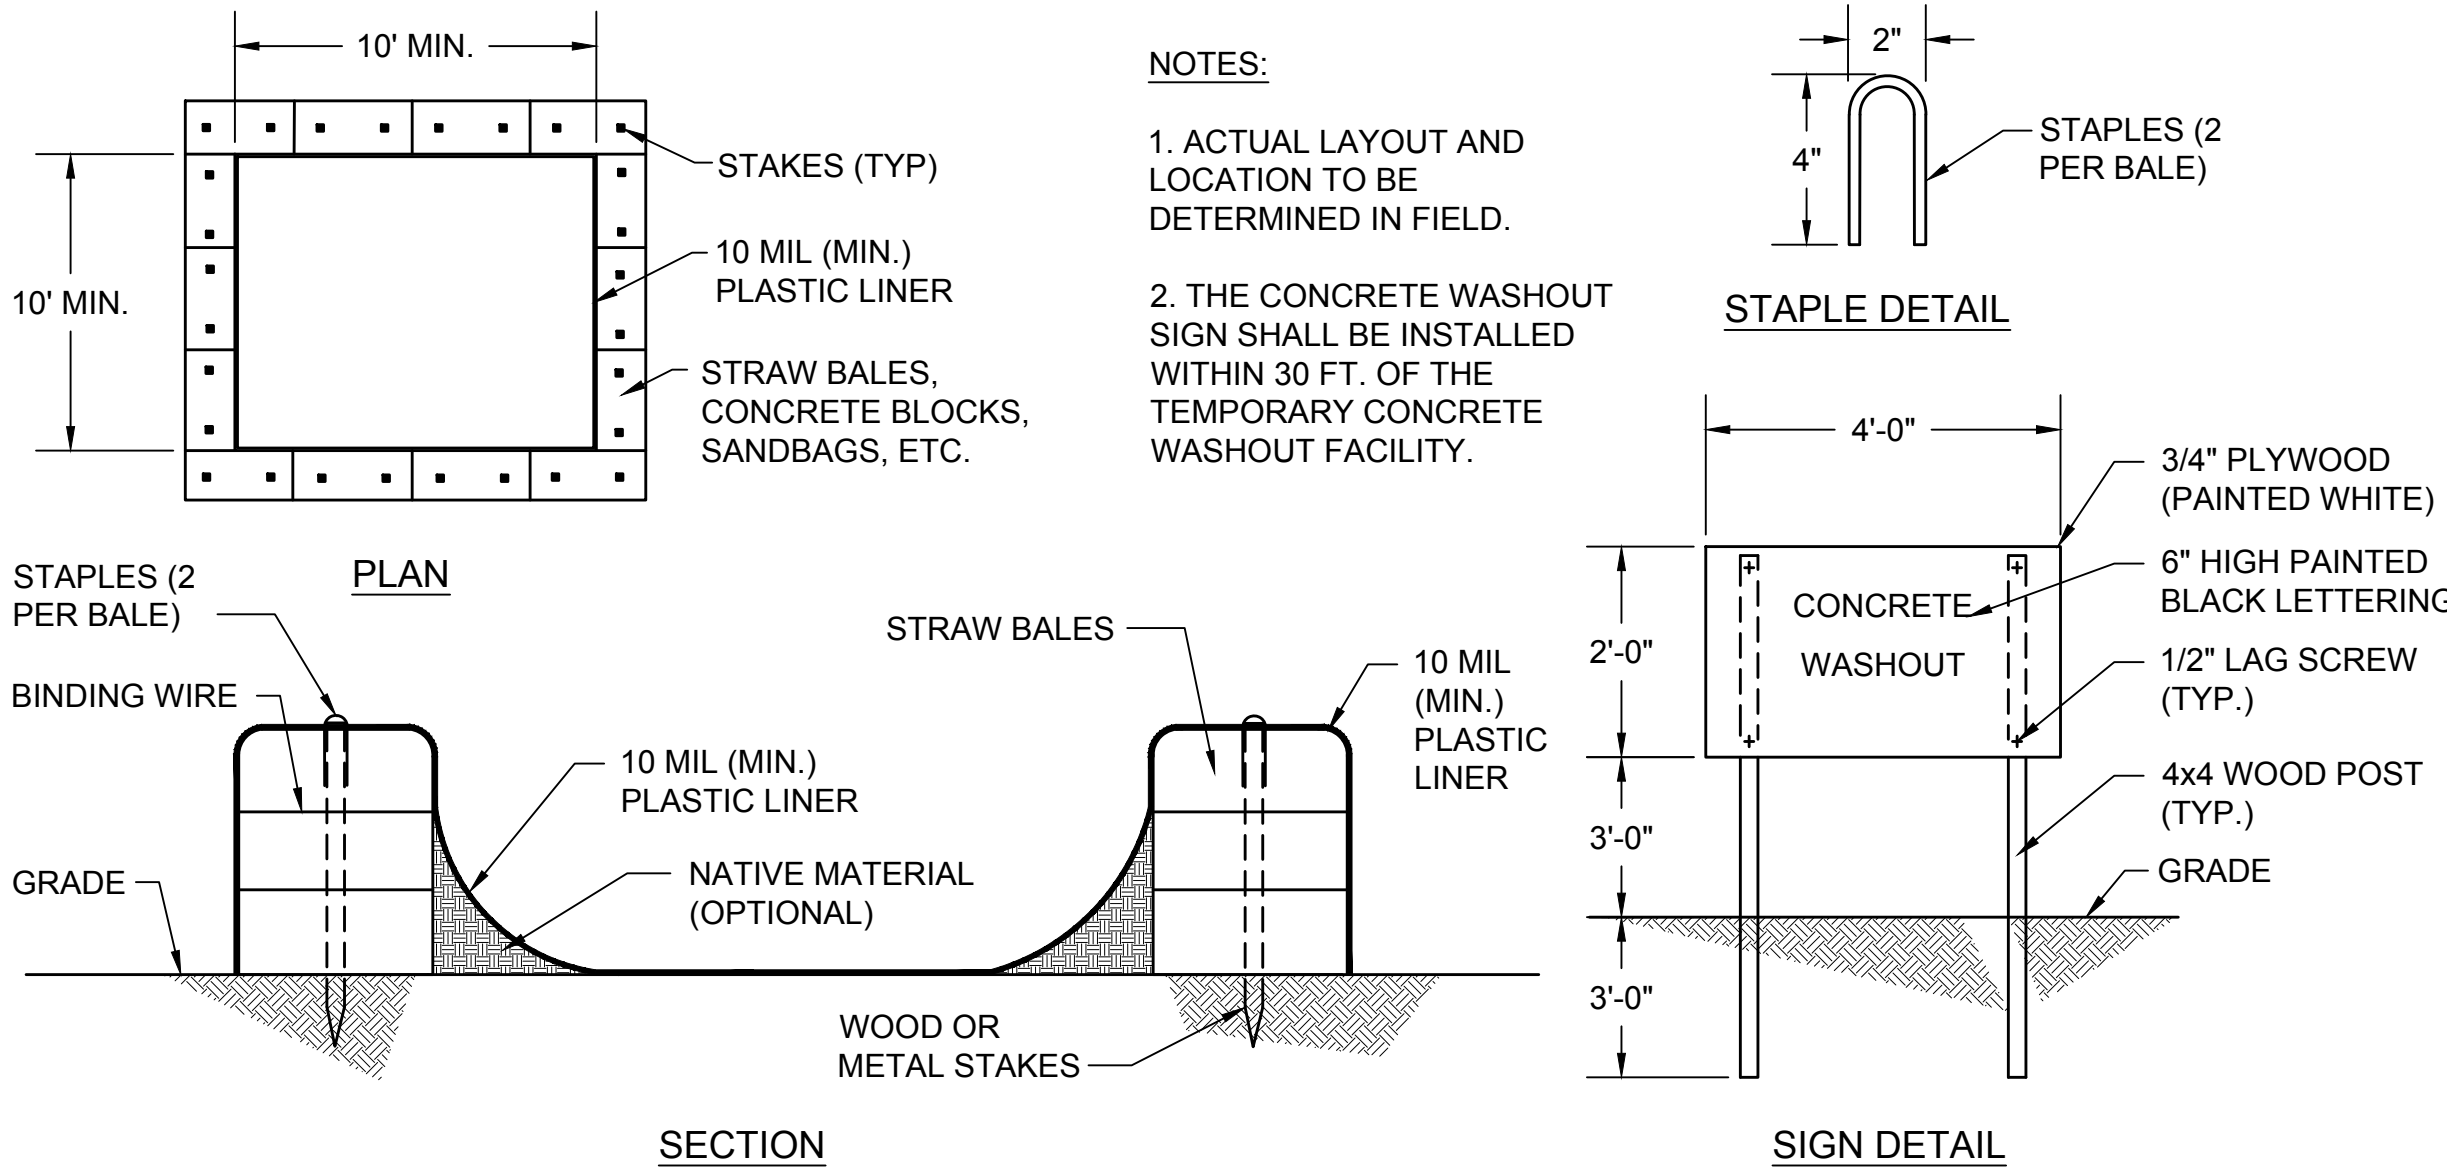

CONCRETE WASHOUT DETAILS

NOT TO SCALE

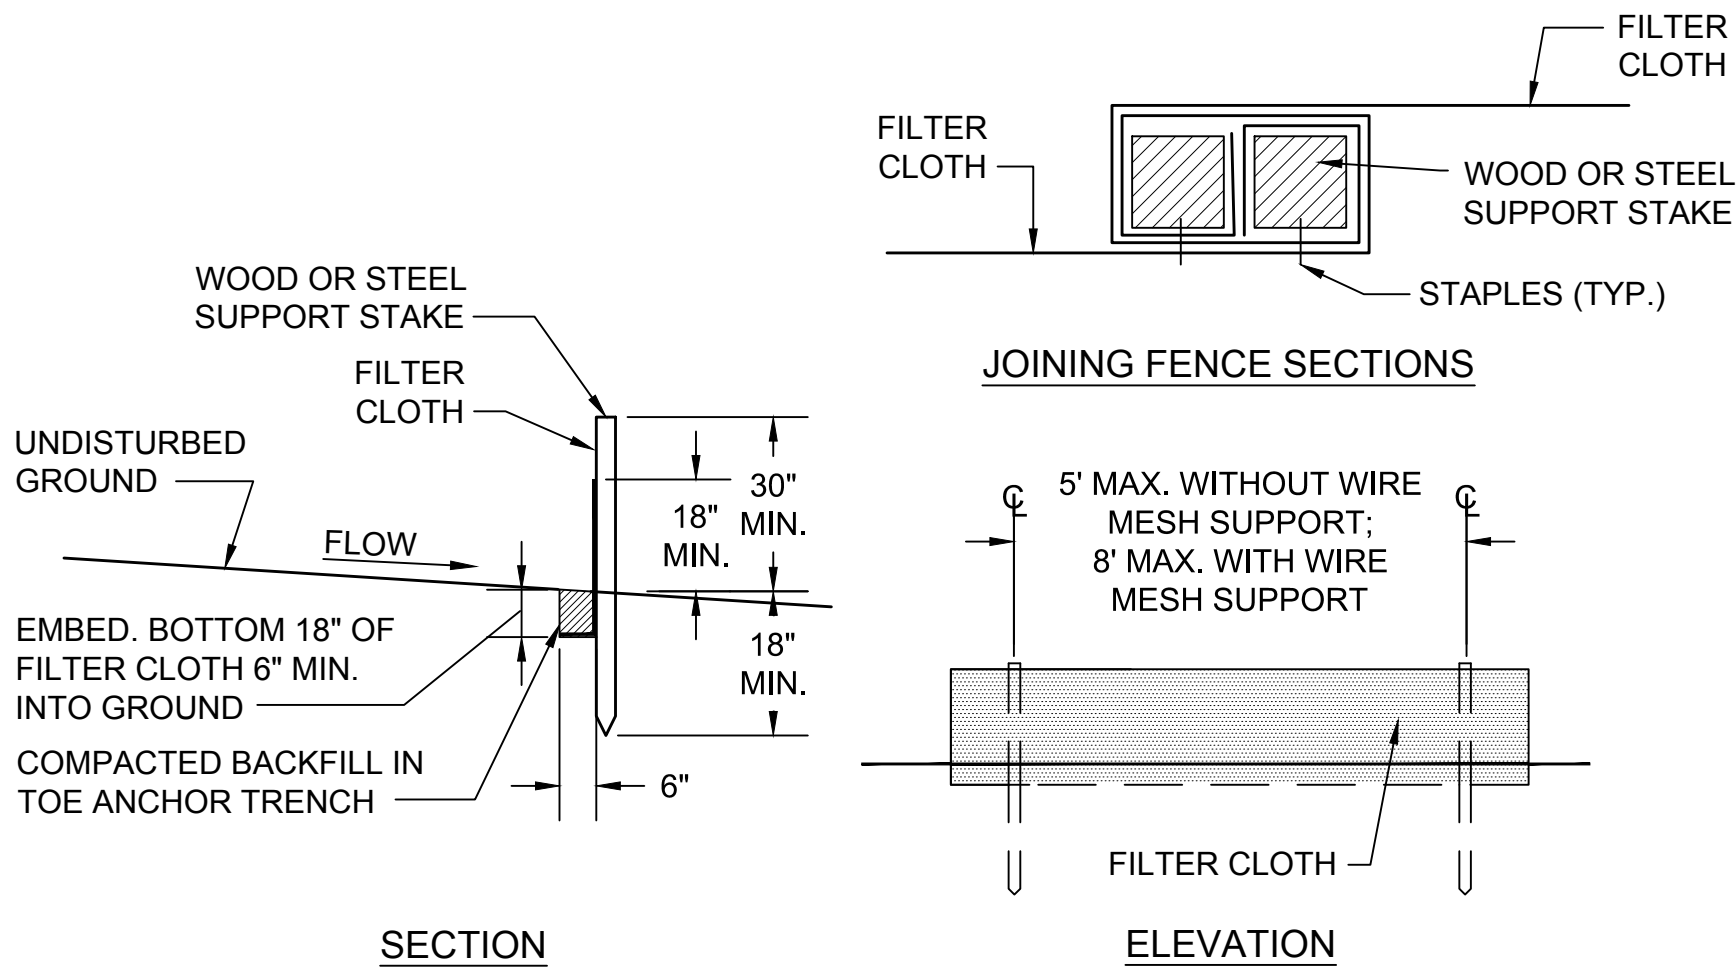

STANDARD SILT FENCE REQUIREMENTS

FILTER FABRIC FENCE DETAILS

NOT TO SCALE

NOTES:

1.

GEOTEXTILE FABRIC SHALL BE PURCHASED IN A CONTINUOUS ROLL AND CUT TO THE LENGTH OF THE BARRIER. WHEN JOINTS CANNOT BE AVOIDED, GEOTEXTILE FABRIC SHALL BE SPliced TOGETHER ONLY AT A POST WITH 3 FOOT MIN. OVERLAP, AND SECURELY SEALED.
2.

POSTS SHALL BE AT LEAST 5 FEET IN LENGTH.
3.

STEEL POSTS SHALL HAVE PROJECTIONS FOR FASTENING WIRE AND FABRIC.
4.

WOOD POSTS SHALL BE 2 INCHES BY 2 INCHES OR EQUIVALENT. STEEL POSTS SHALL BE 1.33 LBS PER LINEAR FOOT.
5.

IF REQUIRED, A WIRE MESH SUPPORT FENCE SHALL BE FASTENED SECURELY TO THE UPSLOPE SIDE OF THE POSTS USING HEAVY DUTY WIRE STAPLES AT LEAST 1 INCH IN LENGTH, WIRE TIES OR HOG RINGS. THE WIRE SHALL EXTEND INTO THE TRENCH A MINIMUM OF 2 INCHES AND SHALL NOT EXTEND MORE THAN 36 INCHES ABOVE THE ORIGINAL GROUND SURFACE.
6.

TURN SILT FENCE UP SLOPE AT ENDS.

GEORGE W. LEWIS
REGISTERED
No. 10403303
STATE OF INDIANA
PROFESSIONAL ENGINEER

GRW PROJECT NO. 4625
CLIENT PROJECT NO. --
ALL RIGHTS RESERVED. NO PART OF THIS DOCUMENT MAY BE REPRODUCED IN WHOLE OR IN PART WITHOUT THE WRITTEN PERMISSION OF GEORGE W. LEWIS & COMPANY, INC. AND SHALL NOT BE USED FOR ANY OTHER PROJECT OTHER THAN THIS SPECIFIC PROJECT WITHOUT WRITTEN PERMISSION.

engineering | architecture | geospatial

www.grwinc.com

EROSION CONTROL DETAILS

BABY FARMS LIFT STATION AND FORCE MAIN IMPROVEMENTS
FALL CREEK REGIONAL WASTE DISTRICT

DESIGNED	GWL	DRAWN	JAJ	REVIEWED	JPT	APPROVED	GWL
NO.							
DATE							
DESCRIPTION							

THIS MARK SHOULD MEASURE EXACTLY 1" WHEN PLOTTED

SCALE CHECK

DATE: NOVEMBER 2017

SCALE: NOTED

SHEET NO.


C-10

INTERIOR LIGHTING


SUBSCRIPTS INDICATE THE FOLLOWING:

LF-X = INDICATES LUMINAIRE TYPE
E = INDICATES EMERGENCY BATTERY BACKUP
a = DENOTES SINGLE SWITCH DESIGNATION
a/b = DENOTES DUAL SWITCH DESIGNATION

CEILING MTD

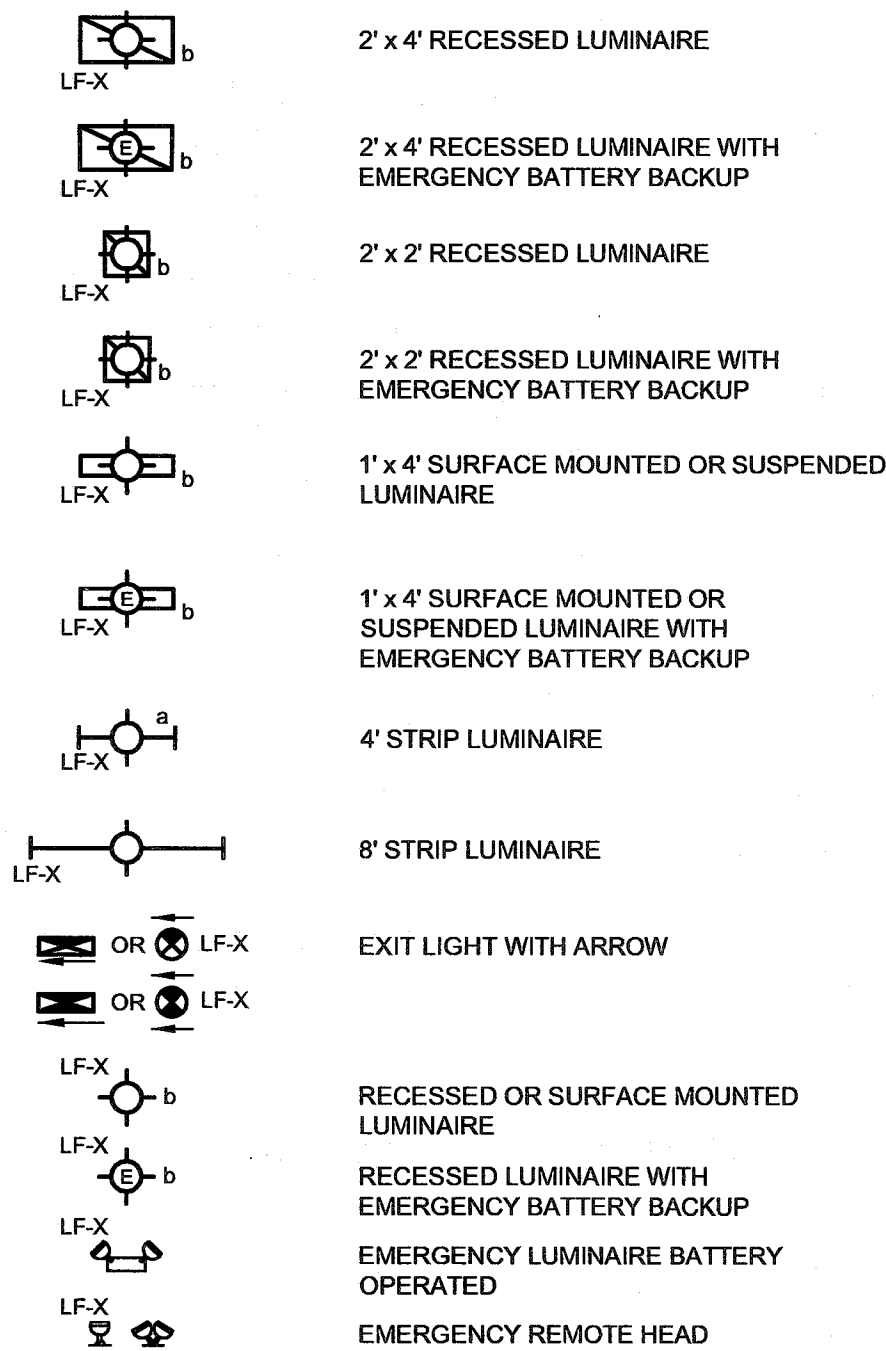


WALL MTD

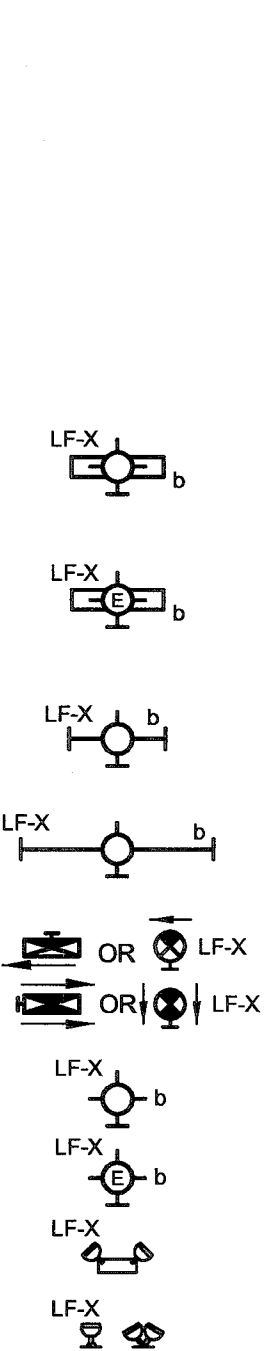


INTERIOR LIGHTING CONTROLS

SUBSCRIPTS INDICATE THE FOLLOWING:

a = SWITCH DESIGNATION
2 = DIMMER
2 = DOUBLE-POLE
3 = THREE-WAY
4 = FOUR-WAY
K = KEY-OPERATED
OC = OCCUPANCY SENSOR
P = PILOT LIGHT
T = TIMER
L = LOW-VOLTAGE
M = MOTOR RATED WITH OVERLOAD PROTECTION
IG = ISOLATED GROUND
EXP = EXPLOSION PROOF
WP = WEATHERPROOF
DR = DOOR SWITCH

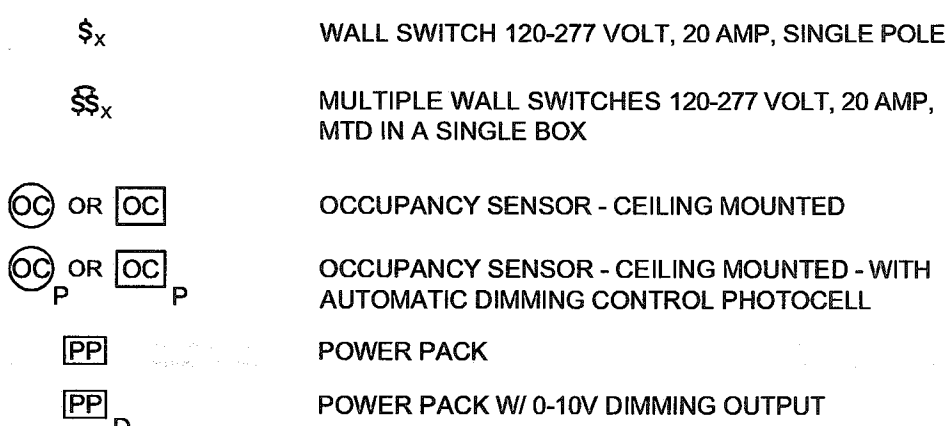


INTERIOR CONDUIT & WIRE

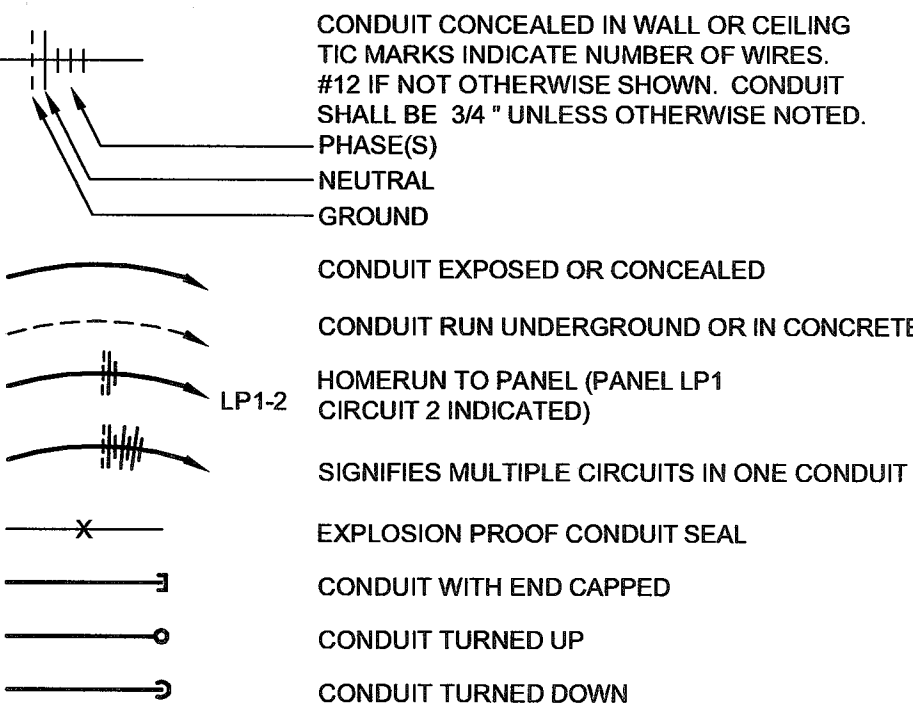

POWER WIRING DEVICES


SUBSCRIPTS INDICATE THE FOLLOWING:

WP = WEATHERPROOF, IN-USE COVER
WR = WEATHER-RESISTANT WIRING DEVICE
GFCI = GROUND FAULT CIRCUIT INTERRUPTER
GF-BF = BLANK FACE GROUND FAULT INTERRUPTER
IG = ISOLATED GROUND
EXP = EXPLOSION PROOF
ACT = ABOVE COUNTER TOP
TR = TAMPER-RESISTANT WIRING DEVICE
AFCI = ARC FAULT CIRCUIT INTERRUPTER
SPD = SURGE PROTECTION DEVICE

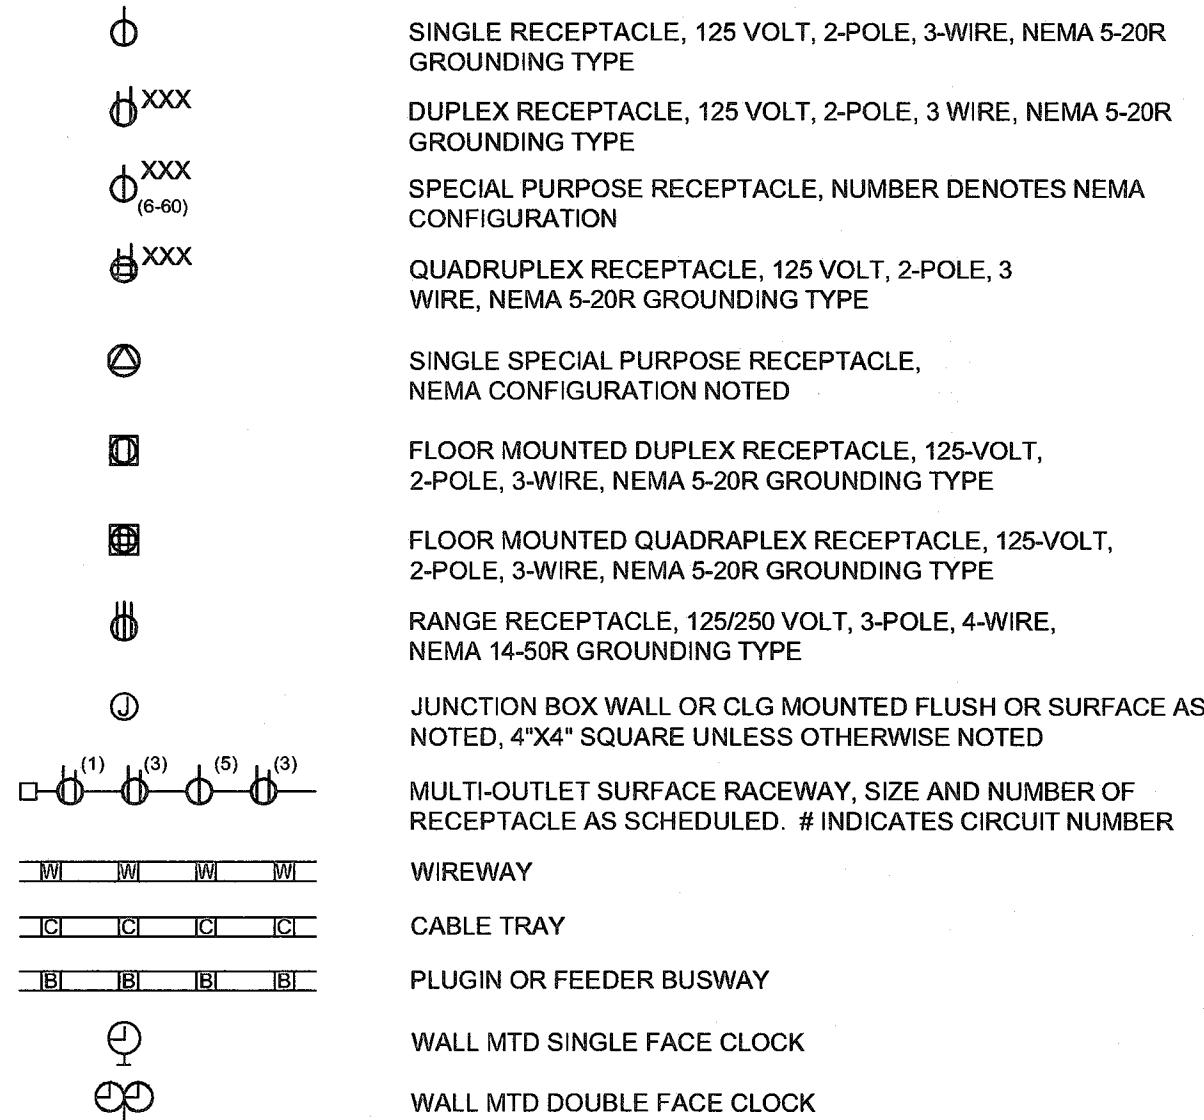


POWER DEVICES

MOTOR CONNECTION (5 HP INDICATED)

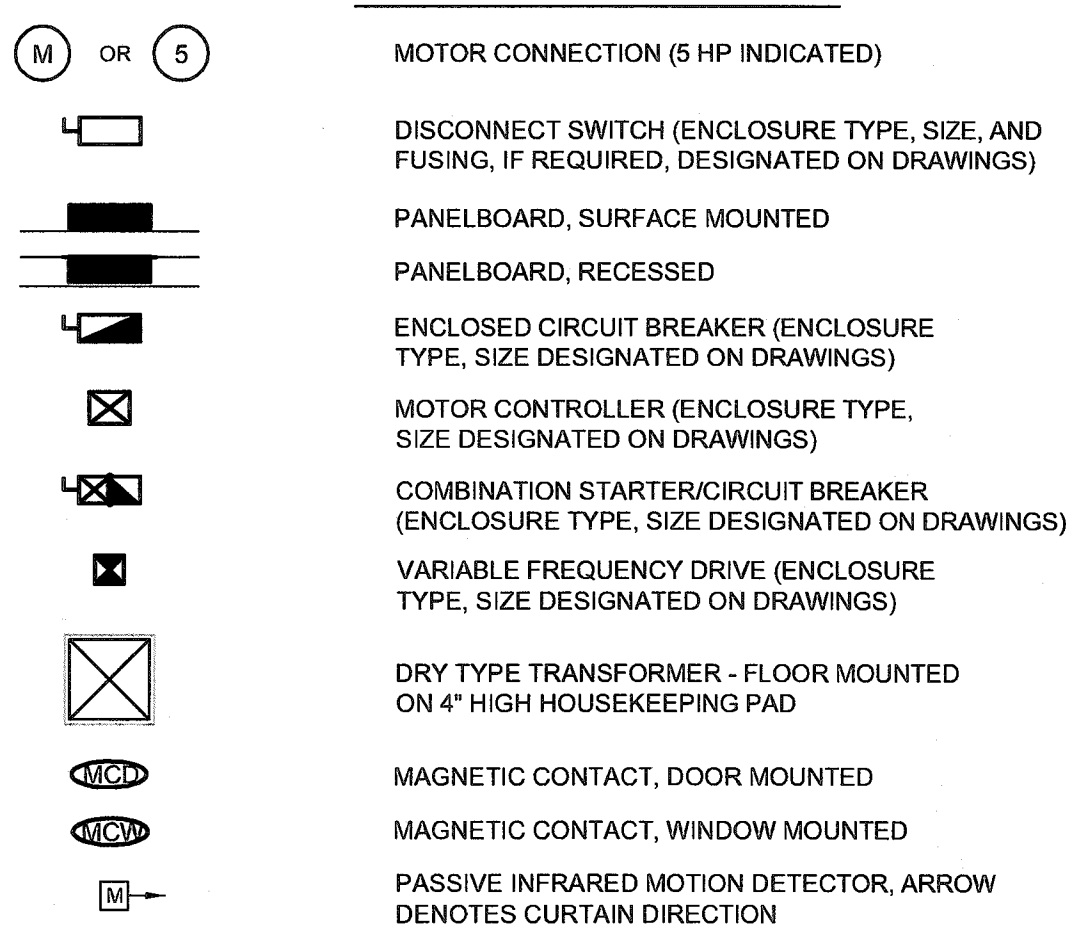


TELECOMMUNICATIONS


SUBSCRIPTS INDICATE THE FOLLOWING:

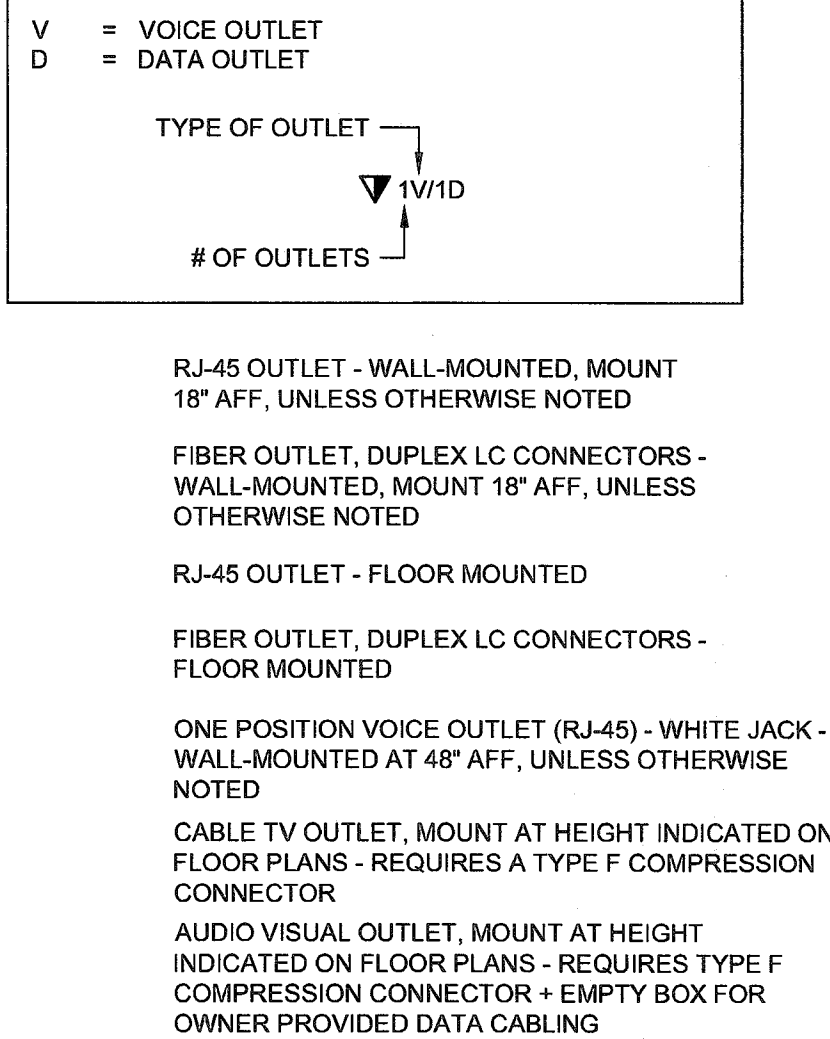


FIRE ALARM/SUPPRESSION SYSTEM DEVICES

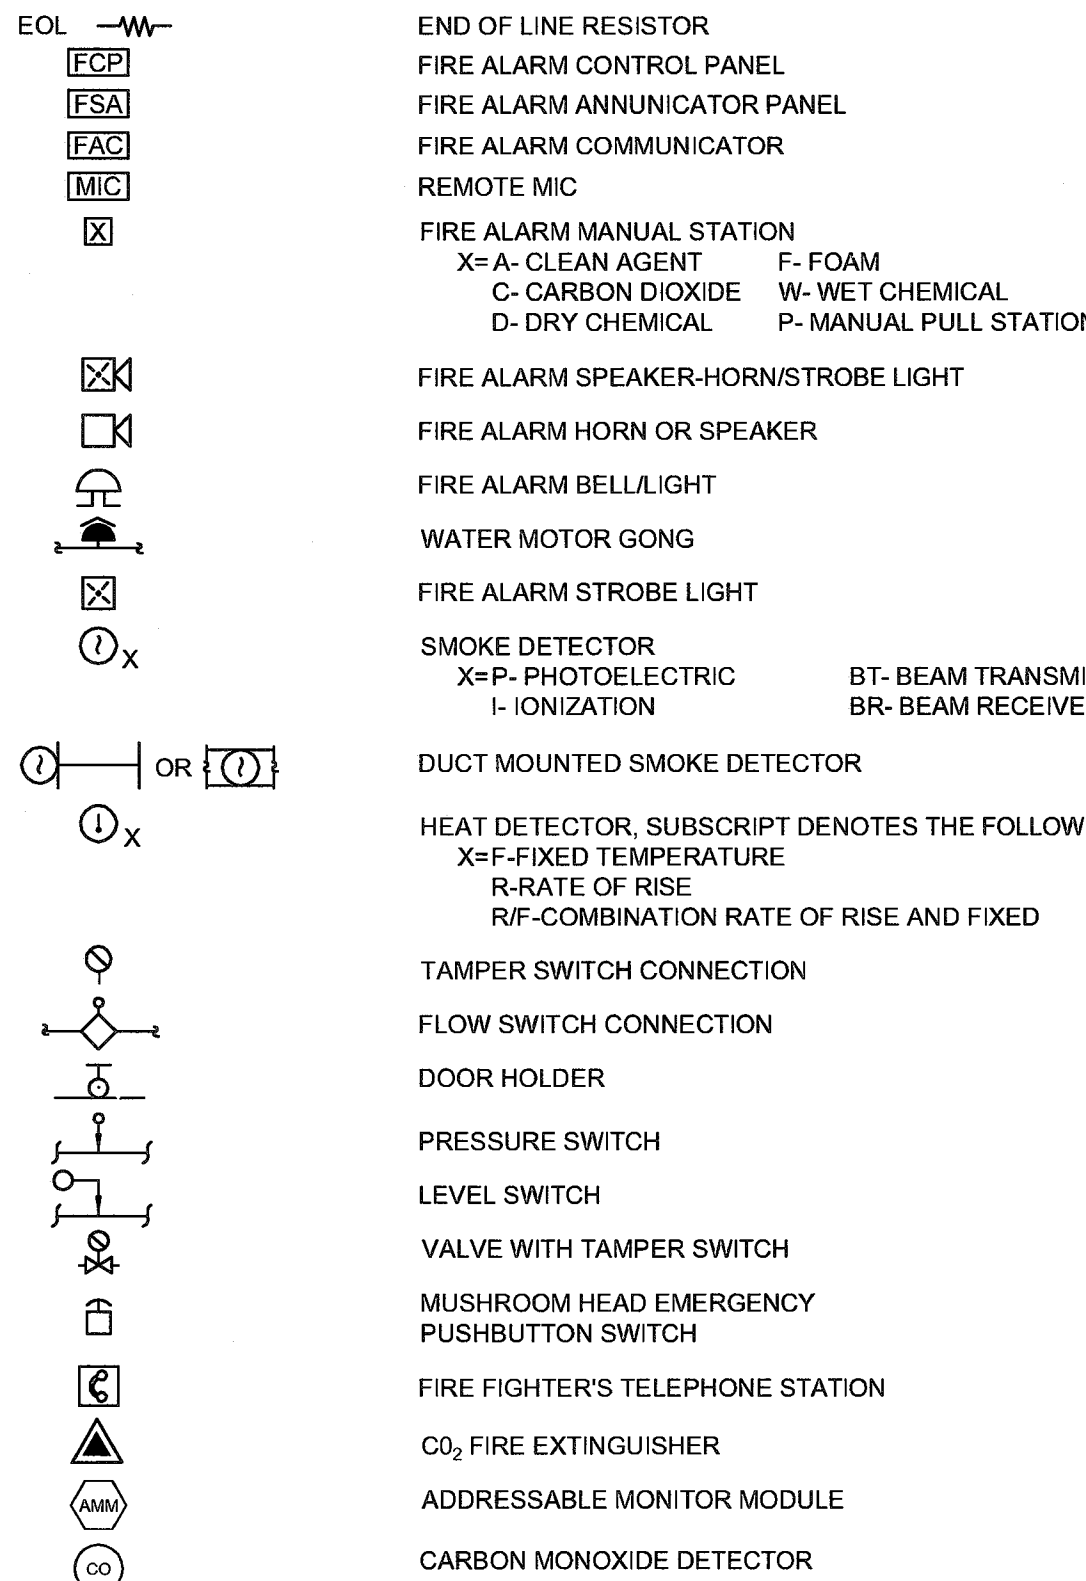


EXISTING

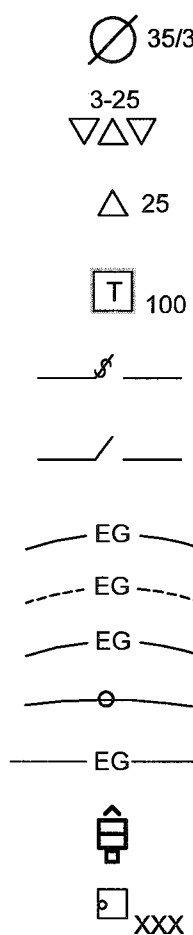

EXTERIOR

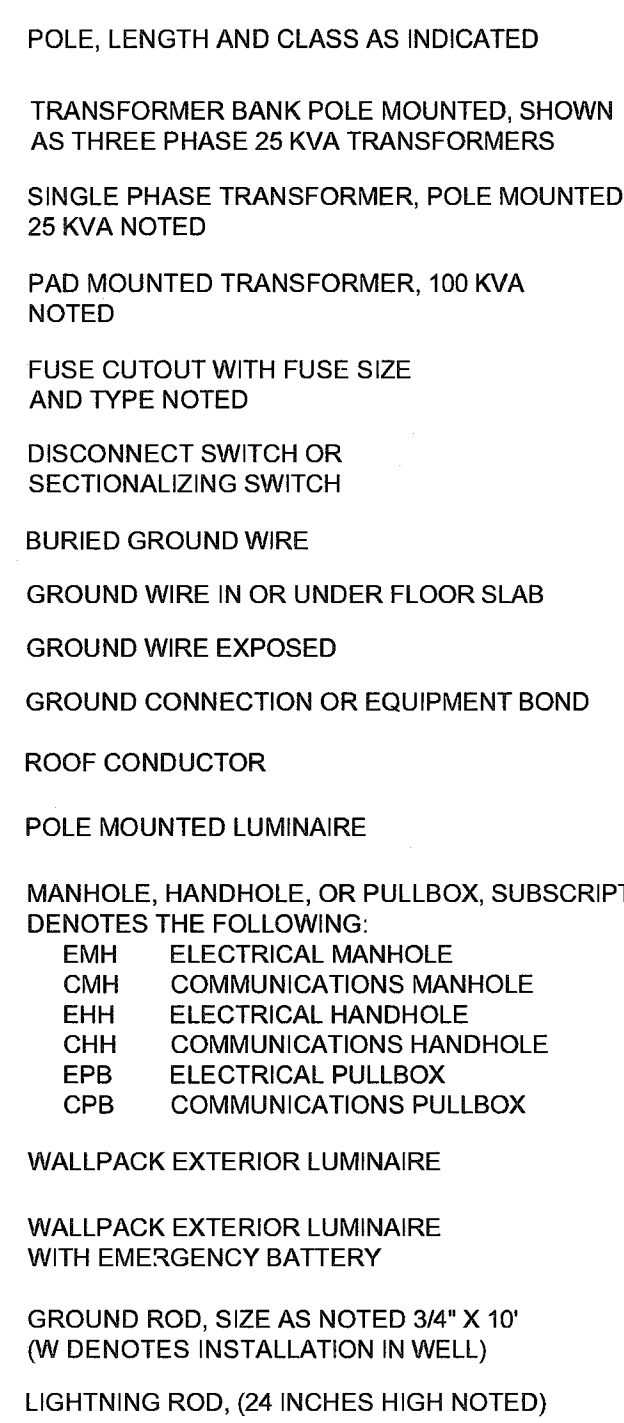


NEW

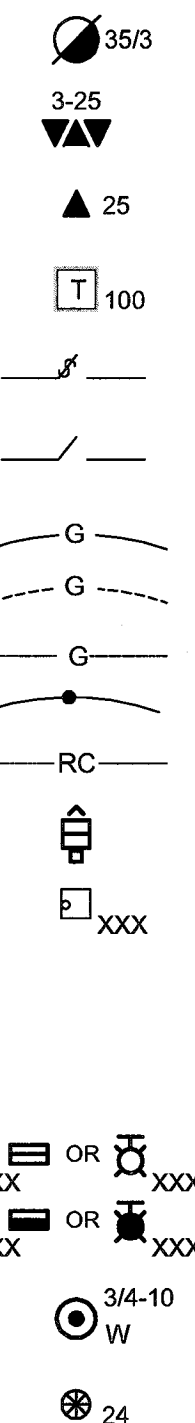

GENERAL NOTES:

- THE MINIMUM STANDARD FOR ALL WORK SHALL BE THE LATEST EDITION OF THE INTERNATIONAL BUILDING CODE WITH IN STATE AMENDMENTS AND THE NATIONAL ELECTRICAL CODE (NEC).
- ALL ELECTRICAL WORK SHALL BE PERFORMED BY AN IN-STATE LICENSED ELECTRICIAN.
- ALL PERMITS NEEDED TO LEGALLY PERFORM THE ELECTRICAL WORK SHALL BE OBTAINED BY THE CONTRACTOR PRIOR TO START OF WORK. COST OF PERMITTING IS BY THE CONTRACTOR.
- AT COMPLETION OF THE WORK, A CERTIFICATE OF COMPLIANCE FROM THE LOCAL AHA OVER THE ELECTRICAL WORK SHALL BE PROVIDED TO THE ENGINEER AND OWNER. COST OF ELECTRICAL INSPECTION IS BY THE CONTRACTOR.
- ALL MATERIALS USED IN THE PROJECT GENERALLY SHALL BE NEW AND UNUSED, UNLESS OTHERWISE NOTED ON THE DRAWINGS. ALL NEW MATERIALS SHALL BE LISTED AND LABELED BY UL OR OTHER ACCEPTABLE LISTING AGENCY, WHERE A LISTING EXISTS.
- THE CONTRACTOR SHALL VISIT THE SITE(S) PRIOR TO BIDDING TO FAMILIARIZE THEMSELVES WITH PROJECT REQUIREMENTS AND EXISTING CONDITIONS.
- FIRESTOP ALL NEW CONDUIT INSTALLED THROUGH EXISTING OR NEW FIRE RATED ASSEMBLIES.
- SHOP DRAWINGS SHALL BE SUBMITTED ON ALL ELECTRICAL MATERIALS AND EQUIPMENT FOR ACCEPTANCE PRIOR TO PURCHASE BY THE CONTRACTOR.
- WHEN AN ITEM DEMOLISHED IS REMOVED, REMOVE ALL CONCRETE PADS, FASTENERS, CONDUIT AND WIRING. SCARIFY SURFACE AND RESTORE TO MATCH EXISTING SURROUNDING SURFACE, INCLUDING PAINTING TO MATCH.
- ALL NEW WIRING SHALL BE ENCLOSED IN AN APPROVED RACEWAY SYSTEM. OPEN WIRING IS PROHIBITED.
- CIRCUIT BREAKERS USED FOR HVAC EQUIPMENT LOADS SHALL BE HACR TYPE.
- ENSURE DEDICATED ELECTRICAL SPACE IS PROVIDED AT ELECTRICAL EQUIPMENT IN ACCORDANCE WITH NEC ARTICLE 110.26.
- UP TO 3 CIRCUITS MAY BE COMBINED IN ONE CONDUIT, AS LONG AS NEC DERATING RULES ARE FOLLOWED.
- ALL CIRCUITS SHALL HAVE A DEDICATED NEUTRAL. SHARED NEUTRALS AND MULTI-WIRE CIRCUITS ARE NOT TO BE USED EXCEPT POSSIBLY TO COORDINATE WITH SYSTEMS FURNITURE. SEE POWER PLAN.
- 120 VOLT CIRCUITS THAT EXCEED 75 LINEAR CIRCUIT FEET SHALL BE INCREASED TO #10 AWG AS A GENERAL RULE. OTHER CIRCUITS WILL BE DESIGNED SPECIFICALLY WITH VOLTAGE DROP CONSIDERED IN CONDUCTOR SIZING.
- COORDINATE ALL MOTOR STARTERS, FEEDERS AND DISCONNECT SWITCHES FOR HVAC AND OTHER UTILIZATION EQUIPMENT ACTUALLY PROVIDED IN ACCEPTED SHOP DRAWINGS.
- IN ORDER TO COMPLY WITH OSHA REQUIREMENTS, NO OPERATOR DEVICE OF ANY PANEL OR DISCONNECT OR MOTOR CONTROL SHALL BE HIGHER THAN 6'-6" AFF.
- PROVIDE AN EXTERIOR RATED SERVICE RECEPTACLE WITHIN 25 FEET HORIZONTALLY OF ANY EXTERIOR OR ROOFTOP HVAC OUTDOOR UNIT (HEATING OR AIR CONDITIONING ONLY).
- SUPPORT ALL LUMINAIRES FROM THE STRUCTURE, NOT FROM THE SUSPENDED CEILING GRID. ALSO ATTACH THE LUMINAIRES TO THE GRID SYSTEM USING EARTHQUAKE CLIPS (SIMILAR TO ERICO/CADDY FASTENERS OR T&B/STEEL CITY).
- DEVICE PLATES SHALL BE INSTALLED PLUMB. JUMBO OR OVERSIZED PLATES SHALL NOT BE USED.
- NEW RECEPTACLES SHALL BE INSTALLED WITH GROUND PIN ORIENTATION TO MATCH EXISTING. IN NEW CONSTRUCTION, GROUND PIN DOWN ABOVE COUNTERS OR WORK BENCHES AND UP FOR LOW WALL MOUNTED DEVICES.
- AT COMPLETION OF PROJECT, ALL ELECTRICAL, TELECOMMUNICATIONS, AND ELECTRONIC SAFETY SYSTEMS SHALL BE FULLY OPERATIONAL.
- INSTALL A NYLON PULLSTRING IN ALL SPARE CONDUITS, ACCESSORIES FOR HVAC AND OTHER UTILIZATION EQUIPMENT ACTUALLY PROVIDED IN ACCEPTED SHOP DRAWINGS.
- EGRESS LUMINAIRES AND EXIT SIGNS REQUIRE UNSWITCHED LIGHTING CONDUCTOR.
- WHERE DUPLEX RECEPTACLES ARE INDICATED GENERALLY BACK TO BACK ON OPPOSITE SIDES OF A PARTY WALL, THE RECEPTACLES SHALL NOT BE INSTALLED IN THE SAME STUD SPACE, BUT SHALL BE SEPARATED BY AT LEAST ONE STUD SPACE.
- PROVIDE LABEL WITH ESTIMATED FAULT CURRENT AND DATE CALCULATED ON THE MAIN SERVICE DISCONNECT ENCLOSURE. PROVIDE COORDINATION STUDY AND ARC FLASH STUDY, AND APPLY JOB SPECIFIC ARC FLASH HAZARD WARNING LABELS ON ALL SWITCHBOARDS, SWITCHGEAR, MCC'S AND PANELBOARDS.
- CIRCUIT BREAKERS, 1200 AMPERE OR LARGER, SHALL COMPLY WITH NEC ARTICLE 240.87, ARC ENERGY REDUCTION.

SINGLE LINE DIAGRAMS/CONTROLS

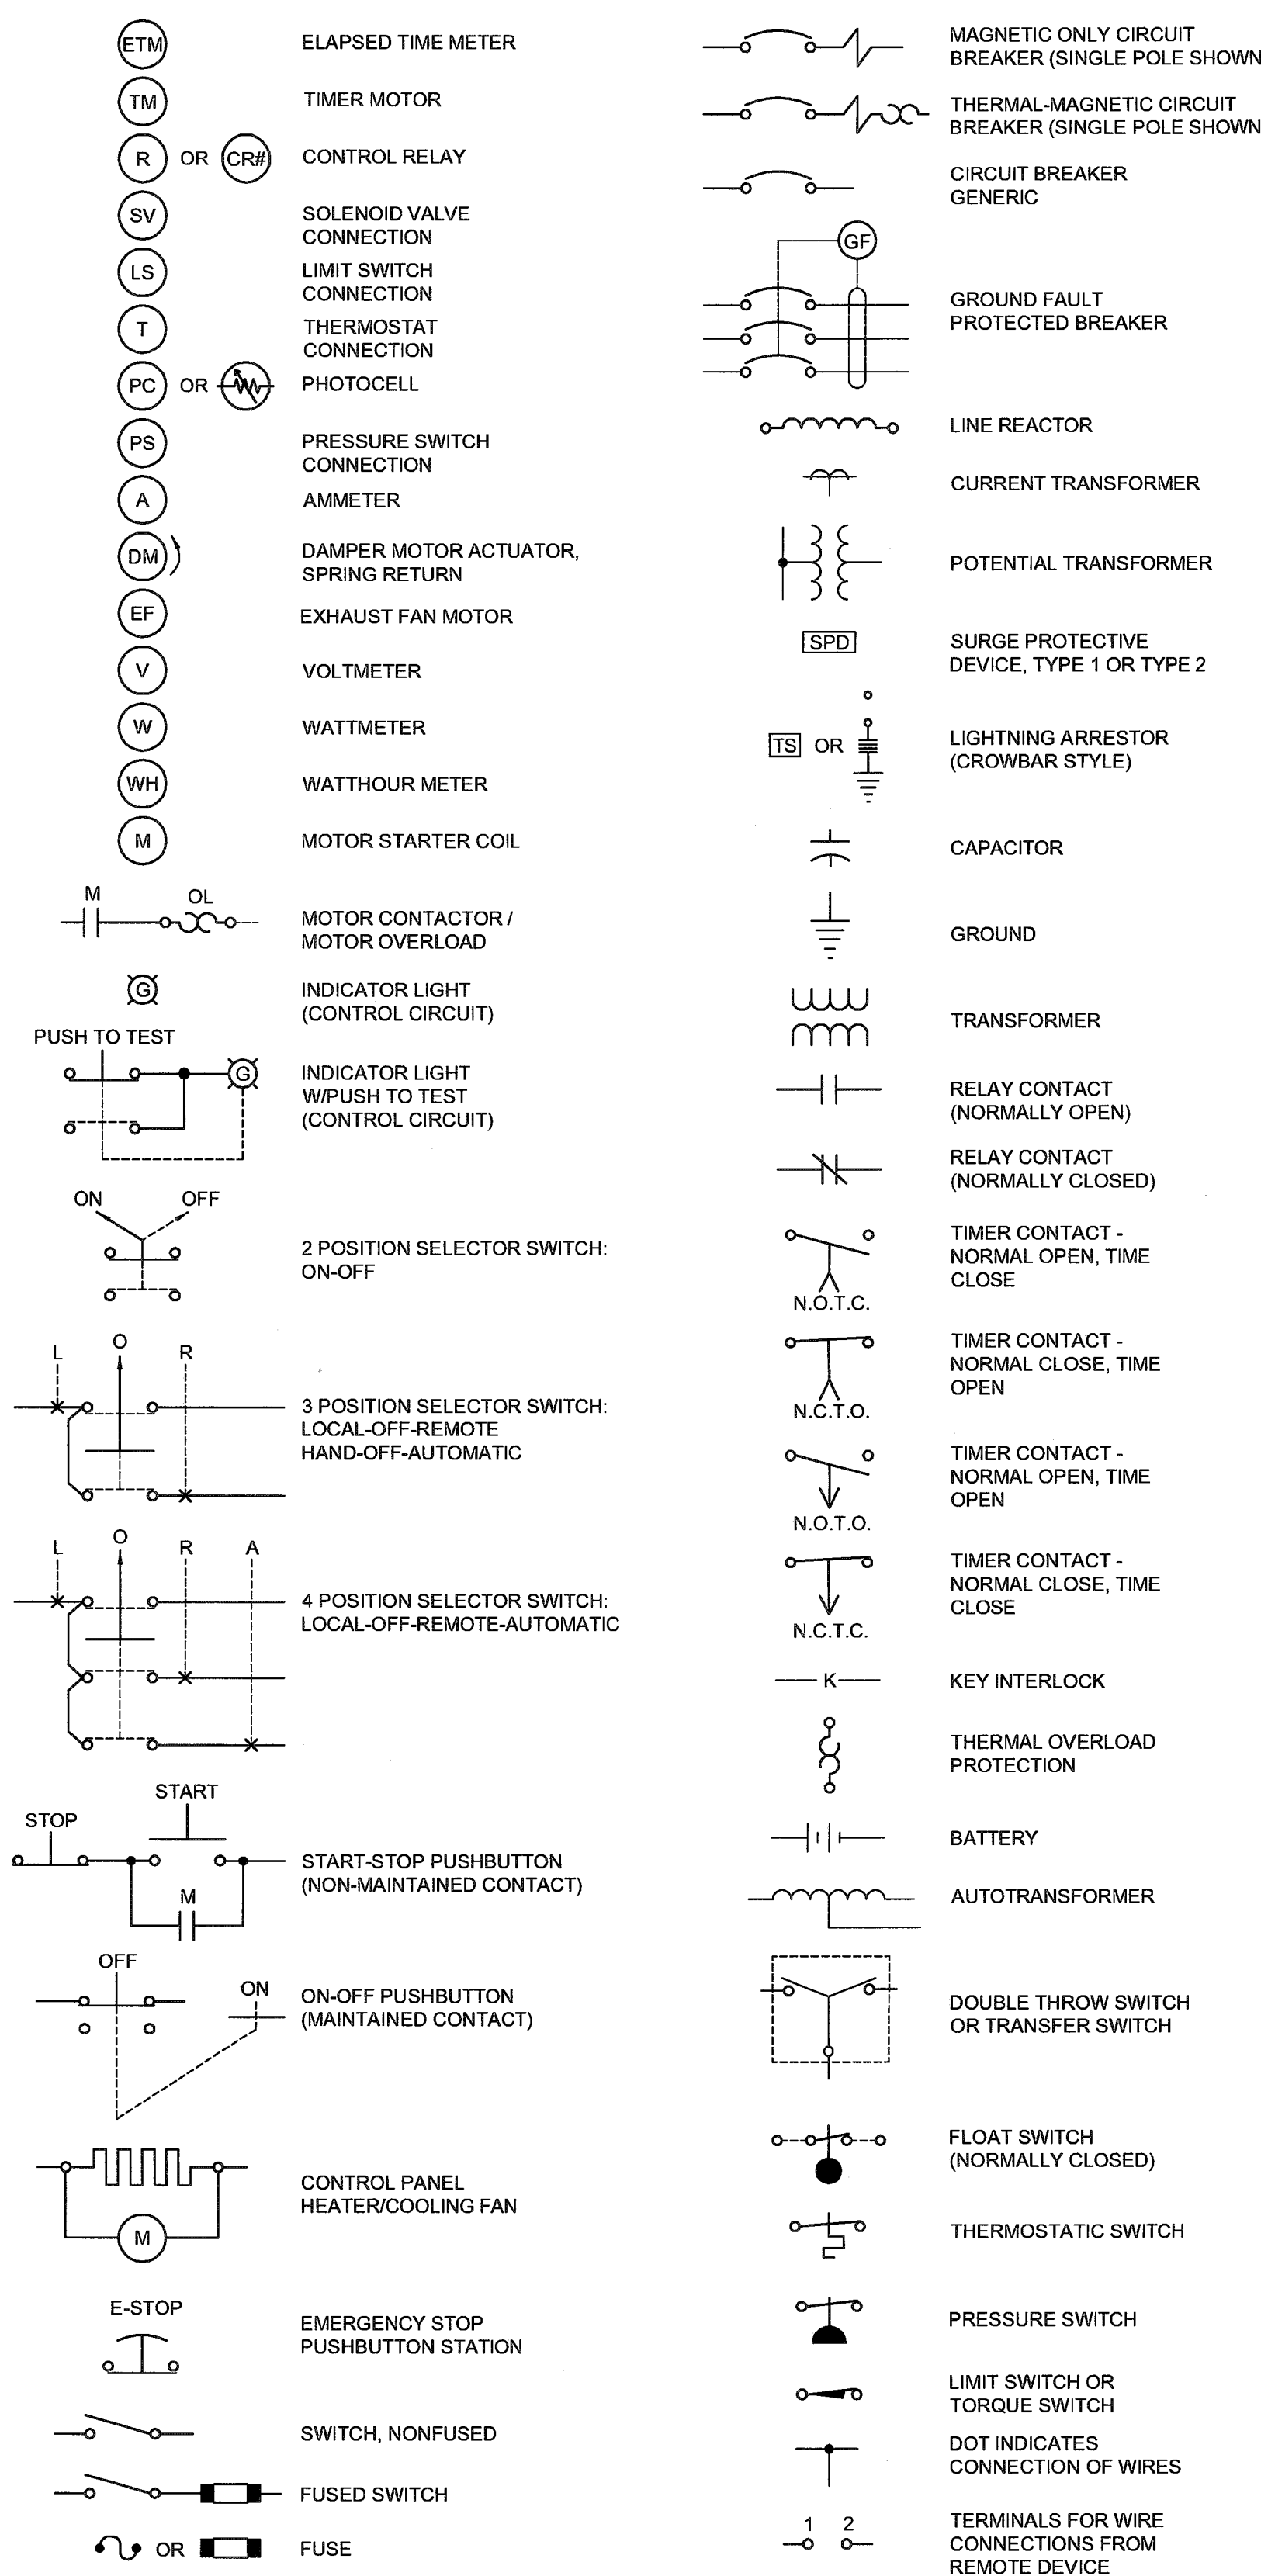

DESIGNED: WER
DRAWN: WER
REVIEWED: WER
APPROVED: WLM

DATE: _____

SCALE: NOT TO SCALE

SHEET NO: E-001

REVISIONS

NO.	DATE	DESCRIPTION

SCALE CHECK: _____ THIS MARK SHOULD MEASURE EXACTLY T WHEN PLOTTED

STANDARD ELECTRICAL SYMBOLS

BABY FARMS LIFT STATION AND FORCE MAIN IMPROVEMENTS
FALL CREEK REGIONAL WASTE DISTRICT

engineering | architecture | geospatial
www.gwrinc.com

GRW PROJECT NO. 4625


CLIENT PROJECT NO.

ALL RIGHTS RESERVED
THIS DOCUMENT IS THE PROPERTY OF
GWR INC. AND IS NOT TO BE REPRODUCED
OR USED FOR CONSTRUCTION OR PROJECT
WITHOUT WRITTEN PERMISSION



Indiana Underground Plant Protection Service

CALL TWO WORKING DAYS
BEFORE YOU DIG
IT'S THE LAW
811

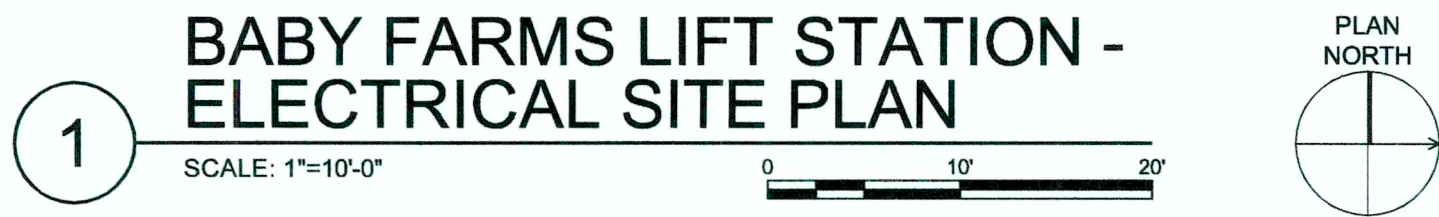

Location of installed control panel



2

EXISTING ELECTRICAL EQUIPMENT RACK - DEMOLITION


NOT TO SCALE

GENERAL NOTES:

1. LOCATE ALL EXISTING UNDERGROUND UTILITIES AND COORDINATE WITH GENERAL CONTRACTOR FOR ALL UNDERGROUND WORK PRIOR TO ANY EXCAVATION OR TRENCHING. MAINTAIN A MINIMUM 12" BETWEEN UTILITIES, UNLESS OTHERWISE NOTED.
2. MINIMUM BURY FOR ALL SITE CONDUITS SHALL BE 24", UNLESS OTHERWISE NOTED.
3. ALL EXPOSED CONDUITS SHALL BE ALUMINUM OR PVC COATED RIGID STEEL - NO EXCEPTIONS.
4. THE OWNER HAS THE OPTION TO KEEP ANY DEMOLISHED ELECTRICAL EQUIPMENT.

SHEET KEYNOTES:

1. CONTRACTOR SHALL DISCONNECT AND REMOVE EXISTING ELECTRICAL EQUIPMENT RACK (WOODEN STRUCTURE). THIS INCLUDES THE ENTIRE STRUCTURE, EXCLUDING THE EXISTING UTILITY RISER POLE - UTILITY RISER POLE SHALL REMAIN UNDISTURBED.
2. CONTRACTOR SHALL DISCONNECT AND REMOVE EXISTING METER/METER BASE. METER/METER BASE SHALL BE RELOCATED AND RE-INSTALLED AT THE RISER POLE AS INDICATED IN KEYNOTE 19. COORDINATE REMOVAL AND RELOCATION WITH ANDERSON MUNICIPAL LIGHT & POWER.
3. CONTRACTOR SHALL DISCONNECT AND REMOVE EXISTING SERVICE CONDUIT/WEATHERHEAD/CONDUCTORS ROUTED UP THE RISER POLE, FROM METER BASE.
4. CONTRACTOR SHALL DISCONNECT AND REMOVE EXISTING DOUBLE THROW TRANSFER SWITCH.
5. CONTRACTOR SHALL DISCONNECT AND REMOVE EXISTING CONDUCTORS/CONDUIT FROM METER BASE TO DOUBLE THROW TRANSFER SWITCH.
6. CONTRACTOR SHALL DISCONNECT AND REMOVE EXISTING DISCONNECT SWITCH.
7. CONTRACTOR SHALL DISCONNECT AND REMOVE EXISTING CONDUCTORS/CONDUIT FROM DOUBLE THROW TRANSFER SWITCH TO PAD-MOUNTED STATIONARY GENERATOR.
8. CONTRACTOR SHALL DISCONNECT AND REMOVE EXISTING NIPPLE/CONDUCTORS ENTERING/LEAVING DISCONNECT SWITCH.
9. CONTRACTOR SHALL DISCONNECT AND REMOVE EXISTING PUMP CONTROL PANEL.
10. CONTRACTOR SHALL CAREFULLY REMOVE EXISTING SIGNAGE. EXISTING SIGNAGE SHALL BE RE-INSTALLED AT NEW ELECTRICAL EQUIPMENT RACK/PUMP CONTROL PANEL.
11. CONTRACTOR SHALL DISCONNECT AND REMOVE EXISTING GROUNDING ELECTRODE CONDUCTOR AND CONDUIT.
12. CONTRACTOR SHALL DISCONNECT AND REMOVE EXISTING PUMP POWER CABLES & CONTROL CABLES/CONDUIT FROM THE PUMP CONTROL PANEL TO THE LIFT STATION WETWELL.
13. CONTRACTOR SHALL DISCONNECT AND REMOVE EXISTING FLOAT CABLES/CONDUIT FROM THE PUMP CONTROL PANEL TO THE LIFT STATION WETWELL.
14. CONTRACTOR SHALL CAREFULLY DISCONNECT AND REMOVE EXISTING OMNI-SITE ENCLOSURE. EXISTING OMNI-SITE ENCLOSURE SHALL BE RE-INSTALLED AT THE NEW ELECTRICAL EQUIPMENT RACK.
15. CONTRACTOR SHALL DISCONNECT AND REMOVE EXISTING CONDUCTORS (POWER)/CONDUIT FROM THE PUMP CONTROL PANEL TO THE OMNI-SITE ENCLOSURE.
16. CONTRACTOR SHALL DISCONNECT AND REMOVE EXISTING MULTI-CONDUCTOR (MONITORING SIGNALS)/CONDUIT FROM THE PUMP CONTROL PANEL TO THE OMNI-SITE ENCLOSURE.
17. EXISTING UTILITY RISER POLE SHALL REMAIN.
18. EXISTING STATIONARY GENERATOR SHALL REMAIN (CATERPILLAR D30P1, 208/120V, 3-PHASE OUTPUT, 125A MCB, 30KW - GENERATOR OUTPUT IS CURRENTLY SET AT 215V).
19. CONTRACTOR SHALL RE-INSTALL EXISTING METER BASE/METER AT EXISTING RISER POLE. COORDINATE INSTALLATION WITH ANDERSON MUNICIPAL LIGHT & POWER.
20. CONTRACTOR SHALL FURNISH AND INSTALL NEW ELECTRICAL EQUIPMENT RACK. SEE DRAWING E-501, DETAIL 3, FOR REQUIREMENTS.
21. NEW CONCRETE EQUIPMENT PAD FOR ELECTRICAL EQUIPMENT RACK. SEE DRAWING E-501, DETAIL 7, FOR REQUIREMENTS.
22. NEW SERVICE ENTRANCE CONDUIT/WEATHERHEAD/CONDUCTORS FROM METER BASE. SEE DRAWING E-701 FOR REQUIRED CONDUIT/CONDUCTORS.
23. NEW ELECTRICAL FEEDER FROM METER BASE TO RACK-MOUNTED DOUBLE THROW DISCONNECT SWITCH.
24. SEE DRAWING E-701 FOR REQUIRED FEEDERS/BRANCH CIRCUITS BETWEEN EQUIPMENT LOCATED AT ELECTRICAL EQUIPMENT RACK.
25. NEW ELECTRICAL FEEDER FROM RACK-MOUNTED DOUBLE THROW DISCONNECT SWITCH TO EXISTING GENERATOR.
26. NEMA 4X, 100A, FUSED, DOUBLE THROW TRANSFER SWITCH. SEE DRAWING E-701 FOR REQUIRED FUSING.
27. NEMA 4X LIFT STATION CONTROL PANEL.
28. EXISTING OMNI-SITE XR-50 ENCLOSURE, RELOCATED FROM EXISTING WOODEN RACK, TO NEW ELECTRICAL EQUIPMENT RACK.
29. PUMP BRANCH CIRCUIT FROM LIFT STATION CONTROL PANEL - SEE DRAWING E-701 FOR REQUIRED CONDUIT/CONDUCTORS.
30. #12, 1#12 GND, 1" FROM WETWELL JUNCTION BOX TO LIFT STATION CONTROL PANEL (FLOAT CABLES).
31. EXISTING UTILITY TRANSFORMER POLE (2 POLE TOP TRANSFORMERS - OPEN DELTA CONFIGURATION) SHALL REMAIN.
32. EXISTING OVERHEAD SECONDARY ELECTRICAL SERVICE SHALL REMAIN.
33. NEW 3/4" x 10'-0" DRIVEN GROUND ROD - TYPICAL OF 3.
34. NEW BARE #6 COPPER GROUNDING ELECTRODE CONDUCTOR - BURIED A MINIMUM OF 30" BELOW FINISHED GRADE.

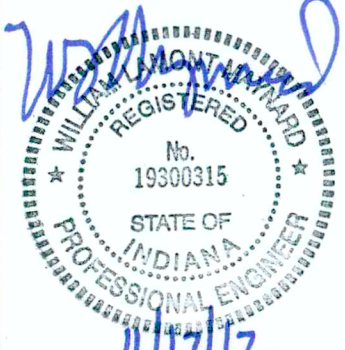

GRW PROJECT NO. 4625

CLIENT PROJECT NO.

ALL RIGHTS RESERVED. NO PART OF THIS DOCUMENT SHALL BE REPRODUCED IN WHOLE OR IN PART WITHOUT WRITTEN PERMISSION.



BABY FARMS LIFT STATION - ELECTRICAL SITE PLAN

BABY FARMS LIFT STATION AND FORCE MAIN IMPROVEMENTS

FALL CREEK REGIONAL WASTE DISTRICT

DESIGNED	WER
DRAWN	WER
REVIEWED	WER
APPROVED	WLM

NO.	DATE	DESCRIPTION	BY



DATE:

SCALE:

NONE

SHEET NO.

E-101

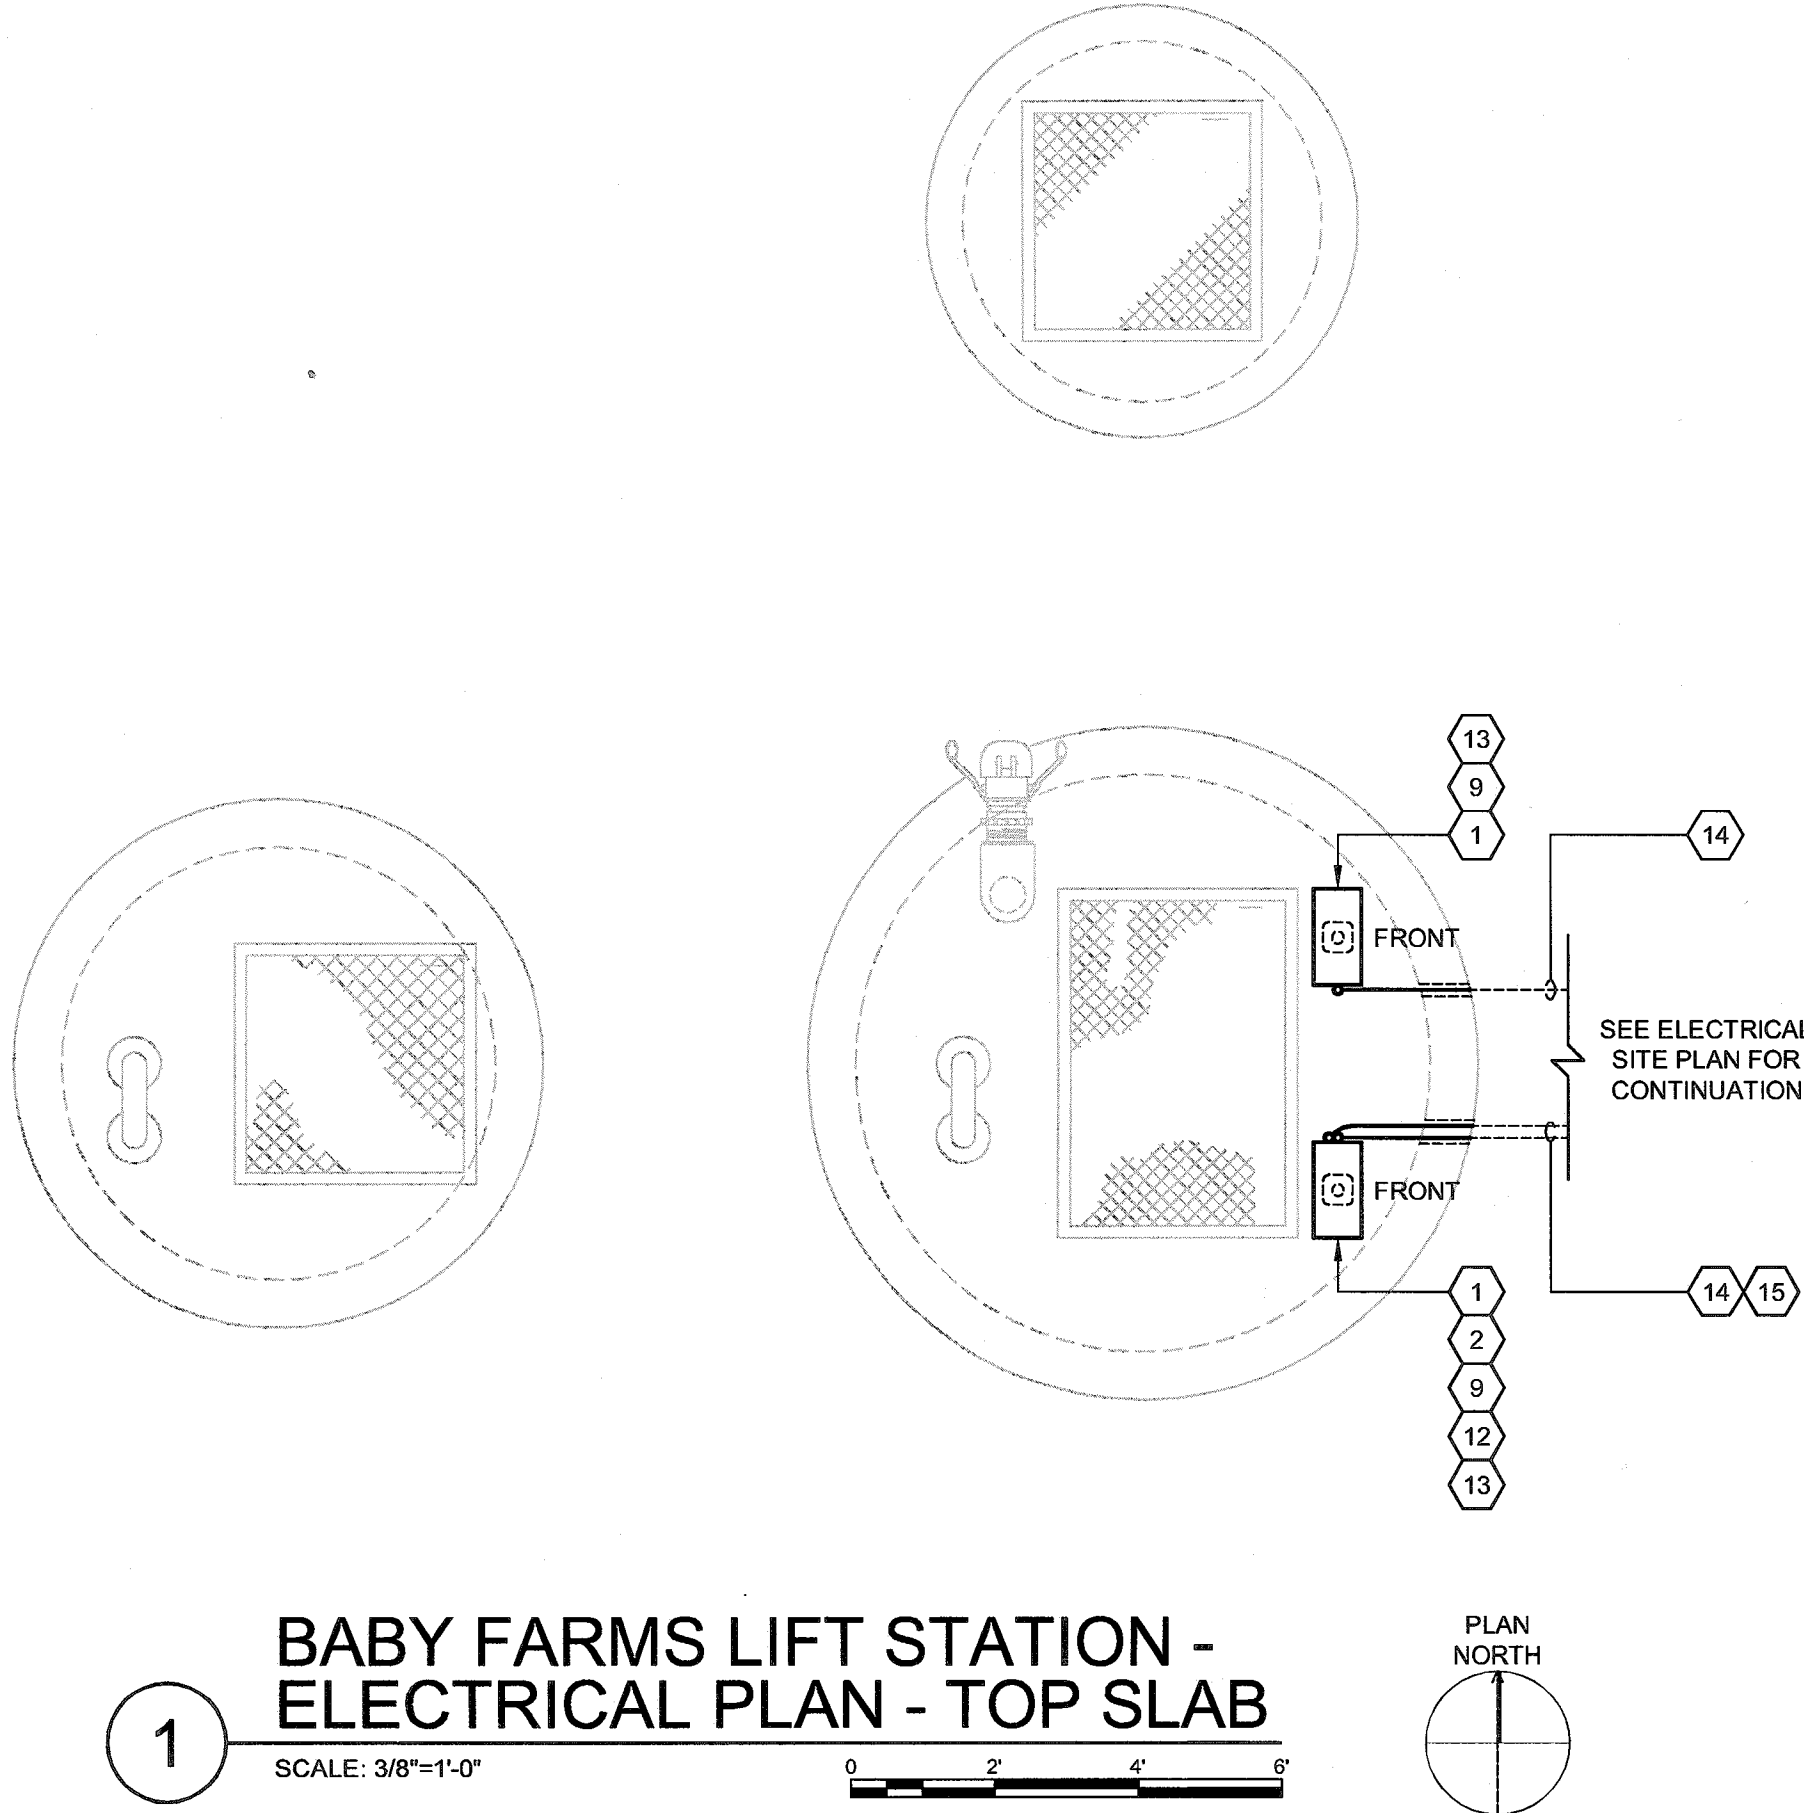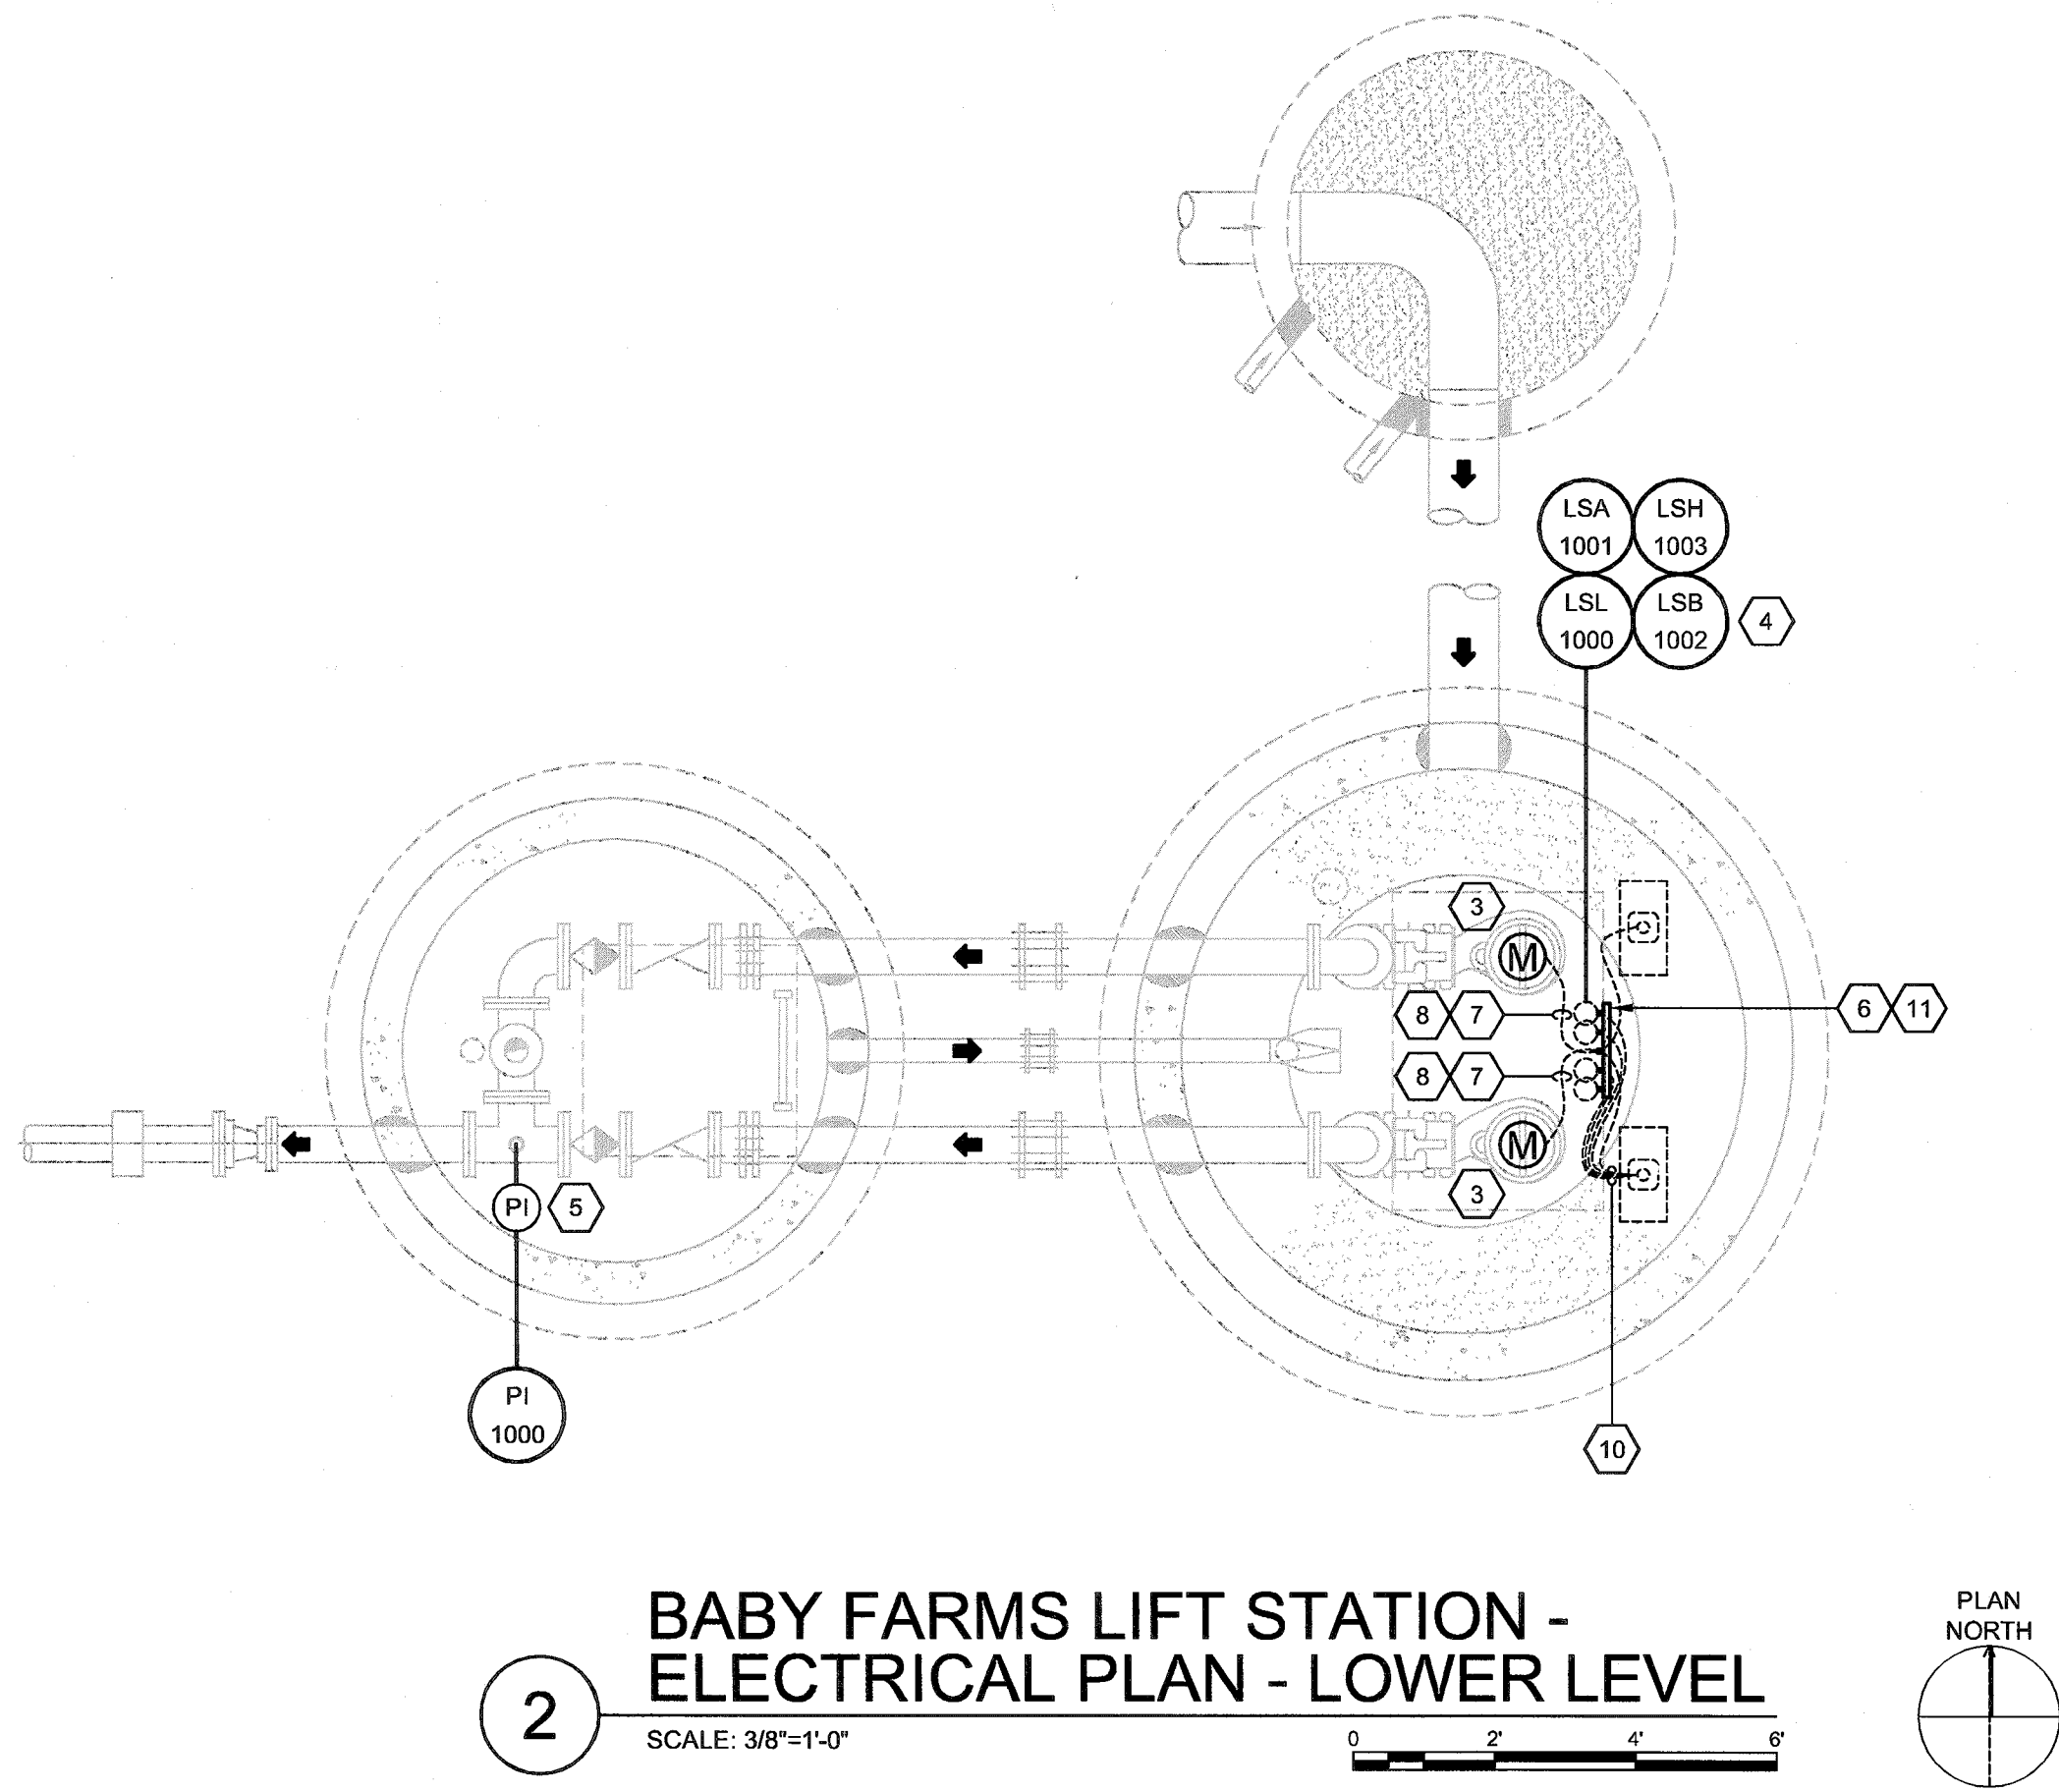

GENERAL NOTES:

- THE PUMP STATION WETWELL IS CLASSIFIED AS CLASS I, DIVISION 1, GROUP D AREA PER NFPA 820. THE CLASS I, DIVISION 1 AREA EXTENDS TO 18" ABOVE THE PUMP STATION TOP SLAB AND EXTENDS 3' BEYOND ALL SIDES. ANY EQUIPMENT LOCATED WITHIN THE CLASSIFIED AREA SHALL BE UL LISTED FOR THAT AREA. ALL WIRING METHODS SHALL CONFORM TO THE REQUIREMENTS OF NEC ARTICLE 500 AND 501.
- THE PUMP STATION VALVE VAULT IS CLASSIFIED AS CLASS I, DIVISION 2, GROUP C AND D AREAS PER NFPA 820. THE CLASS I, DIVISION 2 AREA EXTENDS TO 18" ABOVE THE TOP SLAB AND EXTENDS 3' BEYOND ALL SIDES. ANY EQUIPMENT LOCATED WITHIN THE CLASSIFIED AREA SHALL BE UL LISTED FOR THAT AREA. ALL WIRING METHODS SHALL CONFORM TO THE REQUIREMENTS OF NEC ARTICLE 500 AND 501.
- ALL CONDUITS ENTERING HAZARDOUS LOCATIONS, AS NOTED IN PRECEDING NOTES, SHALL HAVE SEAL FITTINGS BEFORE ENTRANCE INTO AREA. CONDUITS LEAVING HAZARDOUS LOCATIONS SHALL HAVE SEAL FITTINGS AFTER LEAVING THE HAZARDOUS AREA.
- ALL EXPOSED CONDUITS SHALL BE ALUMINUM ONLY (NO EXCEPTIONS).
- ALL CONDUITS SHOWN AT THE WETWELL ARE ROUTED WITHIN THE SLAB. DO NOT ROUTE ANY EXPOSED CONDUITS WITHIN THE WETWELL AREA OR ON TOP OF THE WETWELL SLAB.
- CONTRACTOR SHALL MAINTAIN A MINIMUM OF 4" SEPARATION BETWEEN ALL CONDUITS LARGER THAN 1" WHICH ARE ROUTED WITHIN THE TOP SLAB. SEPARATION SHALL BE MEASURED BETWEEN OUTER EDGE OF CONDUITS, NOT CENTERLINE.

SHEET KEYNOTES:

- NEMA 4X WETWELL JUNCTION BOX FOR CONVERSION OF PUMP POWER AND CONTROL CABLE TO SINGLE CONDUCTORS - TYPICAL OF 2. SEE DRAWING E-501, DETAIL 1, FOR REQUIREMENTS.
- NEMA 4X WETWELL JUNCTION BOX FOR CONVERSION OF FLOAT CABLES TO SINGLE CONDUCTORS - THIS BOX IS COMMON TO THE WETWELL JUNCTION BOX NOTED IN KEYNOTE 1.
- SUBMERSIBLE PUMP/MOTOR.
- FLOATS - TYPICAL OF 4. CABLES SHALL BE ROUTED THROUGH WETWELL SLAB TO WETWELL JUNCTION BOX VIA SEALING CONNECTORS. COORDINATE FLOAT ELEVATIONS WITH SANITARY DRAWINGS AND SPECIFICATIONS.
- NEW PRESSURE GAUGE. SEE SPECIFICATIONS FOR GAUGE REQUIREMENTS AND RANGES.
- LEVEL SENSOR HOLDER. SEE DRAWING I-501 FOR DETAILS.
- SUBMERSIBLE PUMP POWER/CONTROL CABLE FROM PUMP MOTOR TO WETWELL JUNCTION BOX.
- CONTRACTOR SHALL FURNISH AND INSTALL STAINLESS STEEL STRAIN RELIEF CABLE GRIP AT EACH END OF PUMP CABLES.
- CONTRACTOR SHALL FURNISH AND INSTALL SEALING CONNECTORS (CLASS I, DIVISION 2) FOR PUMP POWER/CONTROL CABLES.
- SUBMERSIBLE FLOAT CABLES TO WETWELL JUNCTION BOX.
- CONTRACTOR SHALL FURNISH AND INSTALL STAINLESS STEEL STRAIN RELIEF CABLE GRIPS FOR EACH FLOAT CABLE.
- CONTRACTOR SHALL FURNISH AND INSTALL SEALING CONNECTORS (CLASS I, DIVISION 2) FOR EACH FLOAT CABLE.
- CONTRACTOR SHALL CORE THROUGH SLAB TO ALLOW ROUTING OF PUMP POWER AND CONTROL CABLE (OR FLOAT CABLES).
- PUMP BRANCH CIRCUIT FROM LIFT STATION CONTROL PANEL - SEE DRAWING E-701 FOR REQUIRED CONDUIT/CONDUCTORS.
- 8#12, 1#12 GND, 1" C FROM WETWELL JUNCTION BOX TO LIFT STATION CONTROL PANEL (FLOAT CABLES).

GRW PROJECT NO. 4625

CLIENT PROJECT NO.

ALL WORKS SHOWN ON THIS DOCUMENT ARE THE PROPERTY OF GEOSPATIAL INC. AND SHALL BE REPRODUCED IN WHOLE OR IN PART OR USED FOR CONSTRUCTION OF ANY PROJECT WITHOUT WRITTEN PERMISSION.

engineering | architecture | geospacial
 www.grvinc.com

BABY FARMS LIFT STATION - ELECTRICAL PLAN

BABY FARMS LIFT STATION AND FORCE MAIN IMPROVEMENTS
 FALL CREEK REGIONAL WASTE DISTRICT



DESIGNED:	WER
DRAWN:	WER
REVIEWED:	WER
APPROVED:	WLM

NO.	DATE	BY	DESCRIPTION

DATE:

SCALE: NOT TO SCALE

SHEET NO. E-102

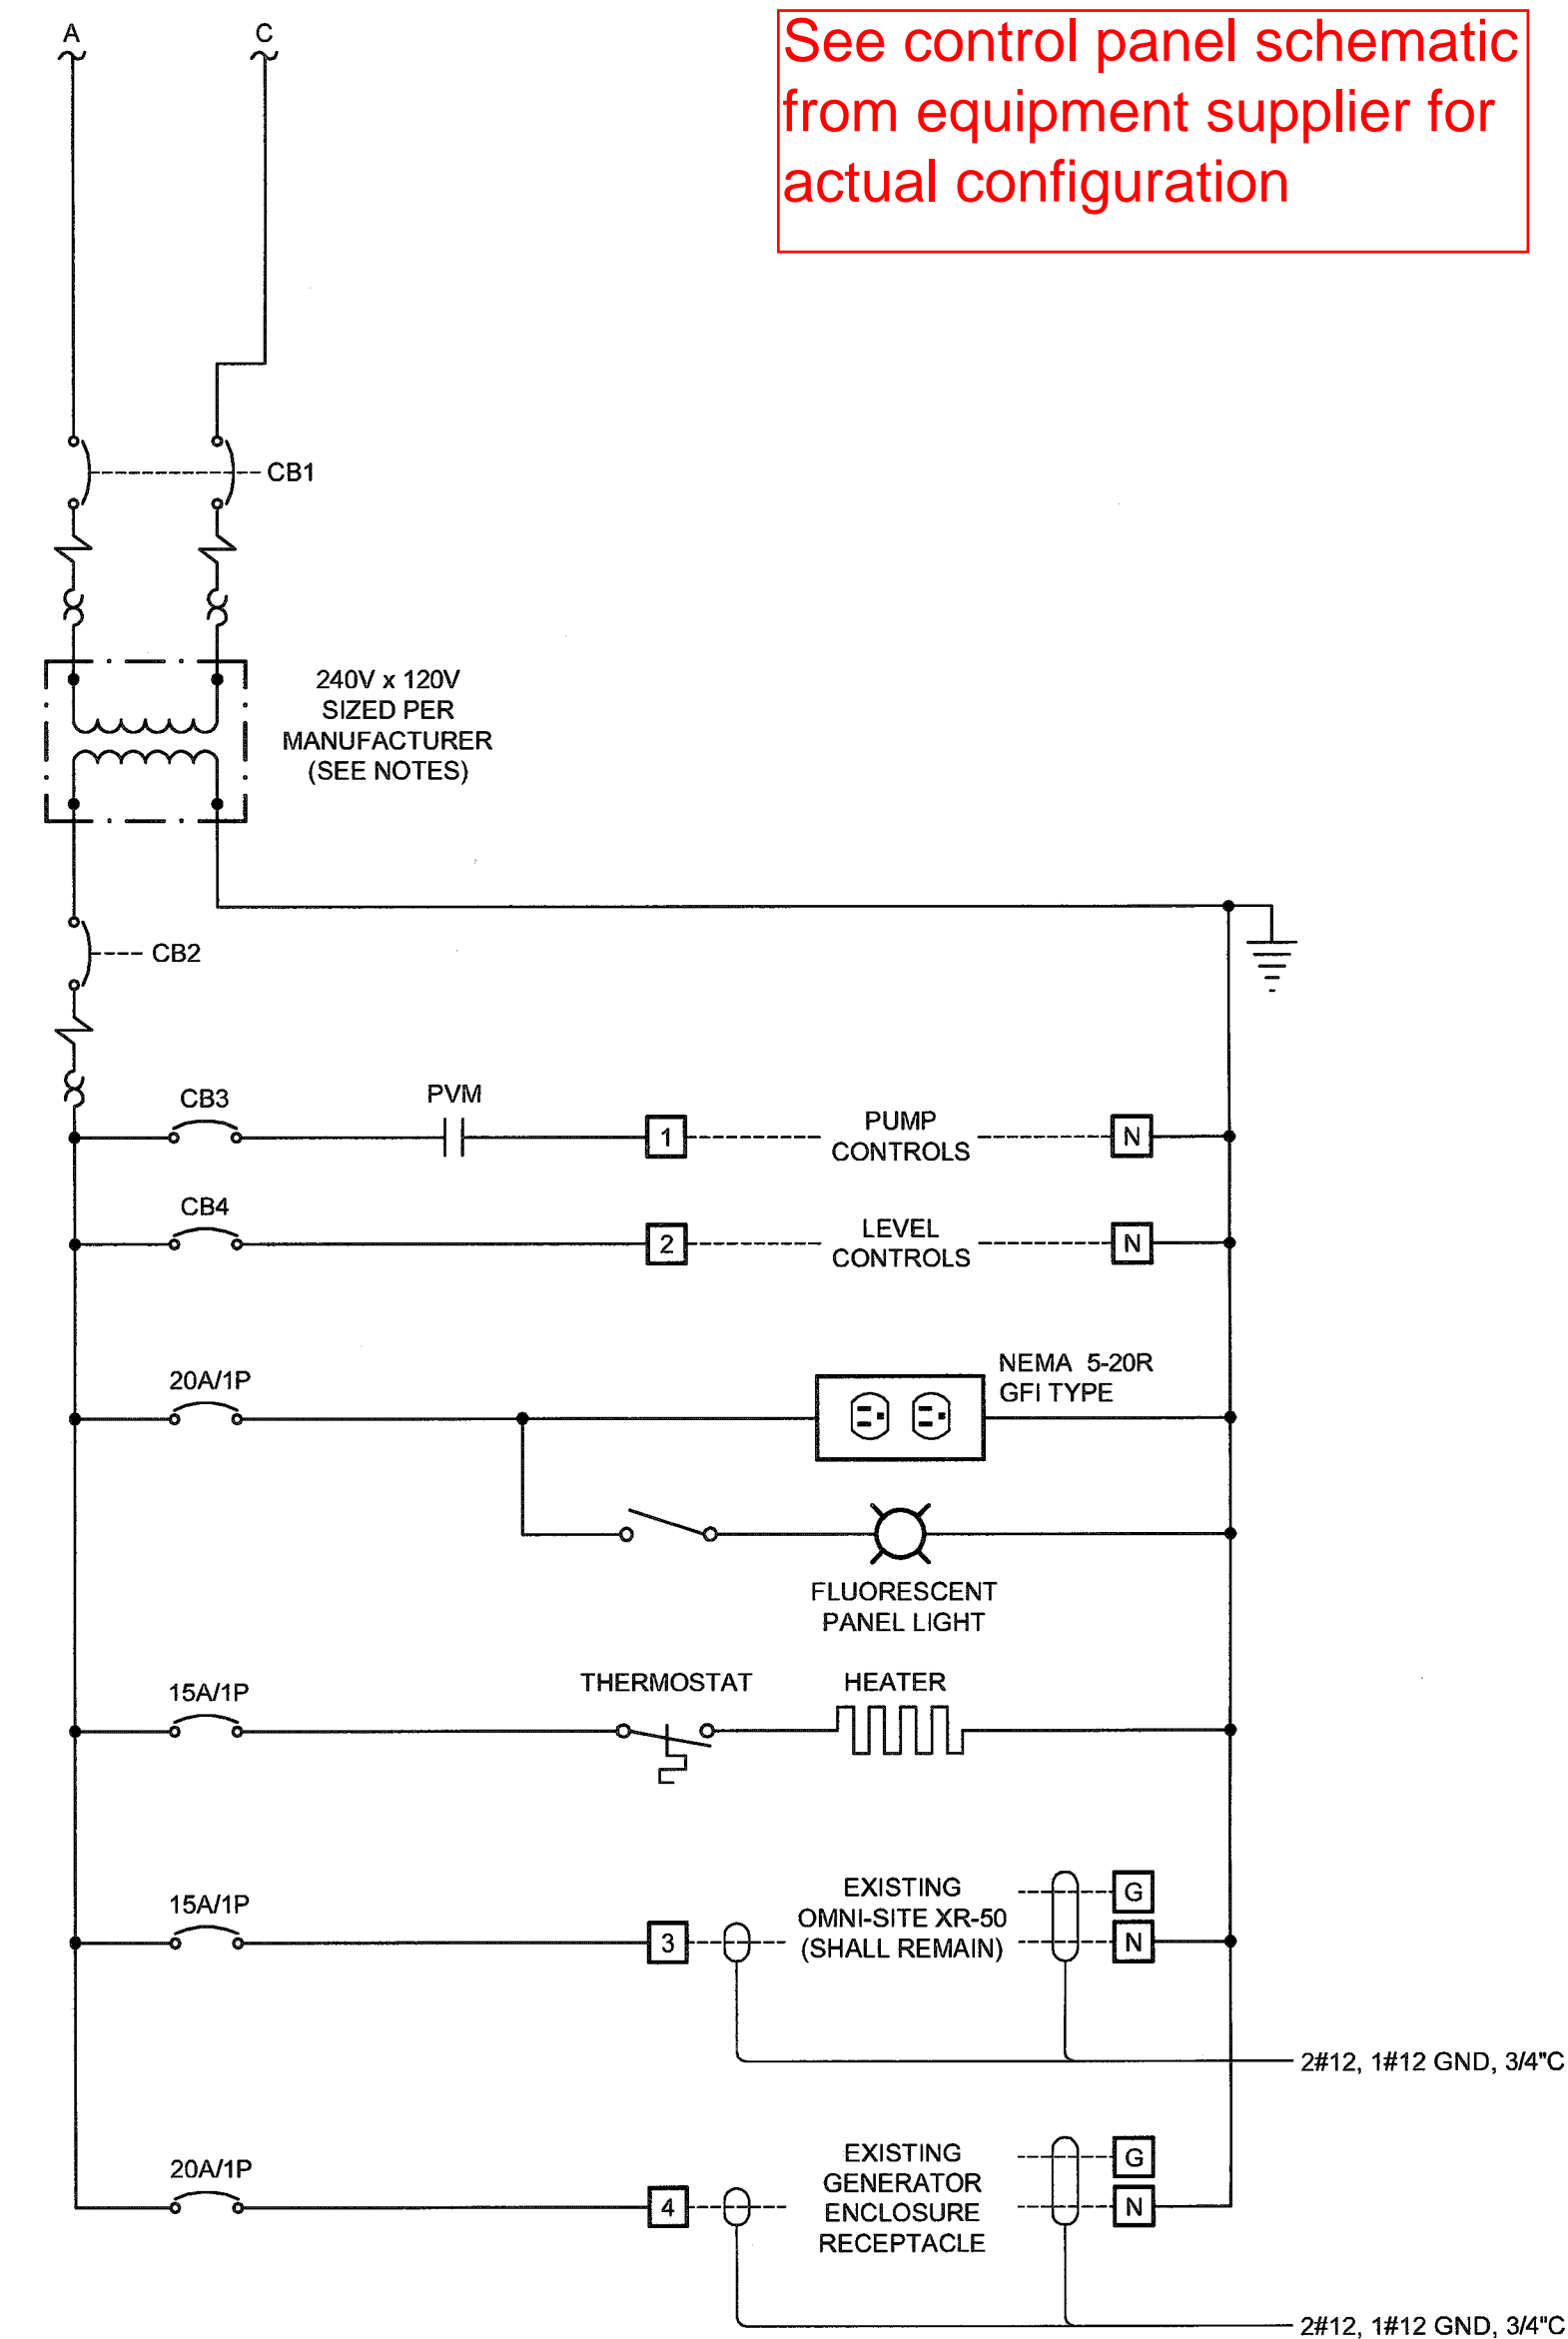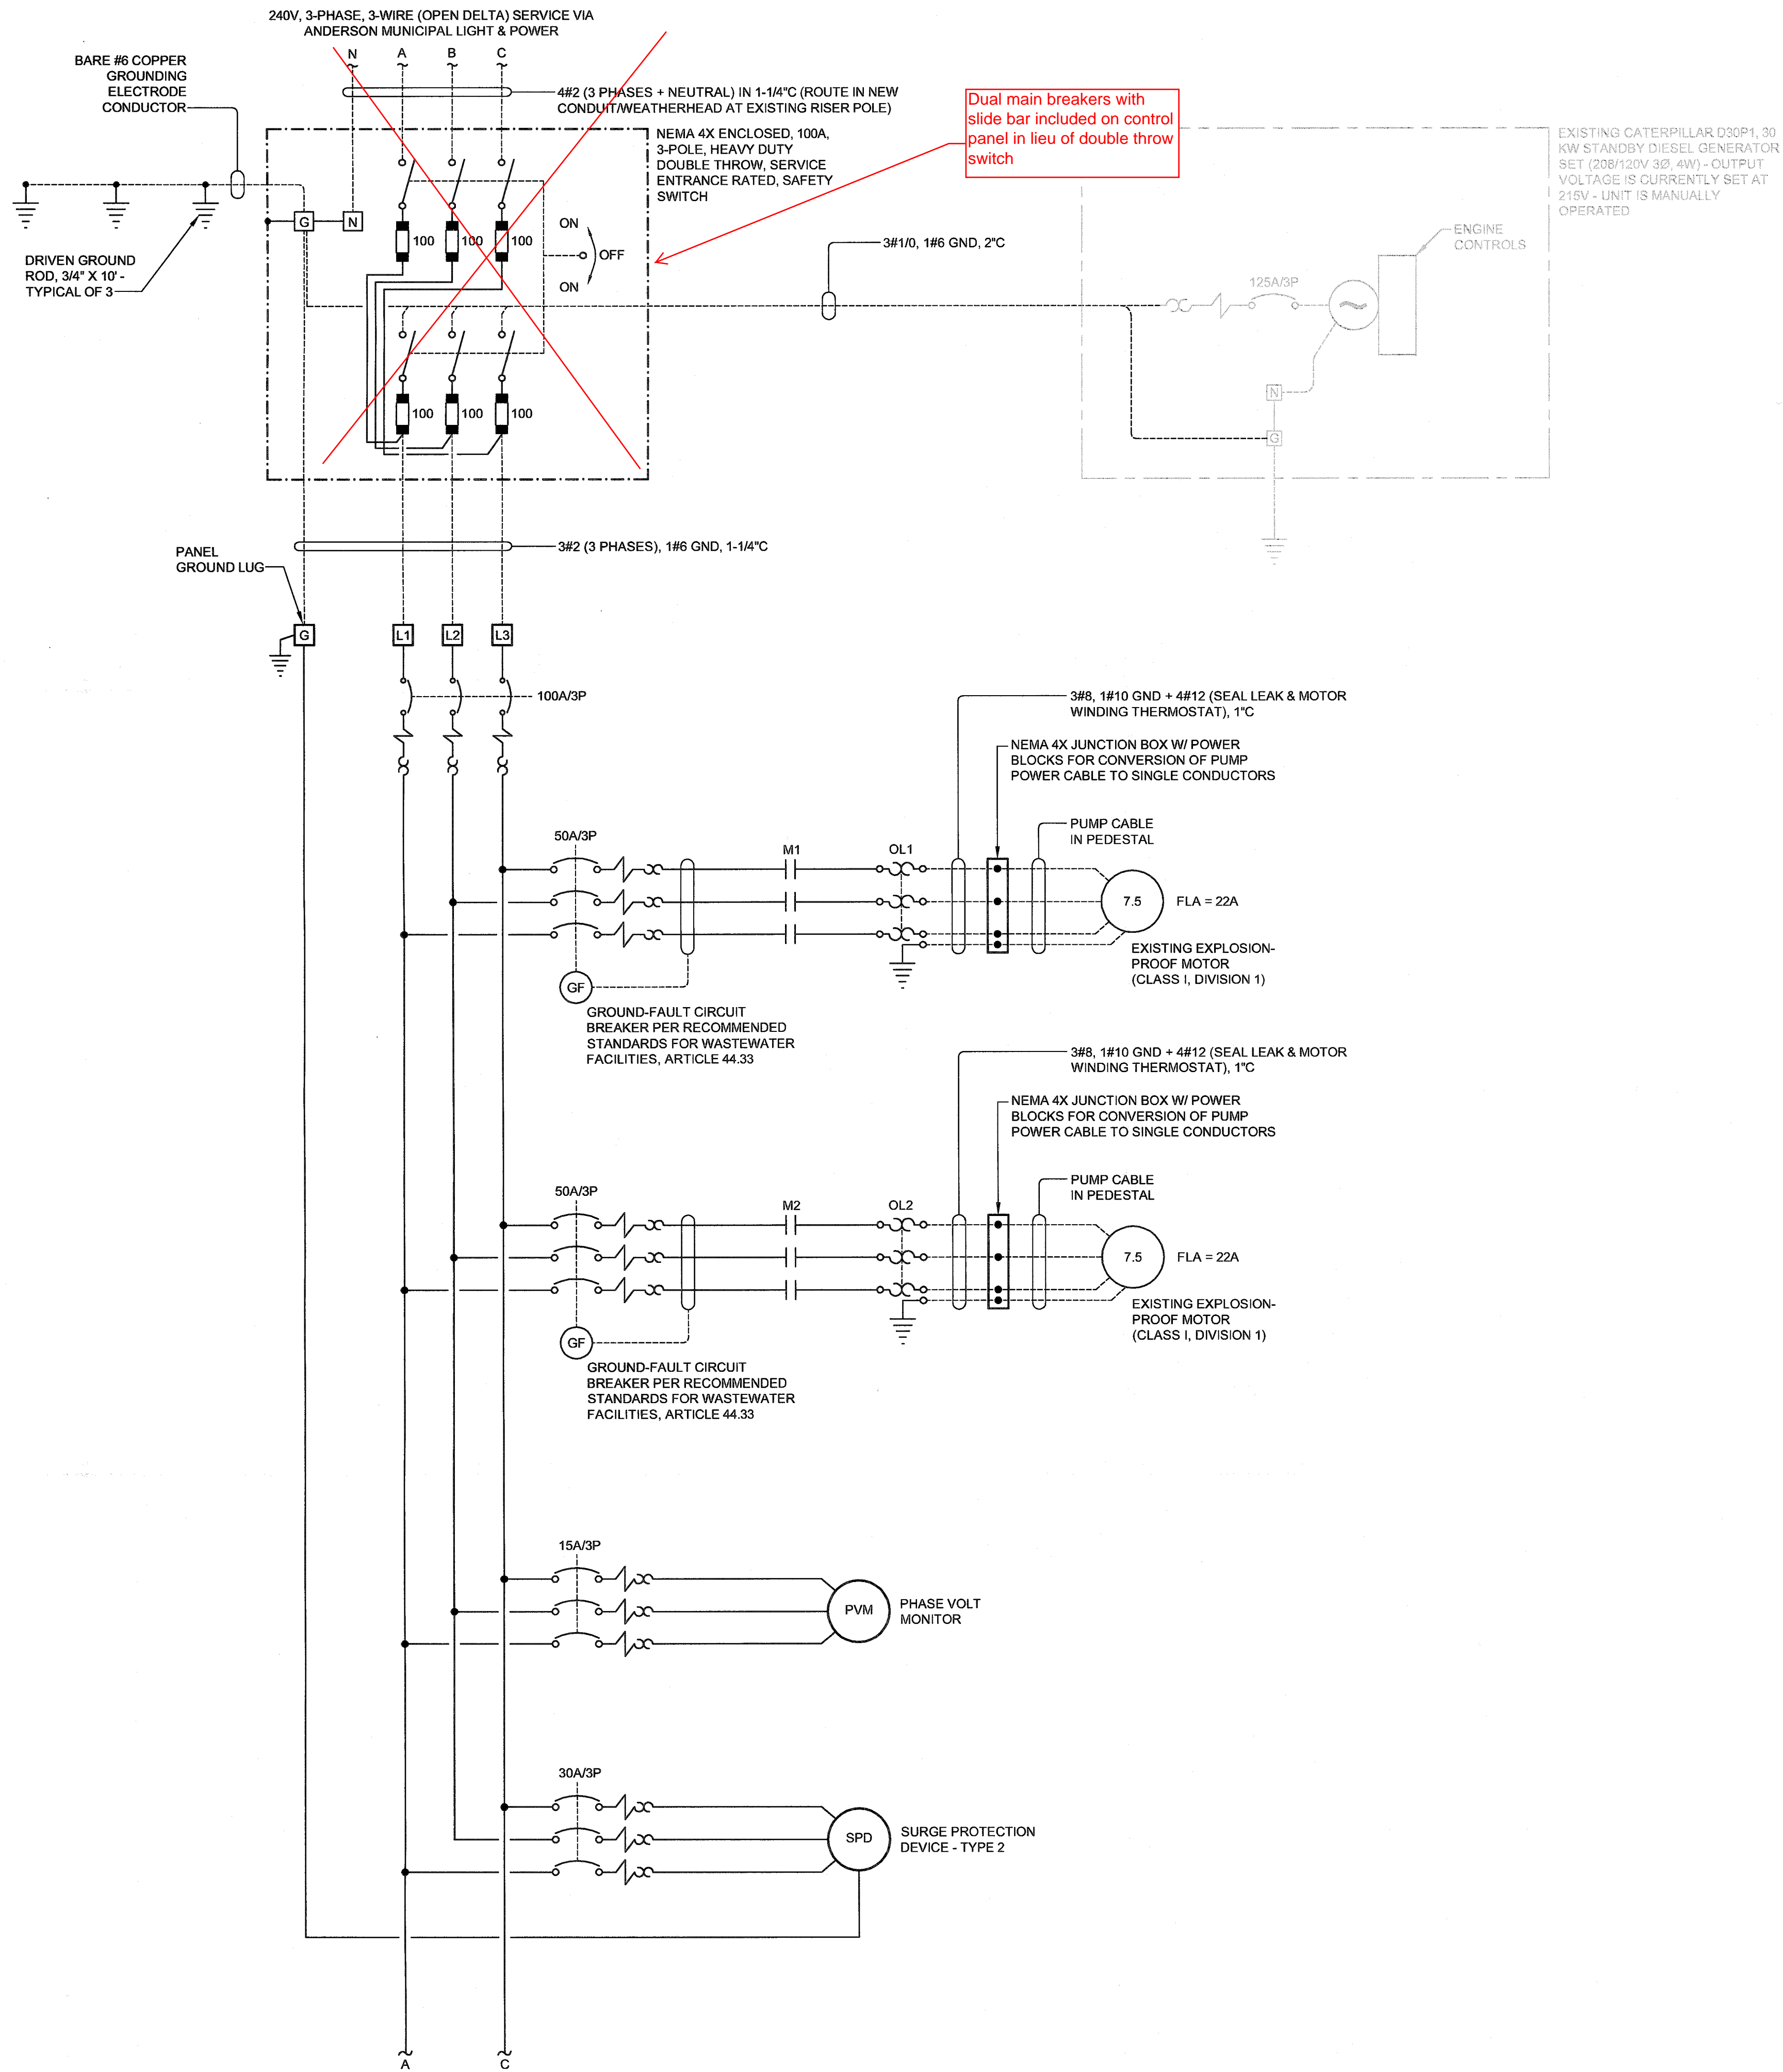


GENERAL NOTES:

- THE PUMP CONTROLS (FVNR MOTOR STARTER, OVERCURRENT DEVICES, SEAL LEAK/MOTOR WINDING RELAY, FEEDERS) ARE BASED ON HYDROMATIC PUMPS/MOTORS - 7.5 HP, 22A FULL LOAD.
- CONTROL PANEL MANUFACTURER SHALL PROVIDE CONDENSATE HEATER OF SUFFICIENT SIZE TO ACCOMMODATE PANEL.
- MANUFACTURER SHALL SIZE UPS, POWER SUPPLIES, PANEL LIGHTING, ETC. AS REQUIRED. UPS SHALL BE SIZED FOR MINIMUM 30 MIN. BACKUP.
- MANUFACTURER SHALL SIZE ALL POWER SUPPLIES AS REQUIRED.
- MANUFACTURER SHALL SIZE ALL OVERCURRENT DEVICES PER THEIR PANEL DESIGN, WHERE INDICATED.
- THE CONTROL PANEL MAIN BREAKER SHALL BE OF SUFFICIENT SIZE TO ALLOW BOTH PUMPS TO OPERATE SIMULTANEOUSLY.
- CONTROL PANEL MANUFACTURER SHALL PROVIDE 240V x 120V SINGLE PHASE TRANSFORMER INCLUDING PRIMARY AND SECONDARY OVERCURRENT PROTECTION (SIZE AS REQUIRED).
- PLEASE NOTE THE MOTOR STARTER OVERLOADS SHOULD BE SIZED ON A WORST CASE SCENARIO WHERE THE SUPPLY VOLTAGE IS VIA THE EXISTING GENERATOR. THE EXISTING GENERATOR OUTPUT VOLTAGE IS CURRENTLY SET AT 215 VOLTS.

1 CONTROL CIRCUIT - BABY FARMS LIFT STATION

NOT TO SCALE

- 1 REQUIRED (NEMA 4X STAINLESS STEEL ENCLOSED)

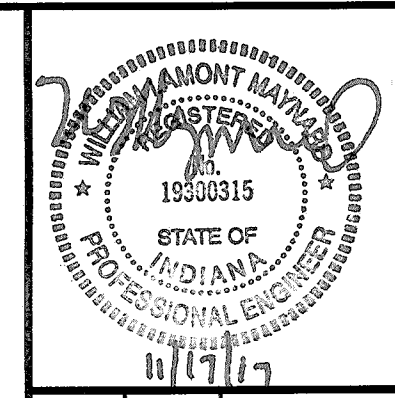

GRW PROJECT NO. 4625

CLIENT PROJECT NO.

ALL WORK IS SUBJECT TO THE PROPERTY OF THE STATE OF INDIANA. THIS DOCUMENT IS THE PROPERTY OF THE STATE OF INDIANA. IT IS TO BE USED FOR THE PROJECT ONLY AND NOT BE REPRODUCED IN ANY MANNER OR FOR ANY OTHER PROJECT WITHOUT WRITTEN PERMISSION.




engineering | architecture | geospatial

www.gvwinc.com

CIRCUIT CONTROLS I BABY FARMS LIFT STATION BABY FARMS LIFT STATION AND FORCE MAIN IMPROVEMENTS FALL CREEK REGIONAL WASTE DISTRICT

REVISIONS										DESIGNED: WER	
NO.	DESCRIPTION	DATE	BY							NAME	
										WER	
										REVIEWED:	
										WER	
										APPROVED:	
										WLM	
				THIS MARK SHEET IS MEASURED EXACTLY 7" WIDE BY 11" HIGH							

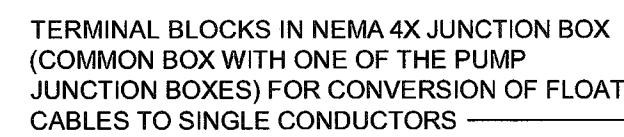


- 1 REQUIRED (NEMA 4X STAINLESS STEEL ENCLOSED)

INSTRUMENT SYMBOL IDENTIFICATION LETTERS TABLE

FIRST-LETTER		SUCCEEDING-LETTERS			
	MEASURED OR INITIATING VARIABLE	MODIFIER	READOUT OR PASSIVE FUNCTION	OUTPUT FUNCTION	MODIFIER
A	ANALYSIS		ALARM		
B	BURNER, COMBUSTION			CLOSE, STOP, DECREASE	
C	CONTROL			CONTROL	
D		DIFFERENTIAL		OPEN, START, INCREASE	
E	VOLTAGE		SENSOR (PRIMARY ELEMENT)		
F	FLOW RATE	RATIO (FRACTION)			FAIL
G			GLASS, VIEWING DEVICE		
H	HAND				HIGH OR OPEN
I	CURRENT (ELECTRICAL)		INDICATE		
J	POWER	SCAN			
K	TIME, TIME SCHEDULE	TIME RATE OF CHANGE		CONTROL STATION	
L	LEVEL		LIGHT		LOW OR CLOSE
M	MOTOR, MOTION	MOMENTARY		MOTOR	MIDDLE INTERMEDIATE
N					STATUS (ON-OFF)
O			ORIFICE, RESTRICTION		OVERLOAD
P	PRESSURE, VACUUM		POINT (TEST) CONNECTION	PUMP	
Q	QUANTITY	INTEGRATE, TOTALIZE			
R	RADIATION		RECORD		RELAY
S	SPEED, FREQUENCY	SAFETY		SWITCH	
T	TEMPERATURE			TRANSMIT	
U	MULTIVARIABLE		MULTIFUNCTION	MULTIFUNCTION	MULTIFUNCTION
V	VIBRATION, MECHANICAL ANALYSIS	VELOCITY		VALVE, DAMPER LOUVER	
W	WEIGHT, FORCE		WELL		
X		X AXIS			
Y	EVENT, STATE OR PRESENCE	Y AXIS		RELAY, COMPUTE, CONVERT	
Z	POSITION, DIMENSION	Z AXIS		DRIVER, ACTUATOR FINAL CONTROL ELEMENT	

EXPLANATORY NOTATIONS

SIGNAL CONVERTERS

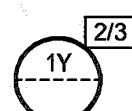


NOTE:

1: PROCESS OR INITIATING VARIABLE


2/3: A = ANALOG
D = DIGITAL
E = VOLTAGE
F = FREQUENCY
H = HYDRAULIC
I = CURRENT

M = MOTOR
O = ELECTROMAGNETIC, SONIC
P = PNEUMATIC
PF = PULSE FREQUENCY
PD = PULSE DURATION
R = RESISTANCE

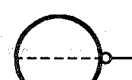

SMALL CIRCLE SIGNIFIES SIGNAL INVERSION


HAND SWITCHES

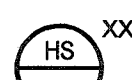


SELECTOR SWITCH (MAINTAINED CONTACT)



SPRING RETURN SWITCH OR PUSHBUTTONS (MOMENTARY CONTACT)

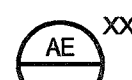

EXPOSED PROBE OR GAS DETECTOR

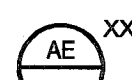

TAPPED OR SAMPLED




IN-LINE (FLOW THROUGH)

XXX:


COL = COLOR
CG = COMBUSTIBLE GAS
CLG = CHLORINE GAS
COG = CARBON MONOXIDE GAS
HC = HYDROCARBONS
H2S = HYDROGEN SULFIDE
NH4 = AMMONIA
OG = OXYGEN GAS
PH = PH
SO2 = SULPHUR DIOXIDE GAS
TOC = TOTAL ORGANIC CARBON

CDG = CARBON DIOXIDE GAS
CH4 = METHANE
CLR = CHLORINE RESIDUAL
DO = DISSOLVED OXYGEN
HUM = HUMIDITY
MHO = CONDUCTIVITY
N2G = NITROGEN GAS
OZG = OZONE GAS
SD = SOLIDS DENSITY
SS = SUSPENDED SOLIDS
TRB = TURBIDITY


INSTRUMENT TAG NUMBER

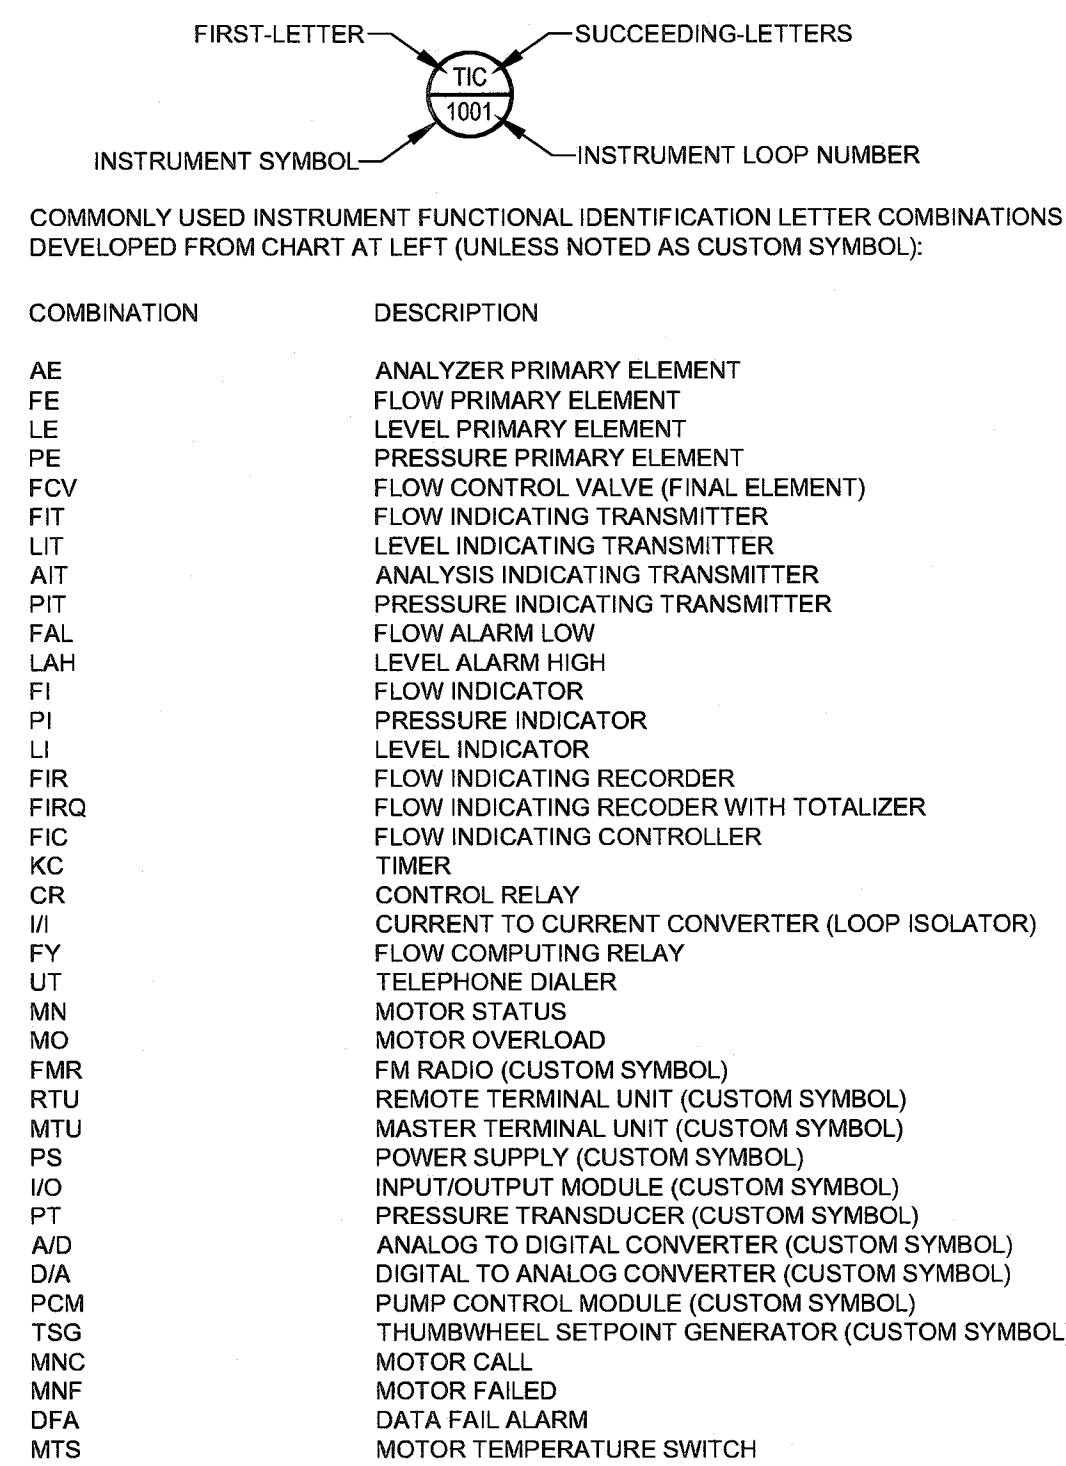

EQUIPMENT SYMBOLS

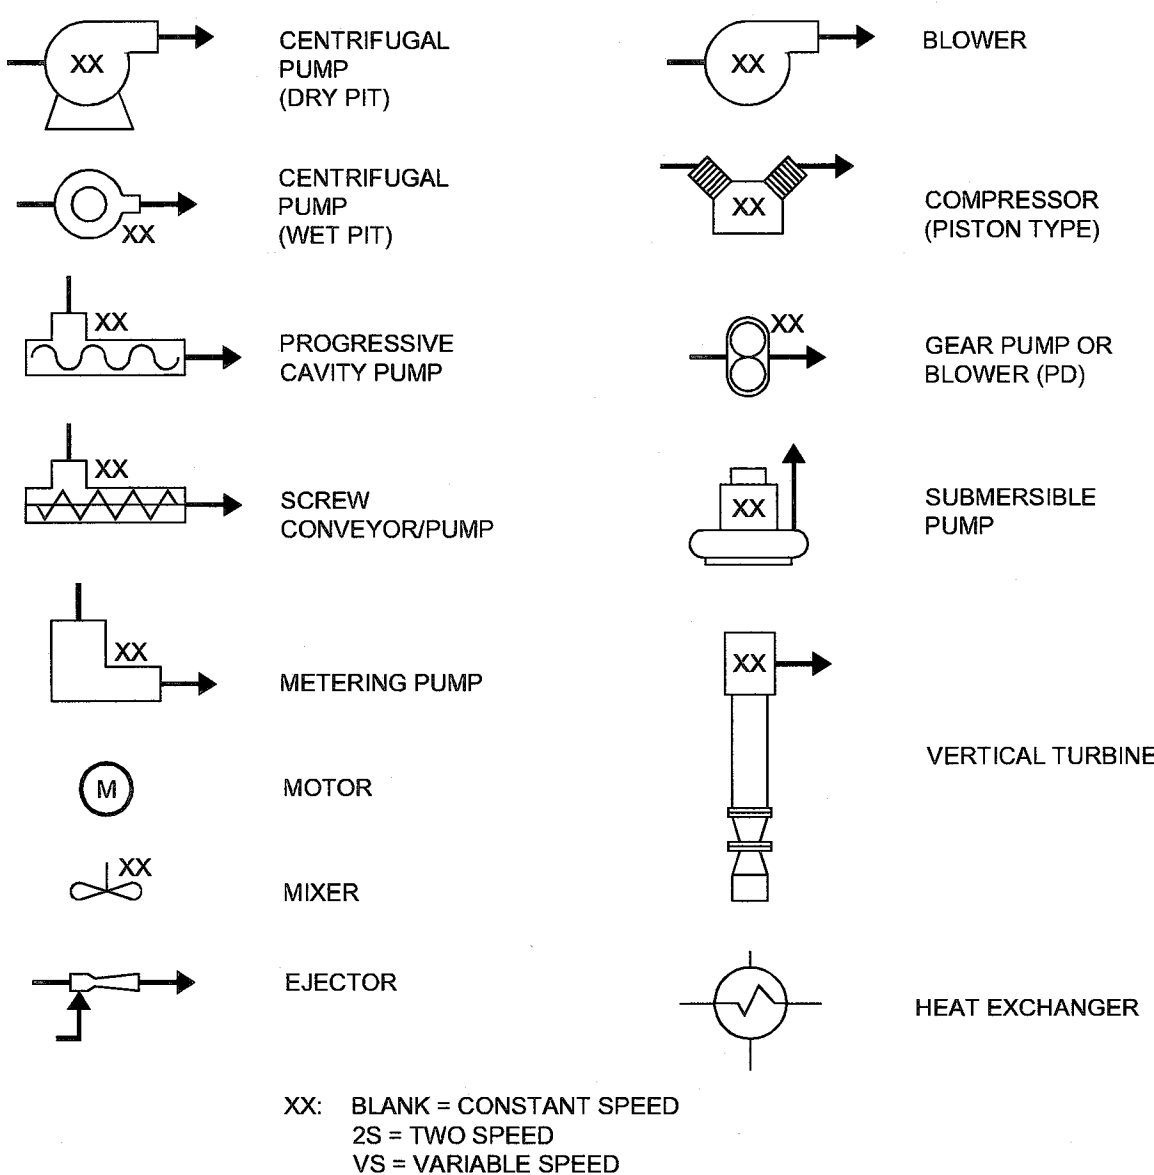


MISCELLANEOUS SYMBOLS

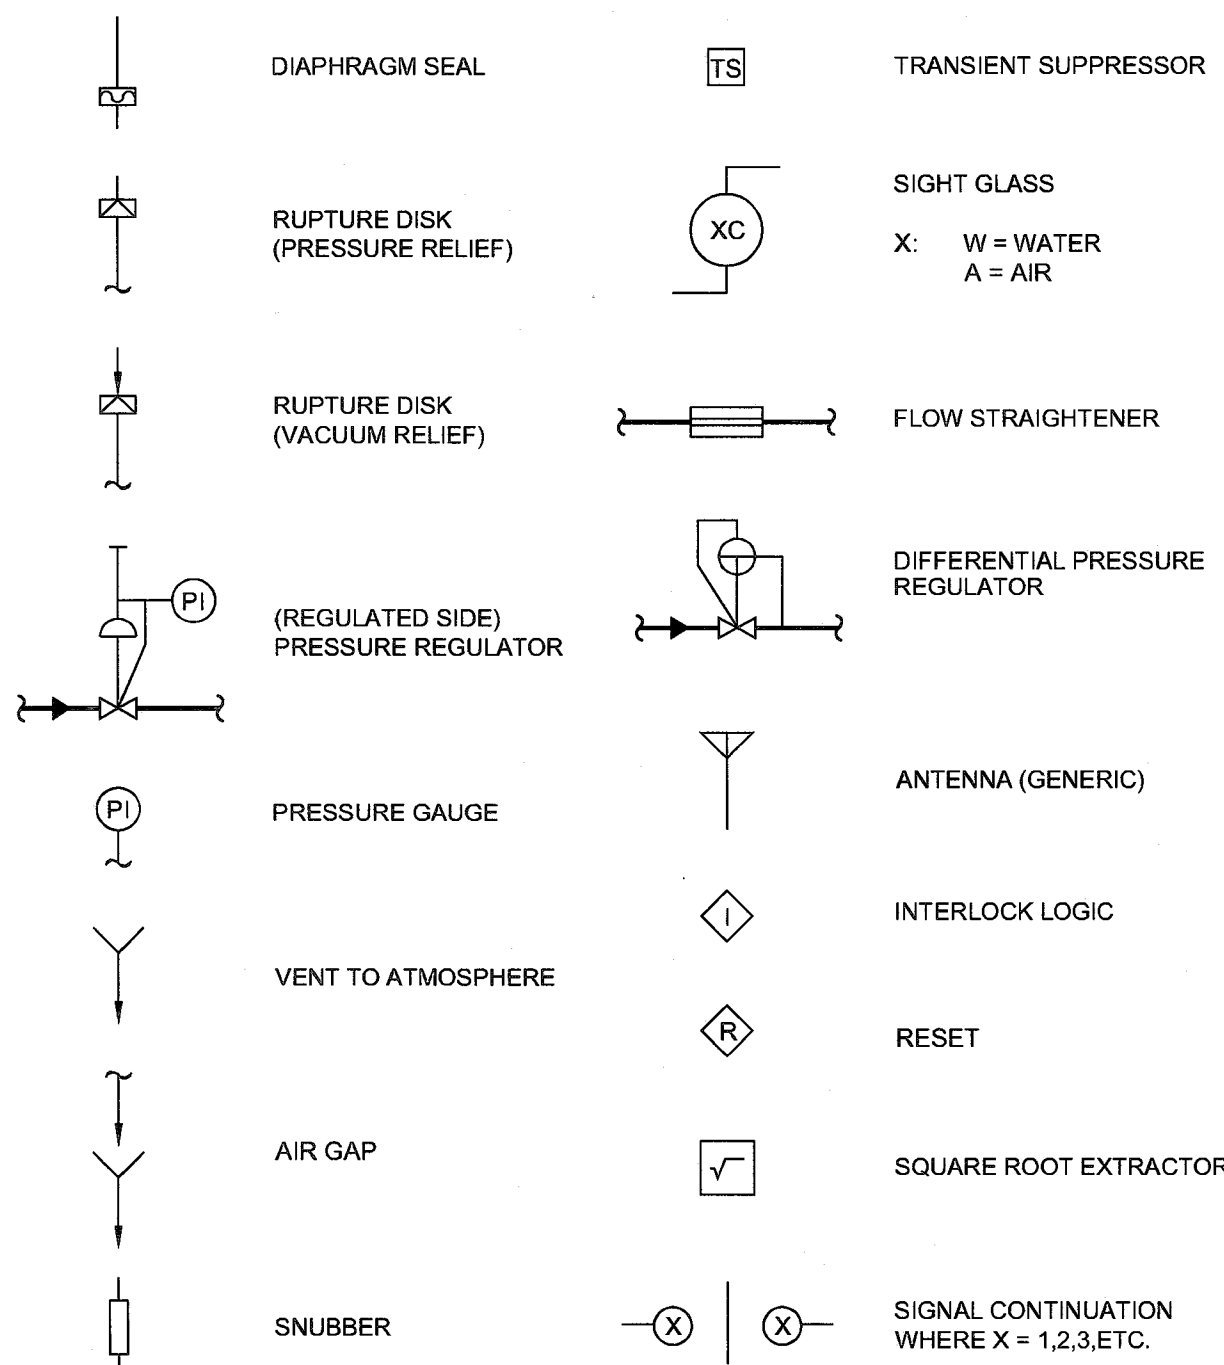


GENERAL INSTRUMENT OR FUNCTION SYMBOLS

	DISCRETE INSTRUMENT	SHARED DISPLAY/ SHARED CONTROL	COMPUTER FUNCTION	PROGRAMMABLE LOGIC CONTROLLER
OPERATOR ACCESSIBLE				
NOT ACCESSIBLE TO OPERATOR				
FIELD MOUNTED				
FRONT OF PANEL MOUNTED				
INTERIOR OF PANEL MOUNTED				
MOTOR CONTROL CENTER MOUNTED				
INSTRUMENTS SHARING A COMMON HOUSING				
ANNUNCIATOR				


PRIMARY ELEMENT SYMBOLS

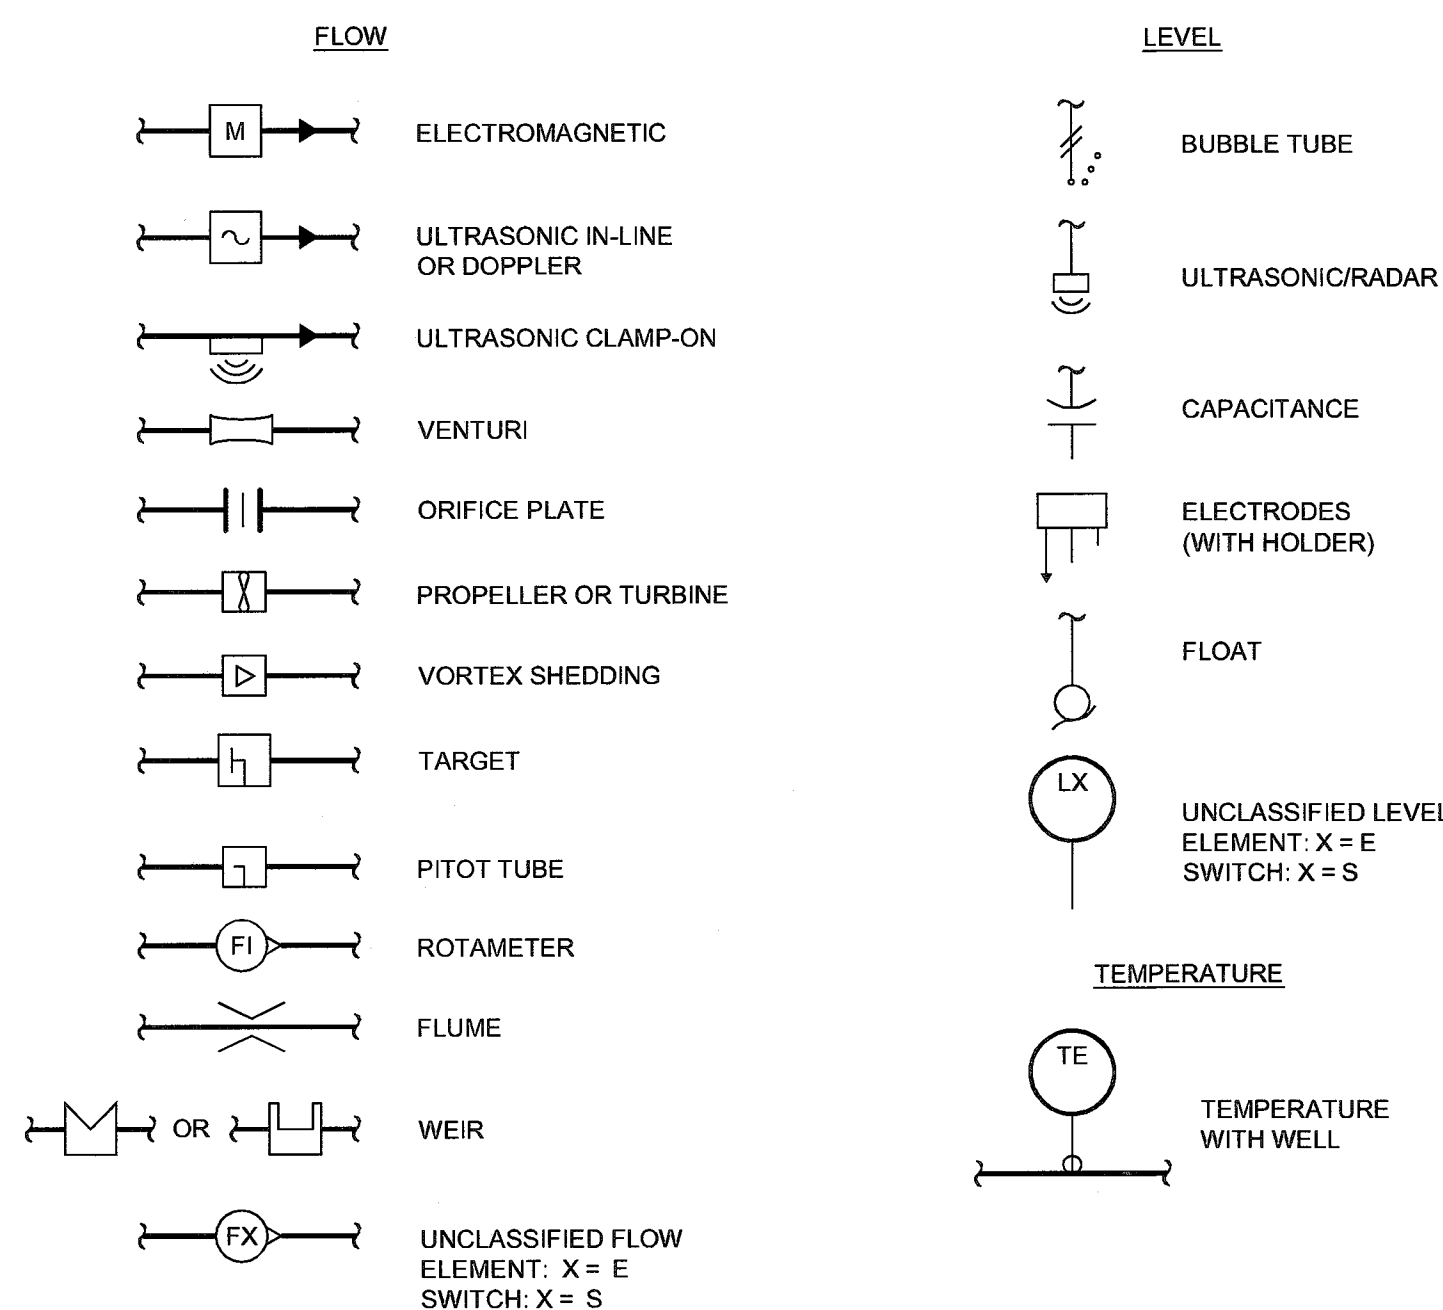

ACTUATOR SYMBOLS

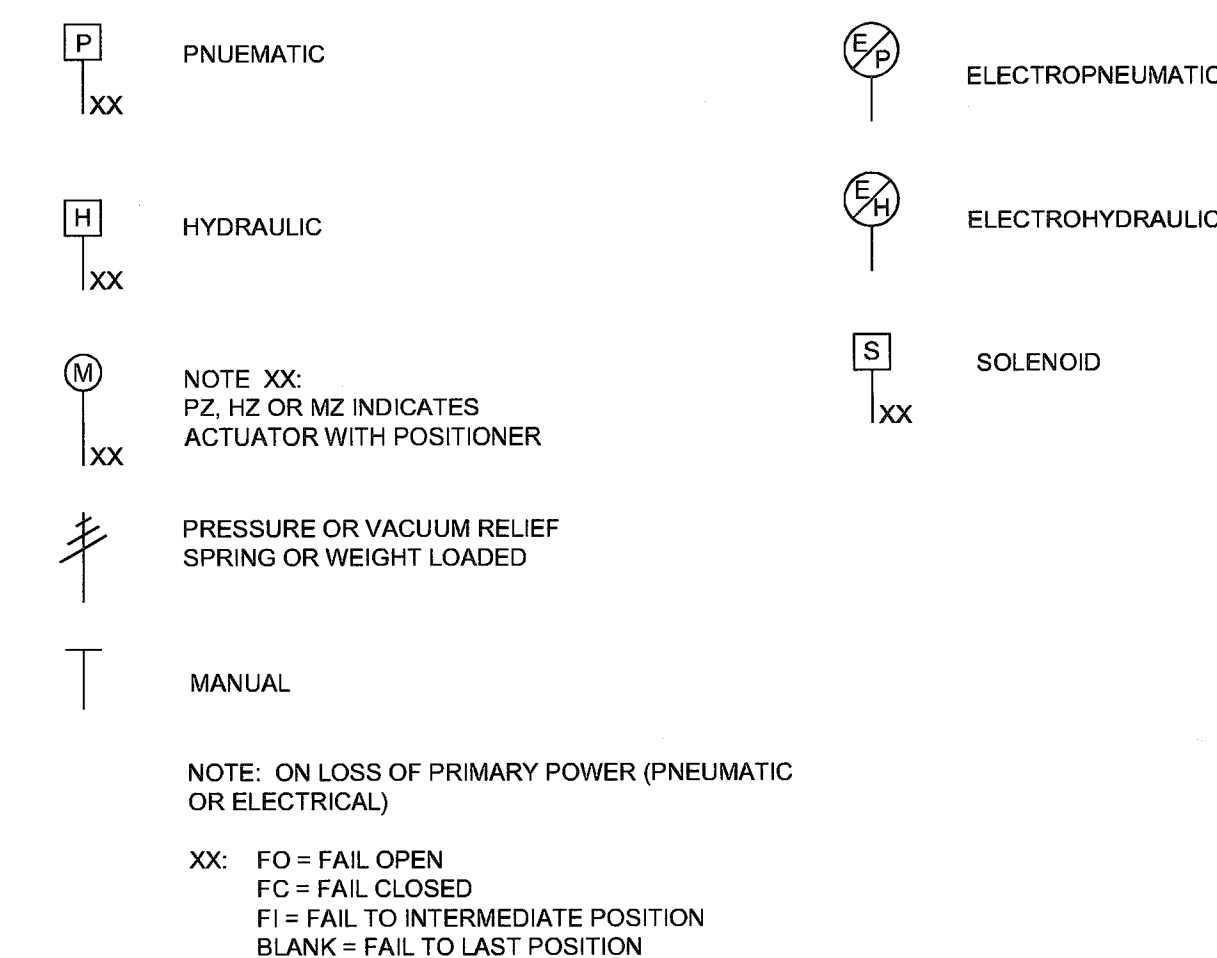


VALVE & GATE SYMBOLS

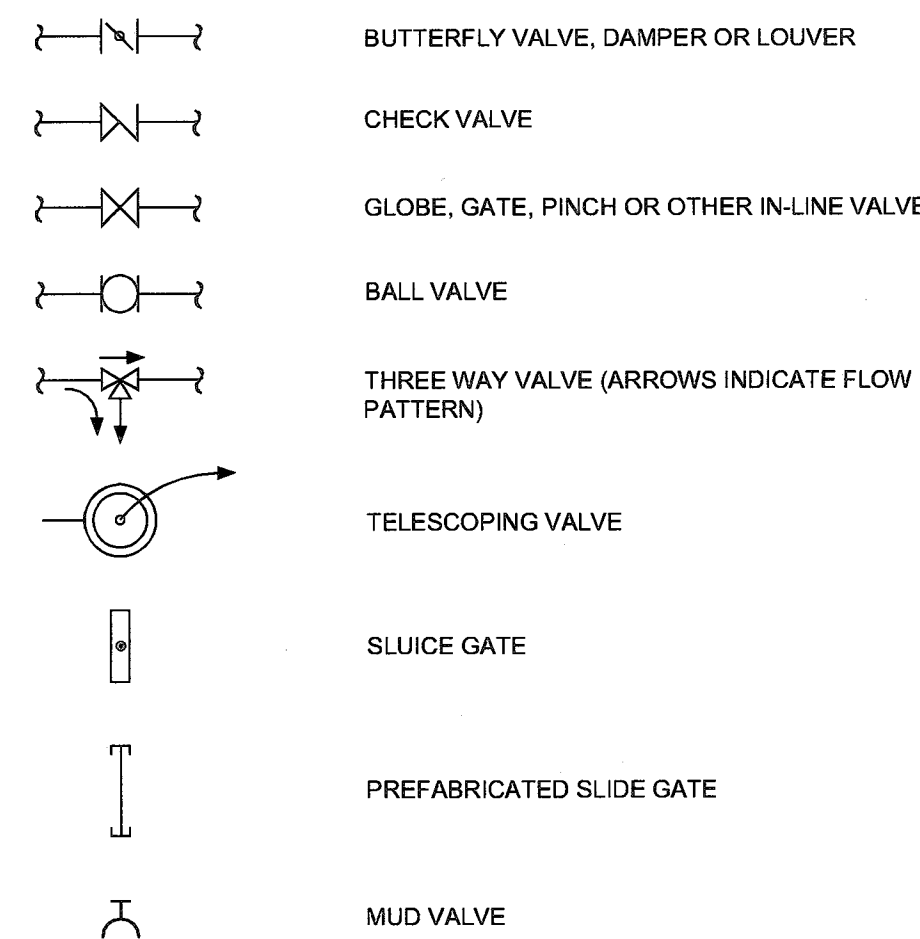

INSTRUMENT LINE SYMBOLS

(LINES TO BE DRAWN FINE IN RELATION TO PROCESS PIPING LINES)

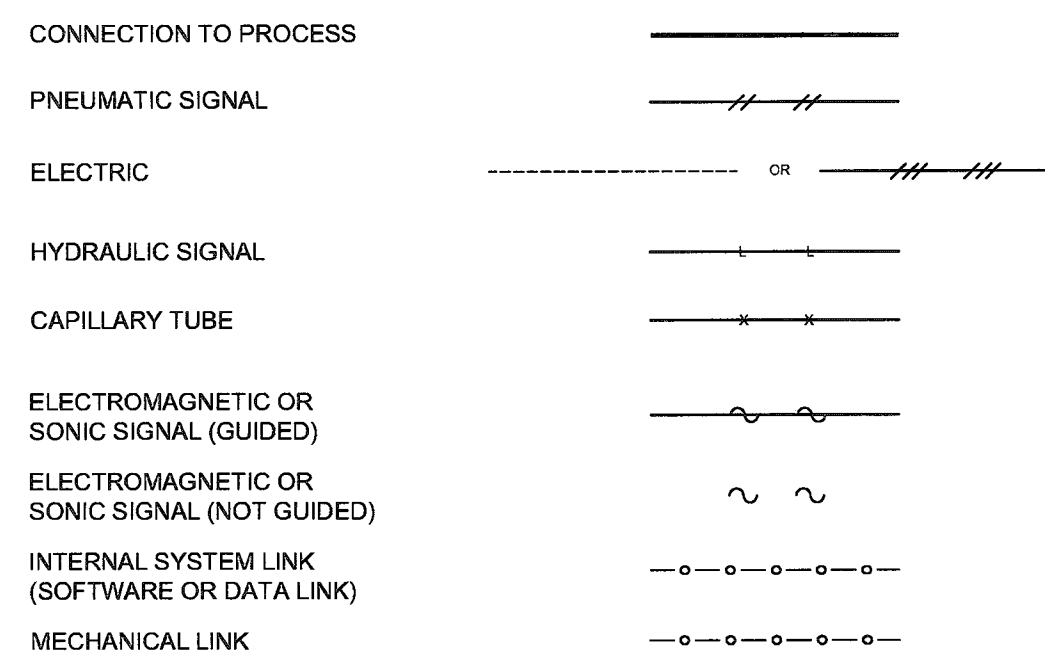


ABBREVIATIONS/ACRONYMS

AS	AIR SUPPLY	ES	ELECTRIC SUPPLY
GS	GAS SUPPLY	HS	HYDRAULIC SUPPLY
WS	WATER SUPPLY	CO	CONTACT OUTPUT
CI	CONTACT INPUT	PD	POSITIVE DISPLACEMENT
FMR	FM RADIO	MTU	MASTER TERMINAL UNIT
RTU	REMOTE TERMINAL UNIT		

GENERAL NOTES

- SEE DIVISION 40 OF THE SPECIFICATIONS FOR FURTHER INSTRUMENTATION REQUIREMENTS.
- THIS IS A GUIDE TO READING INSTRUMENT SOCIETY OF AMERICA (ISA) FORMAT P&ID OR LOOP DIAGRAMS. THESE SYMBOLS AND TECHNIQUES HAVE MOSTLY EXTRACTED FROM ISA STANDARD S5.1. THIS IS NOT HOWEVER, A COMPLETE OR EXACT DUPLICATION OF S5.1. NOT ALL SYMBOLS SHOWN ARE USED ON THIS PROJECT. SOME SYMBOLS MAY BE USED THAT ARE NOT SHOWN. CONTACT THE ENGINEER OR REFER TO ISA STANDARD S5.1 FOR CLARIFICATIONS.
- POWER SUPPLIES SHALL BE FURNISHED BY THE INSTRUMENT SUPPLIER AS REQUIRED TO MEET THE VOLTAGE AND CURRENT REQUIREMENTS OF THE COMPONENTS IN EACH LOOP OR SYSTEM.

COMMUNICATION & PROCESS SYMBOLS

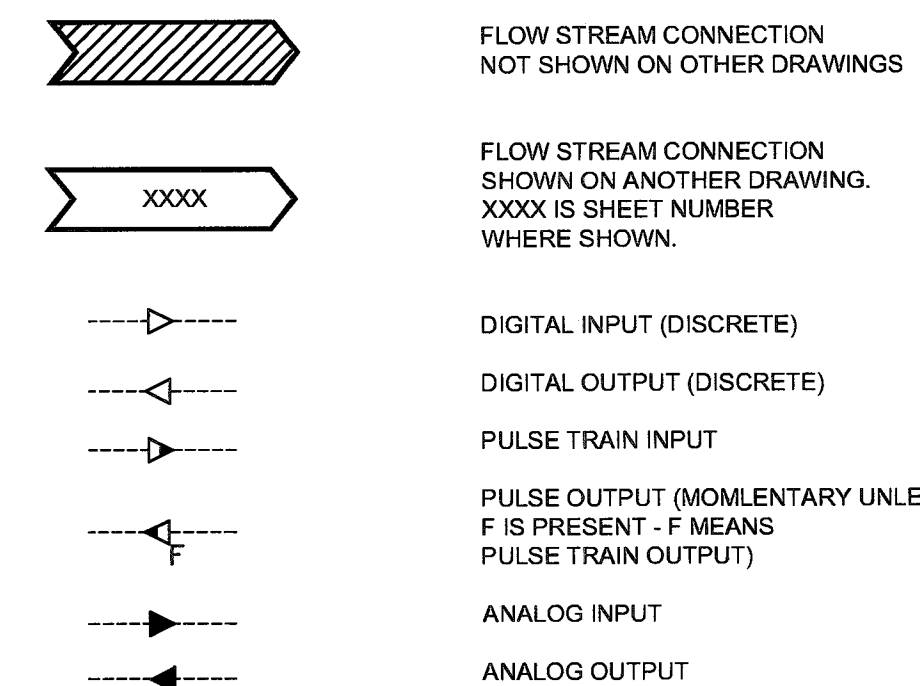

GENERAL NOTE:

- ELECTRICAL CONTRACTOR IS RESPONSIBLE FOR COORDINATING WIRING WITH INSTRUMENTATION EQUIPMENT PROVIDED IN DIVISION 40.

INSTRUMENTATION STANDARD SYMBOLS AND LEGEND

BABY FARMS LIFT STATION AND FORCE MAIN IMPROVEMENTS
FALL CREEK REGIONAL WASTE DISTRICT

DESIGNED: WER
DRAWN: WER
REVIEWED: WER
APPROVED: WLM

DATE: _____
SCALE: NOT TO SCALE
SHEET NO. I-001

SCALE CHECK: THIS MARK SHOULD MEASURE EXACTLY 1 WHEN PLOTTED




1. A SADDLE IS REQUIRED FOR ALL TYPES OF PLASTIC PIPE OR THIN WALL DUCTILE IRON PIPE.

1 TYPICAL PRESSURE GAUGE PIPING DETAIL



1. RACKS FURNISHED WITH PUMPS MAY BE UTILIZED IN LIEU OF THIS DETAILED BRACKET, AS LONG AS SUITABLY PROTECTED FROM CORROSION.

2 LEVEL SENSOR HOLDER
NOT TO SCALE

DATE:		REVISIONS		DESIGNED:		INSTRUMENTATION DETAILS		BABY FARMS LIFT STATION AND FORCE MAIN IMPROVEMENTS FALL CREEK REGIONAL WASTE DISTRICT		engineering architecture geospatial www.gwinc.com		CLIENT PROJECT NO.		GRW PROJECT NO. 4625			
NO.		DESCRIPTION		DATE		BY		WER		TOWN		ALL RIGHTS RESERVED GWIN ENGINEERS, INC. AND SHALL NOT BE REPRODUCED OR TRANSMITTED IN ANY FORM OR BY ANY MEANS WITHOUT WRITTEN PERMISSION					
								WER									
								REVIEWED									
								WER									
								APPROVED:									
								WLM									
SCALE:		NOT TO SCALE															
SHEET NO.		I-501															

