



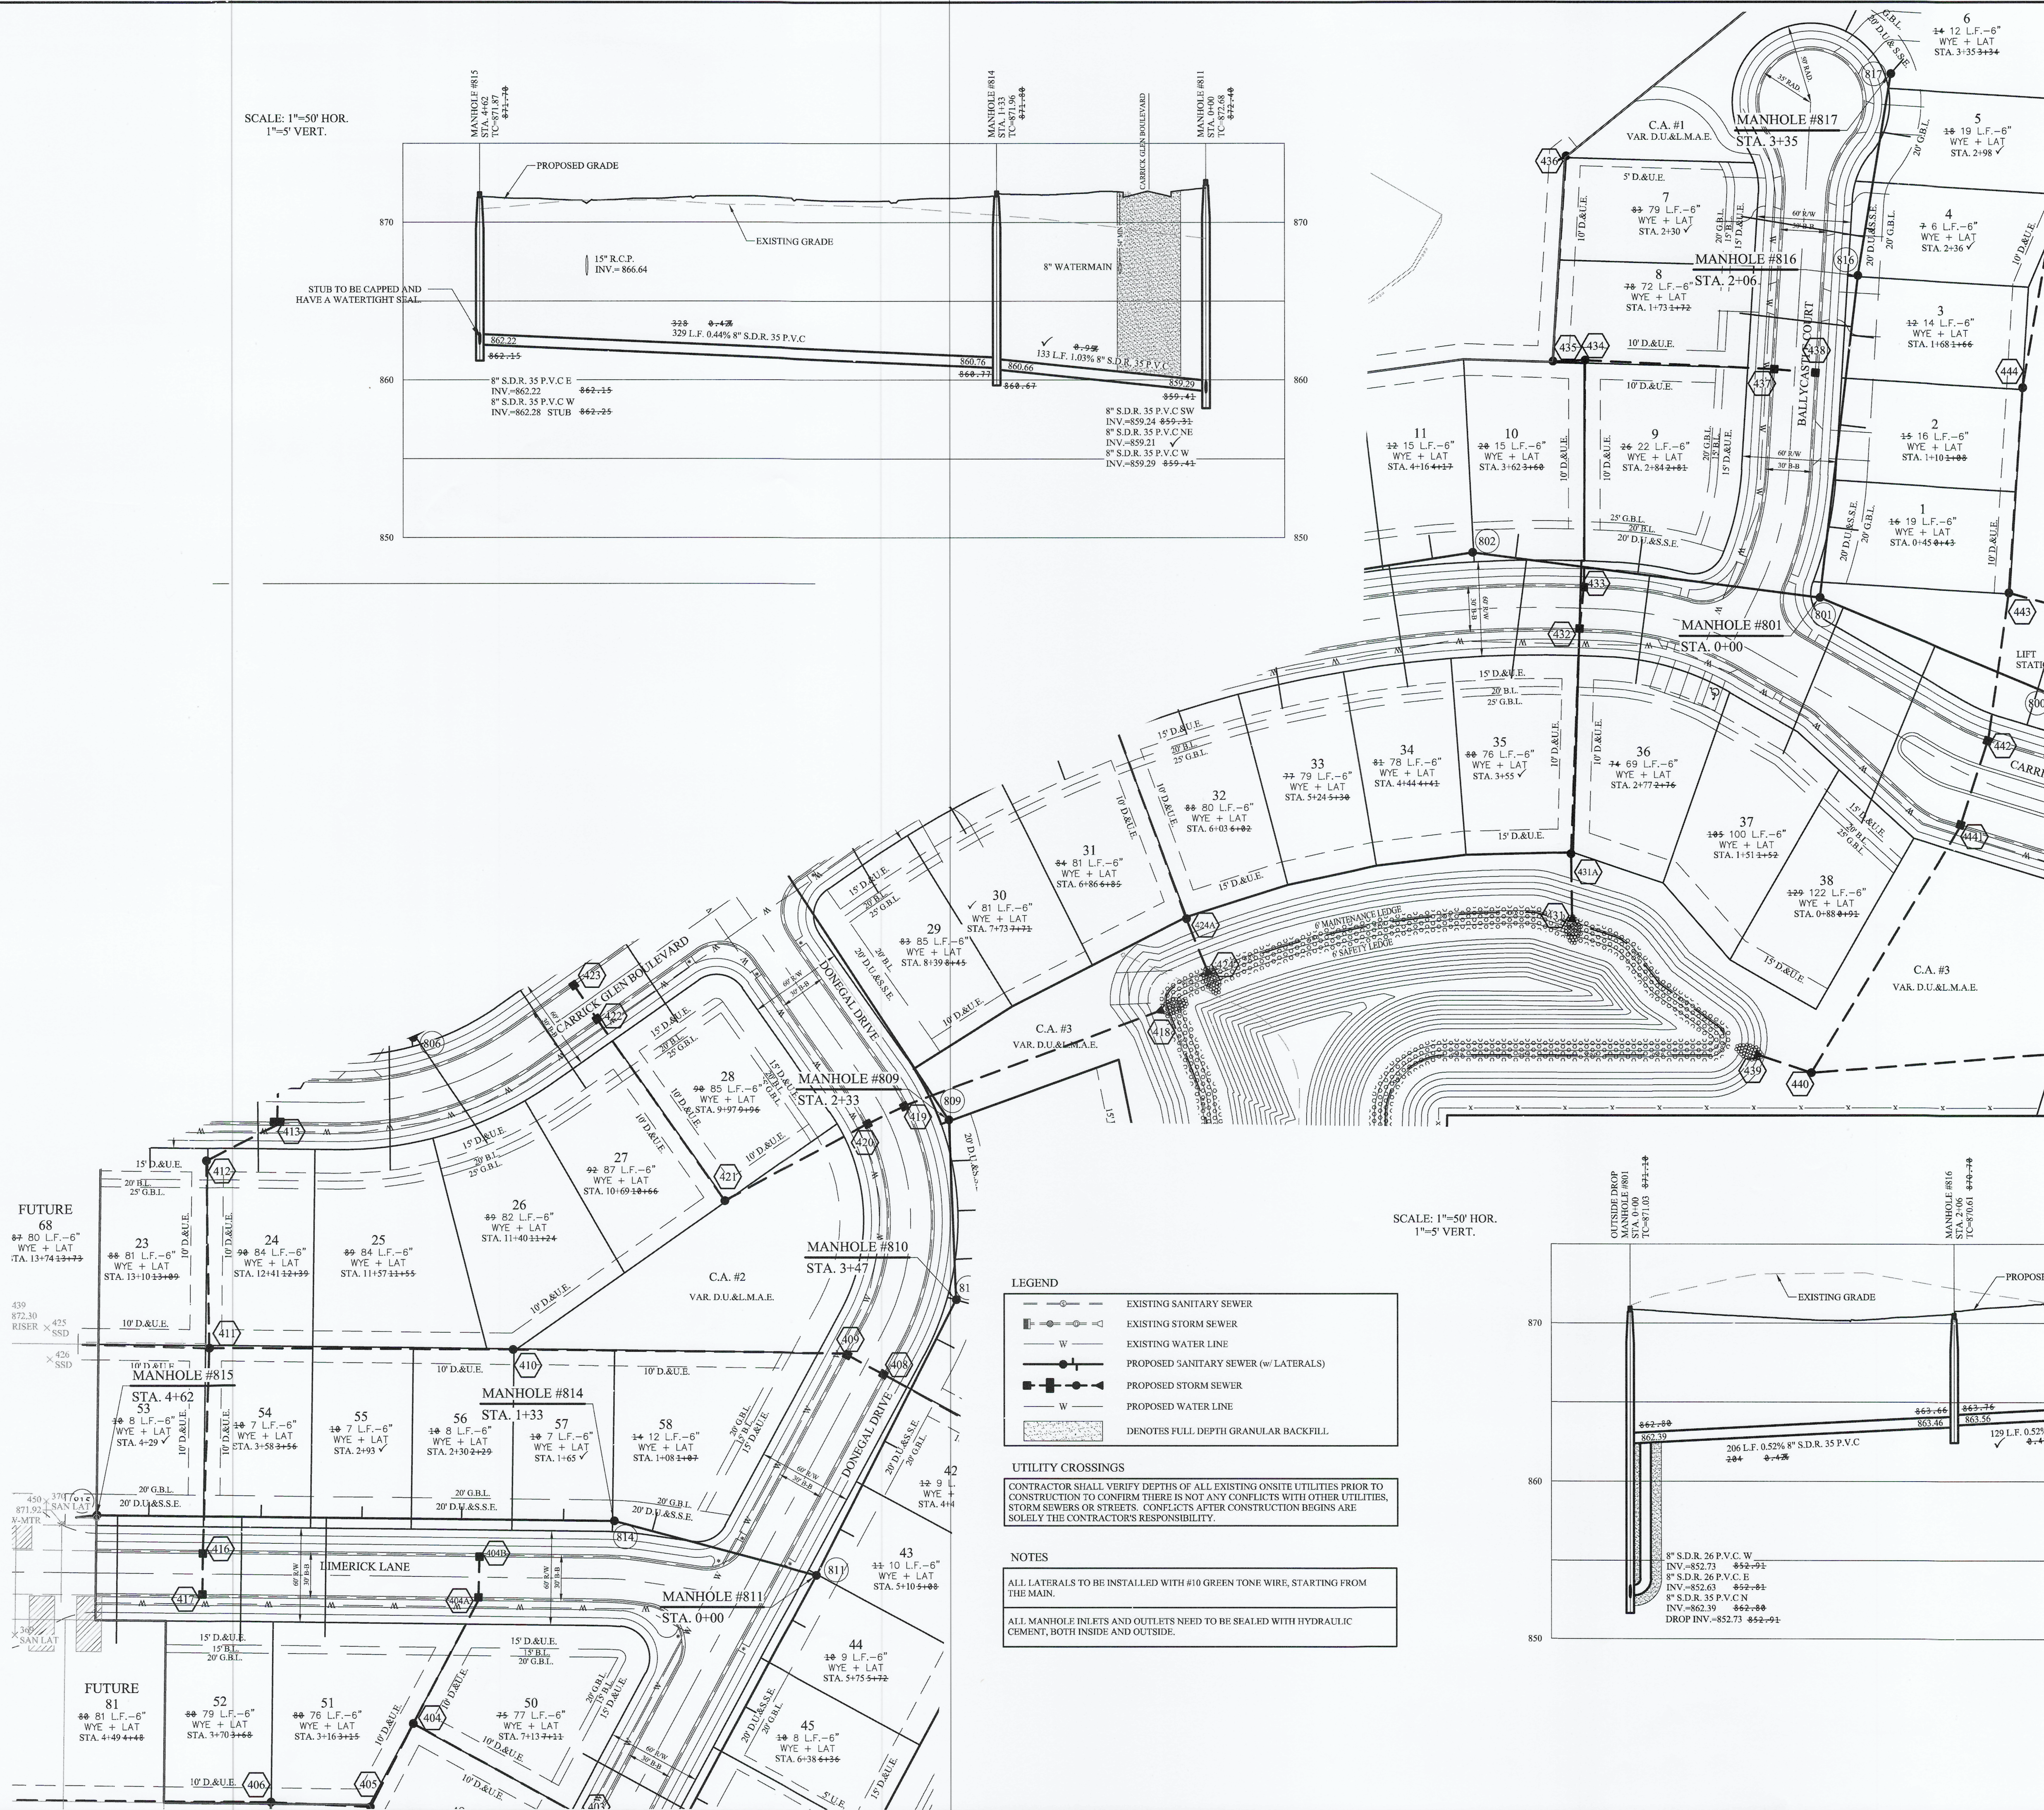

RECORD DRAWING

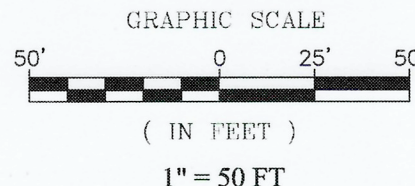

David J. Stoepelwirth
Registered Professional Engineer
No. 19358
State of Indiana
8/24/2020

THIS DRAWING IS NOT INTENDED TO BE REPRESENTED AS A RETRACTION OR ORIGINAL BOUNDARY SURVEY, A ROUTE SURVEY, OR A SURVEY FOR LOCATION REPORT.
CERTIFIED: 06/10/19
David J. Stoepelwirth

STOEPELWERTH
ALWAYS ON
7945 East 106th Street, Fishers, IN 46038-2505
phone 317.840.5925 fax 317.840.5942

SANITARY SEWER PLAN & PROFILES
CARRICK GLEN
SECTIONS 1A & 1B
PENDLETON, FALL CREEK TOWNSHIP
MADISON COUNTY, INDIANA

DRAWN BY: AEC/GEM
CHECKED BY: KRG
SHEET NO. C502
S & A JOB NO. 84449DRH-S1