



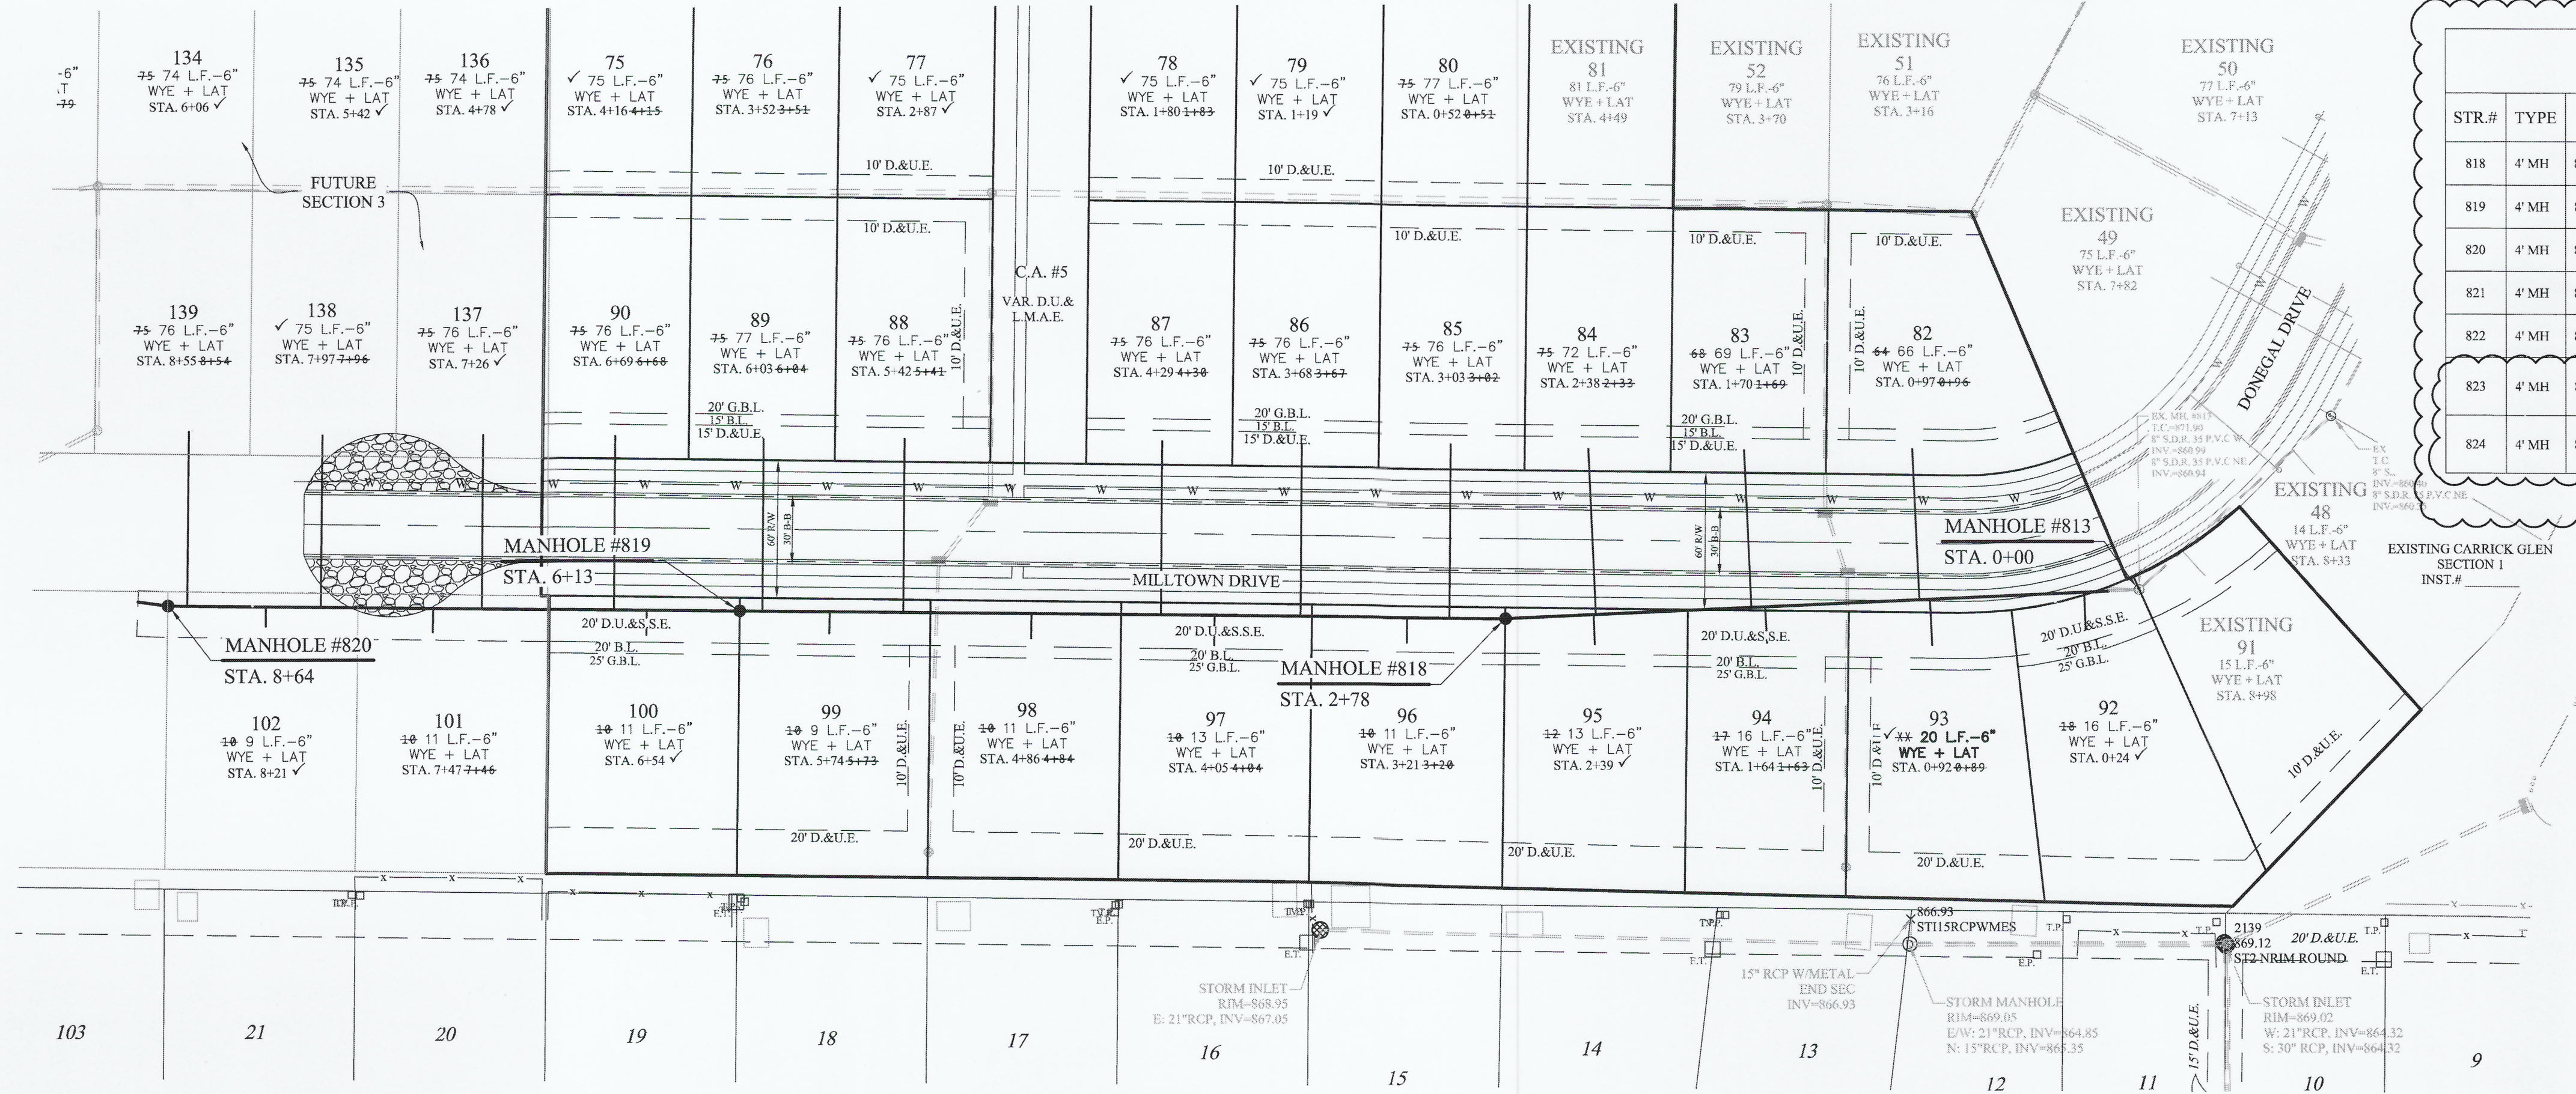

SANITARY SEWER STRUCTURE & PIPE TABLE													
STR.#	TYPE	T.C.	CASTING TYPE	DIA. IN	DIR. IN	INV. IN	DIA. OUT	DIR. OUT	INV. OUT	SLOPE	PIPE	LENGTH	MATERIAL
818	4" MH	872.02	R-1772	8"	W	862.38	8"	E	862.32	0.42%	818-819 813-818	335' 265'	S.D.R. 35 P.V.C. S.D.R. 35 P.V.C.
819	4" MH	871.75	R-1772	8"	W	863.99	8"	E	863.89	0.45%	819-820 818-819	259' 335'	S.D.R. 35 P.V.C. S.D.R. 35 P.V.C.
820	4" MH	873.74	R-1772	8"	W	865.11	8"	E	865.00	0.40%	819-820 820-STUB W	259' 13'	S.D.R. 35 P.V.C. S.D.R. 35 P.V.C.
821	4" MH	872.02	R-1772	8"	W	864.11	8"	E	864.06	0.40%	821-822 815-821	392' 373'	S.D.R. 35 P.V.C. S.D.R. 35 P.V.C.
822	4" MH	873.49	R-1772	8"	W	865.90	8"	E	865.85	0.44%	821-822 822-STUB W	392' 13'	S.D.R. 35 P.V.C. S.D.R. 35 P.V.C.
823	4" MH	874.43	R-1772	8"	W	866.36 866.14	8"	E	866.26	0.40%	823-824 807-823 823-STUB N	290' 187' 15'	S.D.R. 35 P.V.C. S.D.R. 35 P.V.C. S.D.R. 35 P.V.C.
824	4" MH	875.08	R-1772	8"	W	861.63 861.73	8"	E	861.60	0.43%	823-824 824-STUB W 824-STUB N	290' 13' 14'	S.D.R. 35 P.V.C. S.D.R. 35 P.V.C. S.D.R. 35 P.V.C.

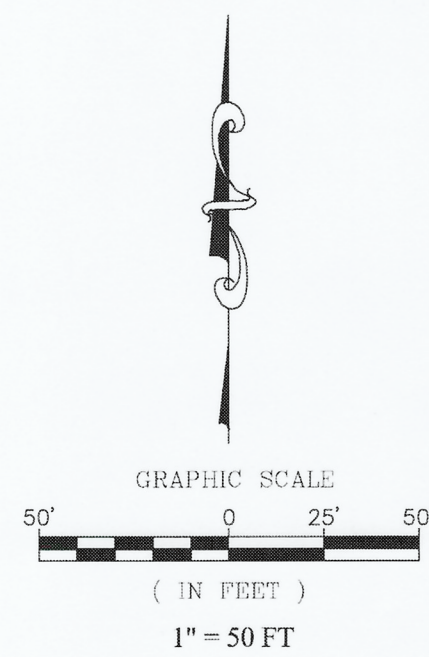


LEGEND	
	EXISTING SANITARY SEWER
	EXISTING STORM SEWER
	EXISTING WATER LINE
	PROPOSED SANITARY SEWER (w/ LATERALS)
	PROPOSED STORM SEWER
	PROPOSED WATER LINE
	DENOTES FULL DEPTH GRANULAR BACKFILL

UTILITY CROSSINGS
CONTRACTOR SHALL VERIFY DEPTHS OF ALL EXISTING ONSITE UTILITIES PRIOR TO CONSTRUCTION TO CONFIRM THERE IS NOT ANY CONFLICTS WITH OTHER UTILITIES. STORM SEWERS OR STREETS. CONFLICTS AFTER CONSTRUCTION BEGINS ARE SOLELY THE CONTRACTOR'S RESPONSIBILITY.


NOTES
ALL LATERALS TO BE INSTALLED WITH #10 GREEN TONE WIRE, STARTING FROM THE MAIN.
ALL MANHOLE INLETS AND OUTLETS NEED TO BE SEALED WITH HYDRAULIC CEMENT, BOTH INSIDE AND OUTSIDE.

SCALE: 1"=50' HOR.
1"=5' VERT.

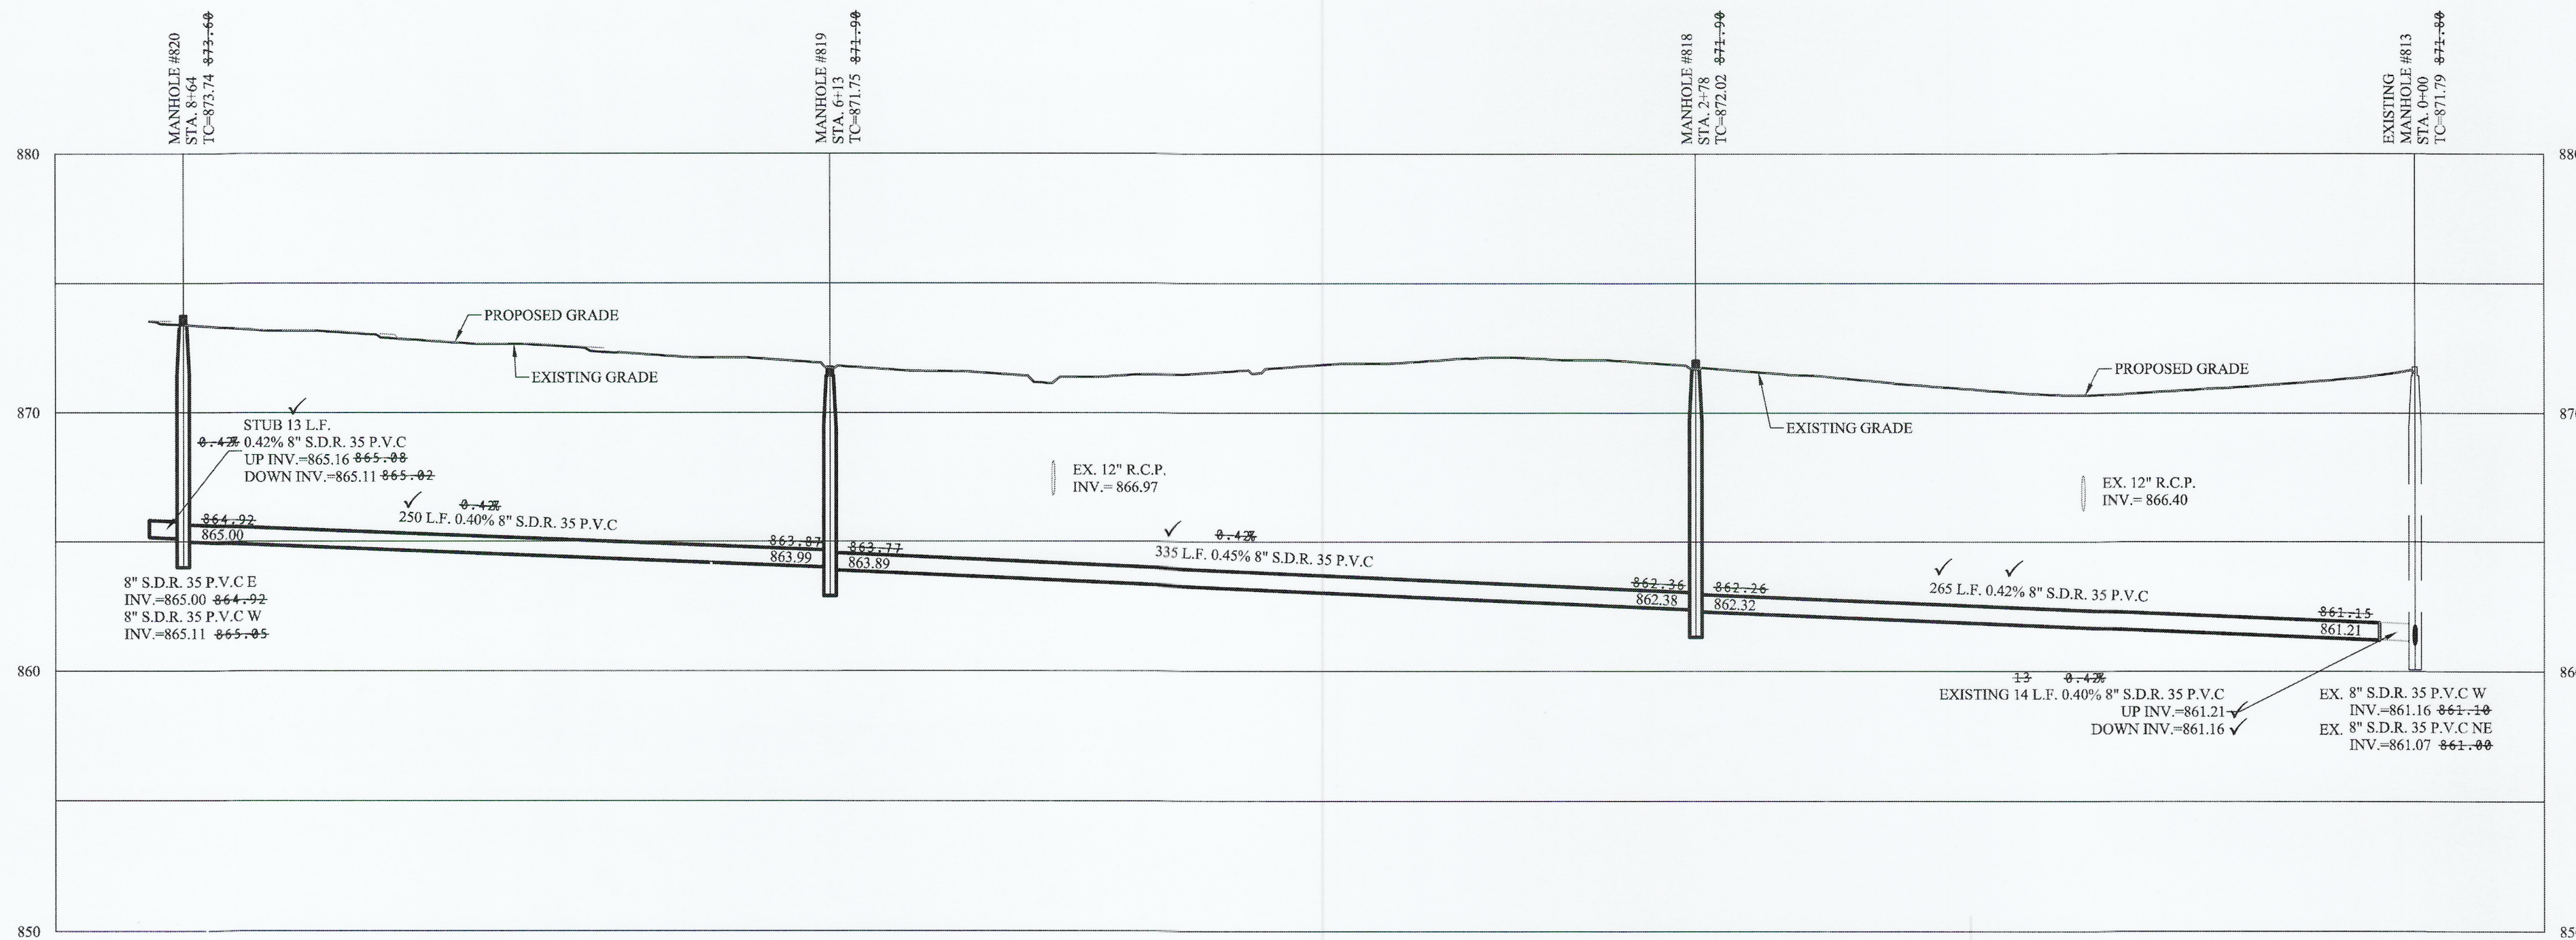

RECORD DRAWING

Dennis D. Olmstead
Registered Land Surveyor
No. 900012
2/11/2021

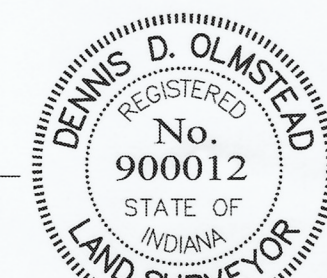

STOEPPELWERTH

ALWAYS ON

7905 East 106th Street, Fishers, IN 46038-2505
phone: 317.849.5955 fax: 317.849.5942

SANITARY SEWER PLAN & PROFILES

CARRICK GLEN

SECTION 2

PENDLETON, FALL CREEK TOWNSHIP

DRAWN BY: AEC

CHECKED BY: KRG

SHEET NO. C501

S & A JOB NO. 84449DRH-S2

THIS DRAWING IS NOT INTENDED TO BE A SUBSTITUTE FOR AN ORIGINAL SURVEY OR A SURVEYOR LOCATION REPORT.

DAVID STOEPPELWERTH
REGISTERED PROFESSIONAL ENGINEER
No. 19358
STATE OF INDIANA
CERTIFIED: 12/09/19
David J. Stoeppelwerth

DATE: 01/09/20
MARK: [initials]
REVISIONS: [table with columns for revision number, description, and date]