

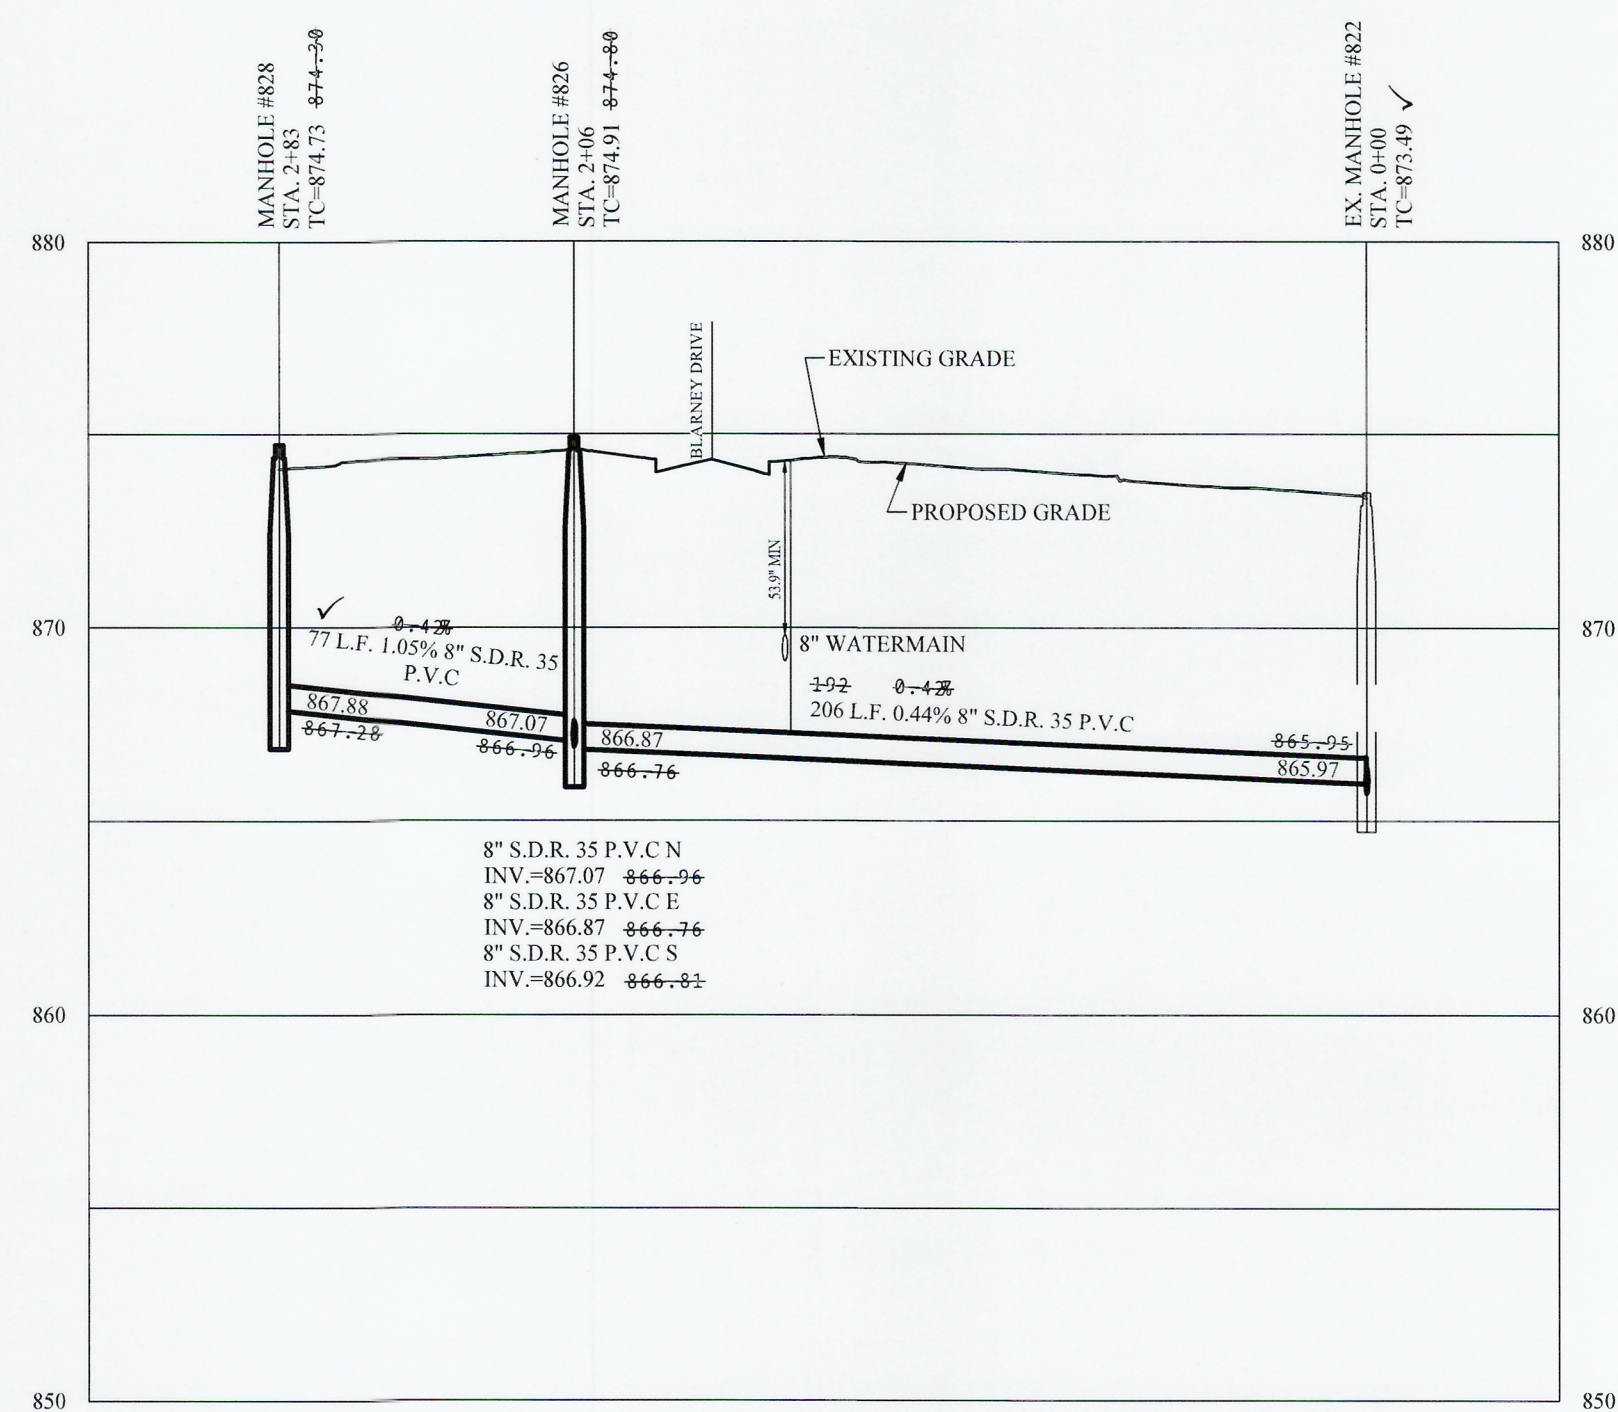 


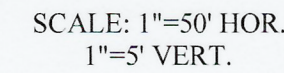


Dennis D. Olmstead
Professional Land Surveyor
No. 900012



UTILITY CROSSINGS

CONTRACTOR SHALL VERIFY DEPTHS OF ALL EXISTING ONSITE UTILITIES PRIOR TO CONSTRUCTION TO CONFIRM THERE IS NOT ANY CONFLICTS WITH OTHER UTILITIES. STORM SEWERS OR STREETS. CONFLICTS AFTER CONSTRUCTION BEGINS ARE SOLELY THE CONTRACTOR'S RESPONSIBILITY.

GRAPHIC SCALE

50' 0 25' 50'

(IN FEET)

1" = 50 FT



THIS DRAWING IS NOT INTENDED TO BE REPRESENTED AS A RETACEMENT OR ORIGINAL BOUNDARY SURVEY, A ROUTE SURVEY OR A SURVEYOR LOCATION

CERTIFIED: 09/08/20

David J. Stoppelmuech

STOEPPELWERTH

ALWAYS ON
1965 East 106th Street, Fishers, IN 46038-2505
phone: 317 840 5935 fax: 317 840 5942

SANITARY SEWER PLAN & PROFILES

CARRICK GLEN
SECTION 3A & 3B

PENDLETON, FALL CREEK TOWNSHIP MADISON COUNTY, INDIANA

DRAWN BY: AEC	CHECKED BY: KRG
SHEET NO. C500	
S & A JOB NO. 84449DRH-S3	