



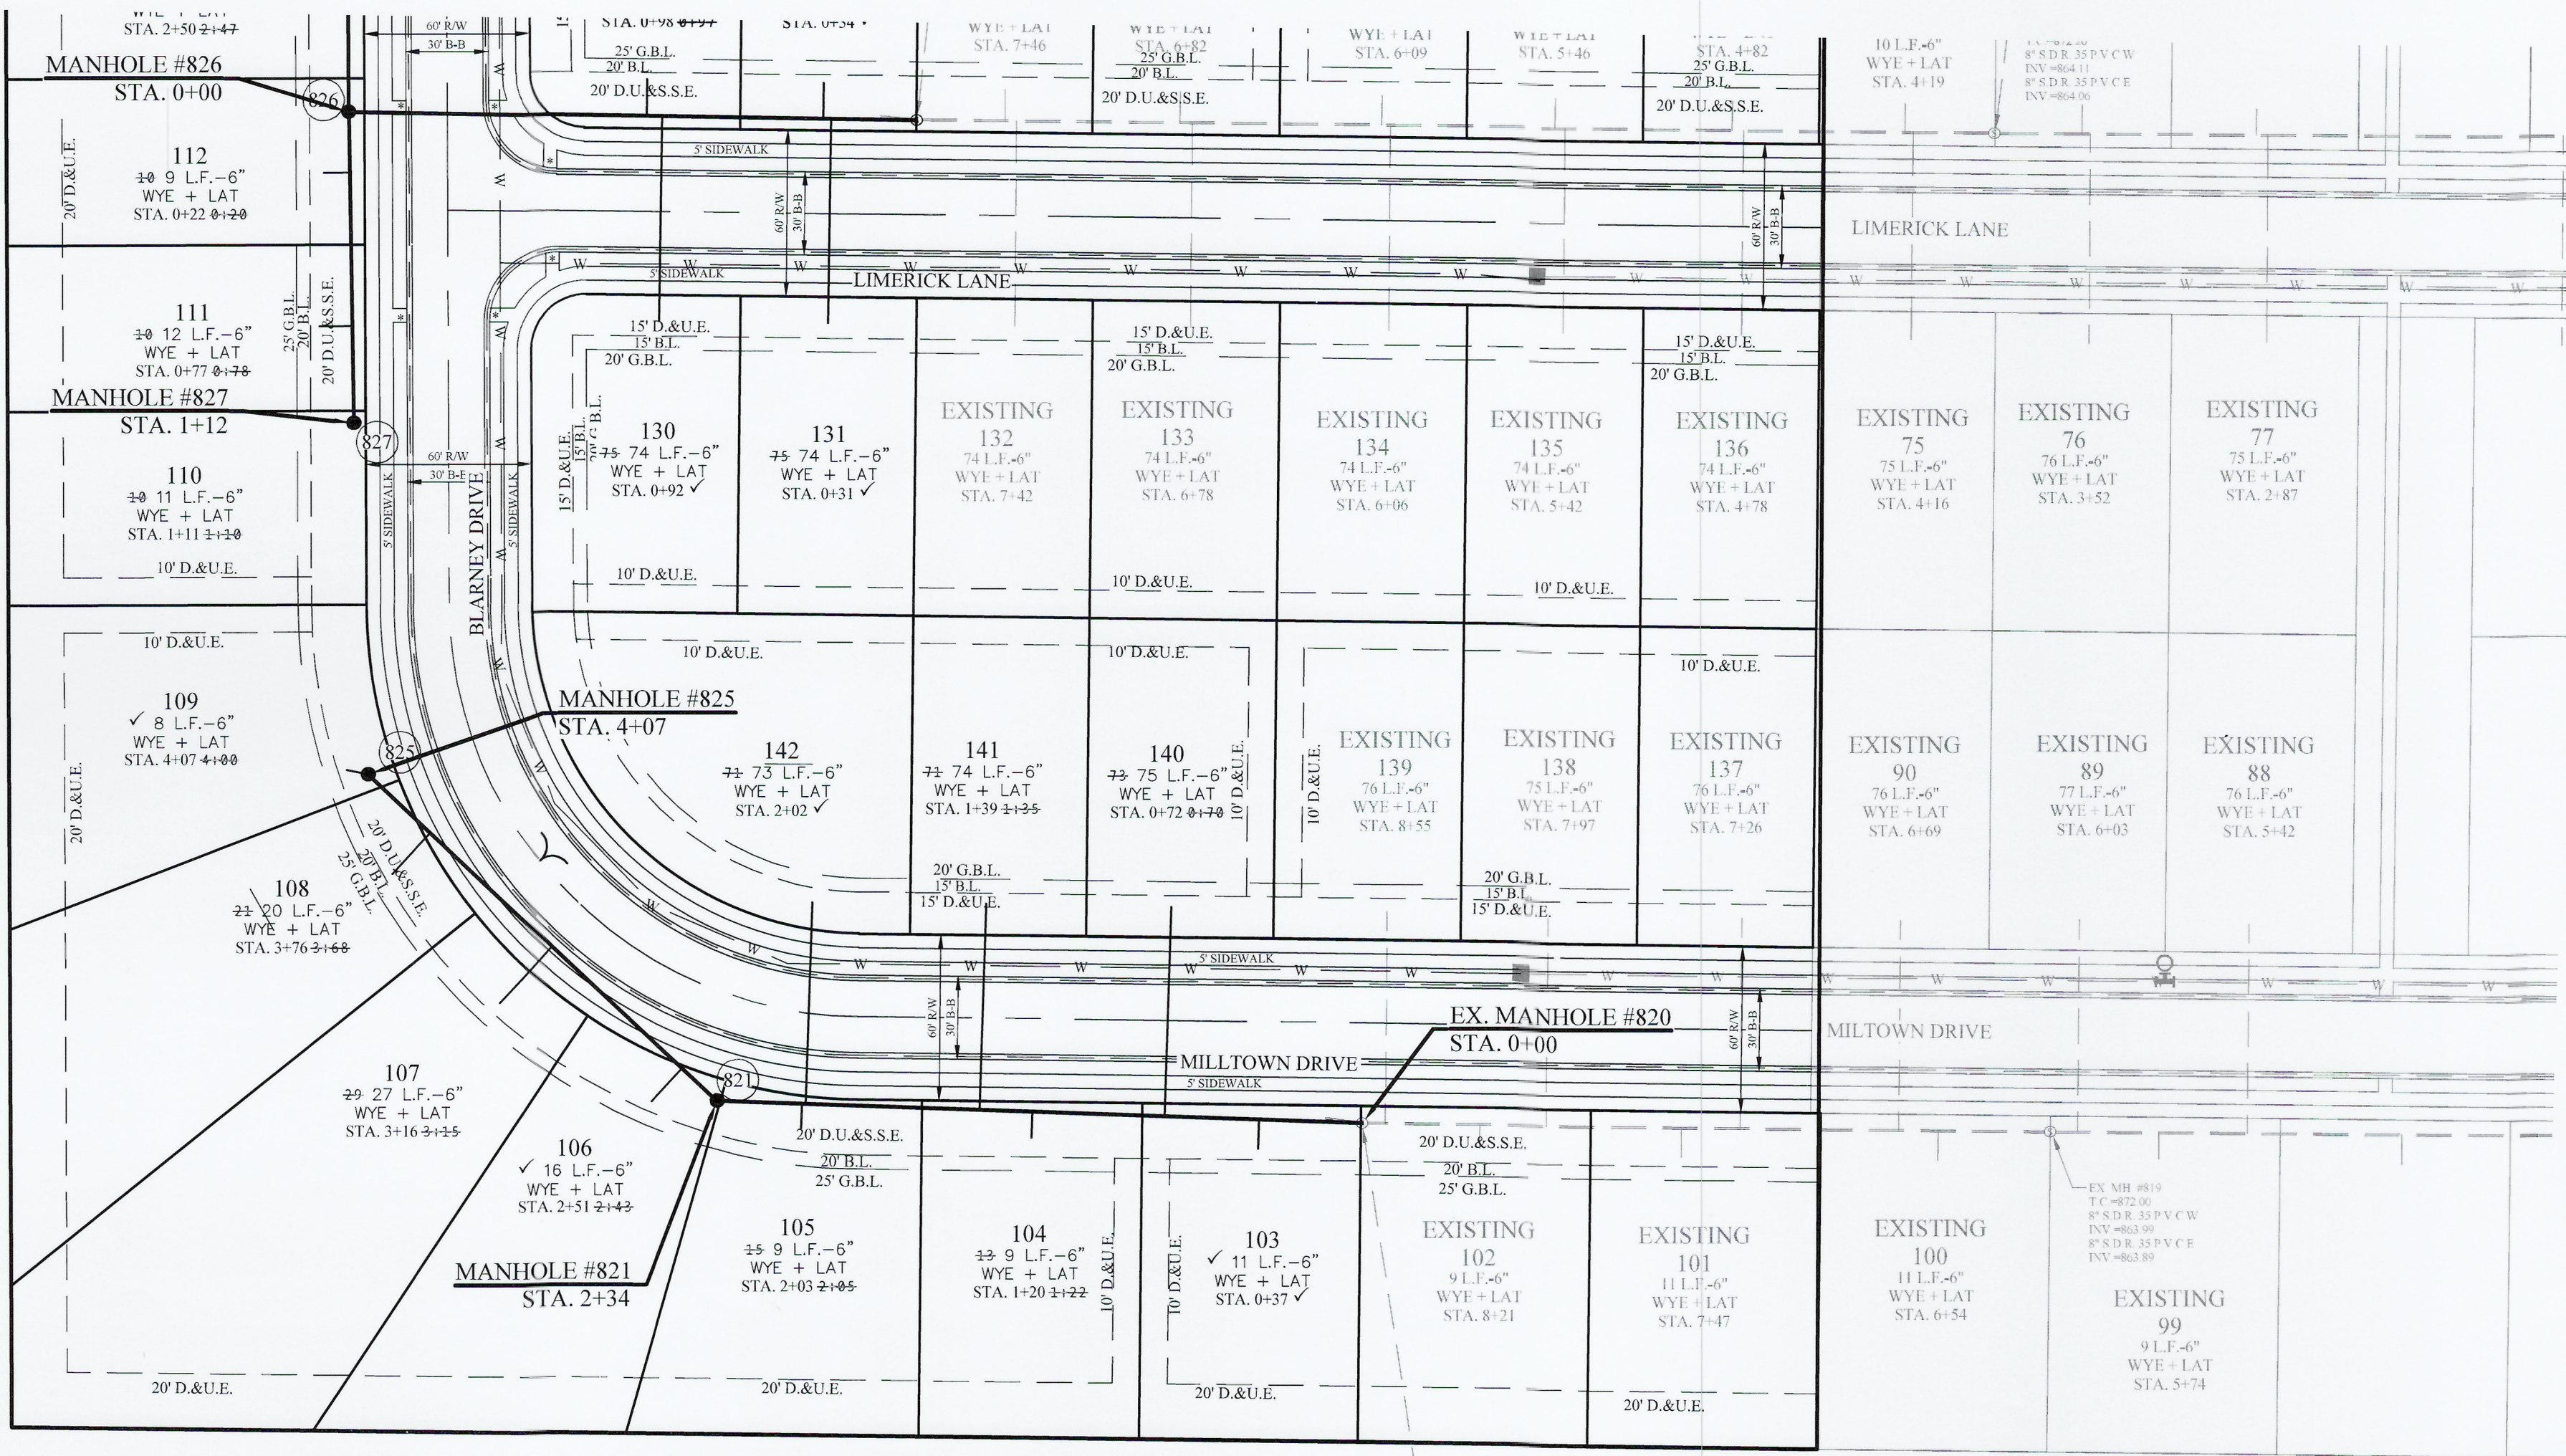

LEGEND

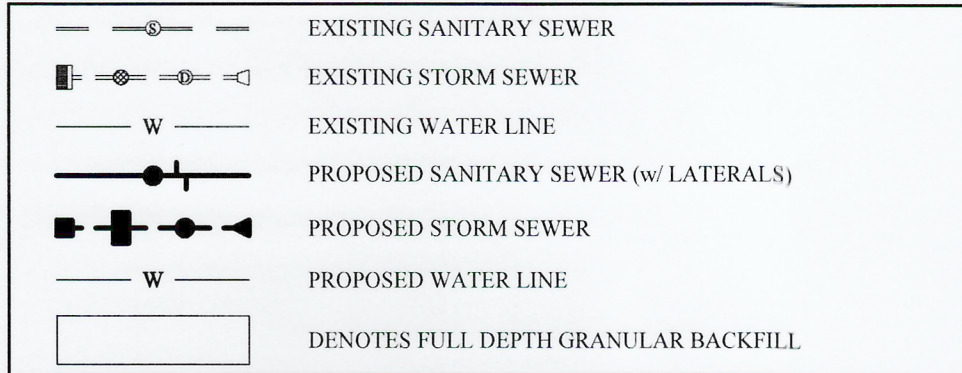


UTILITY CROSSINGS

CONTRACTOR SHALL VERIFY DEPTHS OF ALL EXISTING ONSITE UTILITIES PRIOR TO CONSTRUCTION TO CONFIRM THERE IS NOT ANY CONFLICTS WITH OTHER UTILITIES, STORM SEWERS OR STREETS. CONFLICTS AFTER CONSTRUCTION BEGINS ARE SOLELY THE CONTRACTOR'S RESPONSIBILITY.

NOTES

ALL LATERALS TO BE INSTALLED WITH #10 GREEN TONE WIRE, STARTING FROM THE MAIN.


ALL MANHOLE INLETS AND OUTLETS NEED TO BE SEALED WITH HYDRAULIC CEMENT, BOTH INSIDE AND OUTSIDE.

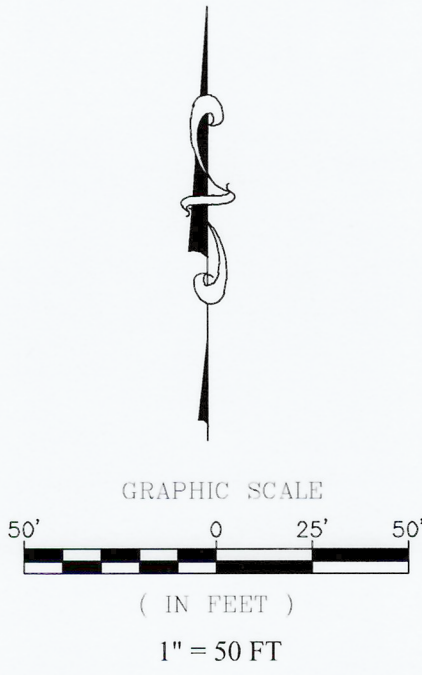


SANITARY SEWER
STRUCTURE & PIPE TABLE

STR.#	TYPE	T.C.	CASTING TYPE	DIA. IN	DIR. IN	INV. IN	DIA. OUT	DIR. OUT	INV. OUT	SLOPE	PIPE	LENGTH	MATERIAL
821	4' MH	875.60	R-1772	8"	NW	866.33	8"	E	866.23	0.47%	821-825 820-821	173'	S.D.R. 35 P.V.C S.D.R. 35 P.V.C
825	4' MH	874.80	R-1772	8"	SE	867.11	8"	SE	867.11	0.45%	821-825	173'	S.D.R. 35 P.V.C
826	4' MH	875.10	R-1772	8"	N	867.07	8"	E	866.87	0.44%	827-828 822-826 826-827	77' 206' 112'	S.D.R. 35 P.V.C S.D.R. 35 P.V.C S.D.R. 35 P.V.C
827	4' MH	874.80	R-1772	8"	S	867.45	8"	N	867.45	0.47%	826-827	112'	S.D.R. 35 P.V.C
828	4' MH	874.90	R-1772	8"	S	867.88	8"	S	867.88	1.05%	827-828	77'	S.D.R. 35 P.V.C
829	4' MH	875.40	R-1772	8"	W	863.33	8"	E	863.26	0.47%	829-830 824-829 829-835	116' 364' 343'	S.D.R. 35 P.V.C S.D.R. 35 P.V.C S.D.R. 35 P.V.C
830	4' MH	875.10	R-1772	8"	N	866.40	8"	E	863.92	0.51%	829-830	116'	S.D.R. 35 P.V.C
831	4' MH	873.70	R-1772	8"	N	866.40	8"	S	866.30	2.01%	831-832 824-831	210' 214'	S.D.R. 35 P.V.C S.D.R. 35 P.V.C
832	4' MH	875.10	R-1772	8"	S	868.10	8"	S	868.10	0.81%	831-832	210'	S.D.R. 35 P.V.C
833	4' MH	875.50	R-1772	8"	S	868.02	8"	S	868.02	0.92%	833-834	197'	S.D.R. 35 P.V.C
834	4' MH	875.40	R-1772	8"	N	864.80	8"	S	865.36	0.47%	835-836	117'	S.D.R. 35 P.V.C
835	4' MH	875.60	R-1772	8"	NE	865.40	8"	S	865.36	0.47%	836-837 835-836	134' 117'	S.D.R. 35 P.V.C S.D.R. 35 P.V.C
836	4' MH	875.20	R-1772	8"	NE	866.03	8"	SW	865.98	0.43%	837-838 836-837	114' 134'	S.D.R. 35 P.V.C S.D.R. 35 P.V.C
837	4' MH	875.10	R-1772	8"	E	866.59	8"	SW	866.49	0.40%	838-839 837-838	241' 114'	S.D.R. 35 P.V.C S.D.R. 35 P.V.C
838	4' MH	875.90	R-1772	8"	W	867.96	8"	W	867.96	0.57%	838-839	241'	S.D.R. 35 P.V.C
839	4' MH	876.20	R-1772	8"	N	860.64	8"	S	860.54	0.80%	840-841 808-840	257' 98'	S.D.R. 35 P.V.C S.D.R. 35 P.V.C
840	4' MH	872.50	R-1772	8"	W	861.83	8"	S	861.68	0.41%	841-842 840-841 841-844	327' 257' 298'	S.D.R. 35 P.V.C S.D.R. 35 P.V.C S.D.R. 35 P.V.C
841	4' MH	874.10	R-1772	8"	W	863.37	8"	E	863.27	0.44%	842-843 841-842	385' 327'	S.D.R. 35 P.V.C S.D.R. 35 P.V.C
842	4' MH	872.80	R-1772	8"	E	863.08	8"	W	862.98	0.40%	844-845 841-844	180' 298'	S.D.R. 35 P.V.C S.D.R. 35 P.V.C
843	4' MH	876.30	R-1772	8"	E	865.04	8"	E	865.04	0.43%	842-843	385'	S.D.R. 35 P.V.C
844	4' MH	872.40	R-1772	8"	E	863.08	8"	W	862.98	0.40%	844-845	180'	S.D.R. 35 P.V.C
845	4' MH	871.30	R-1772	8"	W	863.99	8"	W	863.99	0.51%	844-845	180'	S.D.R. 35 P.V.C

SCALE: 1"=50' HOR.
1"=5' VERT.

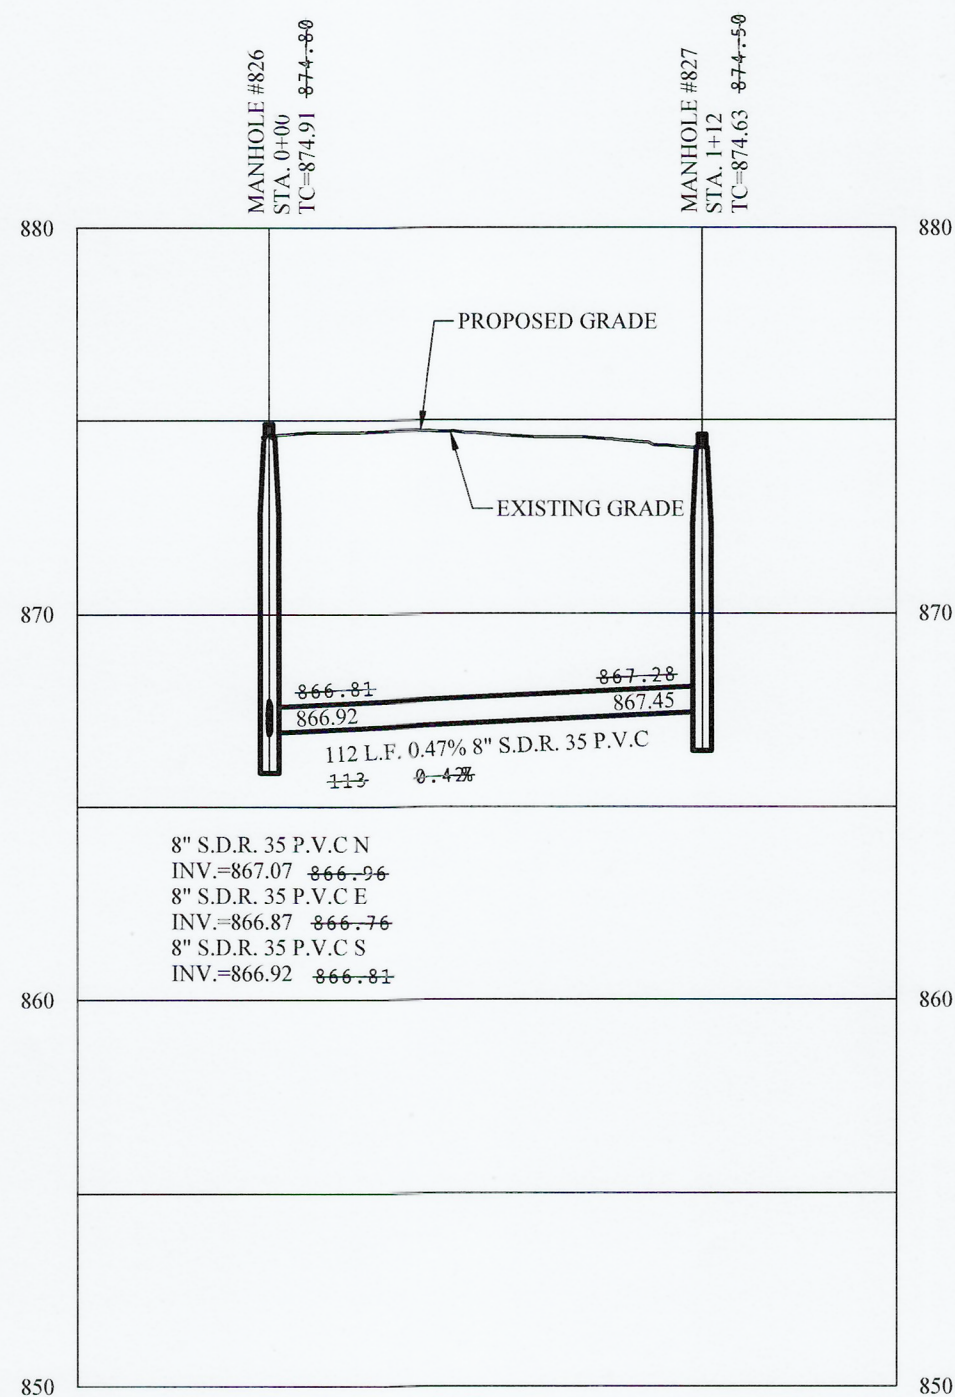

SCALE: 1"=50' HOR.
1"=5' VERT.

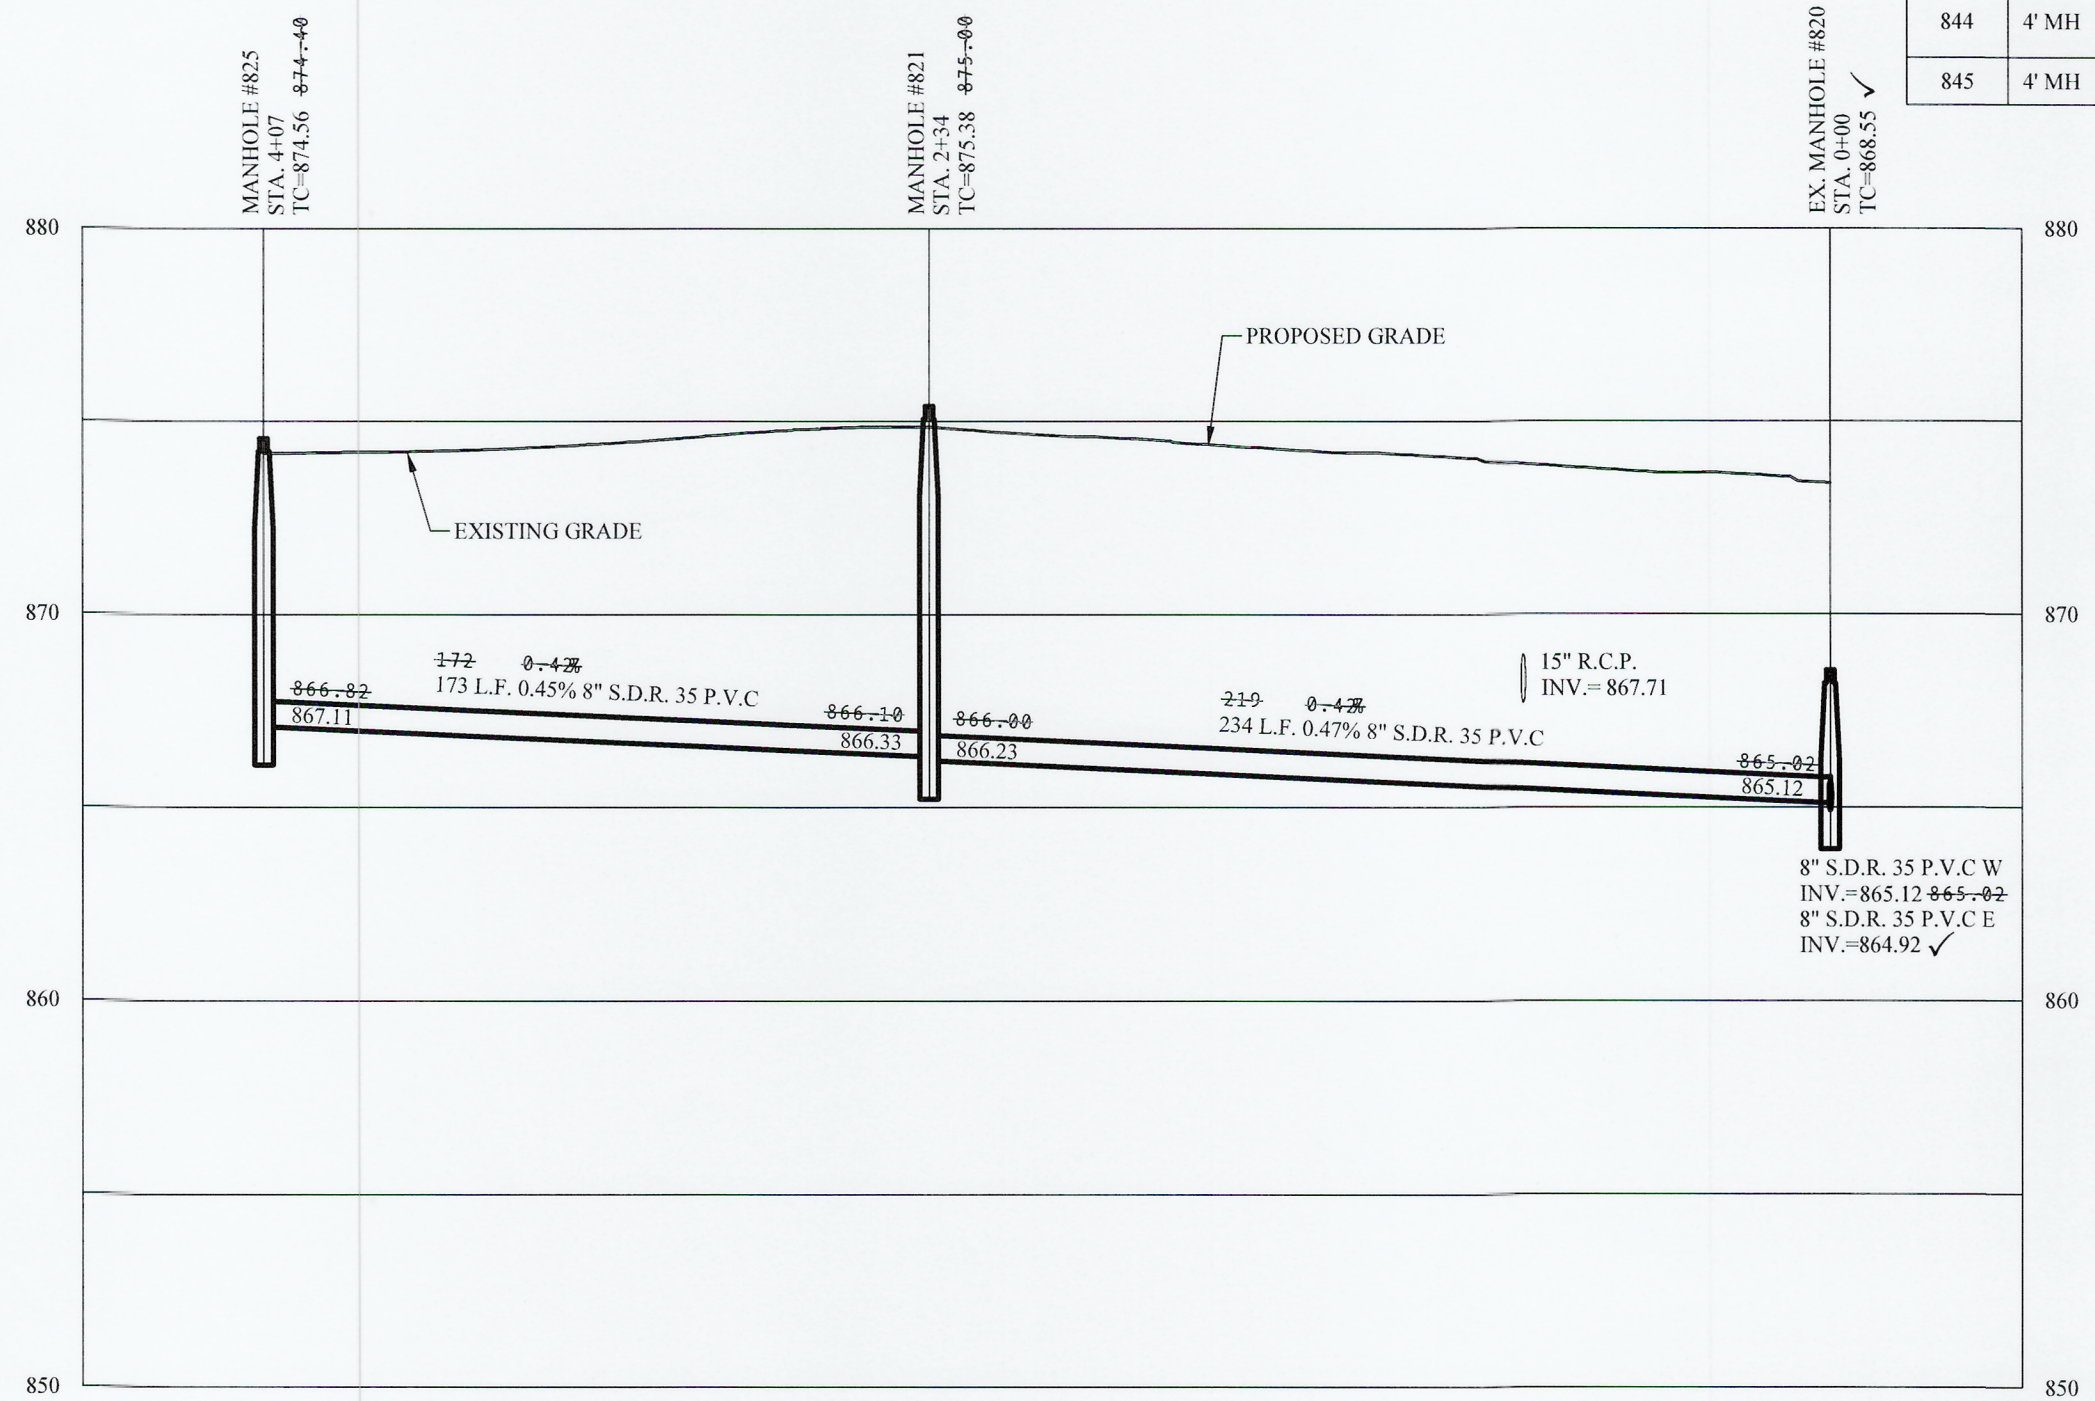

RECORD DRAWING

Dennis D. Olmstead
Professional Land Surveyor
No. 900012
8/1/2022



SANITARY SEWER PLAN & PROFILES

CARRICK GLEN
SECTION 3A & 3B

DRAWN BY
AEC

CHECKED BY
KRG

SHEET NO.

C501

S&A JOB NO.
84449DRH-S3

PENDLETON, FALL CREEK TOWNSHIP
MADISON COUNTY, INDIANA


STOEPPELWERTH

ALWAYS ON

7965 East 10th Street, Fishers, IN 46038-2905
phone: 317.849.5955 fax: 317.849.5942

THIS DRAWING IS NOT INTENDED TO BE
REPRESENTED AS A RETRACEMENT OR
ORIGINAL BOUNDARY SURVEY, A ROUTE
SURVEY OR A SURVEYOR LOCATION
REPORT.

CERTIFIED: 09/08/20
David J. Stoeppele

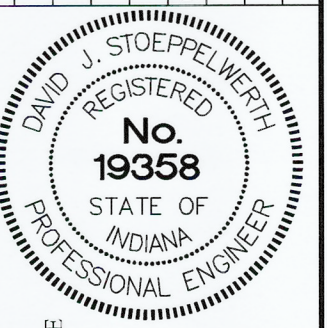

DATE	MARK	REVISIONS
08/01/21		AS-BUILTS
08/01/21		REVISED PER COMMENTS
08/01/21		MIE
08/01/21		GEM
08/01/21		BY