
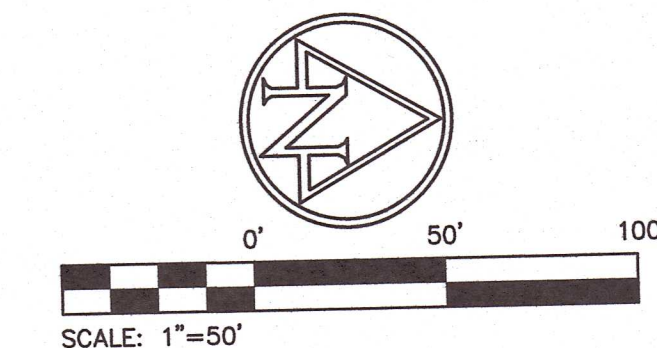


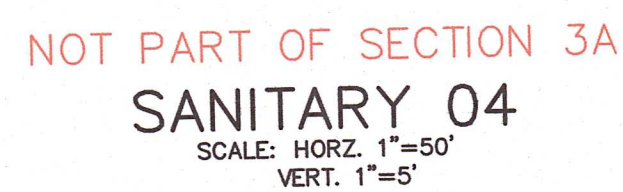

	Beehive Inlet		Pole
	Combination Pole		Post
	Curb Inlet		Sanitary Manhole
	Drainage Manhole		Sign
	Electric Cross Box		Stand Pipe
	Electric Meter Box		Telephone Pedestal
	Fire Hydrant		Transformer
	Fire Plug		Tree
	Flag Pole		Vent
	Gas Marker		Water Marker
	Gas Valve		Water Meter
	Guy Wire		Water Valve
	Lid		Buried Electric Line
	Light Pole		Overhead Electric Line
	Mail Box		Buried Gas Line
	Manhole		Buried Telephone Line
	Pine Tree		Buried Water Line
			Fiber Optic Line

--- RIGHT-OF-WAY (R/W) LINE
 --- BUILDING SETBACK LINE
 --- EASEMENT
 --- WET DETENTION POND NORMAL POOL
 --- LOT LINE
 W WATER MAIN
 (S) --- (S) SANITARY MAIN
 --- SWALE (1.00% MIN SLOPE)
 SD 6" DOUBLE-WALL PERFORATED
 SUBSURFACE UNDERDRAIN
 o SUBSURFACE DRAIN CLEANOUT
 STORM SEWER
 FIRE HYDRANT & WATER VALVE
 DOUBLE & SINGLE WATER METER PIT
 PROPOSED CONTOUR
 SPOT ELEVATION
 PAVEMENT ELEVATION
 FLOW ARROW
 AC ACRE
 B.S.L. BUILDING SETBACK LINE
 B/B BACK TO BACK
 C.A. COMMON AREA
 D.E. DRAINAGE EASEMENT
 FL FLOWLINE
 HP HIGH POINT
 INV INVERT ELEVATION
 LP LOW POINT
 ME MATCH EXISTING
 MFPE MINIMUM FINISHED FLOOR ELEVATION
 MPFG MINIMUM FLOOD PROTECTION GRADE
 PAD PAD GRADE
 PC POINT OF CURVATURE
 PT POINT OF TANGENCY
 PVC POLYVINYL CHLORIDE PIPE
 PV POINT OF VERTICAL INTERSECTION
 RCP REINFORCED CONCRETE PIPE
 R/W RIGHT-OF-WAY
 SF SQUARE FEET
 TR TOP OF RIM ELEVATION
 DRAINAGE UTILITY EASEMENT
 D.&U.E. DRAINAGE, UTILITY & SANITARY EASEMENT
 STREET LIGHT
 SIGN
 ADA SIDEWALK RAMP

1. THE GRANULAR BACKFILL AREAS SHOWN IN PLAN VIEW ARE AN ESTIMATE PROVIDED BY THE ENGINEER. EXACT LIMITS OF GRANULAR BACKFILL ARE TO BE DETERMINED IN THE FIELD BY THE CONTRACTOR BASED ON TRENCH WIDTH AND AS DIRECTED BY THE AUTHORITY HAVING JURISDICTION.



PVC GRAVITY SEWER PIPE AND FITTINGS MUST, AT A MINIMUM, BE INSTALLED IN ACCORDANCE WITH THE DIRECTIONS CONTAINED IN ASTM D 2321.

1. CONTRACTOR SHALL PROTECT AND NOT DESTROY THE PROPERTY CORNER MONUMENTS DURING CONSTRUCTION.
2. CONTRACTOR TO VERIFY LOCATION, SIZE AND DEPTH OF EXISTING UTILITIES PRIOR TO COMMENCING ANY CONSTRUCTION. CONTACT ENGINEER IF VARIATION EXISTS
3. SEE SHEET C002 GENERAL NOTES FOR MORE INFORMATION.

!! CAUTION !!

THE LOCATIONS OF ALL EXISTING UNDERGROUND
THIS PLAN ARE BASED UPON ABOVE GROUND EVIDENCE
NOT LIMITED TO, MANHOLES, INLETS, VALVES, AND MAN
GROUND BY OTHERS) AND ARE SPECULATIVE IN NATURE.
ALSO BE OTHER EXISTING UNDERGROUND UTILITIES
IS NO ABOVE GROUND EVIDENCE OR FOR WHICH
EVIDENCE WAS OBSERVED. THE EXACT LOCATIONS OF
UNDERGROUND UTILITIES SHALL BE VERIFIED BY
PRIOR TO ANY AND ALL CONSTRUCTION.

CALL TOLL FREE
"811" OR 1-800-382-5555
- INDIANA UNDERGROUND

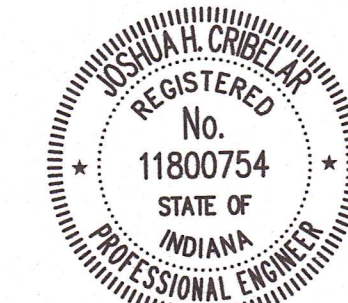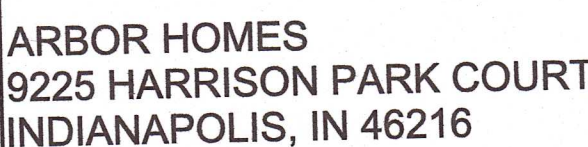

Joshua H. Cribbe
CERTIFIED BY

DATE:
08/01/2022
PROJECT PHASE:
CONSTRUCTION DOCUMENTS

Project Number	2019.02070
----------------	------------

C414