

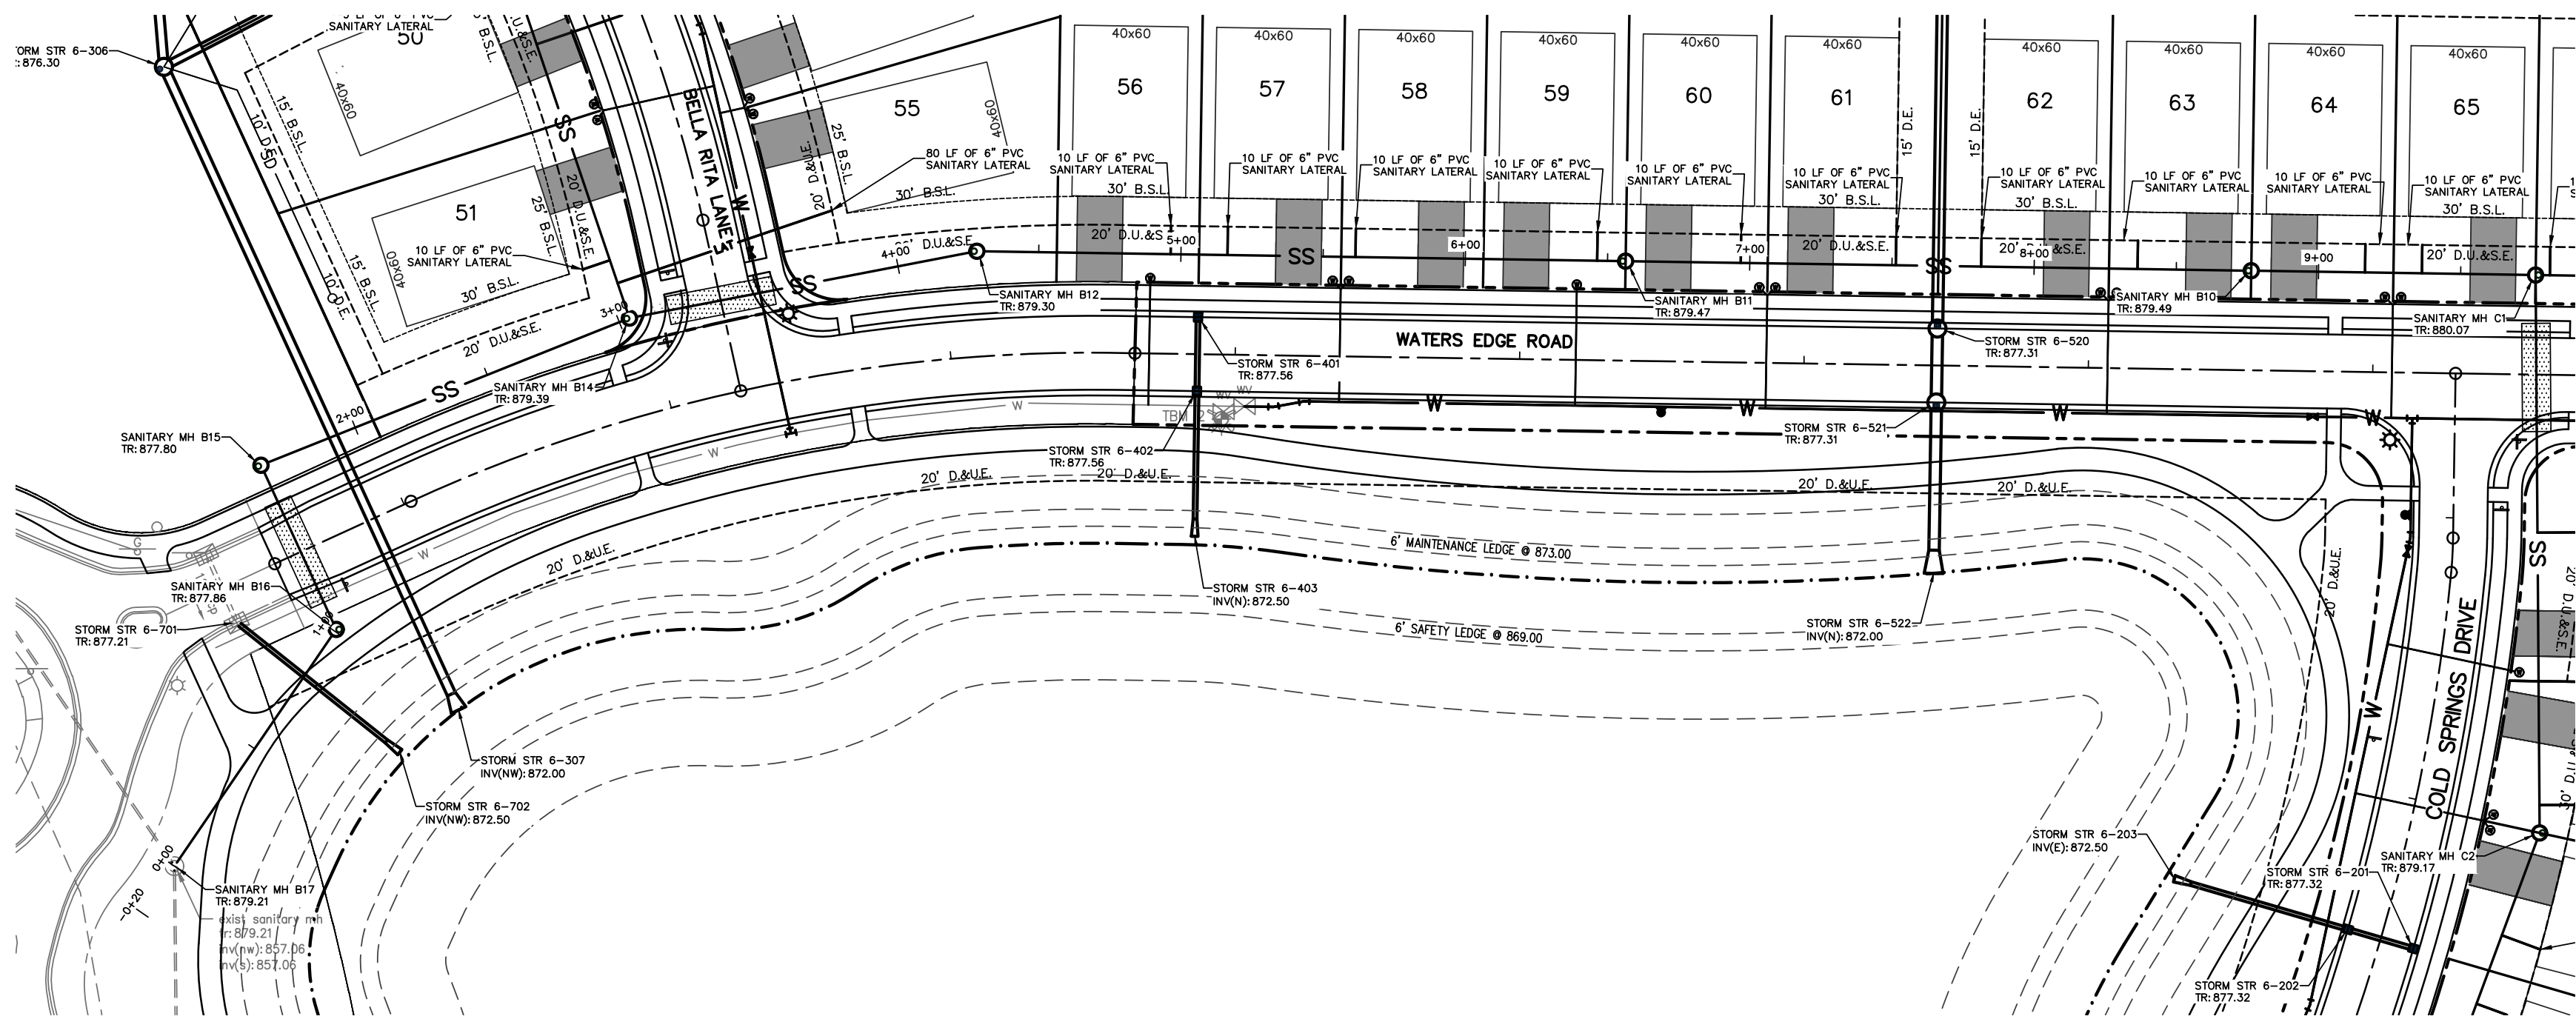


PLOT DATE: 12/20/2021 10:19 AM
PLOT SCALE: 1"=50'
DRAWING FILE: \\msps\p\projects\2019\020702.DWG
DRAWING: Civil\Construction Documents\2. Construction Documents\Section 2 CSD0218.020702.CE C410 SANPP.DWG
EDIT DATE: 12/20/2021
EDIT BY: JVSALDI

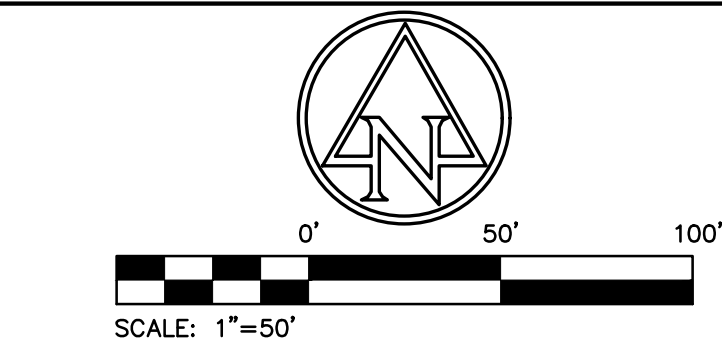

SANITARY 2
SCALE: HORZ. 1"=50'
VERT. 1"=5'

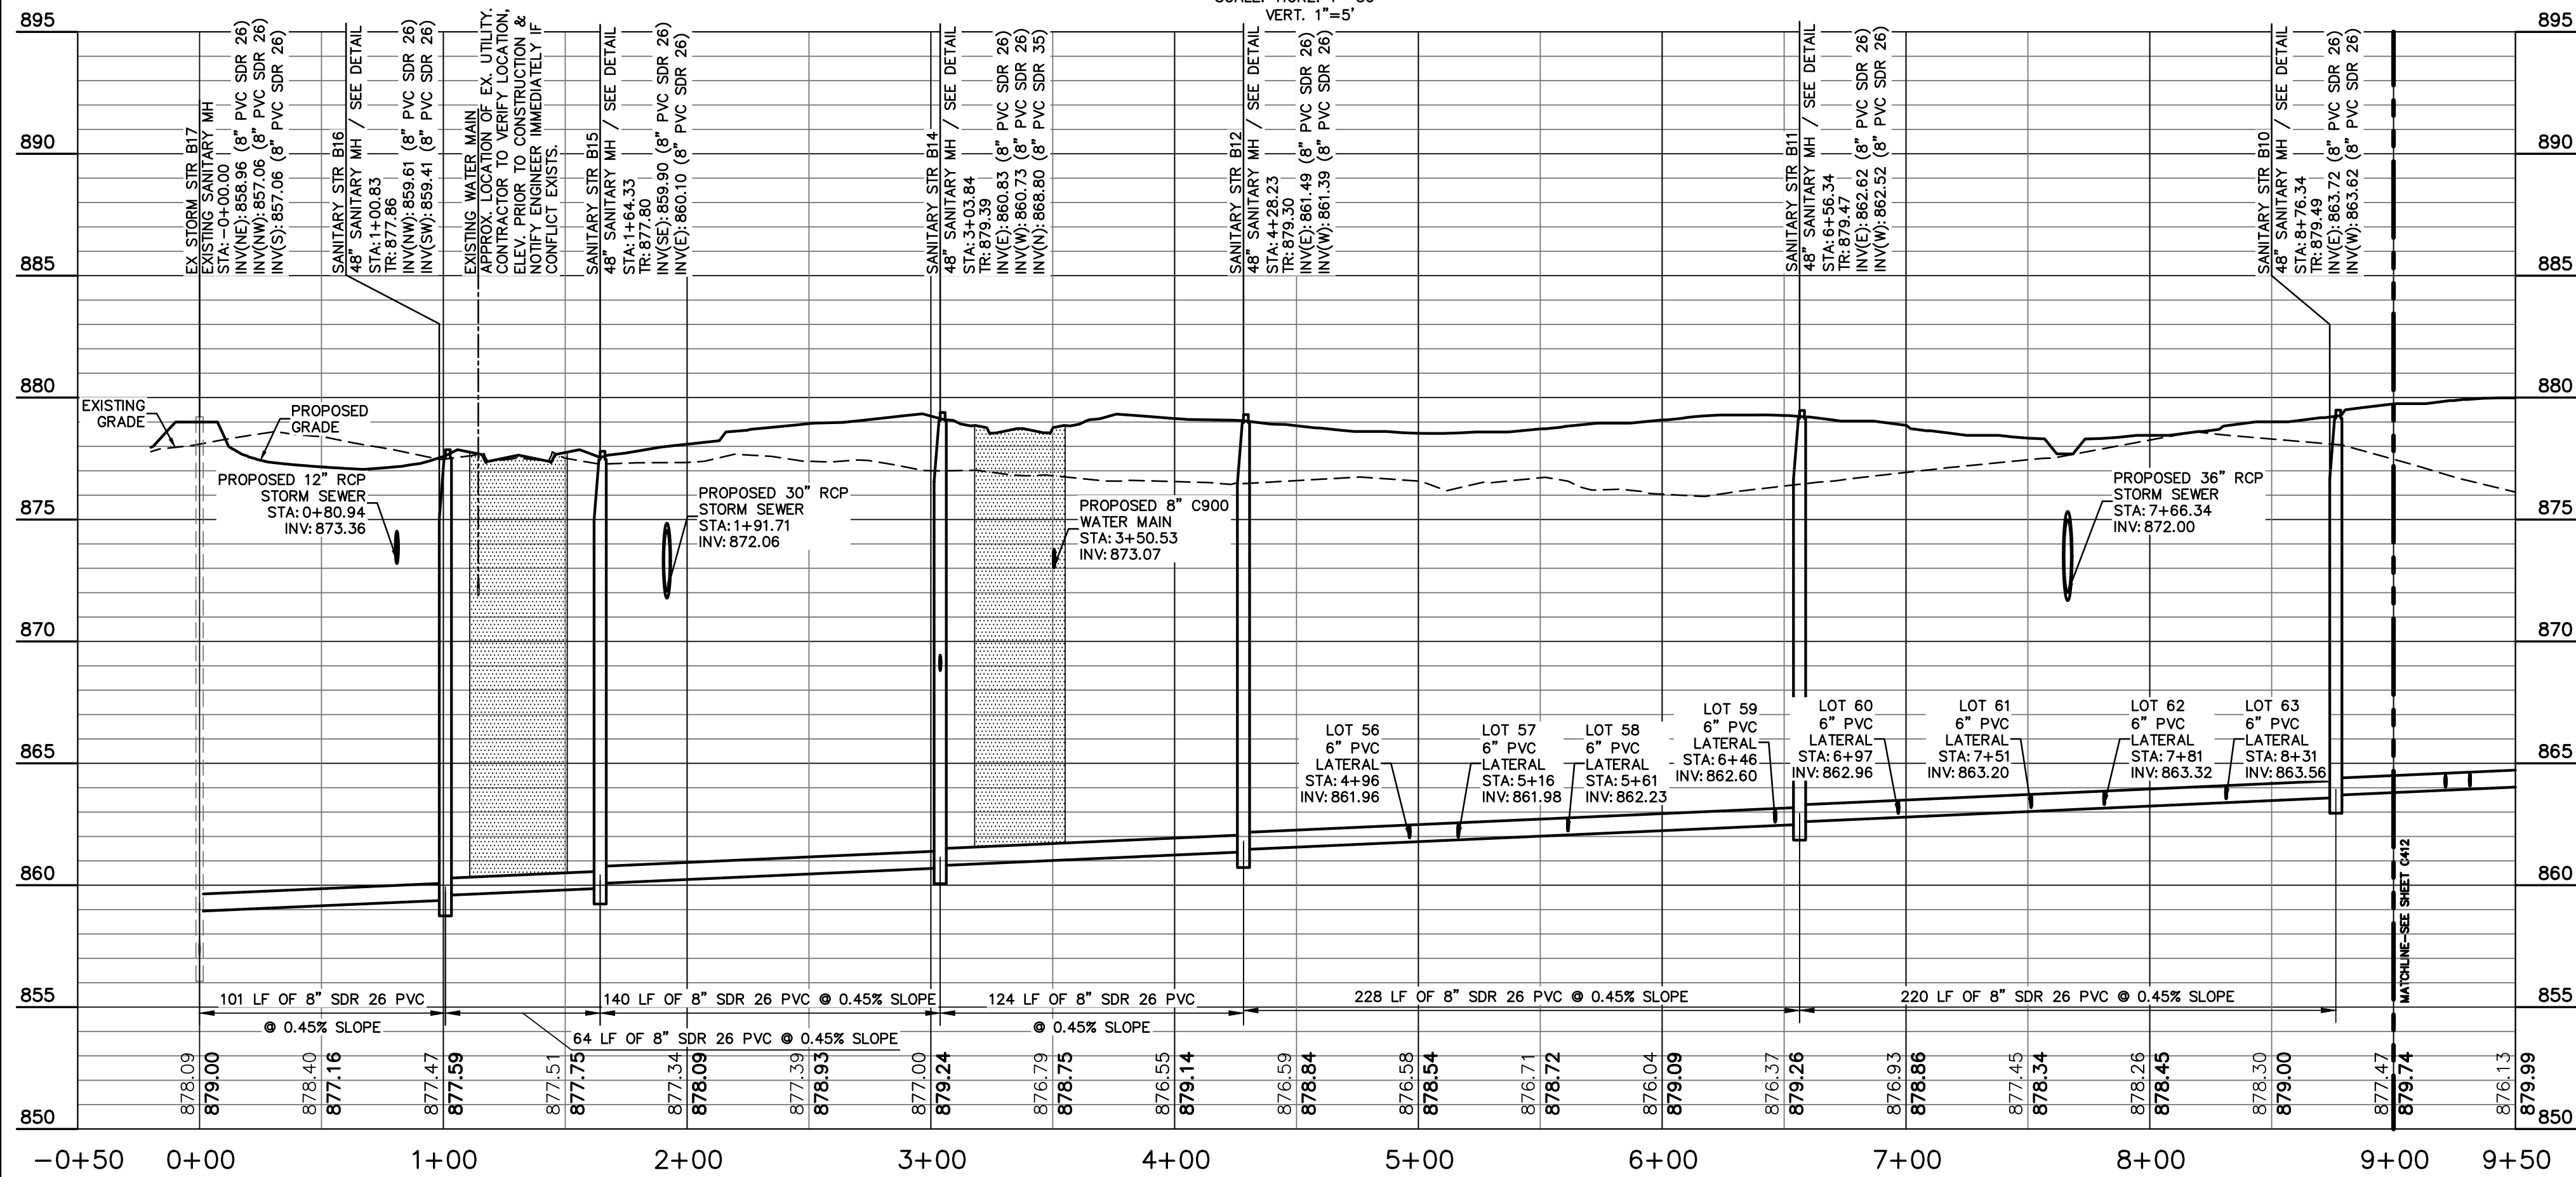

EXISTING LEGEND

- | | | | |
|--|--------------------|--|------------------------|
| | Beehive Inlet | | Pole |
| | Combination Pole | | Post |
| | Curb Inlet | | Sanitary Manhole |
| | Drainage Inlet | | Sign |
| | Drainage Manhole | | Stand Pipe |
| | Electric Cross Box | | Telephone Pedestal |
| | Electric Meter Box | | Transformer |
| | Fire Hydrant | | Tree |
| | Fire Plug | | Vent |
| | Flag Pole | | Water Marker |
| | Gas Marker | | Water Meter |
| | Gas Valve | | Water Valve |
| | Guy Wire | | Buried Electric Line |
| | Lid | | Overhead Electric Line |
| | Light Pole | | Buried Gas Line |
| | Mail Box | | Buried Telephone Line |
| | Manhole | | Buried Water Line |
| | Pine Tree | | Fiber Optic Line |

PROPOSED LEGEND

- | | |
|--|-------------------------------------|
| | RIGHT-OF-WAY (R/W) LINE |
| | BUILDING SETBACK LINE |
| | EASEMENT |
| | WET DETENTION POND NORMAL POOL |
| | LOT LINE |
| | WATER MAIN |
| | SANITARY MAIN |
| | SWALE (1.00% MIN SLOPE) |
| | |
| | STORM SEWER |
| | FIRE HYDRANT & WATER VALVE |
| | DOUBLE & SINGLE WATER METER PIT |
| | PROPOSED CONTOUR |
| | SPOT ELEVATION |
| | PAVEMENT ELEVATION |
| | FLOW ARROW |
| | ACRE |
| | BUILDING SETBACK LINE |
| | BACK TO BACK |
| | COMMON AREA |
| | DRAINAGE EASEMENT |
| | FLOWLINE |
| | HIGH POINT |
| | INVERT ELEVATION |
| | MATCH EXISTING |
| | MINIMUM FINISHED FLOOR ELEVATION |
| | MINIMUM FLOOD PROTECTION GRADE |
| | PAD GRADE |
| | POINT OF CURVATURE |
| | POINT OF TANGENCY |
| | POLYVINYL CHLORIDE PIPE |
| | POINT OF VERTICAL INTERSECTION |
| | REINFORCED CONCRETE PIPE |
| | RIGHT-OF-WAY |
| | SQUARE FEET |
| | SANITARY SEWER EASEMENT |
| | TOP OF RIM ELEVATION |
| | UTILITY & DRAINAGE EASEMENT |
| | UTILITY, DRAINAGE, & SANITARY ESMT. |
| | STREET LIGHT |
| | SIGN |
| | ADA SIDEWALK RAMP |

SANITARY SEWER NOTES:

- THE GRANULAR BACKFILL AREAS SHOWN IN PLAN VIEW ARE AN ESTIMATE PROVIDED BY THE ENGINEER. EXACT LIMITS OF GRANULAR BACKFILL ARE TO BE DETERMINED IN THE FIELD BY THE CONTRACTOR BASED ON TRENCH WIDTH AND AS DIRECTED BY THE AUTHORITY HAVING JURISDICTION.

GRANULAR BACKFILL
REQUIRED

PVC GRAVITY SEWER PIPE AND FITTINGS MUST, AT A MINIMUM, BE INSTALLED IN ACCORDANCE WITH THE DIRECTIONS CONTAINED IN ASTM D 2321.

GENERAL NOTES:

- CONTRACTOR SHALL PROTECT AND NOT DESTROY THE PROPERTY CORNER MONUMENTS DURING CONSTRUCTION.
- CONTRACTOR TO VERIFY LOCATION, SIZE AND DEPTH OF EXISTING UTILITIES PRIOR TO COMMENCING ANY CONSTRUCTION. CONTACT ENGINEER IF VARIATION EXISTS.
- SEE SHEET C002 GENERAL NOTES FOR MORE INFORMATION.

!! CAUTION !!

THE LOCATIONS OF ALL EXISTING UNDERGROUND UTILITIES SHOWN ON THIS PLAN ARE BASED UPON ABOVE GROUND EVIDENCE (including, but not limited to, manholes, inlets, valves, and marks made upon the ground by others) AND ARE SPECULATIVE IN NATURE. THERE MAY ALSO BE OTHER EXISTING UNDERGROUND UTILITIES FOR WHICH THERE IS NO ABOVE GROUND EVIDENCE OR FOR WHICH NO ABOVE GROUND EVIDENCE WAS OBSERVED. THE EXACT LOCATIONS OF SAID EXISTING UNDERGROUND UTILITIES SHALL BE VERIFIED BY THE CONTRACTOR PRIOR TO ANY AND ALL CONSTRUCTION.

CALL TOLL FREE
"811" OR 1-800-382-5544
- INDIANA UNDERGROUND -





ARBOR HOMES
9225 HARRISON PARK COURT
INDIANAPOLIS, IN 46216



9025 River Road, Suite 200 | Indianapolis, Indiana 46240
TEL 317.547.5580 | FAX 317.543.0270
www.structurepoint.com

COLD SPRINGS AT
HUNTZINGER FARM
SECTION 2

WATERS EDGE ROAD
PENDLETON, IN

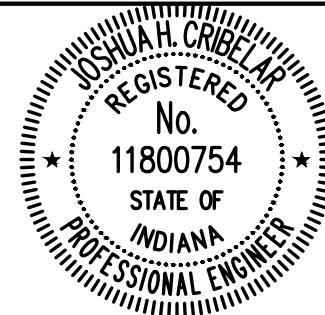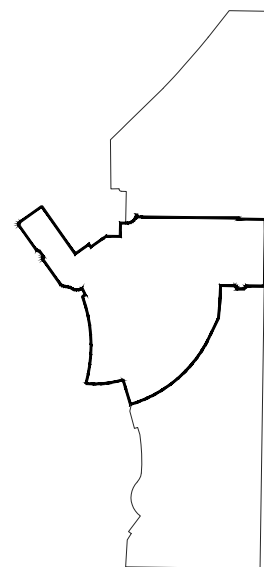

Joshua H. Crisler
CERTIFIED BY

ISSUANCE INDEX

DATE:
01/03/2022
PROJECT PHASE:
CONSTRUCTION DOCUMENTS

REVISION SCHEDULE

NO.	DESCRIPTION	DATE

Project Number 2019.02070

SANITARY SEWER
PLAN & PROFILES

C411