



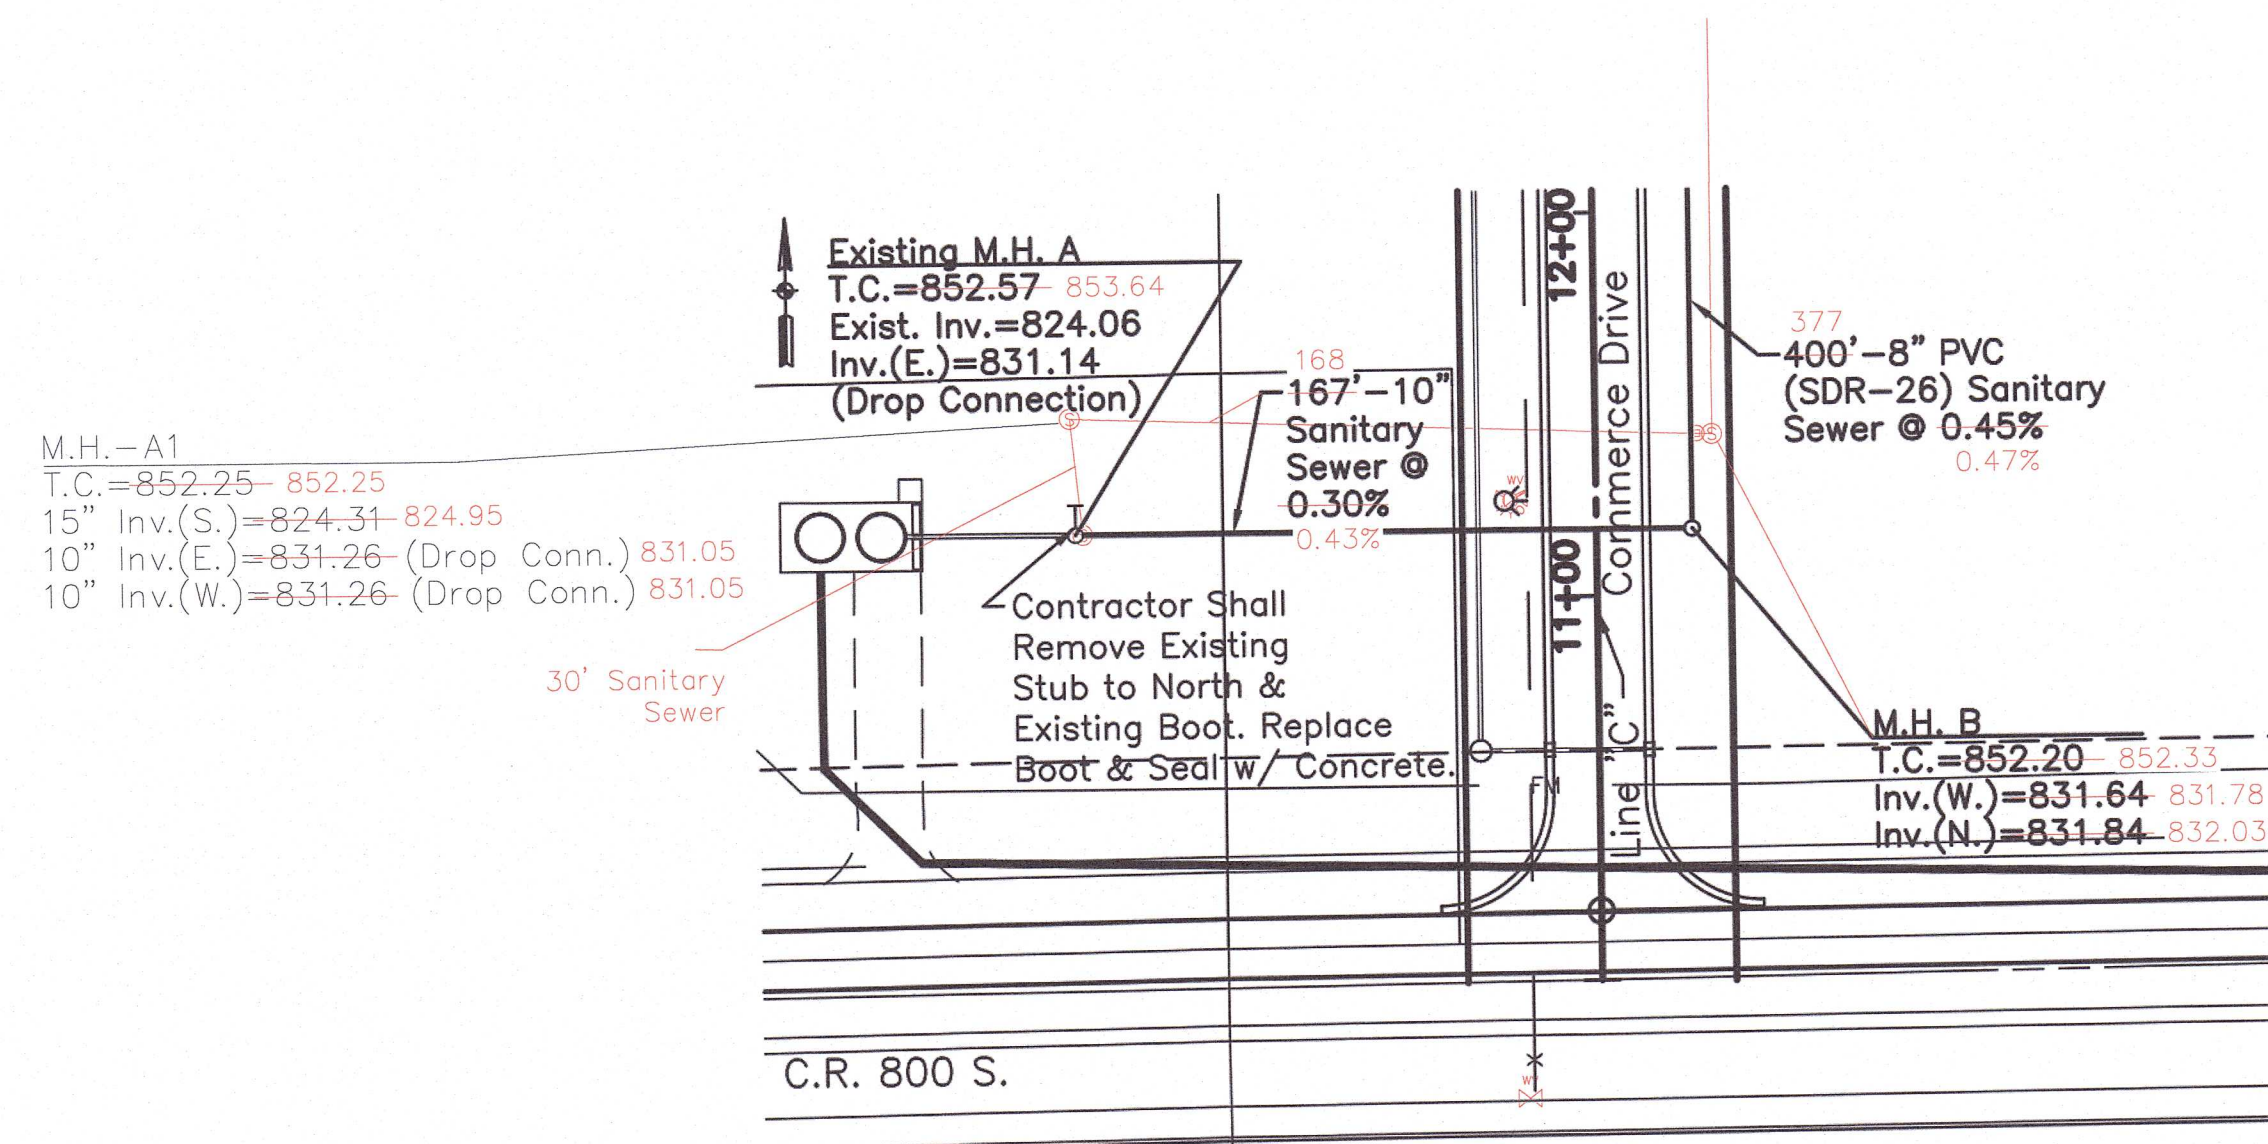

N.A = INFORMATION WAS NOT ACCESSIBLE

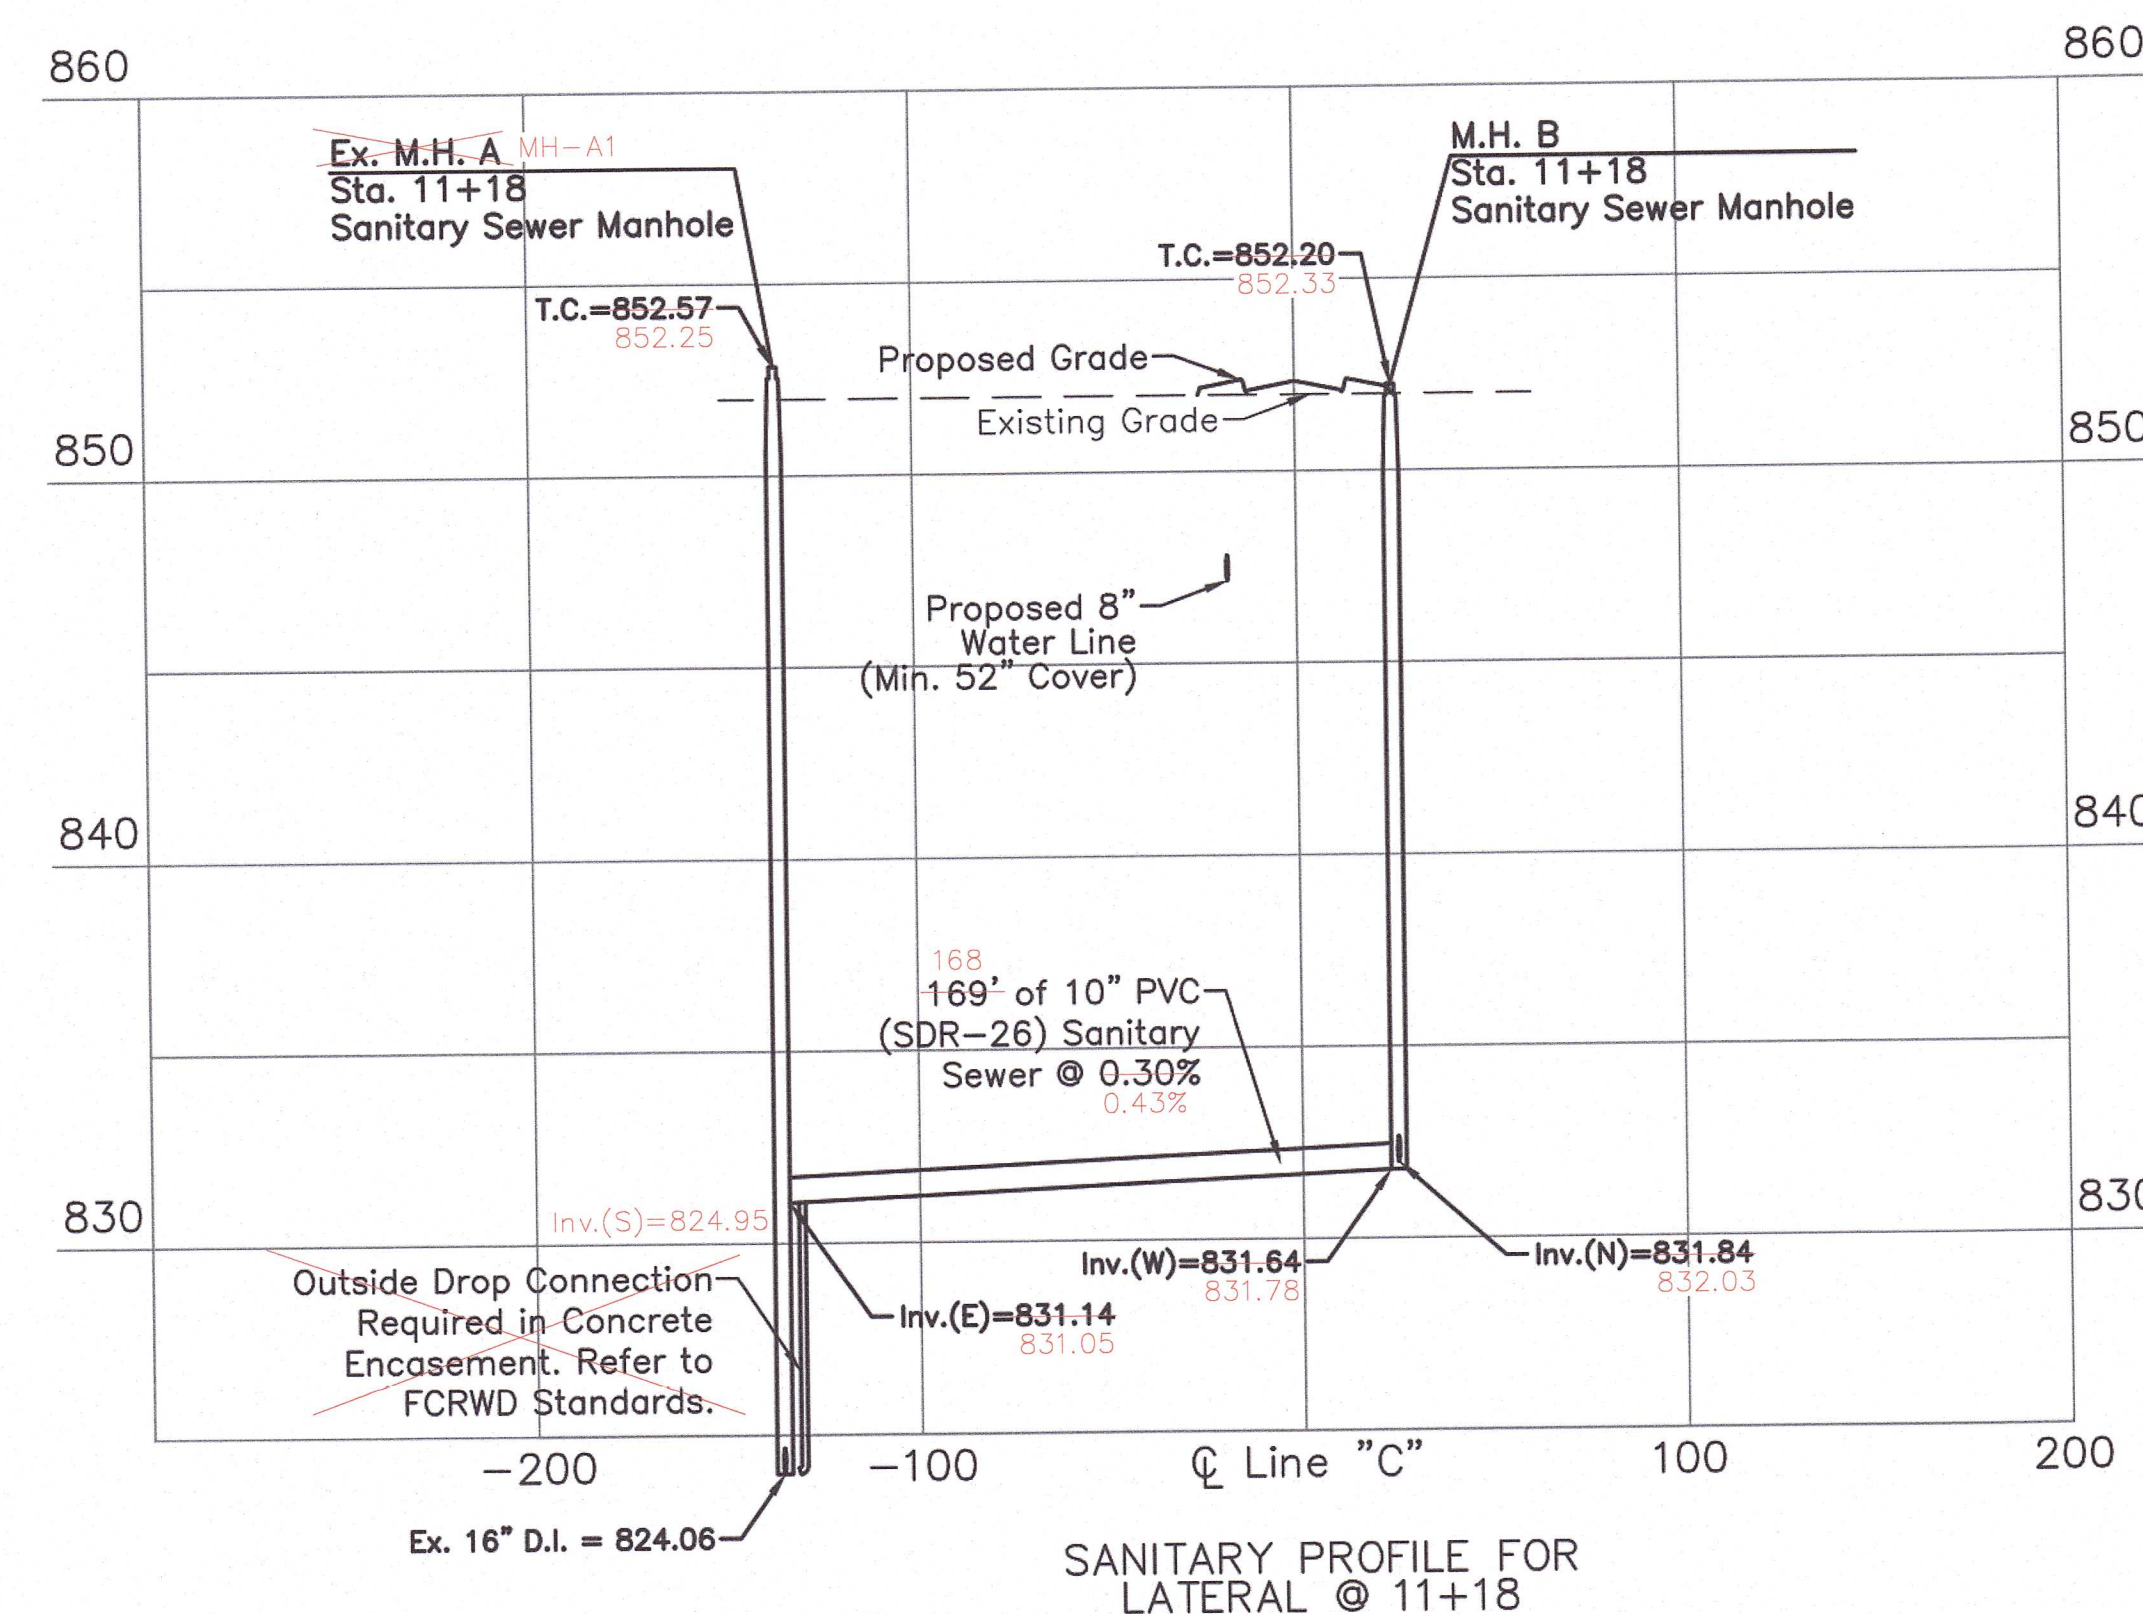

SANITARY SEWER AS-BUILT STATEMENT

As-Built information for sanitary sewer rims are based upon above ground evidence of the existing sanitary sewer system. The strike through data shown on the Sanitary Sewers are the proposed elevations for all the structures to be placed. Said information has been replaced by the as-built information per elevations collected in the field on August 14, 2017.

Jeffrey A. Douglass
Jeffrey A. Douglass
Registered Land Surveyor No. 29700000



CONSULTANT:


REVISIONS:

DATE	DESCRIPTION	BY

APPROVED BY:



THIS DRAWING AND THE IDEAS, DESIGNS AND CONCEPTS CONTAINED HEREIN ARE THE EXCLUSIVE INTELLECTUAL PROPERTY OF TRIAD ASSOCIATES, INC., AND ARE NOT TO BE USED OR REPRODUCED, IN WHOLE OR IN PART, WITHOUT THE WRITTEN CONSENT OF TRIAD ASSOCIATES, INC.

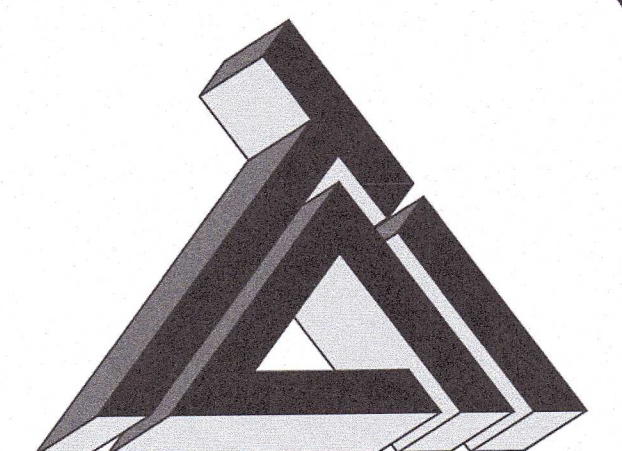

TRIAD ASSOCIATES INC.
5835 LAWTON LOOP EAST DRIVE
INDIANAPOLIS, INDIANA 46216
PHONE: 317-377-5230 FAX: 317-377-5241

DESIGNED FOR:

D.B. MANN DEVELOPMENT INC.
5035 EAST 76TH STREET COURT
INDIANAPOLIS, INDIANA 46250

SHEET TITLE:

SANITARY SEWER PROFILES

JOB NUMBER: 201450A

SCALE: 1" = 50'

PLOT SCALE: 1" = 1'

DRAWN BY: DWB

DESIGNED BY: Jonathan Moen, P.E.

DRAWING NAME: 201450A-Sanitary Profiles

CHECKED BY:

PLOT DATE: 9/19/16

DATE:

SHEET No.

4