

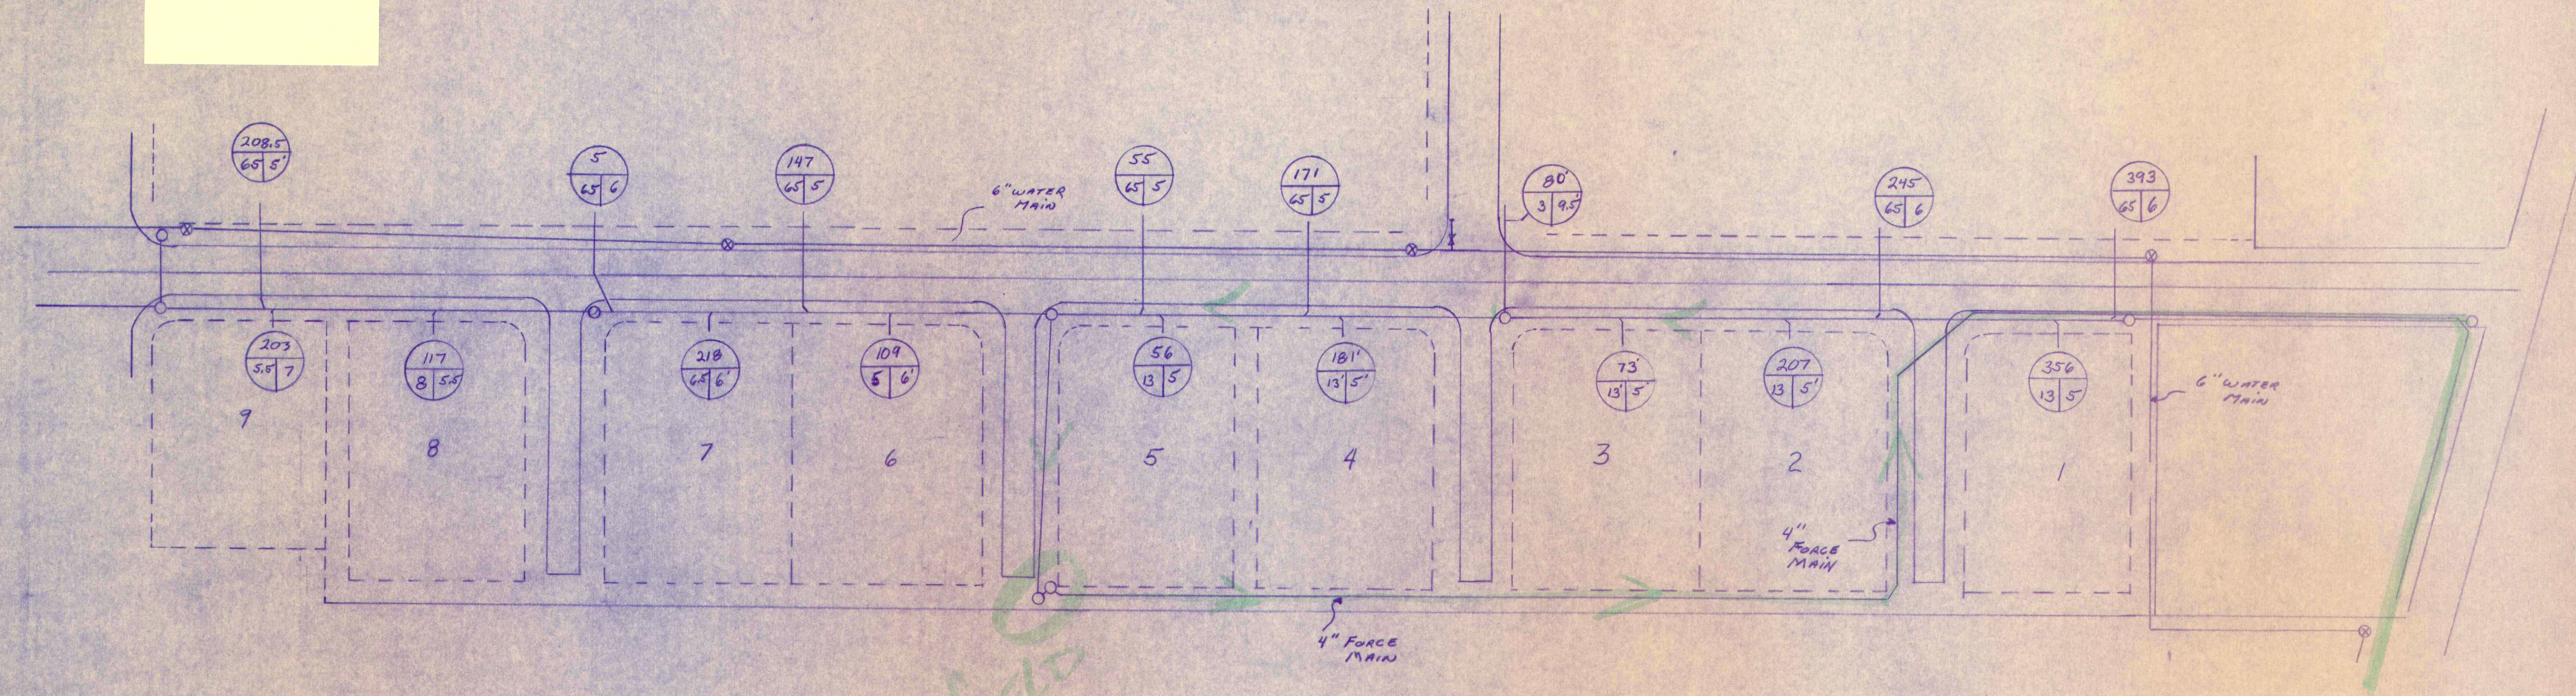


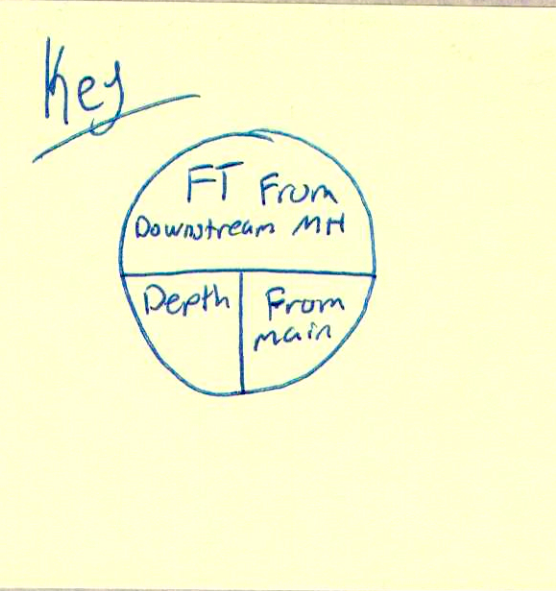

Deerfield LLC

ON-SITE UTILITIES

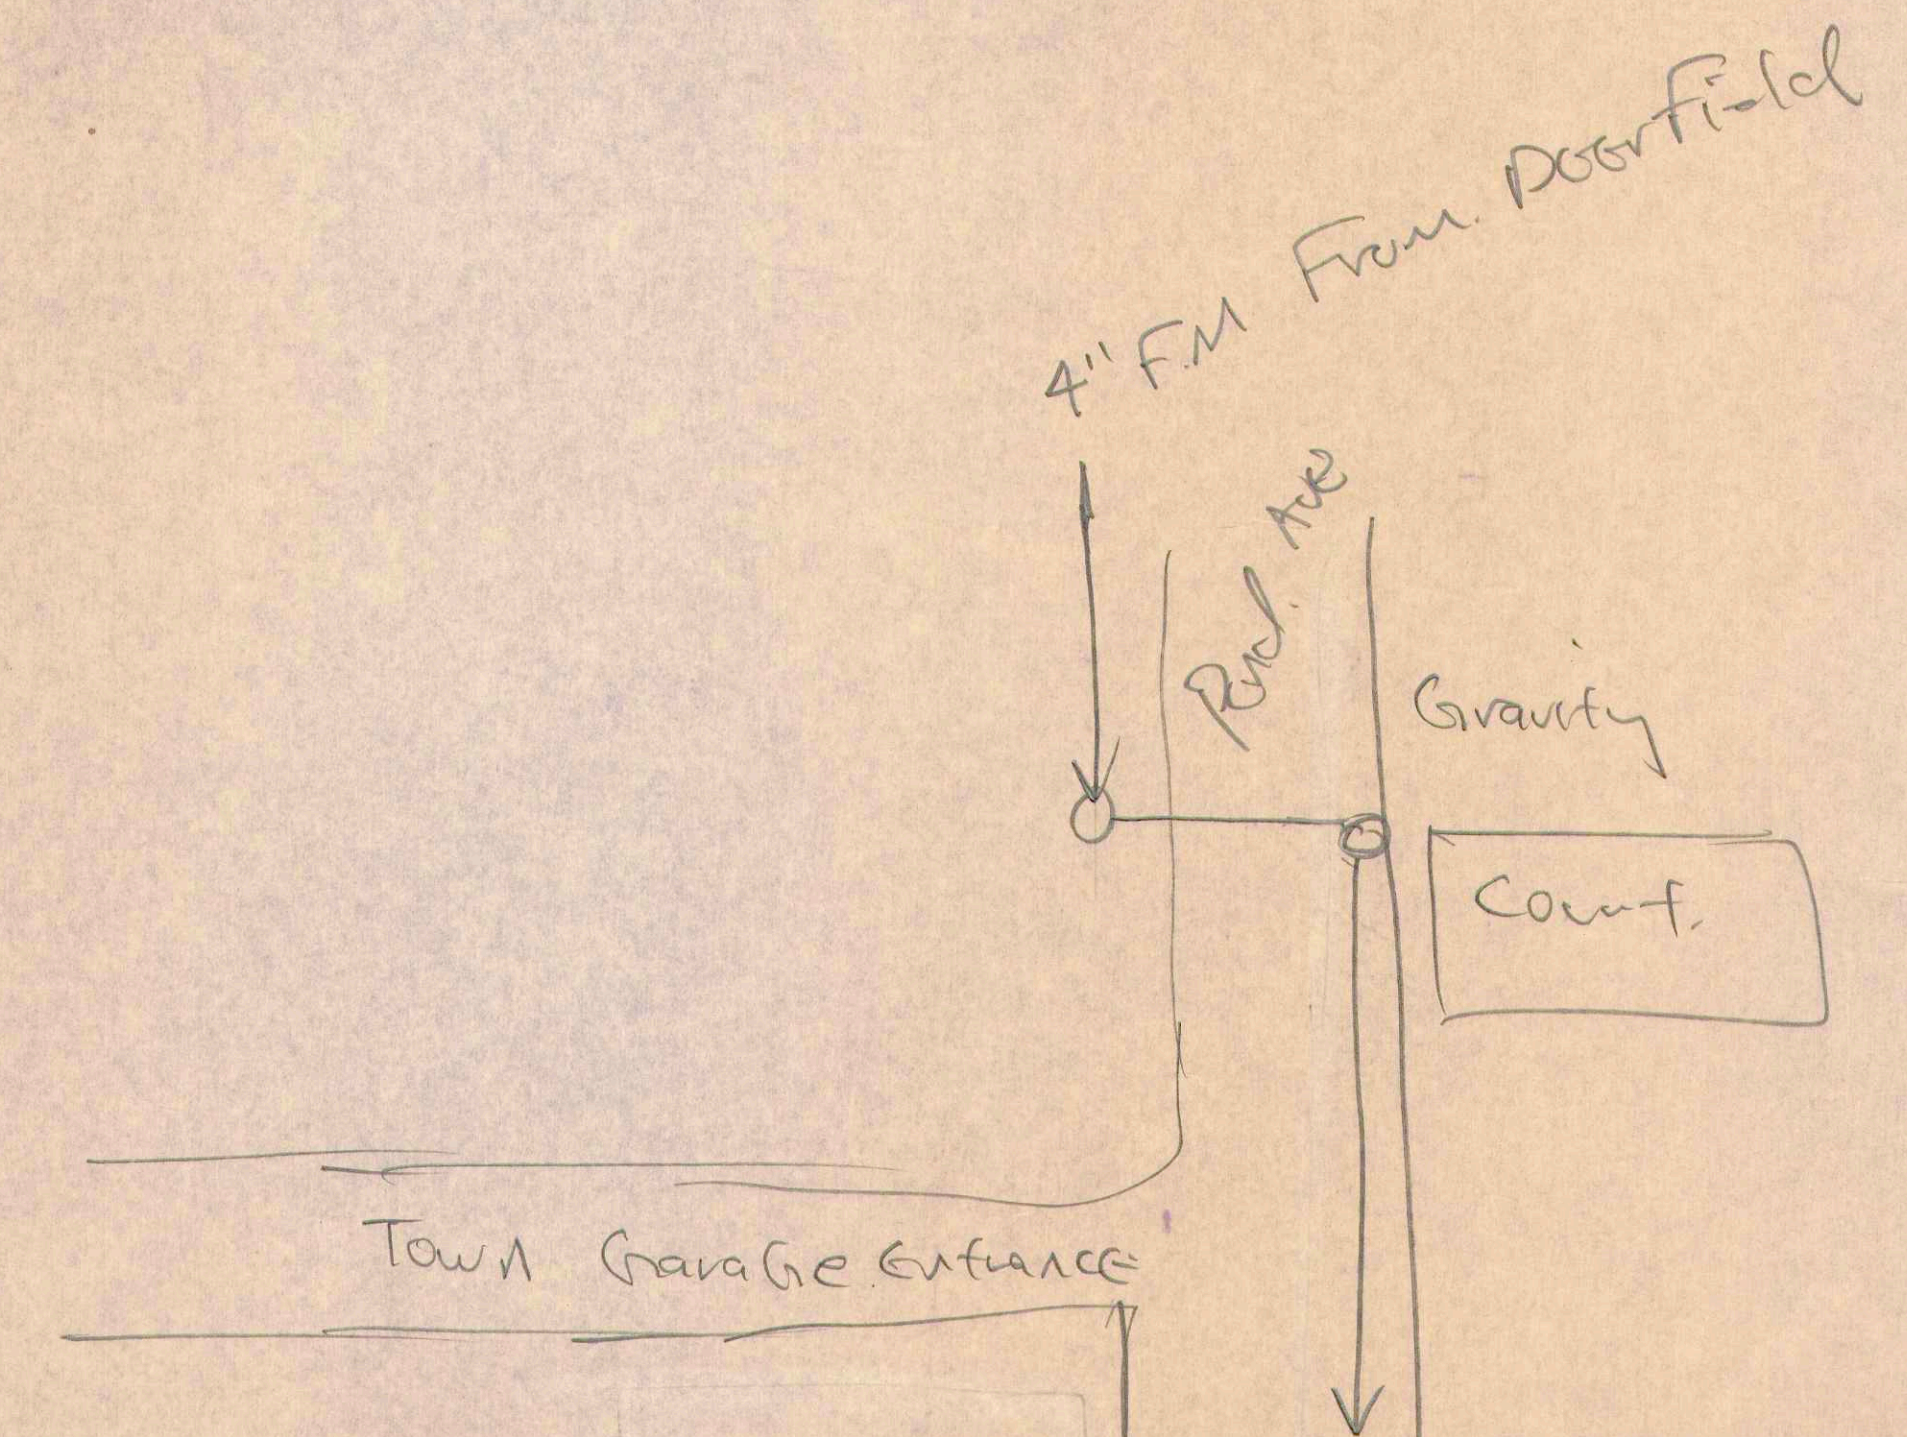

TOLERANCES		REVISIONS			DEERFIELD CONDOMINIUM		
EXCEPT AS NOTED	NO.	DATE	BY				
DECIMAL	1						
FRACTIONAL	2						
ANGULAR	3						
	4						
	5						

DRAWN BY: As Built
 SCALE: 1"=50'
 DATE: 7/15/01
 CHECKED: DATE
 TRACED: APP'D