

108,500



960

8.5

1300

101+00

OFF-SITE UTILITIES

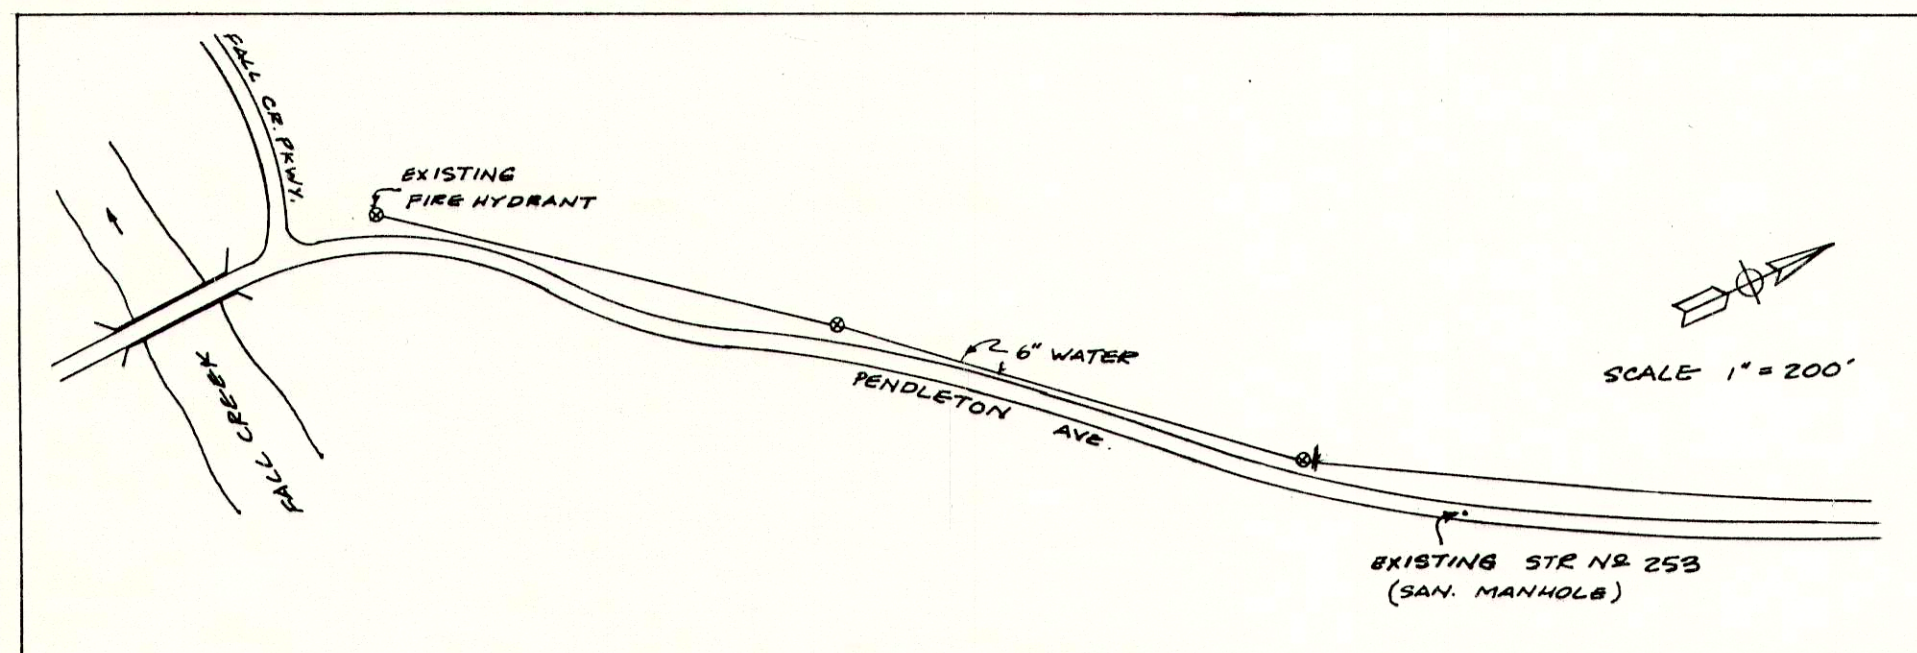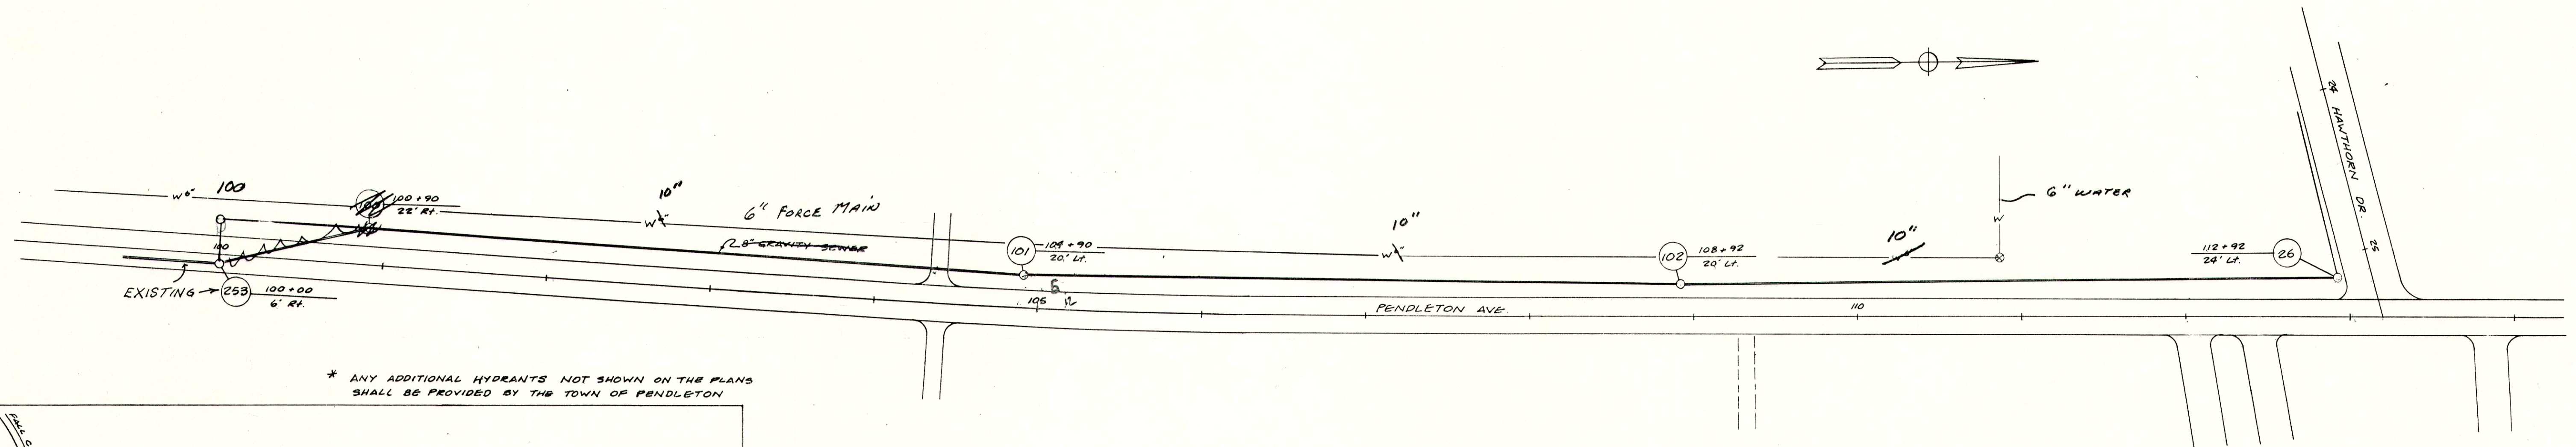

NOTES:

LENGTHS OF PIPE INDICATED ARE FROM CENTER TO CENTER OF STRUCTURES AND ARE NOT ACTUAL PIPE LENGTHS.

⊗ FIRE HYDRANT


SCALE

PLAN: 1" = 50'

PROFILE

VERT: 1" = 5'

HORIZ: 1" = 50'

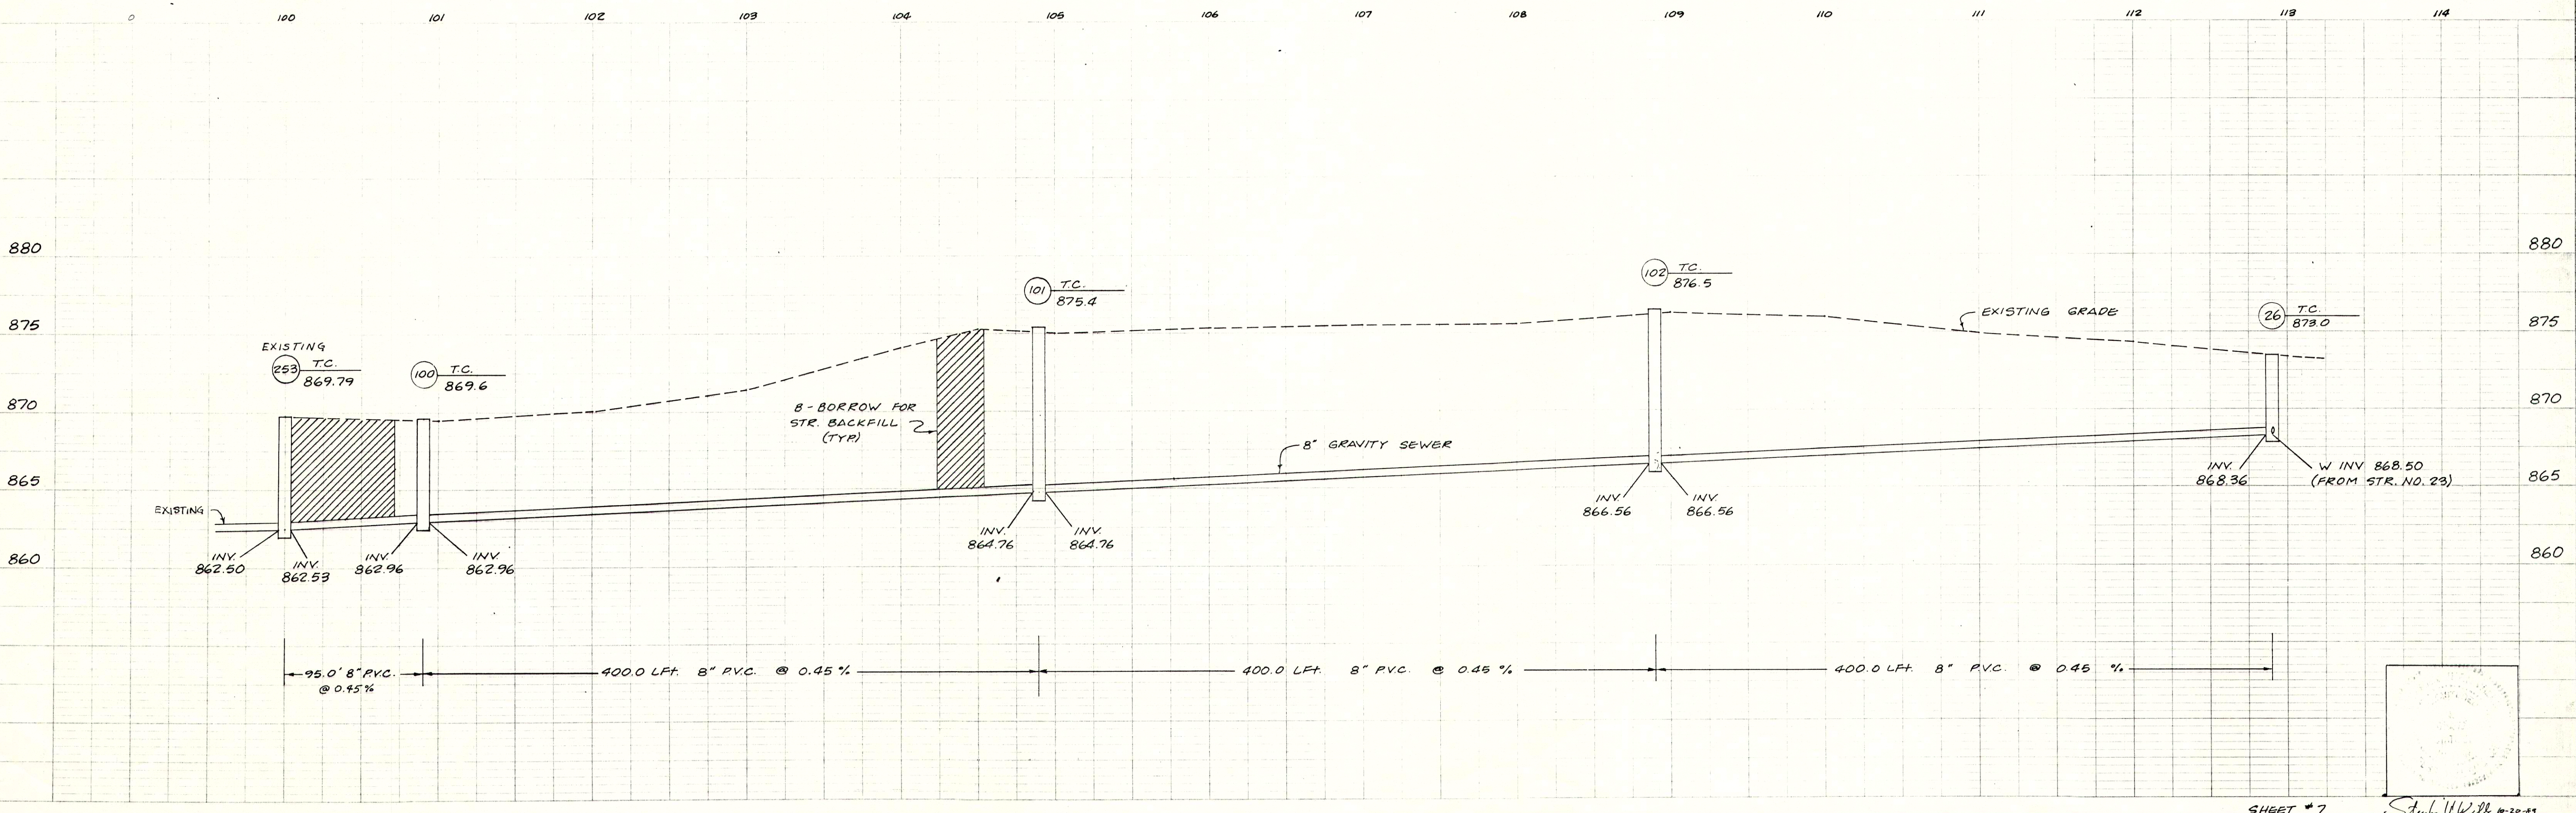

SHEET #7

