
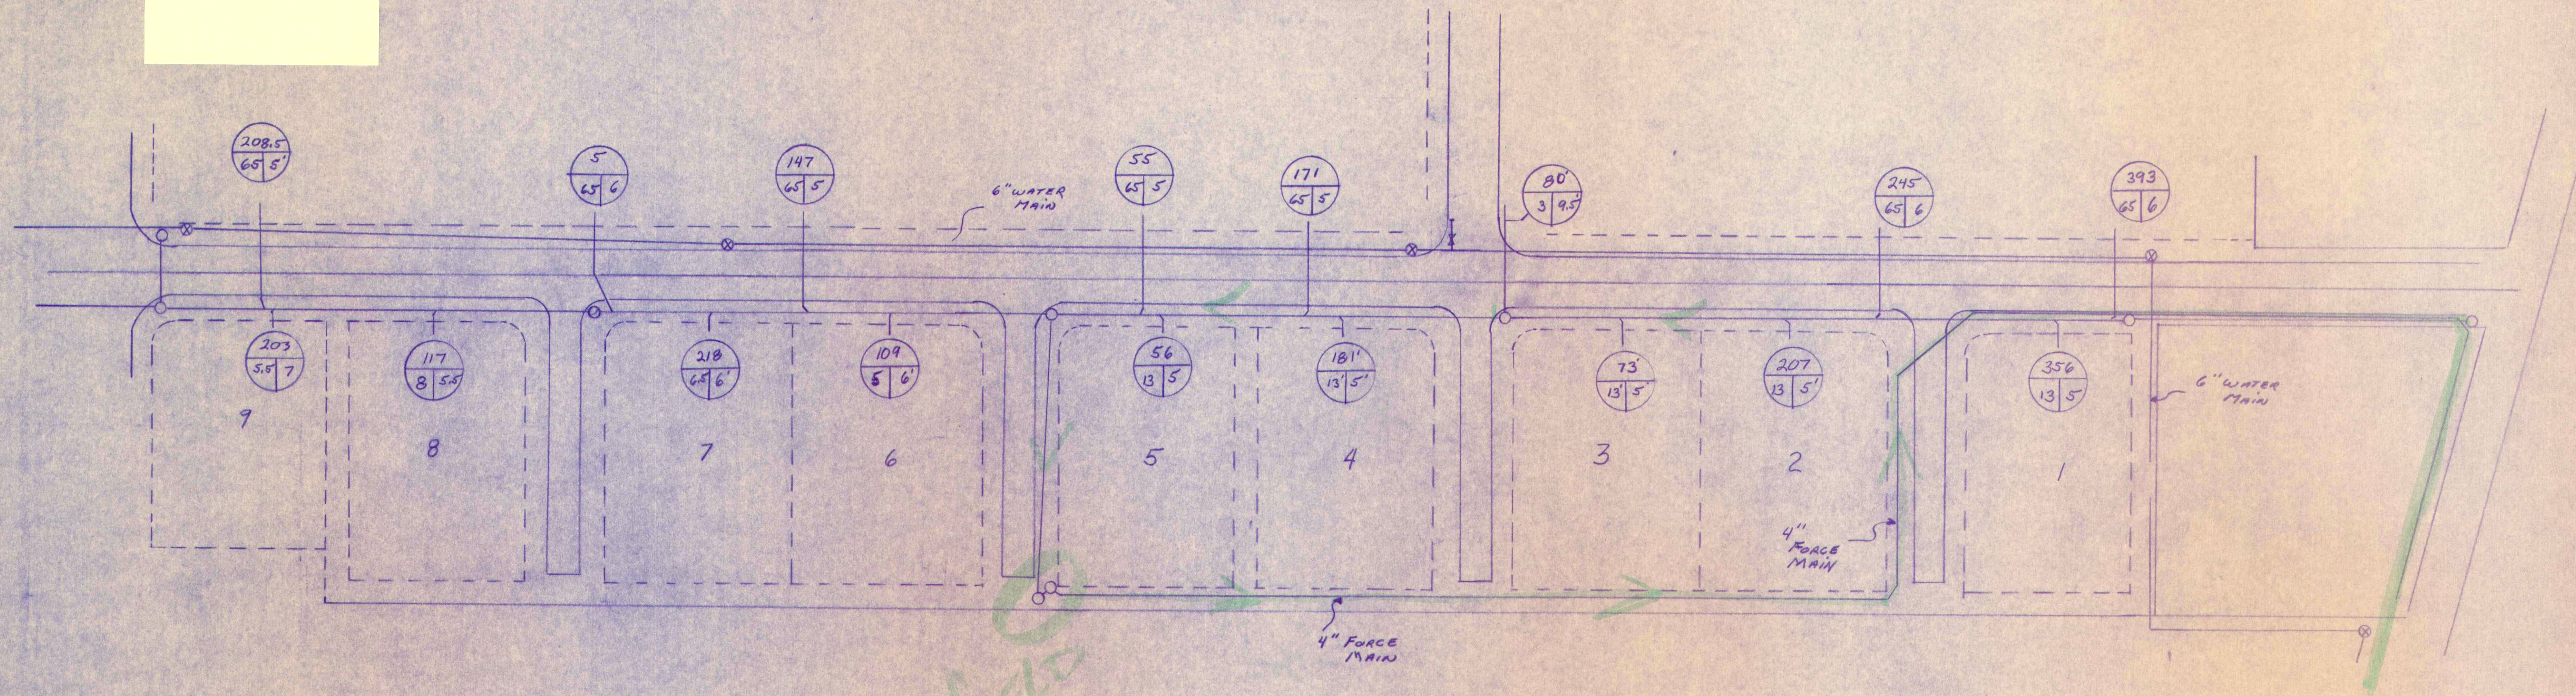



Key

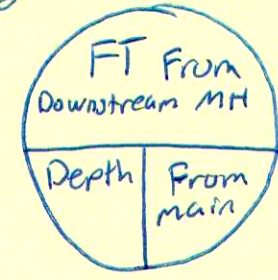

Deerfield LLC

ON-SITE UTILITIES

4" F.M. From Deerfield

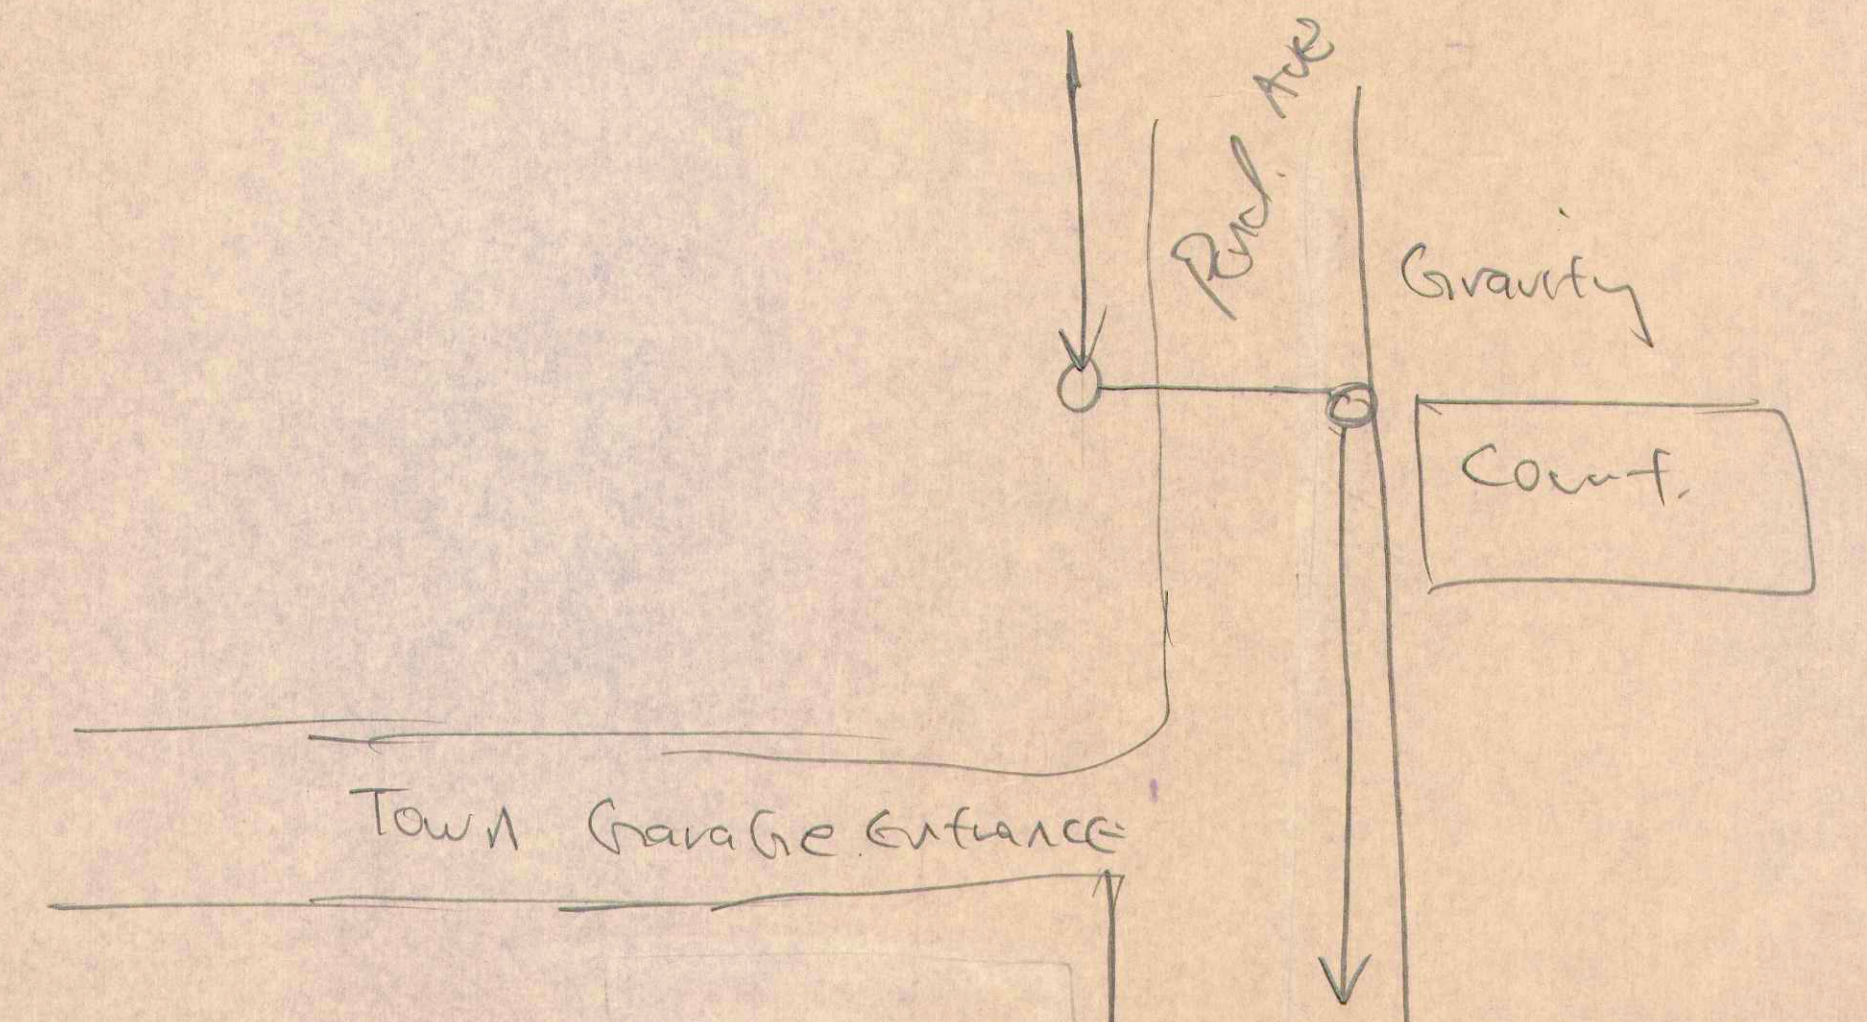

TOLERANCES		REVISIONS			
EXCEPT AS NOTED	NO.	DATE	BY		
DECIMAL	1				
FRACTIONAL	2				
ANGULAR	3				
	4				
	5				

DEERFIELD CONDOMINIUM
 PHASE I As Built
 SCALE 1"=50'
 DATE
 DRAWING NO.

108,500



960

8.5

1300

101+00

OFF-SITE UTILITIES

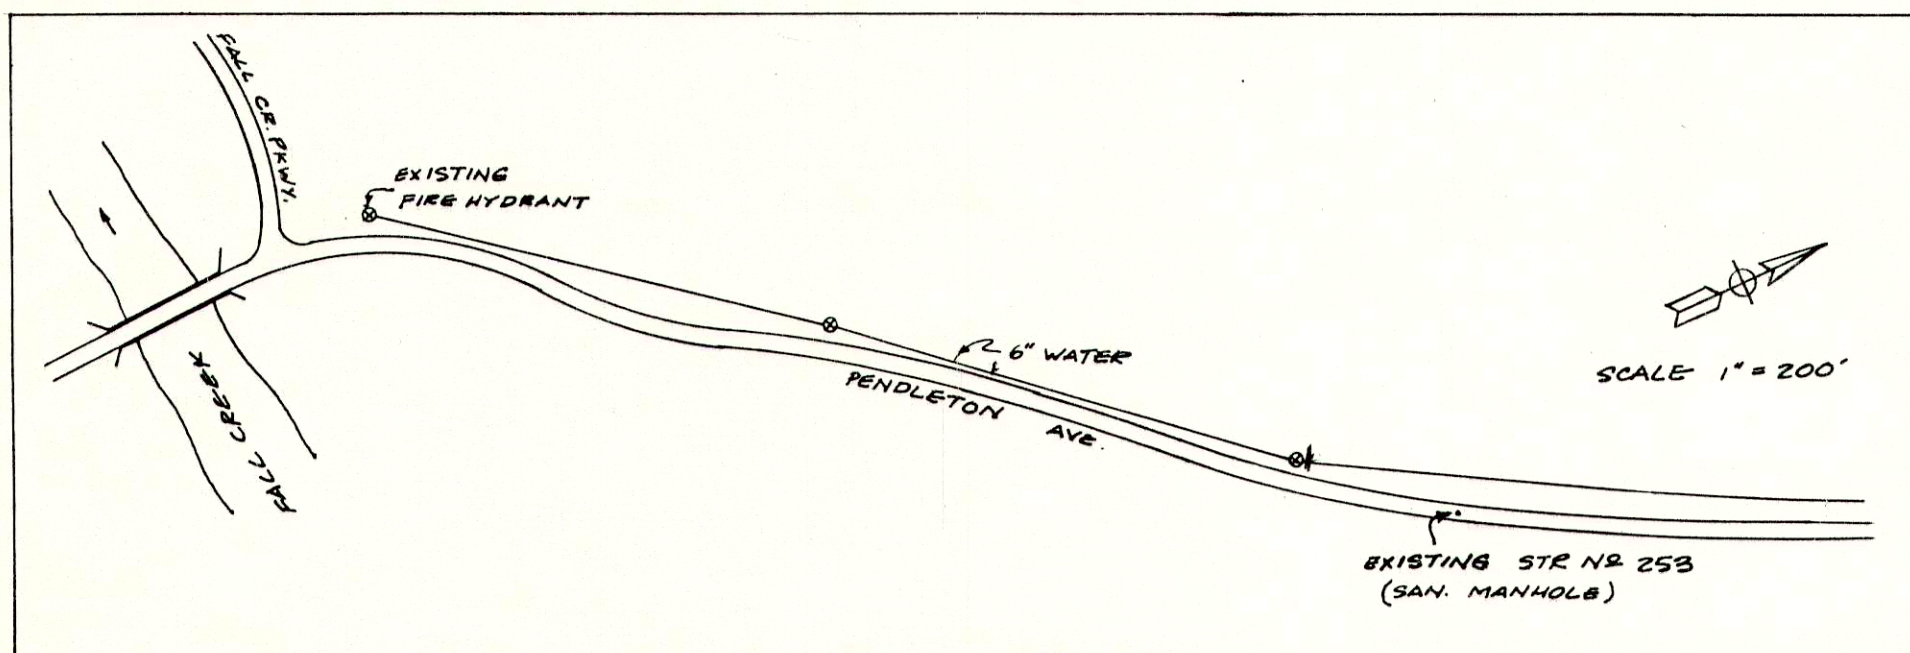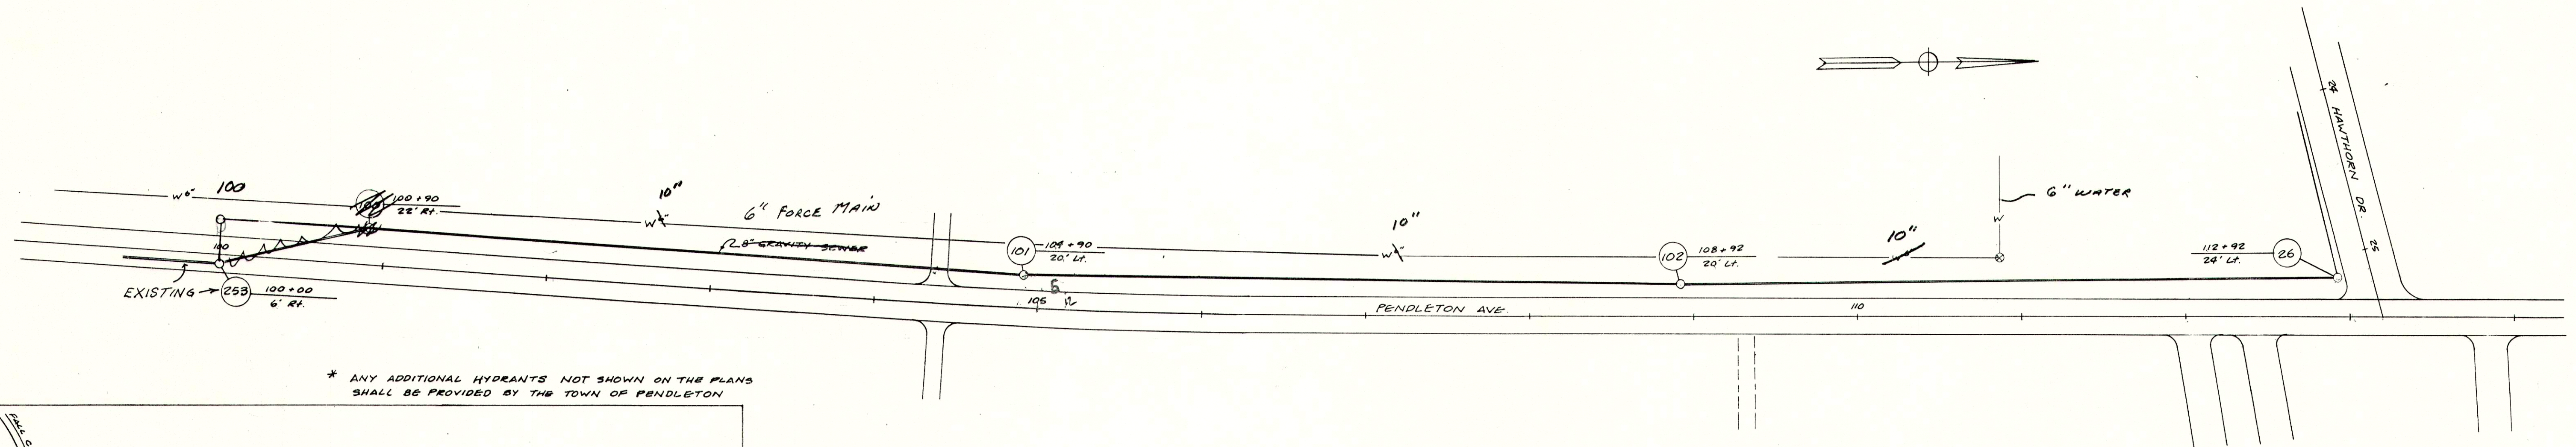

NOTES:

LENGTHS OF PIPE INDICATED ARE FROM CENTER TO CENTER OF STRUCTURES AND ARE NOT ACTUAL PIPE LENGTHS.

⊗ FIRE HYDRANT


SCALE

PLAN: 1" = 50'

PROFILE

VERT: 1" = 5'

HORIZ: 1" = 50'

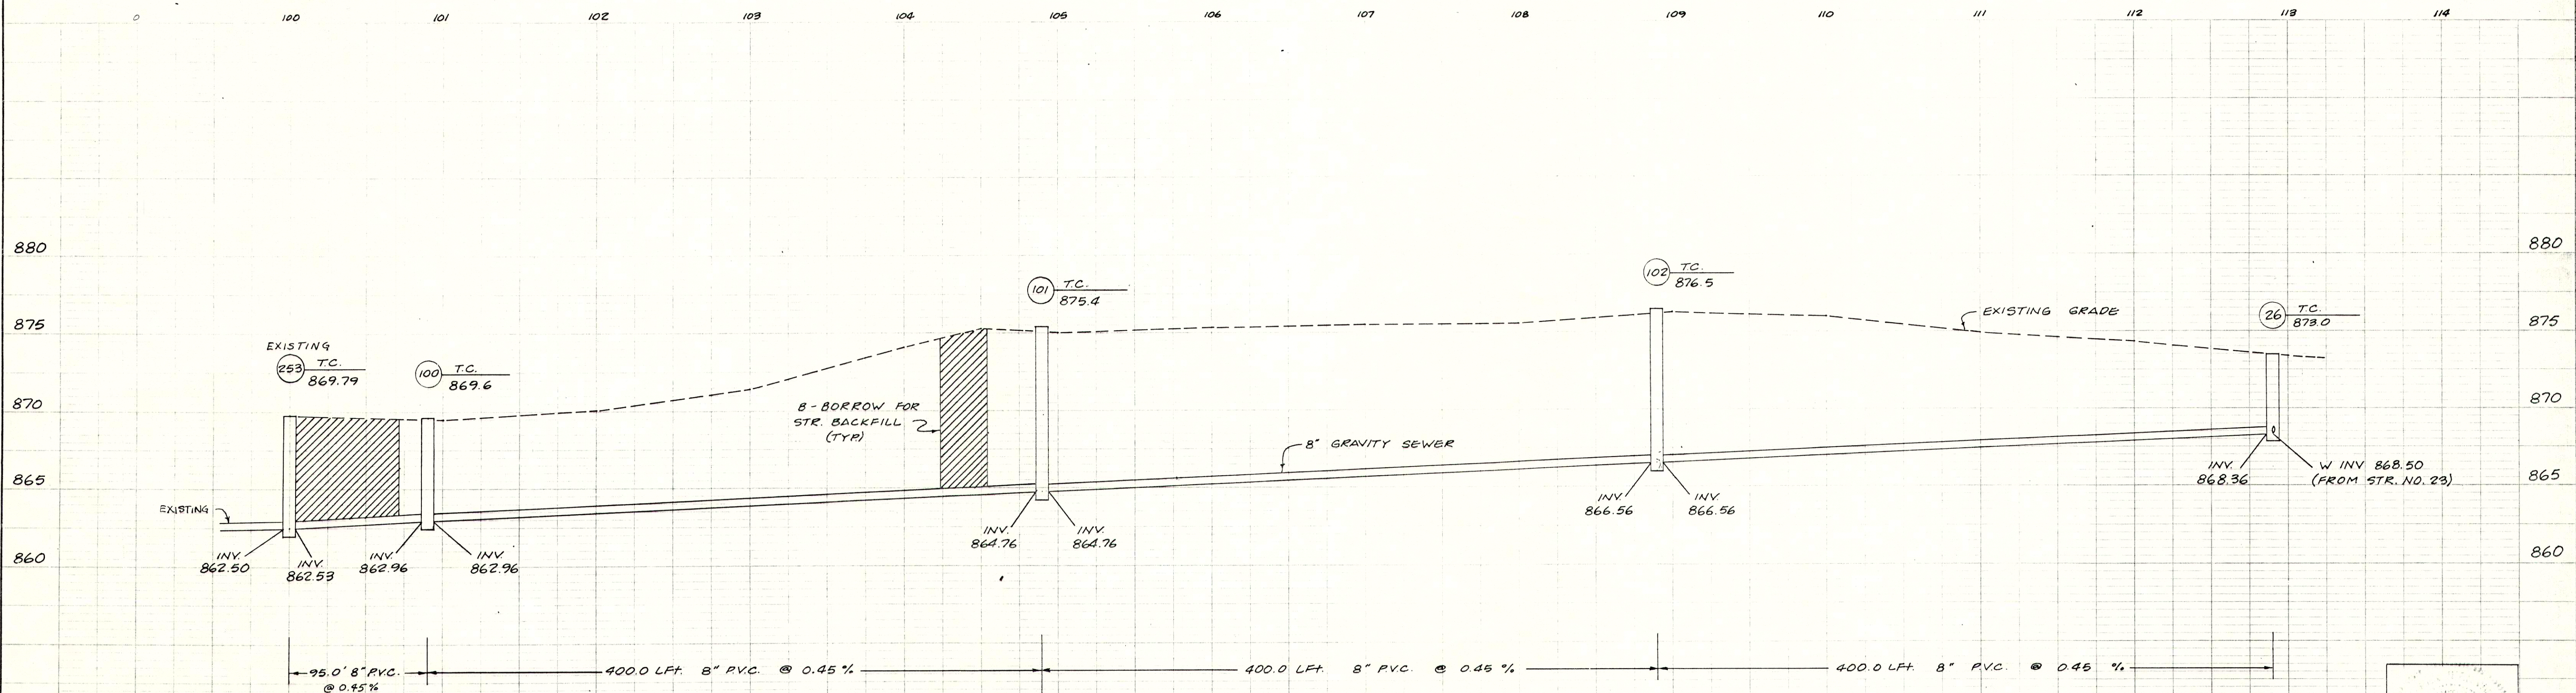

SHEET #7

Stylus 11/10/88 10:20:41

530
140
60
320
1050 4"

5

ON-SITE UTILITIES

PLAN
DATE
BY
SURVEYED
NOTE BOOK
ALIGNED CHECKED
BY
NO.

PROFILE
DATE
BY
SURVEYED
NOTE BOOK
GRADES CHECKED
BY
NO.

