


HWC
ENGINEERING

INDIANAPOLIS - TERRE HAUTE
LAFAYETTE - MUNCIE - NEW ALBANY
www.hwcengineering.com

CONSTRUCTION DETAILS

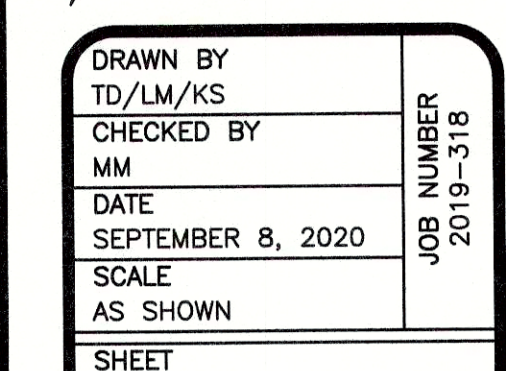

CONSTRUCTION DETAILS