


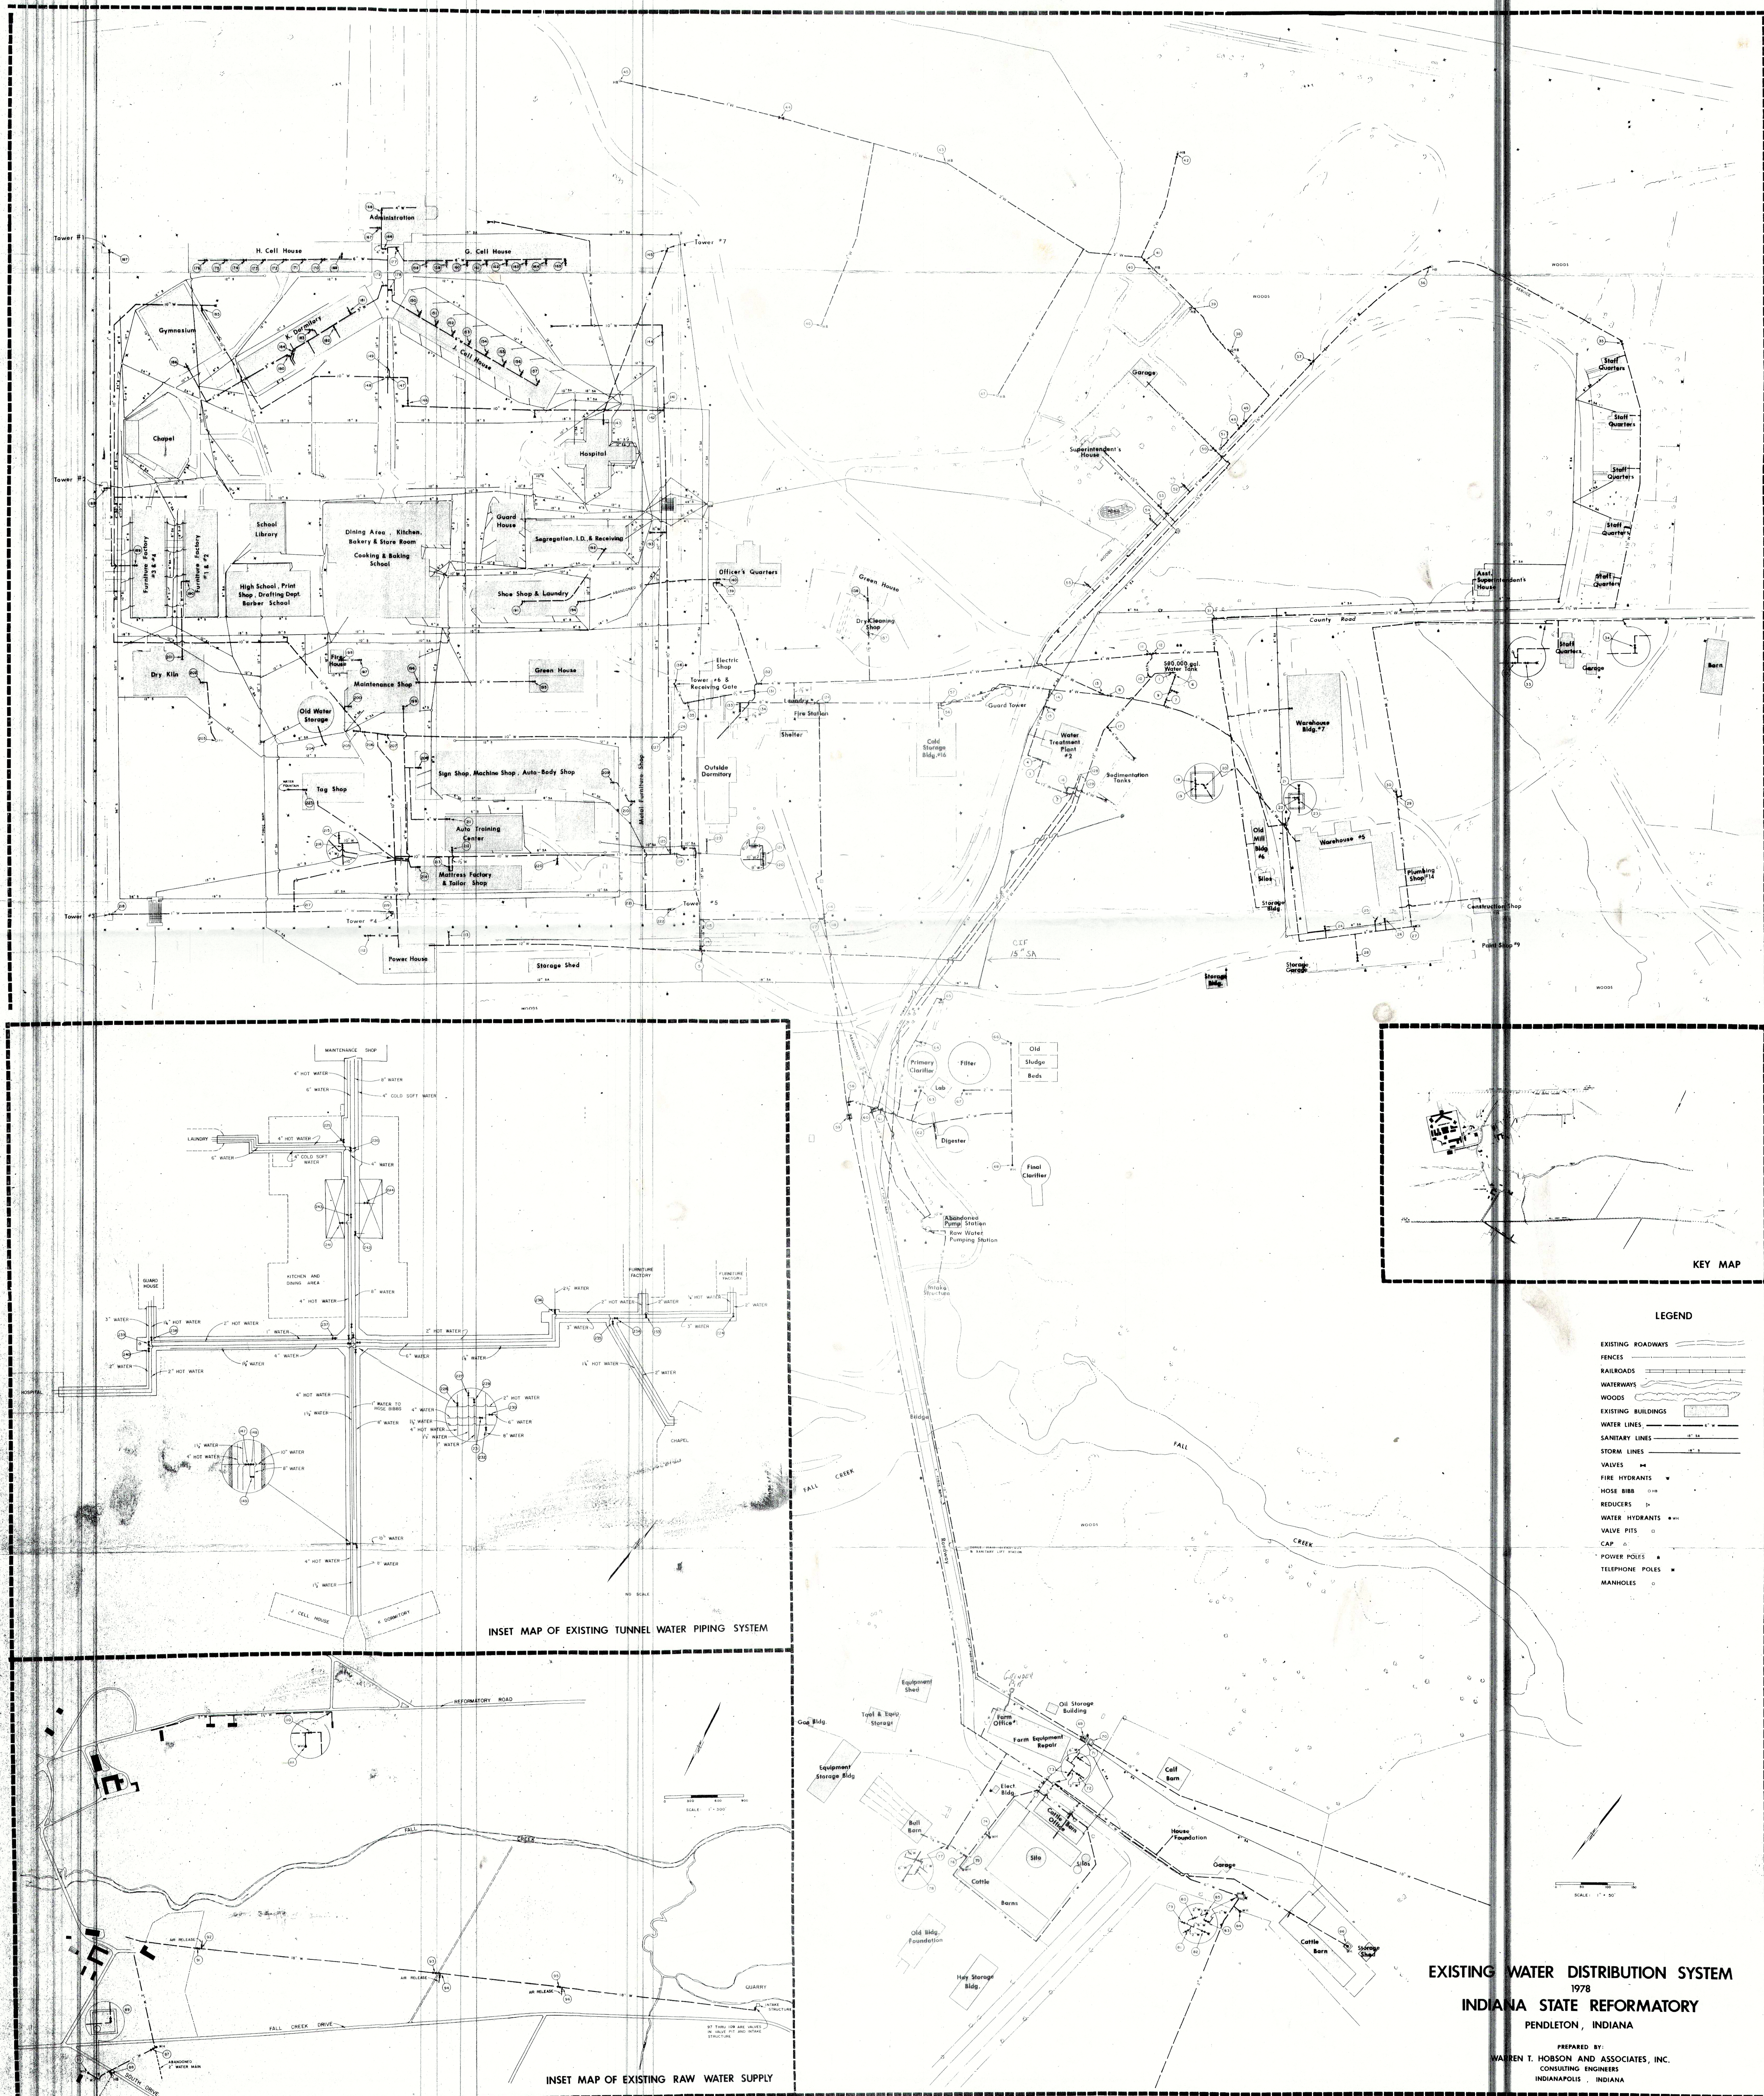

EXISTING WATER DISTRIBUTION SYSTEM
1978
INDIANA STATE REFORMATORY
PENDLETON, INDIANA

PREPARED BY:
WARREN T. HOBSON AND ASSOCIATES, INC.
CONSULTING ENGINEERS
INDIANAPOLIS, INDIANA