


FALL CREEK REGIONAL WASTE DISTRICT

HICKORY HILLS SUBDIVISION

CONTRACT 'II'

SHEET No. 7b OF 13

INDEX SA-1

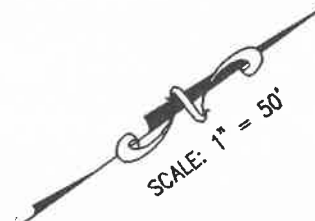


KEYNOTES

- (A) STRUCTURE No. 13a
T.C. = 883.43
INV. ℓ = 876.43
- (B) STRUCTURE No. 13b
T.C. = 887.03
INV. ℓ = 878.23

LEGEND:

- | | | | |
|-------|---------------------------|-------------|---|
| ===== | EXISTING DRAINAGE CULVERT | --- W --- | WATER LINE |
| ● | PROPOSED SANITARY MANHOLE | --- G --- | GAS LINE |
| — | PROPOSED SANITARY SEWER | — | EXISTING UTILITY POLE W/GUY |
| ▲ | EXISTING SIGN | — | EXISTING UTILITY POLE |
| ⊗ | EXISTING MAILBOX | ⊗ | WATER WELL |
| --- | RIGHT OF WAY | ⊞ | EXISTING ELECTRIC TRANSFORMER |
| --- | PROPERTY LINE | SC, 301.50' | AS-BUILT LATERAL LOCATION
(CONTRACT II SEWER LATERALS ARE
4 TO 5 FEET DEEP AT R/W LINE) |
| -x- | EXISTING FENCE LINE | | |

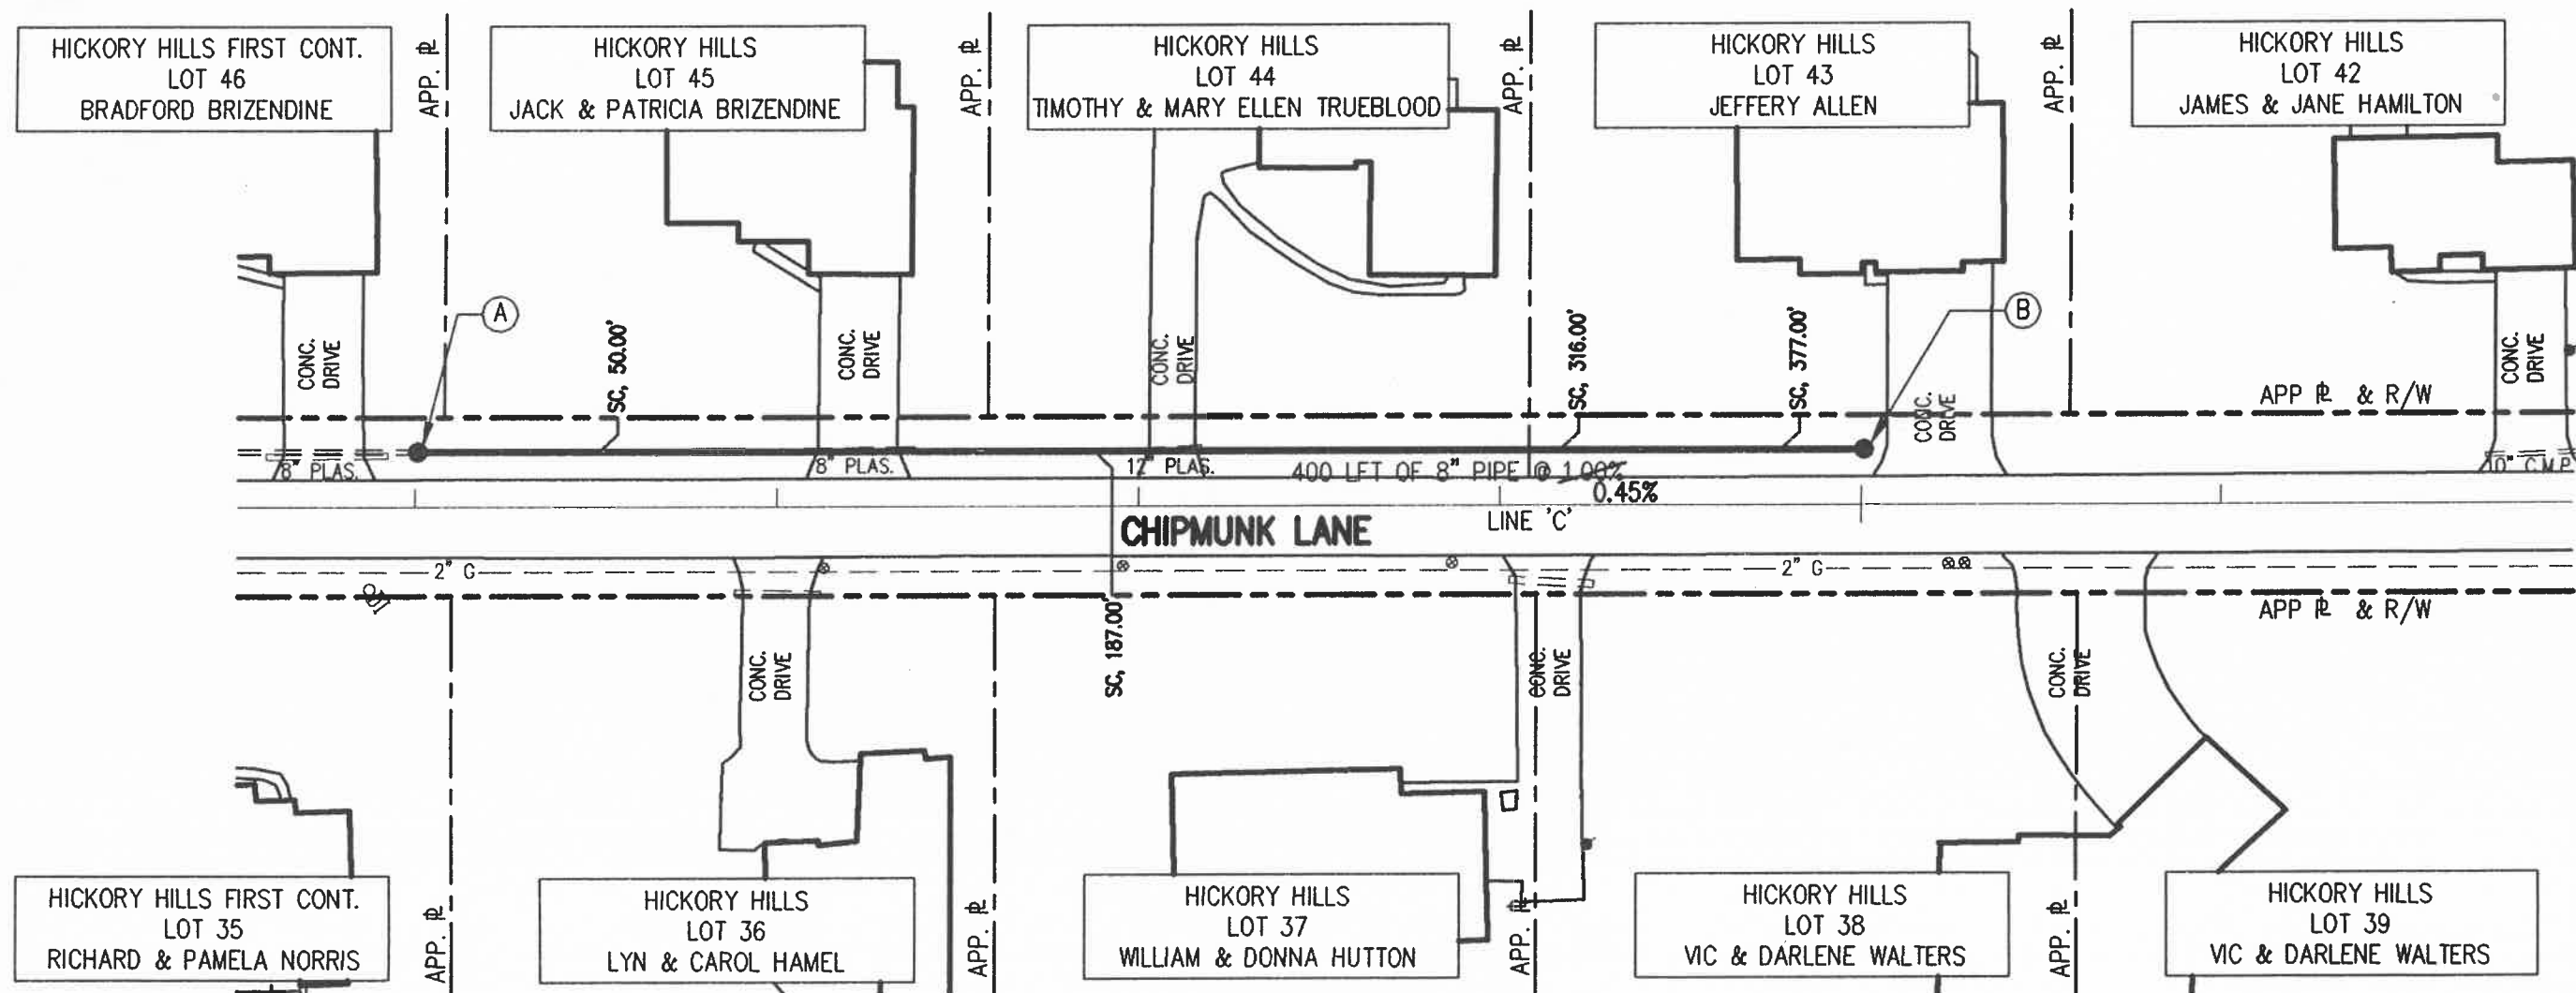

AS-BUILT NOTES:

- ALL LATERAL LOCATIONS ARE FROM CENTER OF CASTING OF DOWN STREAM M.H.

AS-BUILT INFORMATION

SCALE: 1" = 50'



TRIAD
ASSOCIATES
INC.
INDIANAPOLIS, INDIANA

FALL CREEK REGIONAL WASTE DISTRICT

HICKORY HILLS SUBDIVISION
CONTRACT 'II'

SHEET No. 3a OF 13

INDEX SA-1




SCALE: 1" = 50'

KEYNOTES

- (A) STRUCTURE No. 10
INV.(N) = 857.60
- (B) STRUCTURE No. 11
T.C. = 865.10
INV. ϕ = 859.00
- (C) STRUCTURE No. 12
T.C. = 866.92
INV. ϕ = 860.42

LEGEND:

- == == == == EXISTING DRAINAGE CULVERT
- PROPOSED SANITARY MANHOLE
- PROPOSED SANITARY SEWER
- ▲ EXISTING SIGN
- ⊕ EXISTING MAILBOX
- RIGHT OF WAY
- PROPERTY LINE
- x- EXISTING FENCE LINE
- W WATER LINE
- G GAS LINE
- EXISTING UTILITY POLE W/GUY
- EXISTING UTILITY POLE
- ⊙ WATER WELL
- ⊠ EXISTING ELECTRIC TRANSFORMER
- SC, 301.50' AS-BUILT LATERAL LOCATION
(CONTRACT II SEWER LATERALS ARE 4 TO 5 FEET DEEP AT R/W LINE)

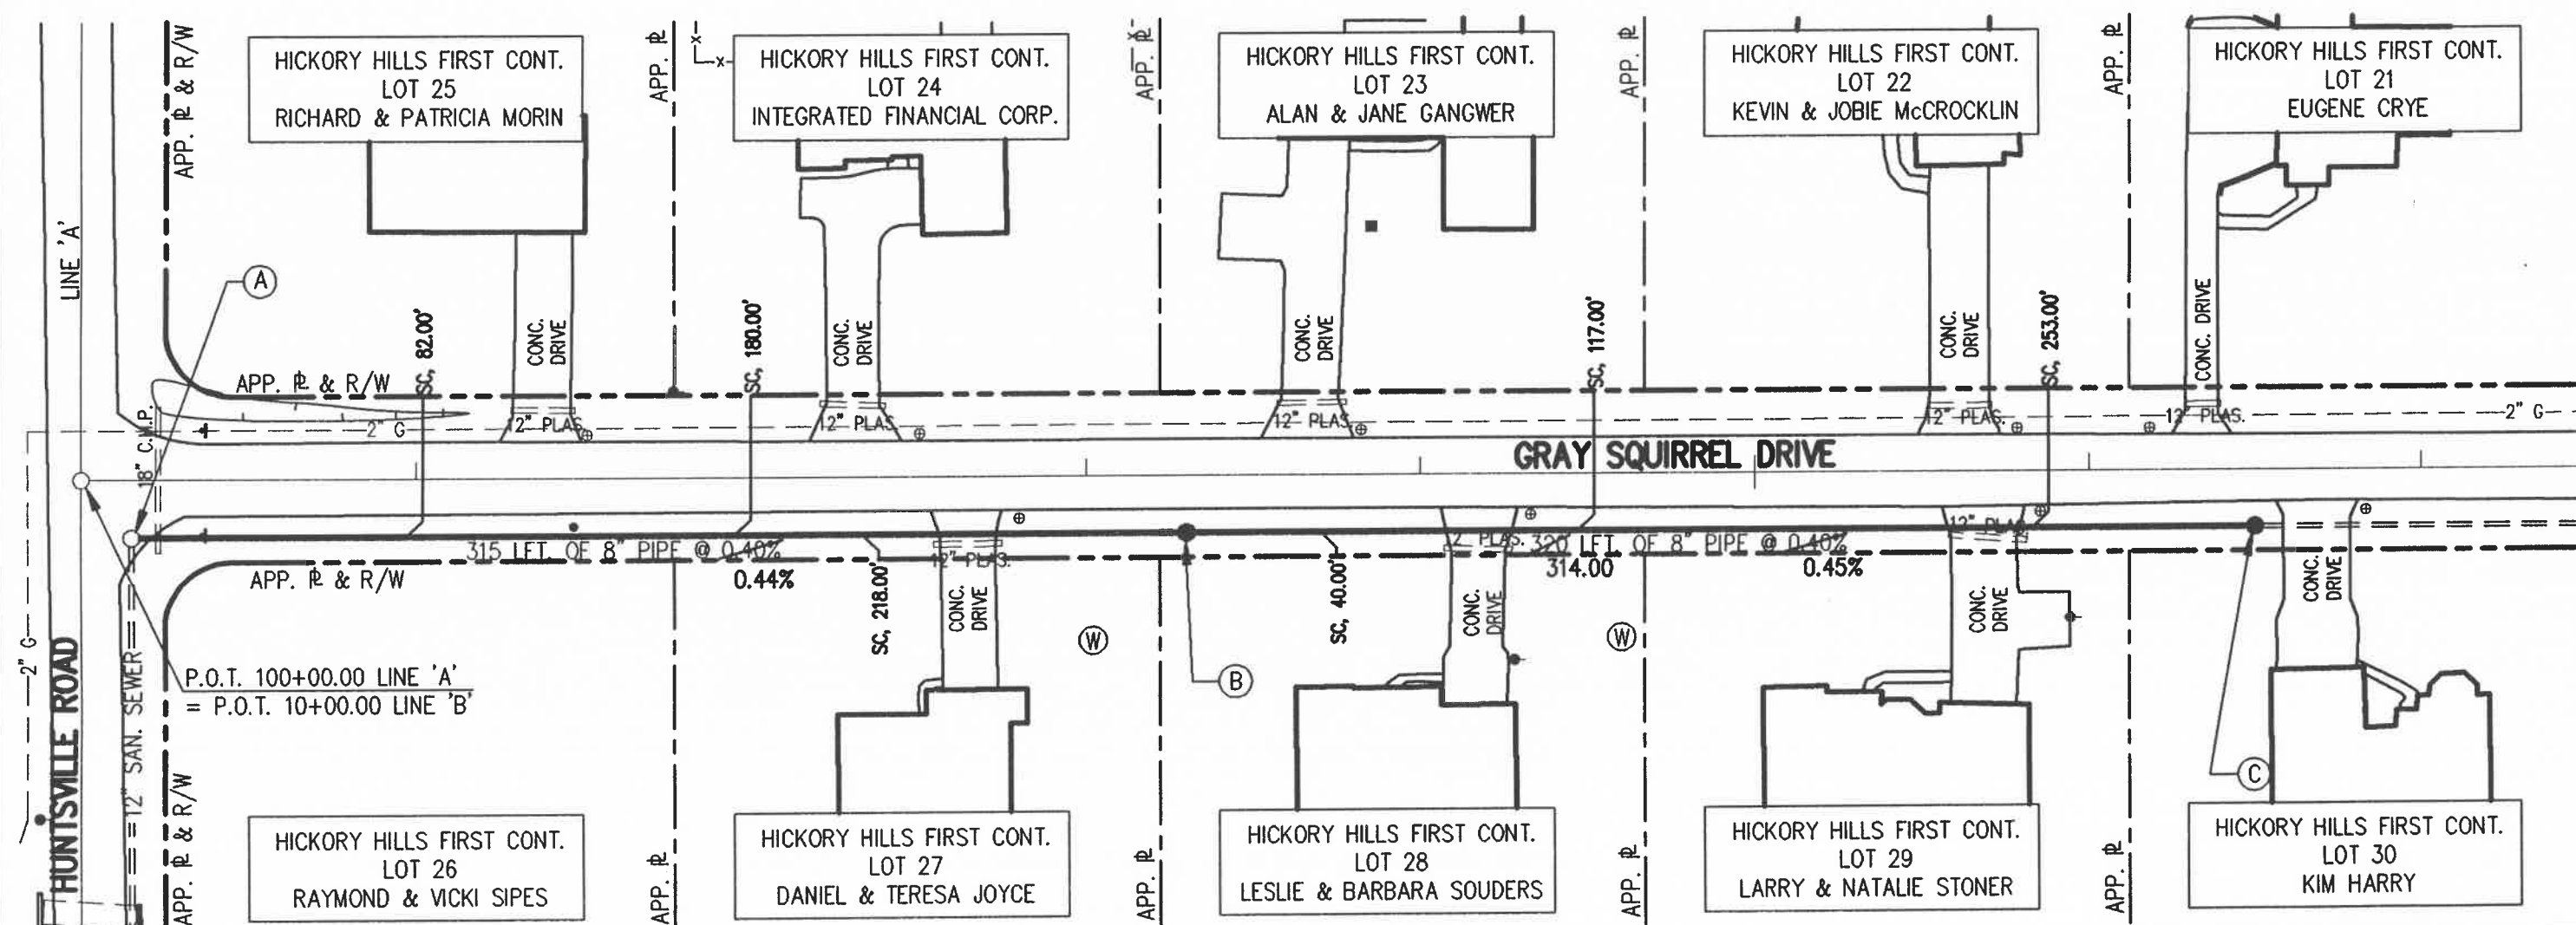

AS-BUILT INFORMATION

SCALE: 1" = 50'



NORTH

TRIAD
ASSOCIATES
INC.

INDIANAPOLIS, INDIANA



FALL CREEK REGIONAL WASTE DISTRICT

HICKORY HILLS SUBDIVISION
CONTRACT 'II'

SHEET No. 3b OF 13

INDEX SA-1




SCALE: 1" = 50'

KEYNOTES

- (A) STRUCTURE No. 12
T.C. = 866.92
INV. ϕ = 860.42
- (B) STRUCTURE No. 13
T.C. = 882.13
INV.(NE) = 874.03
INV. ϕ = 870.41
- (C) STRUCTURE No. 14
T.C. = 884.15
INV. ϕ = 871.75

==	EXISTING DRAINAGE CULVERT	---	W	---	WATER LINE
●	PROPOSED SANITARY MANHOLE	---	G	---	GAS LINE
---	PROPOSED SANITARY SEWER	⊙			EXISTING UTILITY POLE W/GUY
▲	EXISTING SIGN	⚡			EXISTING UTILITY POLE
⊕	EXISTING MAILBOX	(W)			WATER WELL
---	RIGHT OF WAY	⊞			EXISTING ELECTRIC TRANSFORMER
---	PROPERTY LINE	SC, 301.50'			AS-BUILT LATERAL LOCATION (CONTRACT II SEWER LATERALS ARE 4 TO 5 FEET DEEP AT R/W LINE)
-x-	EXISTING FENCE LINE				

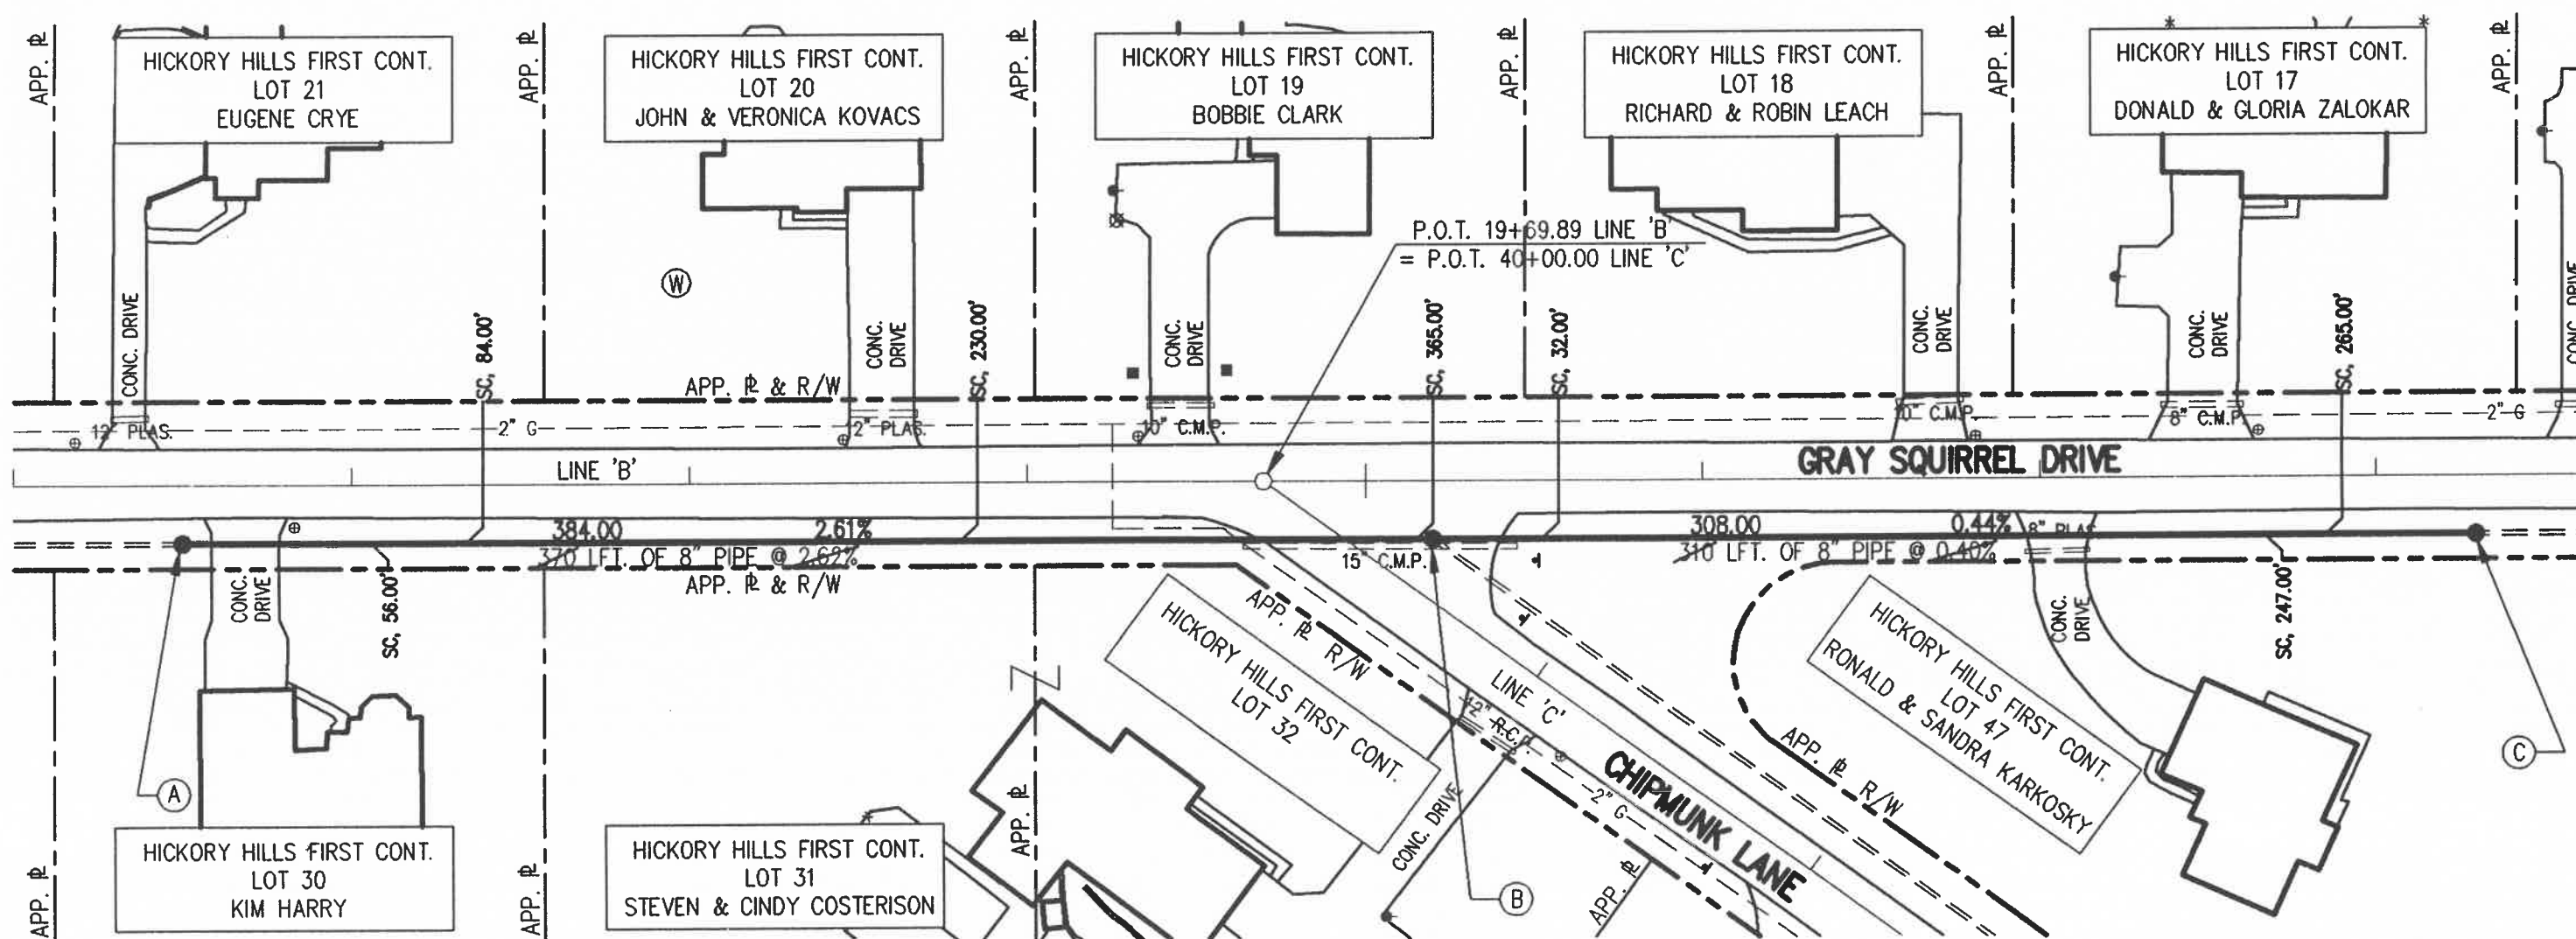

AS-BUILT INFORMATION

SCALE: 1" = 50'



NORTH

TRIAD
ASSOCIATES
INC.

INDIANAPOLIS, INDIANA



**FALL CREEK REGIONAL
WASTE DISTRICT**
HICKORY HILLS SUBDIVISION
CONTRACT 'II'
SHEET No. 4a OF 13

INDEX SA-1




KEYNOTES

- (A) STRUCTURE No. 14
T.C. = 884.15
INV. ℓ = 871.75
- (B) STRUCTURE No. 15
T.C. = 885.62
INV. ℓ = 873.32
- (C) STRUCTURE No. 16
T.C. = 886.95
INV. ℓ = 874.85

LEGEND:

- == == == == EXISTING DRAINAGE CULVERT
- PROPOSED SANITARY MANHOLE
- — — — PROPOSED SANITARY SEWER
- ▲ EXISTING SIGN
- ⊕ EXISTING MAILBOX
- — — — RIGHT OF WAY
- — — — PROPERTY LINE
- x — — EXISTING FENCE LINE
- w — — WATER LINE
- g — — GAS LINE
- — — — EXISTING UTILITY POLE W/GUY
- — — — EXISTING UTILITY POLE
- ⊙ WATER WELL
- ⊠ EXISTING ELECTRIC TRANSFORMER
- SC, 301.50' — AS-BUILT LATERAL LOCATION
(CONTRACT II SEWER LATERALS ARE
4 TO 5 FEET DEEP AT R/W LINE)

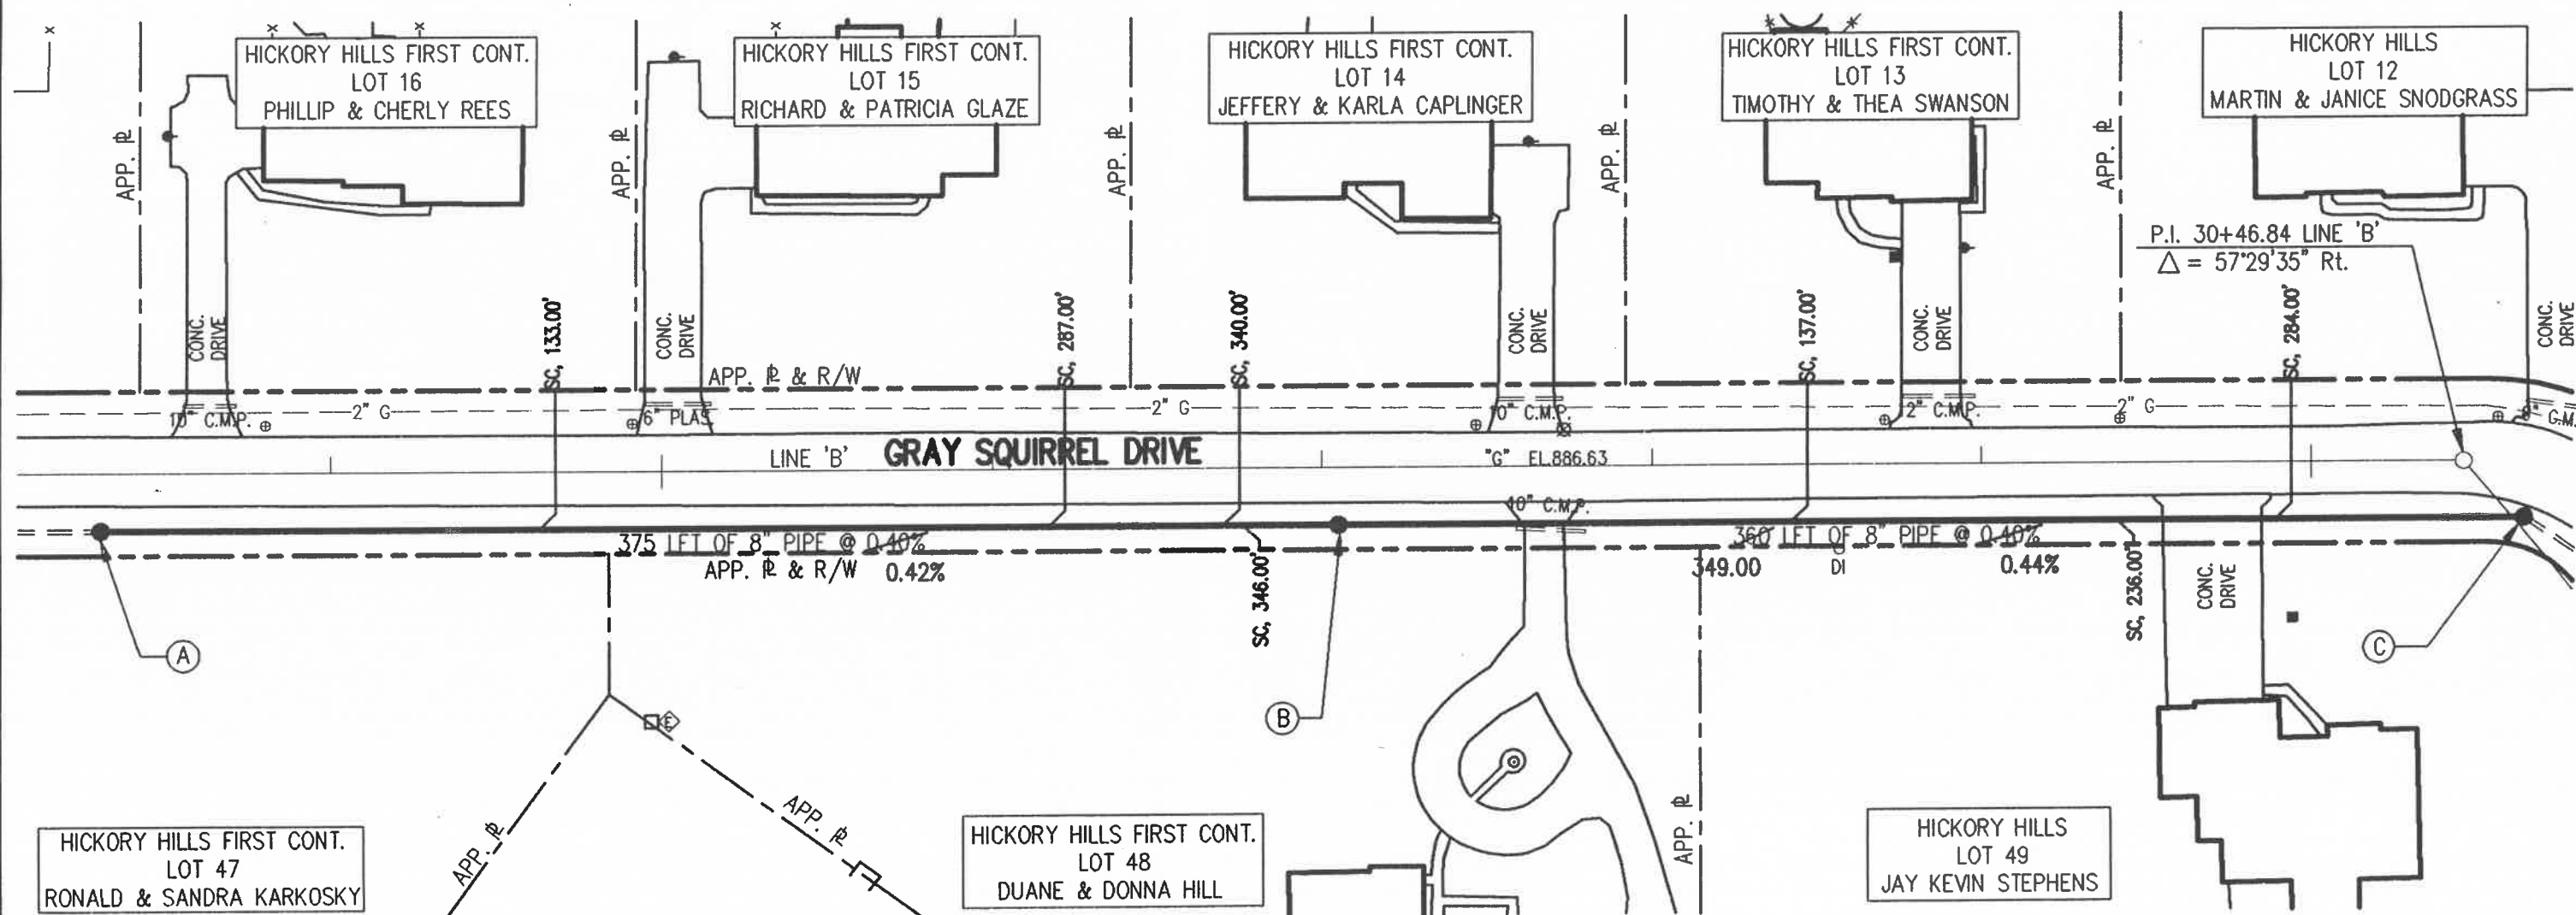

AS-BUILT INFORMATION

SCALE: 1" = 50'



**TRIAD
ASSOCIATES
INC.**
INDIANAPOLIS, INDIANA

SHEET No. 4b OF 13


INDEX SA-1

KEYNOTES

- (A) STRUCTURE No. 16
T.C. = 886.95
INV. C = 874.85
- (B) STRUCTURE No. 17
T.C. = 887.77
INV. C = 875.27
- (C) STRUCTURE No. 18
T.C. = 886.96
INV. C = 876.46
- (D) STRUCTURE No. 19
T.C. = 883.53
INV. C = 877.63

LEGEND:

- | | | | | | |
|-------------|---|---------------------------|---------------|---|---|
| == -- == | - | EXISTING DRAINAGE CULVERT | --- W --- | - | WATER LINE |
| ● | - | PROPOSED SANITARY MANHOLE | --- G --- | - | GAS LINE |
| ===== | - | PROPOSED SANITARY SEWER | ●- | - | EXISTING UTILITY POLE W/GUY |
| ▲ | - | EXISTING SIGN | ⚡ | - | EXISTING UTILITY POLE |
| ⊕ | - | EXISTING MAILBOX | Ⓢ | - | WATER WELL |
| ----- | - | RIGHT OF WAY | ⓧ | - | EXISTING ELECTRIC TRANSFORMER |
| ----- | - | PROPERTY LINE | └ SC, 301.50' | - | AS-BUILT LATERAL LOCATION
(CONTRACT II SEWER LATERALS ARE
4 TO 5 FEET DEEP AT R/W LINE) |
| -----x----- | - | EXISTING FENCE LINE | | | |

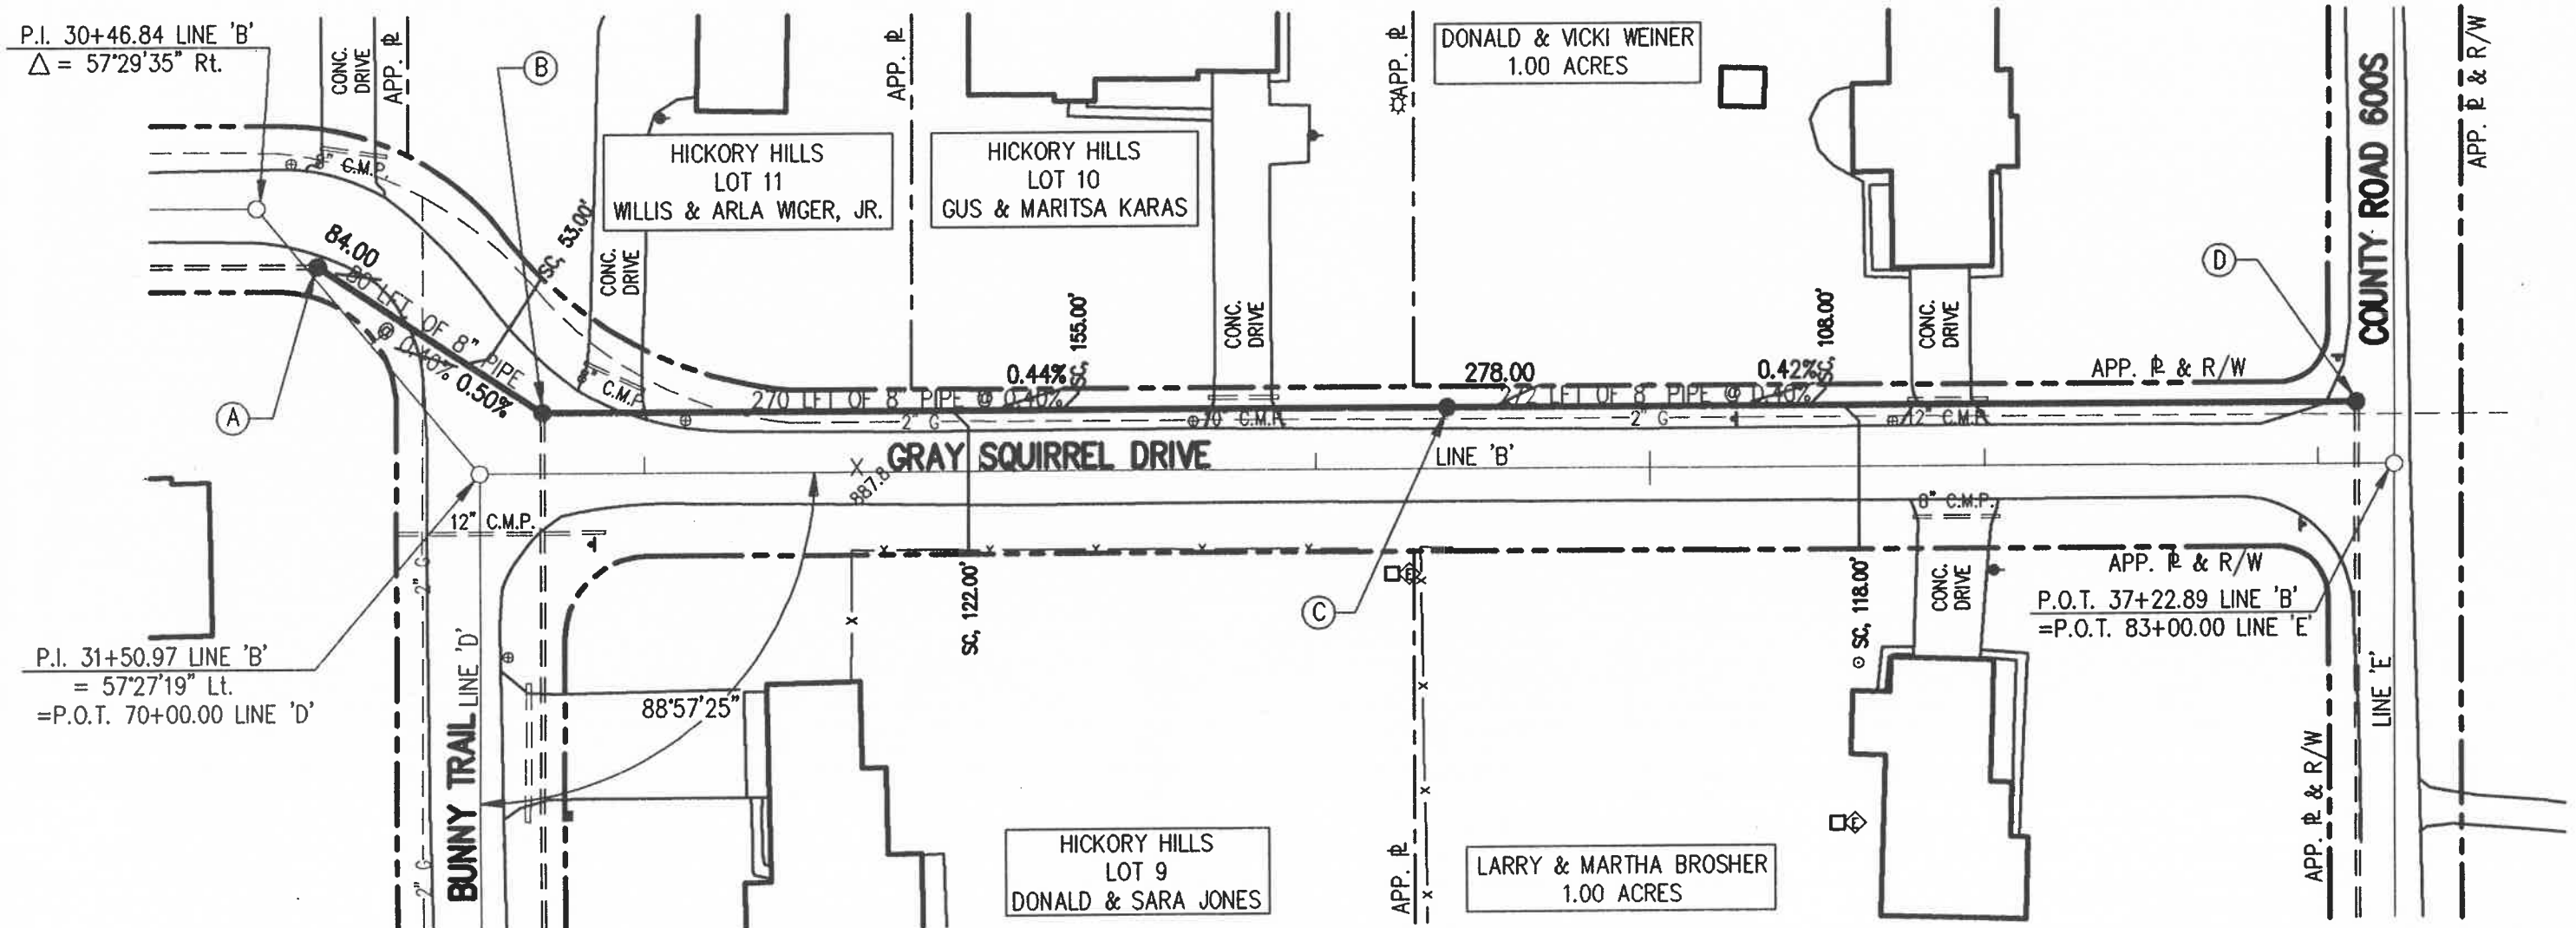

AS-BUILT INFORMATION

SCALE: 1" = 50'



**TRIAD
ASSOCIATES
INC.**

INDIANAPOLIS, INDIANA



FALL CREEK REGIONAL
WASTE DISTRICT
HICKORY HILLS SUBDIVISION
CONTRACT 'II'

SHEET No. 5a OF 13

INDEX SA-1


KEYNOTES

- (A) STRUCTURE No. 19
T.C. = 883.53
INV. ℓ = 877.63
- (B) STRUCTURE No. 19a
T.C. = 888.78
INV. ℓ = 881.98

LEGEND:

- | | | | |
|-------|---------------------------|-------------|---|
| ===== | EXISTING DRAINAGE CULVERT | --- W --- | WATER LINE |
| ● | PROPOSED SANITARY MANHOLE | --- G --- | GAS LINE |
| — | PROPOSED SANITARY SEWER | ⊙ | EXISTING UTILITY POLE W/GUY |
| ▲ | EXISTING SIGN | ⊙ | EXISTING UTILITY POLE |
| ⊕ | EXISTING MAILBOX | ⊙ | WATER WELL |
| --- | RIGHT OF WAY | ⊙ | EXISTING ELECTRIC TRANSFORMER |
| --- | PROPERTY LINE | SC, 301.50' | AS-BUILT LATERAL LOCATION
(CONTRACT II SEWER LATERALS ARE
4 TO 5 FEET DEEP AT R/W LINE) |
| -x- | EXISTING FENCE LINE | | |

SCALE: 1" = 50'

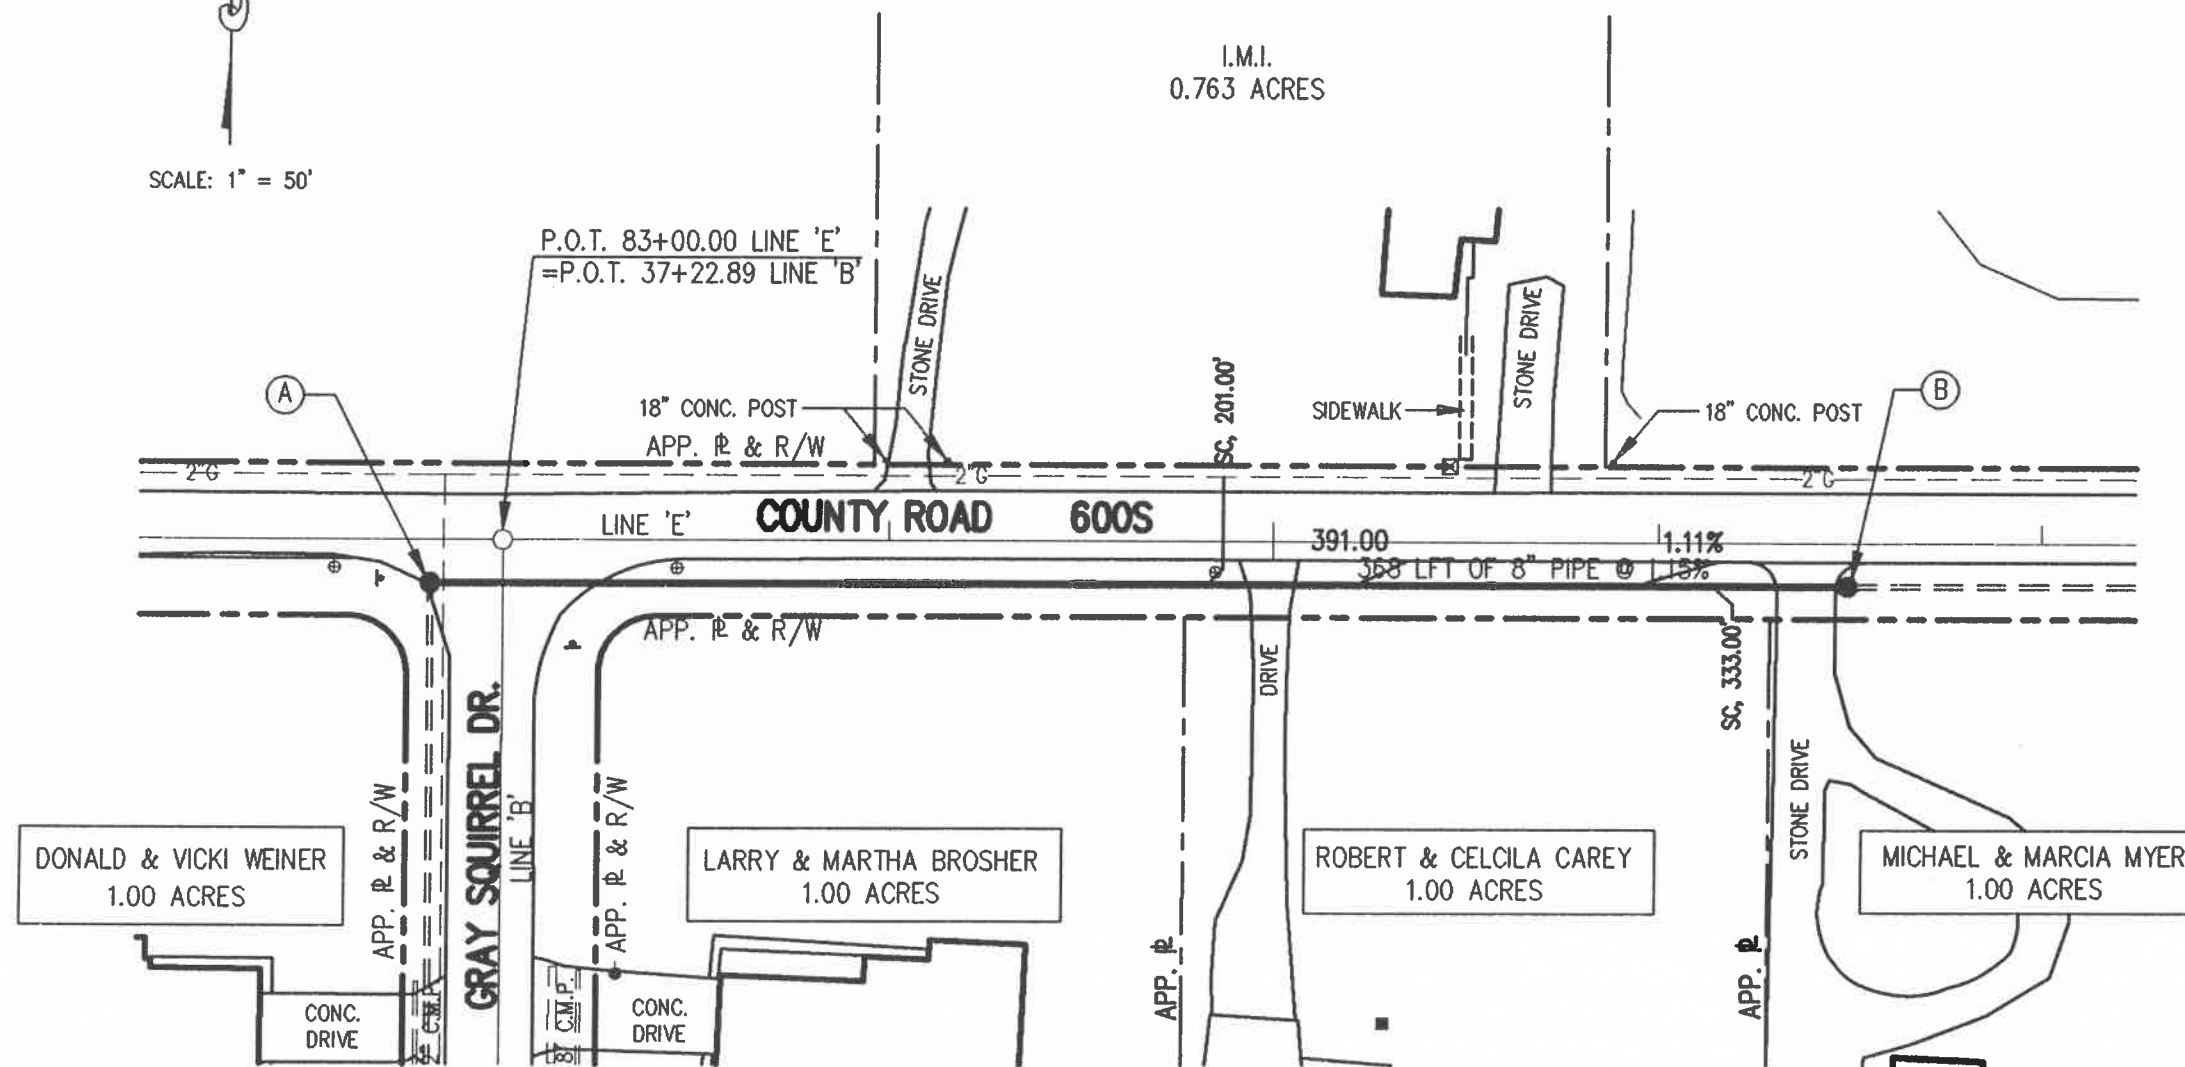

AS-BUILT NOTES:

- ALL LATERAL LOCATIONS ARE FROM CENTER OF CASTING OF DOWN STREAM M.H.

AS-BUILT INFORMATION

SCALE: 1" = 50'



TRIAD
ASSOCIATES
INC.
INDIANAPOLIS, INDIANA

**FALL CREEK REGIONAL
WASTE DISTRICT**
HICKORY HILLS SUBDIVISION
CONTRACT 'II'
SHEET No. 5b OF 13


INDEX SA-1

KEYNOTES

- (A) STRUCTURE No. 19a
T.C. = 888.78
INV. ℓ = 881.98
(B) STRUCTURE No. 19b
T.C. = 889.95
INV. ℓ = 883.25

LEGEND:

- | | | | |
|-------|---------------------------|-------------|---|
| ===== | EXISTING DRAINAGE CULVERT | --- W --- | WATER LINE |
| ● | PROPOSED SANITARY MANHOLE | --- G --- | GAS LINE |
| — | PROPOSED SANITARY SEWER | ⊙ | EXISTING UTILITY POLE W/GUY |
| ▲ | EXISTING SIGN | ⊙ | EXISTING UTILITY POLE |
| ⊕ | EXISTING MAILBOX | ⊙ | WATER WELL |
| --- | RIGHT OF WAY | ⊙ | EXISTING ELECTRIC TRANSFORMER |
| --- | PROPERTY LINE | SC, 301.50' | AS-BUILT LATERAL LOCATION
(CONTRACT II SEWER LATERALS ARE
4 TO 5 FEET DEEP AT R/W LINE) |
| --- | EXISTING FENCE LINE | | |

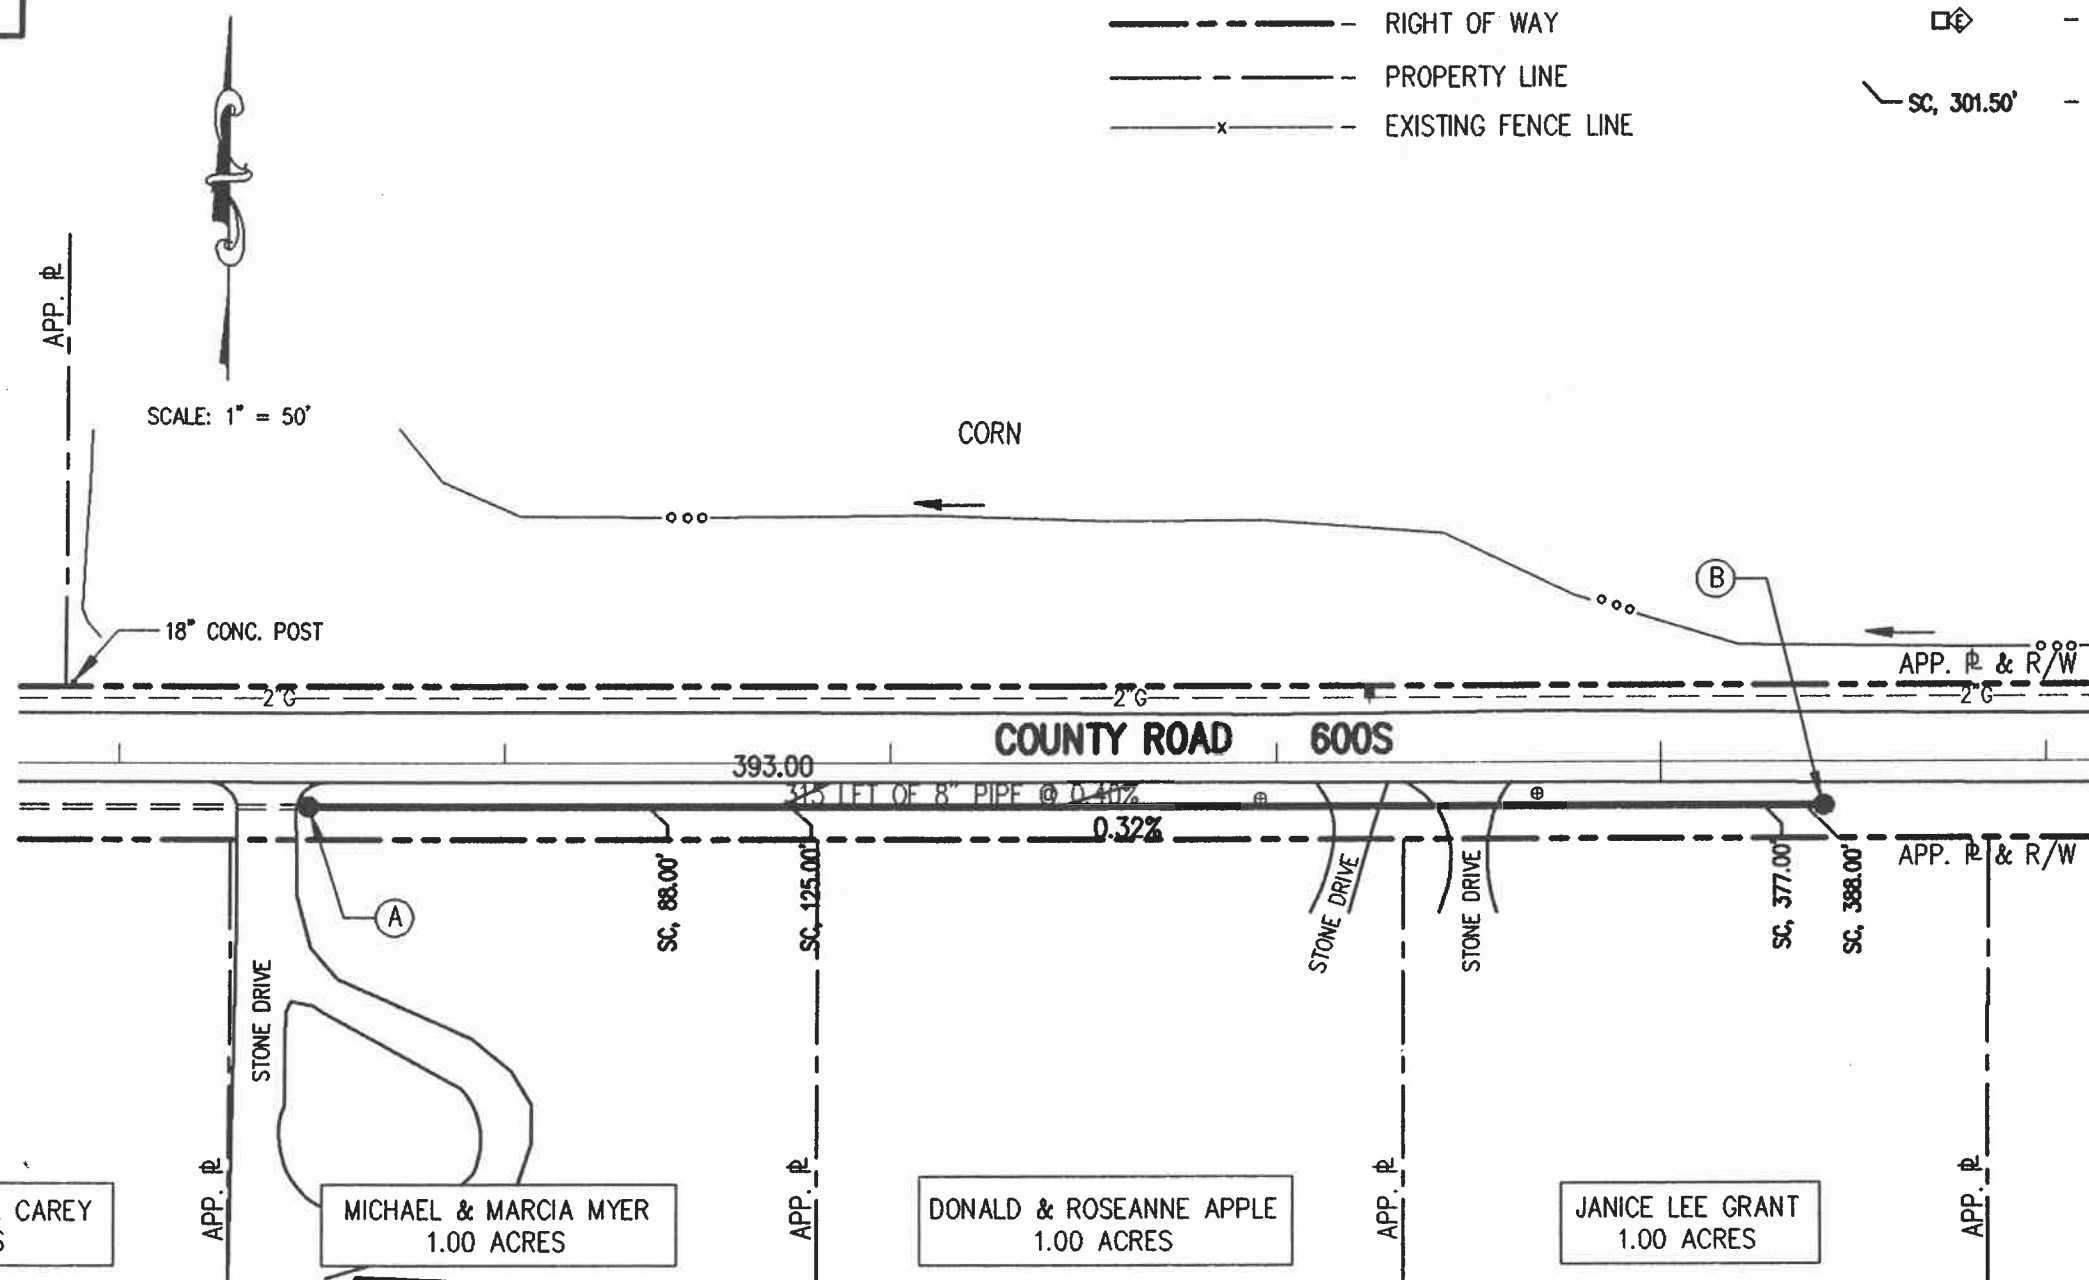

AS-BUILT NOTES:

- ALL LATERAL LOCATIONS ARE FROM CENTER OF CASTING OF DOWN STREAM M.H.

AS-BUILT INFORMATION

SCALE: 1" = 50'



**TRIAD
ASSOCIATES
INC.**
INDIANAPOLIS, INDIANA

FALL CREEK REGIONAL WASTE DISTRICT

HICKORY HILLS SUBDIVISION
CONTRACT 'II'

SHEET No. 6 OF 13

INDEX SA-1




KEYNOTES

- (A) STRUCTURE No. 17
T.C. = 887.77
INV. ℓ = 875.27
- (B) STRUCTURE No. 17a
T.C. = 887.41
INV. ℓ = 876.71
- (C) STRUCTURE No. 17b
T.C. = 887.15
INV. ℓ = 878.05

LEGEND:

- EXISTING DRAINAGE CULVERT
- PROPOSED SANITARY MANHOLE
- PROPOSED SANITARY SEWER
- ▲ EXISTING SIGN
- ⊕ EXISTING MAILBOX
- RIGHT OF WAY
- PROPERTY LINE
- EXISTING FENCE LINE
- W --- WATER LINE
- G --- GAS LINE
- EXISTING UTILITY POLE W/GUY
- EXISTING UTILITY POLE
- ⊙ WATER WELL
- ⊠ EXISTING ELECTRIC TRANSFORMER
- SC, 301.50' AS-BUILT LATERAL LOCATION
(CONTRACT II SEWER LATERALS ARE
4 TO 5 FEET DEEP AT R/W LINE)

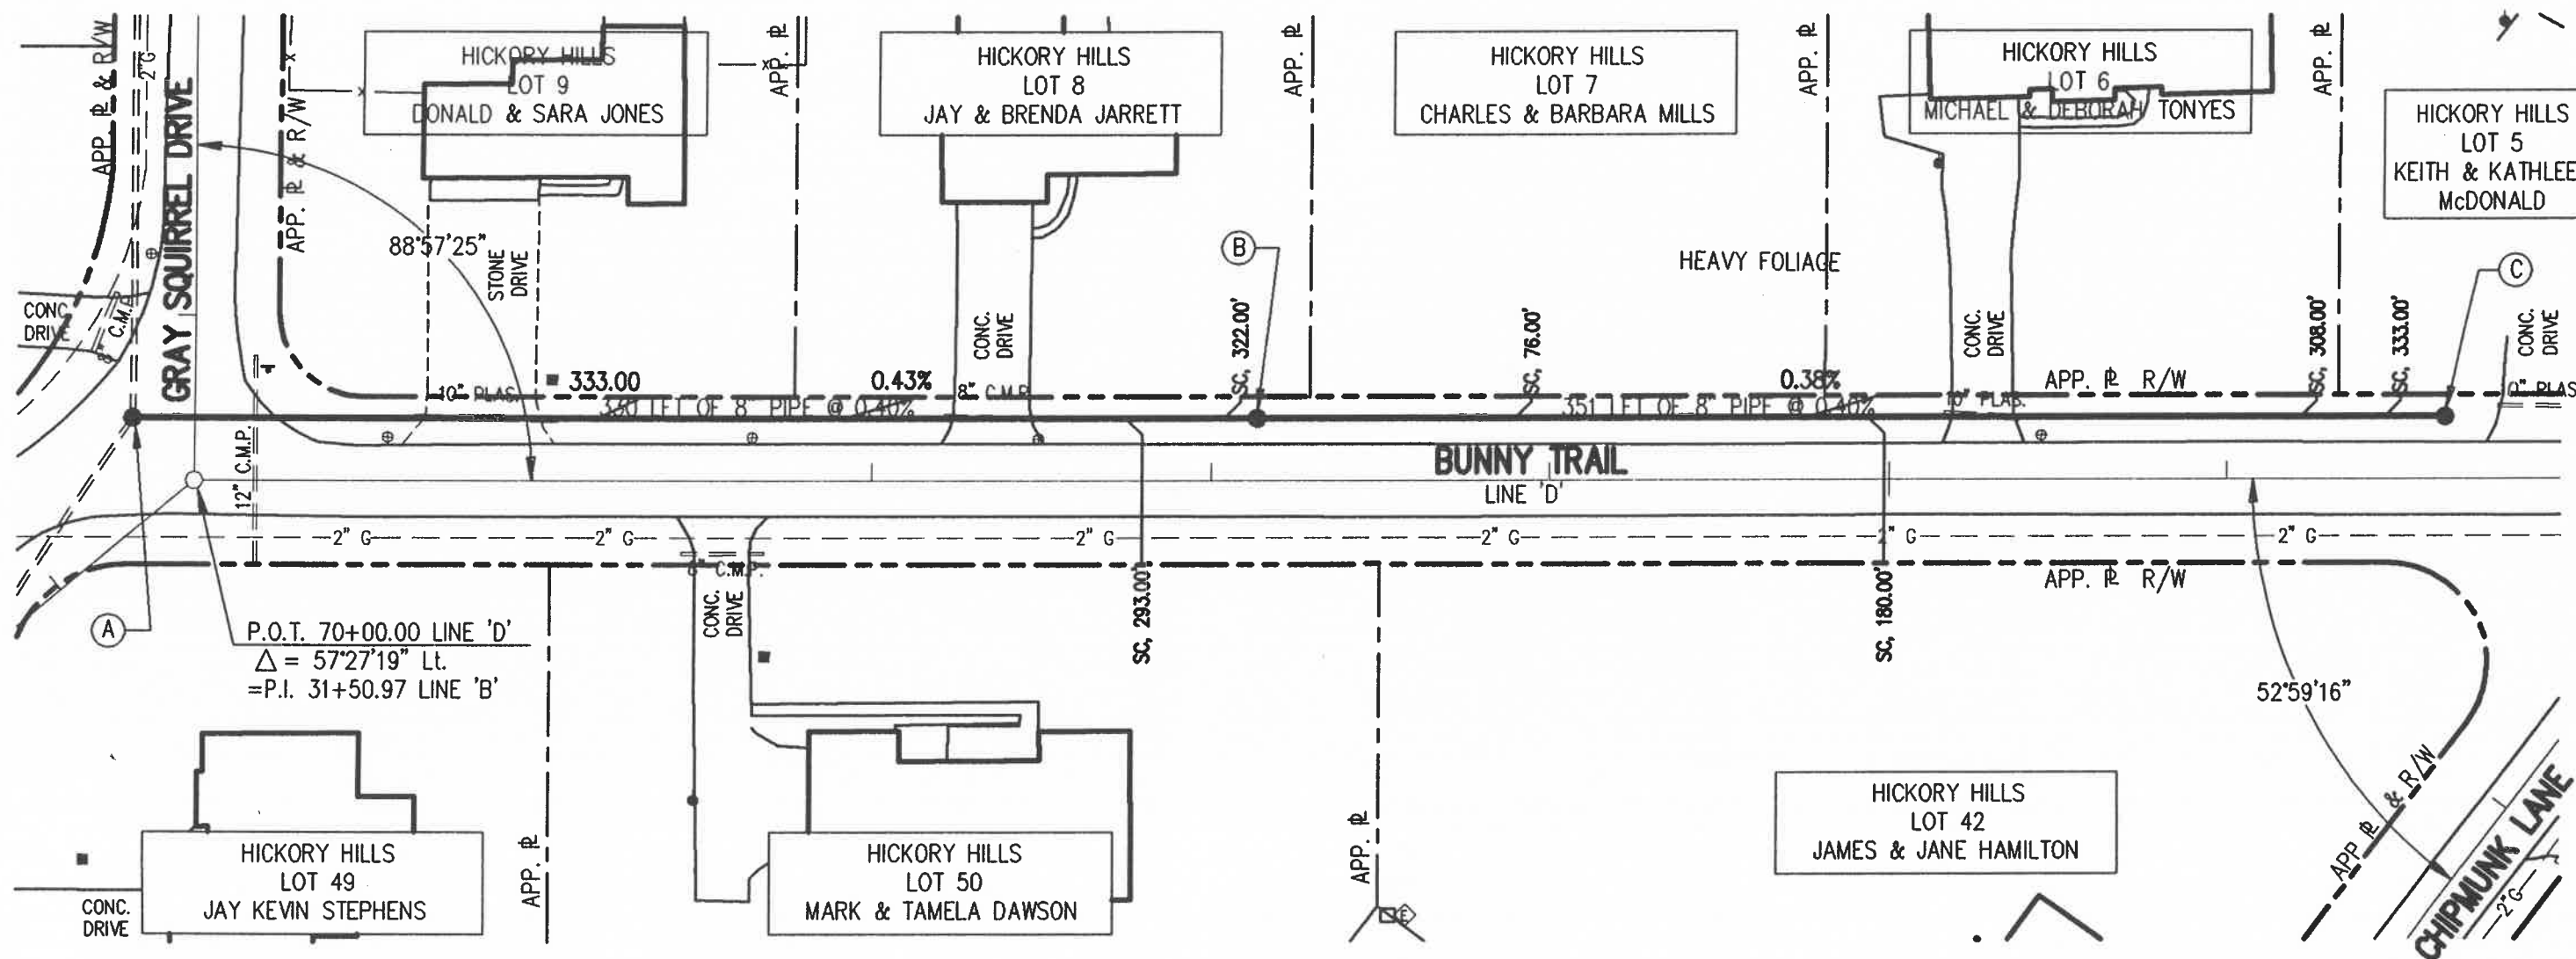

P.O.T. 70+00.00 LINE 'D'
 $\Delta = 57^{\circ}27'19''$ Lt.
= P.I. 31+50.97 LINE 'B'

AS-BUILT NOTES:

1. ALL LATERAL LOCATIONS ARE FROM CENTER
OF CASTING OF DOWN STREAM M.H.

AS-BUILT INFORMATION

SCALE: 1" = 50'



**TRIAD
ASSOCIATES
INC.**

INDIANAPOLIS, INDIANA



**FALL CREEK REGIONAL
WASTE DISTRICT**
HICKORY HILLS SUBDIVISION
CONTRACT 'II'
SHEET No. 7a OF 13


INDEX SA-1

KEYNOTES

- (A) STRUCTURE No. 13
T.C. = 882.13
INV.(NE) = 874.03
INV. ϕ = 870.41
- (B) STRUCTURE No. 13a
T.C. = 883.43
INV. ϕ = 876.43

LEGEND:

- | | | | |
|-------|---------------------------|-------------|---|
| ===== | EXISTING DRAINAGE CULVERT | --- W --- | WATER LINE |
| ● | PROPOSED SANITARY MANHOLE | --- G --- | GAS LINE |
| --- | PROPOSED SANITARY SEWER | ⊙ | EXISTING UTILITY POLE W/GUY |
| ▲ | EXISTING SIGN | ⊙ | EXISTING UTILITY POLE |
| ⊕ | EXISTING MAILBOX | ⊙ W | WATER WELL |
| --- | RIGHT OF WAY | ⊙ | EXISTING ELECTRIC TRANSFORMER |
| --- | PROPERTY LINE | SC, 301.50' | AS-BUILT LATERAL LOCATION
(CONTRACT II SEWER LATERALS ARE
4 TO 5 FEET DEEP AT R/W LINE) |
| -x- | EXISTING FENCE LINE | | |

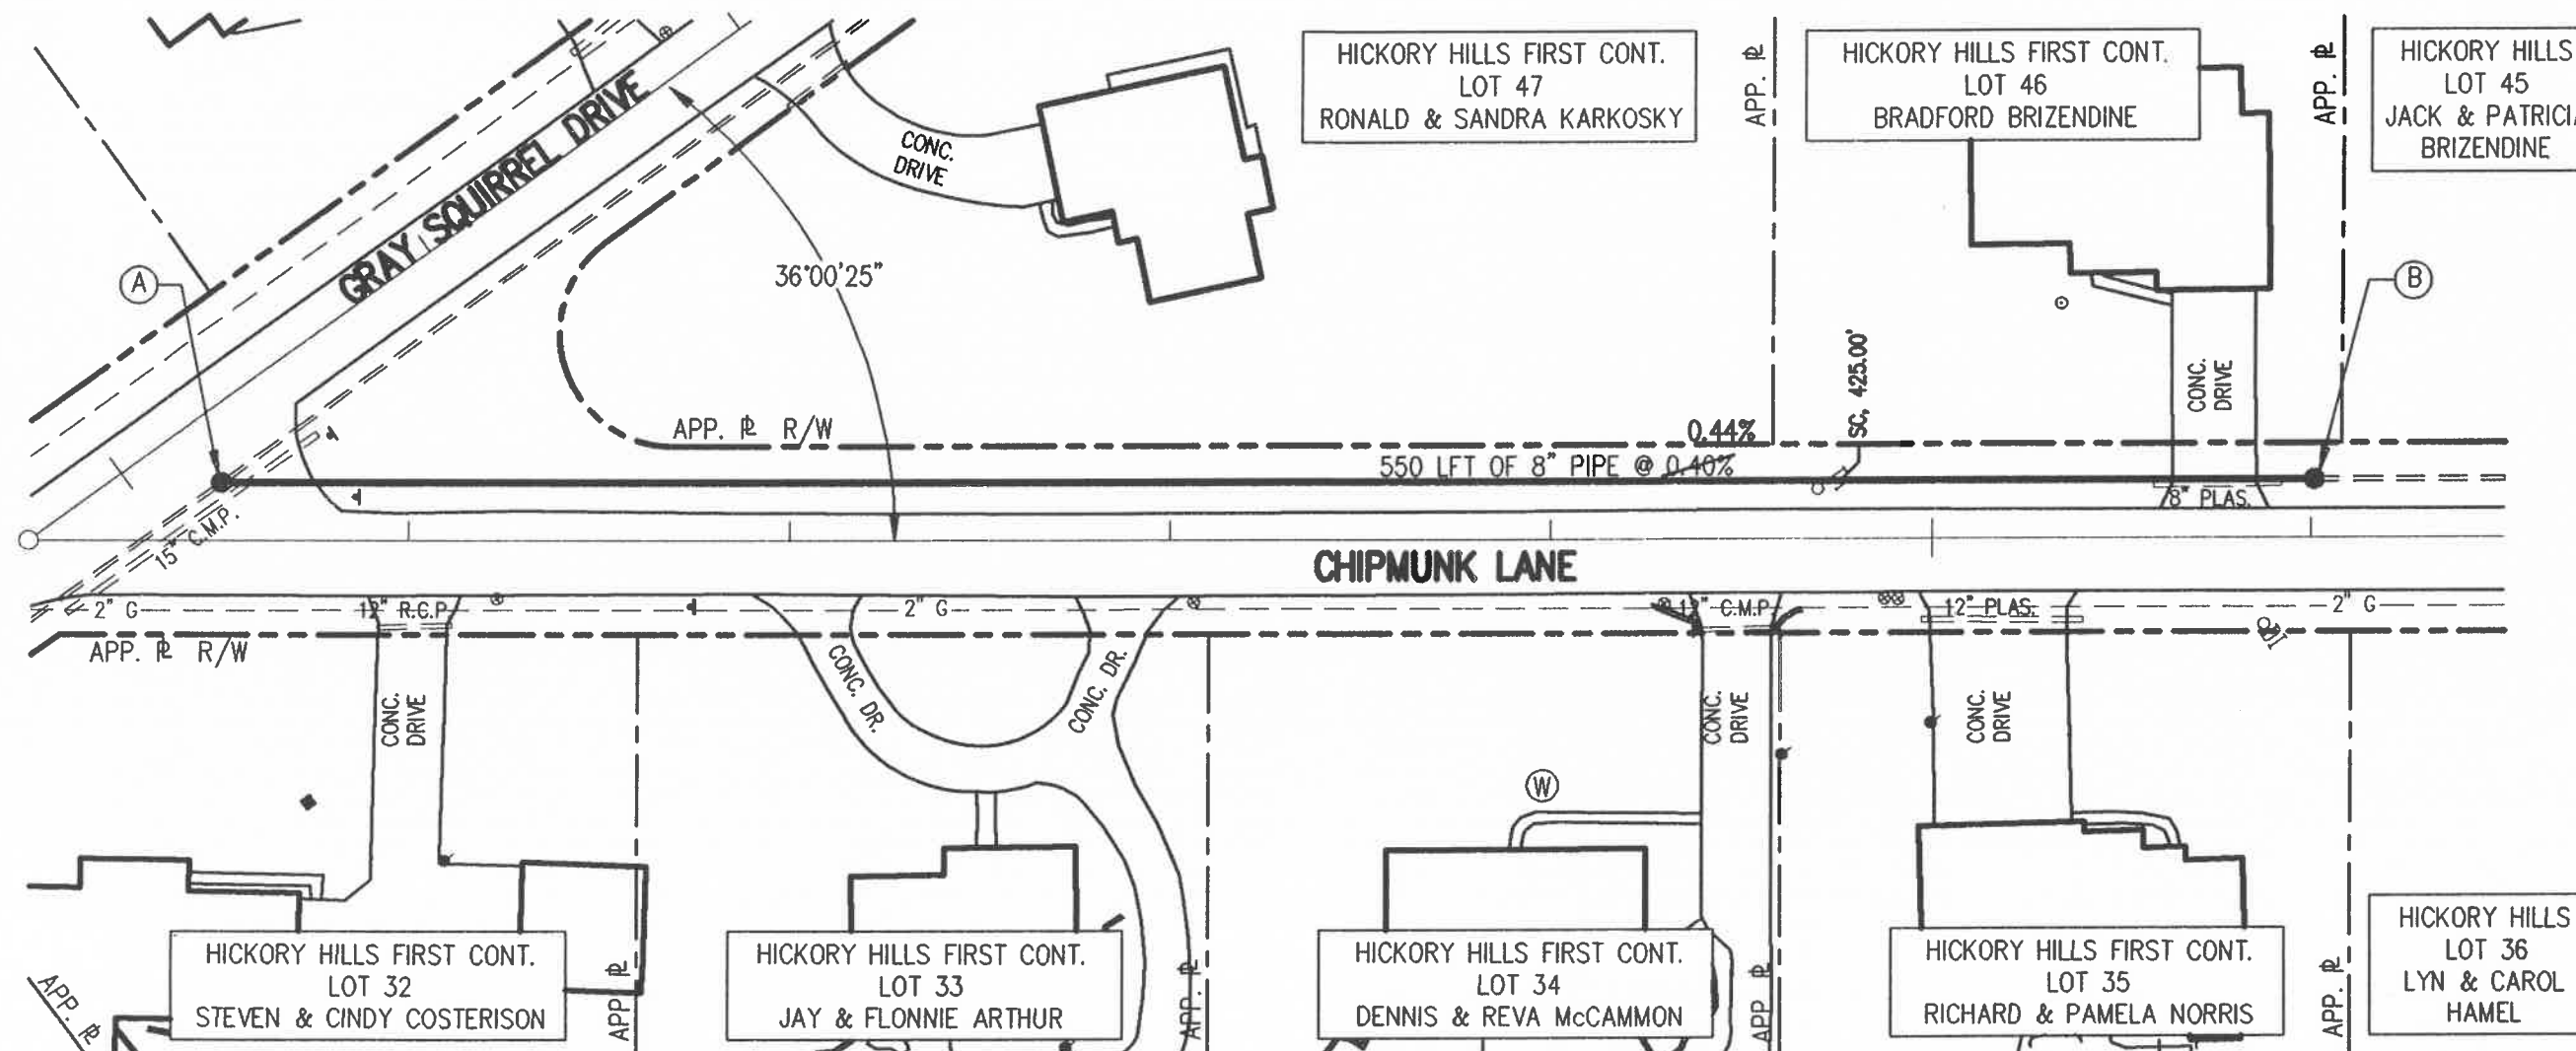

AS-BUILT NOTES:

- ALL LATERAL LOCATIONS ARE FROM CENTER OF CASTING OF DOWN STREAM M.H.

AS-BUILT INFORMATION

SCALE: 1" = 50'



**TRIAD
ASSOCIATES
INC.**
INDIANAPOLIS, INDIANA

FALL CREEK REGIONAL WASTE DISTRICT

HICKORY HILLS SUBDIVISION CONTRACT 'I'

SHEET No. 8a OF 13

INDEX SA-1




SCALE: 1" = 50'

KEYNOTES

- (A) STRUCTURE No. 21
TC = 868.75
INV. ℓ = 854.37
- (B) STRUCTURE No. 22
TC = 862.35
INV. ℓ = 855.86


LEGEND:

- | | | | |
|-------|---------------------------|-------------|---|
| ===== | EXISTING DRAINAGE CULVERT | --- W --- | WATER LINE |
| ● | PROPOSED SANITARY MANHOLE | --- G --- | GAS LINE |
| — | PROPOSED SANITARY SEWER | — | EXISTING UTILITY POLE W/GUY |
| ▲ | EXISTING SIGN | — | EXISTING UTILITY POLE |
| ⊗ | EXISTING MAILBOX | ⊗ | WATER WELL |
| --- | RIGHT OF WAY | ⊞ | EXISTING ELECTRIC TRANSFORMER |
| --- | PROPERTY LINE | SC, 301.50' | AS-BUILT LATERAL LOCATION
(CONTRACT II SEWER LATERALS ARE
4 TO 5 FEET DEEP AT R/W LINE) |
| -x- | EXISTING FENCE LINE | | |

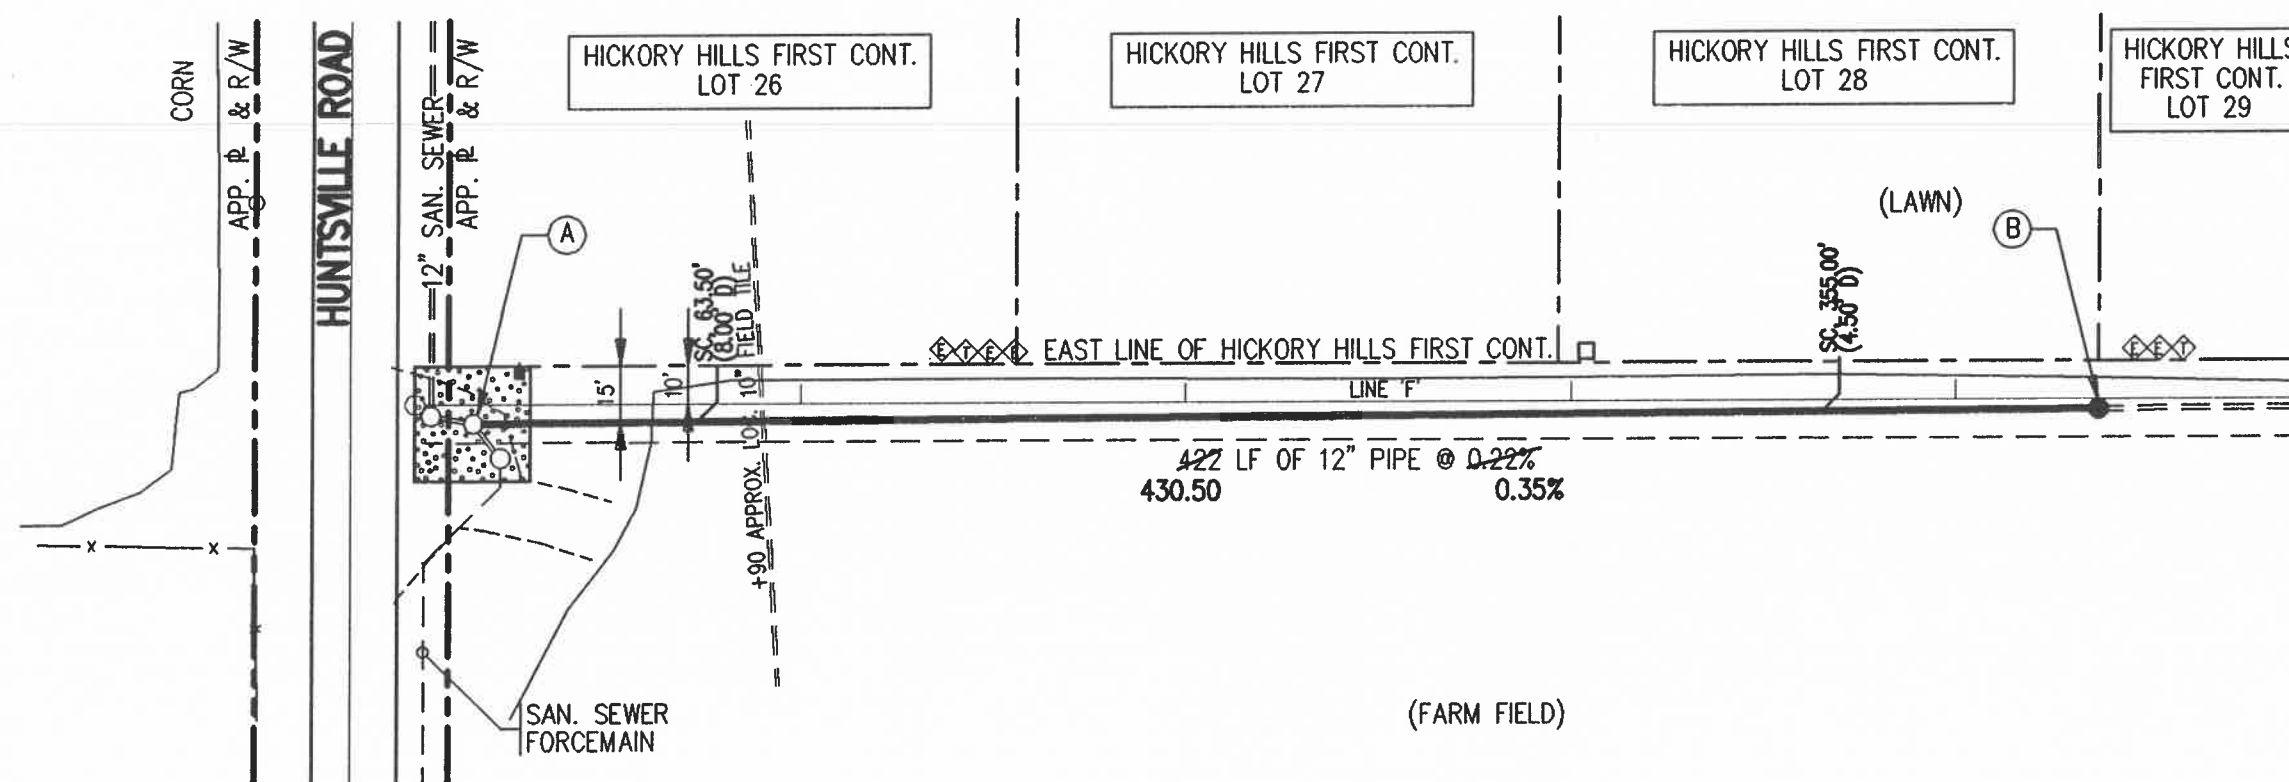

AS-BUILT NOTES:

- ALL LATERAL LOCATIONS ARE FROM CENTER OF CASTING OF DOWN STREAM M.H.

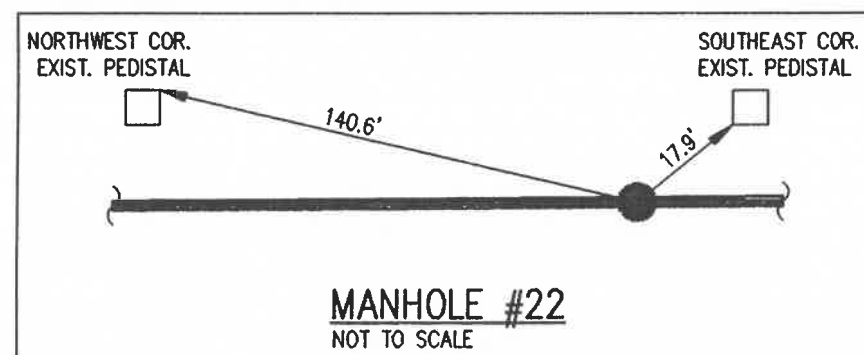

AS-BUILT INFORMATION

SCALE: 1" = 50'



NORTH

**TRIAD
ASSOCIATES
INC.**

INDIANAPOLIS, INDIANA



FALL CREEK REGIONAL WASTE DISTRICT

HICKORY HILLS SUBDIVISION
CONTRACT 'I'

SHEET No. 8b OF 13

INDEX SA-1




SCALE: 1" = 50'

KEYNOTES

- (A) STRUCTURE No. 22
TC = 862.35
INV. ℓ = 855.86
- (B) STRUCTURE No. 23
TC = 864.22
INV. ℓ = 858.01


LEGEND:

- | | | | |
|-------|---------------------------|-------------|---|
| ===== | EXISTING DRAINAGE CULVERT | --- W --- | WATER LINE |
| ● | PROPOSED SANITARY MANHOLE | --- G --- | GAS LINE |
| — | PROPOSED SANITARY SEWER | ⊙ | EXISTING UTILITY POLE W/GUY |
| ▲ | EXISTING SIGN | ⊙ | EXISTING UTILITY POLE |
| ⊕ | EXISTING MAILBOX | ⊙ | WATER WELL |
| --- | RIGHT OF WAY | ⊙ | EXISTING ELECTRIC TRANSFORMER |
| --- | PROPERTY LINE | SC, 301.50' | AS-BUILT LATERAL LOCATION
(CONTRACT II SEWER LATERALS ARE
4 TO 5 FEET DEEP AT R/W LINE) |
| —x— | EXISTING FENCE LINE | | |

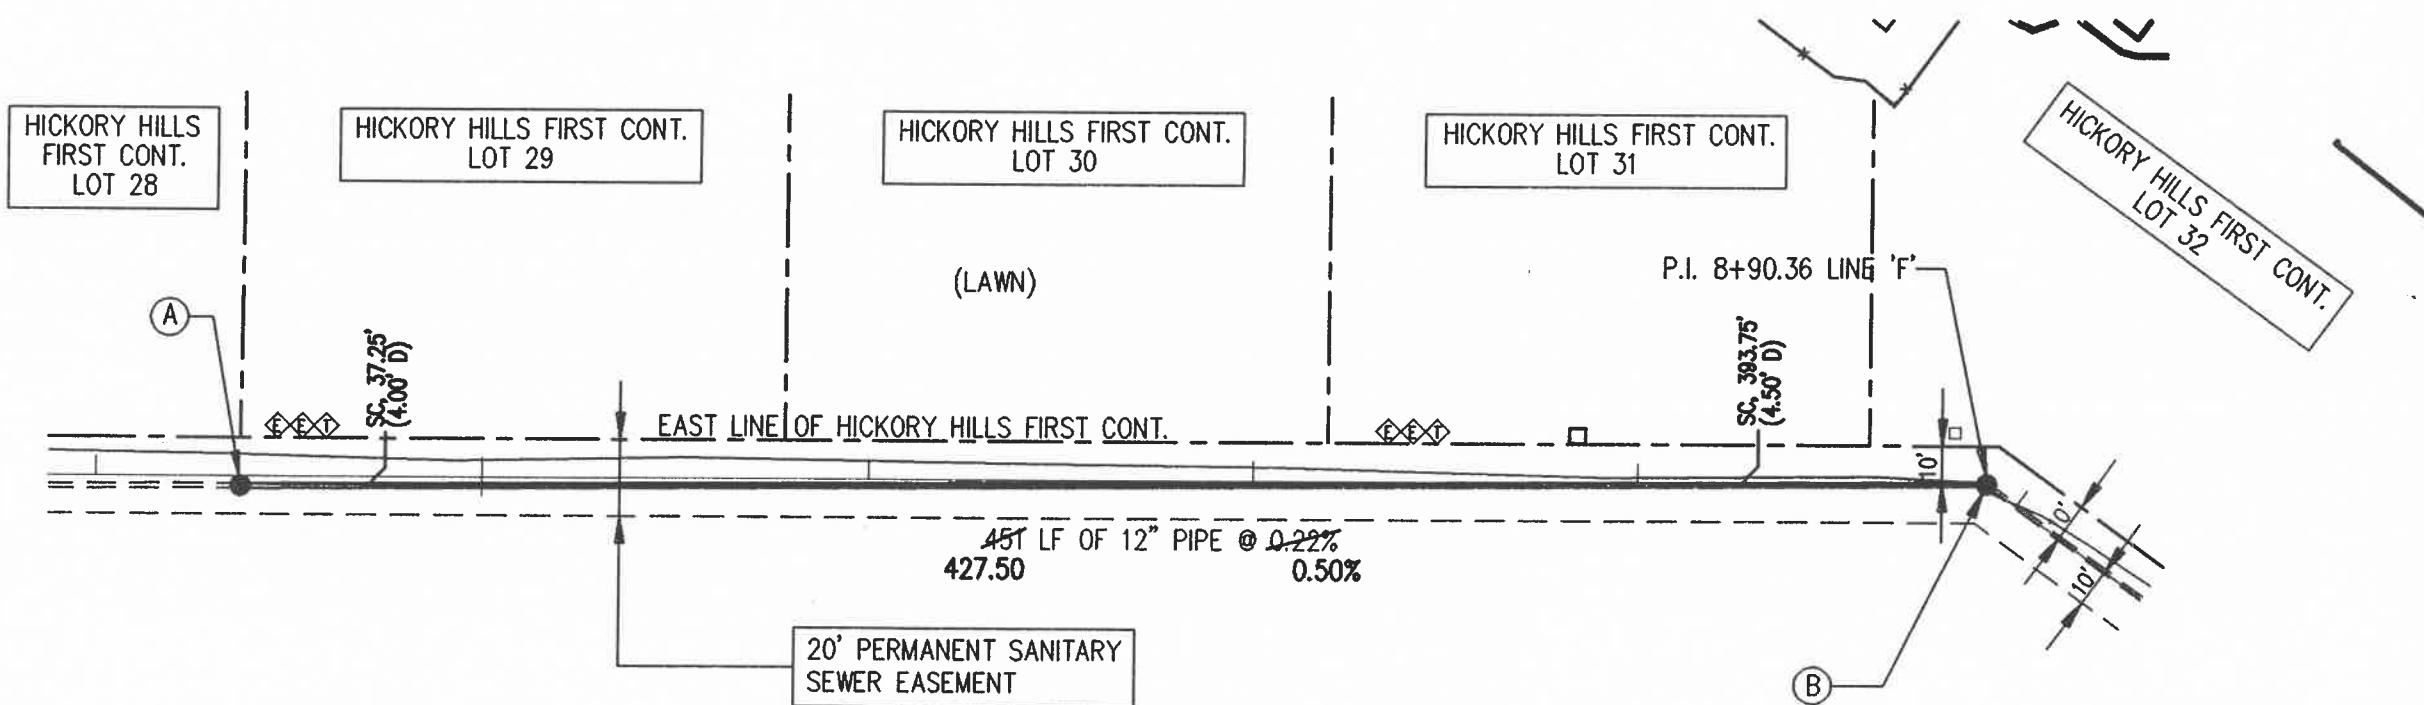

AS-BUILT NOTES:

- ALL LATERAL LOCATIONS ARE FROM CENTER OF CASTING OF DOWN STREAM M.H.

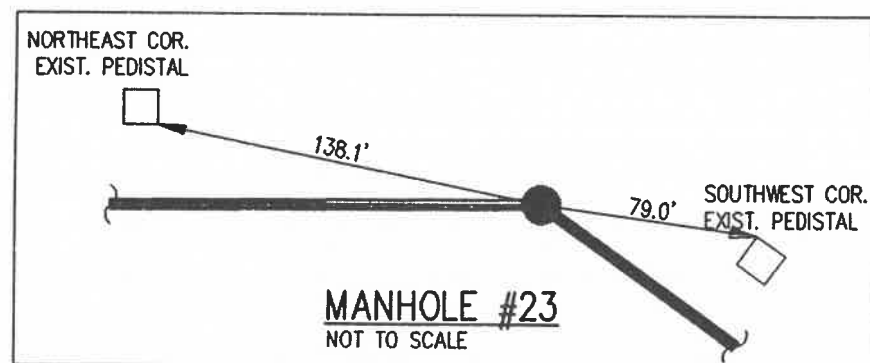

AS-BUILT INFORMATION

SCALE: 1" = 50'



TRIAD
ASSOCIATES
INC.


INDIANAPOLIS, INDIANA



FALL CREEK REGIONAL
WASTE DISTRICT
HICKORY HILLS SUBDIVISION
CONTRACT 'I'

SHEET No. 8c OF 13

INDEX SA-1

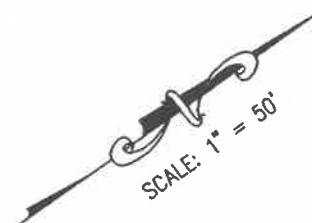


KEYNOTES

- (A) STRUCTURE No. 23
TC = 864.22
INV. ℓ = 858.01
- (B) STRUCTURE No. 24
TC = 865.31
INV. ℓ = 859.96


LEGEND:

- | | | | | | |
|-----|---------------------------|-------------|-----|-----|---|
| --- | EXISTING DRAINAGE CULVERT | --- | W | --- | WATER LINE |
| ● | PROPOSED SANITARY MANHOLE | --- | G | --- | GAS LINE |
| --- | PROPOSED SANITARY SEWER | ● | --- | --- | EXISTING UTILITY POLE W/GUY |
| ▲ | EXISTING SIGN | ▲ | --- | --- | EXISTING UTILITY POLE |
| ⊕ | EXISTING MAILBOX | ⊕ | --- | --- | WATER WELL |
| --- | RIGHT OF WAY | ⊕ | --- | --- | EXISTING ELECTRIC TRANSFORMER |
| --- | PROPERTY LINE | SC, 301.50' | --- | --- | AS-BUILT LATERAL LOCATION
(CONTRACT II SEWER LATERALS ARE
4 TO 5 FEET DEEP AT R/W LINE) |
| --- | EXISTING FENCE LINE | | | | |

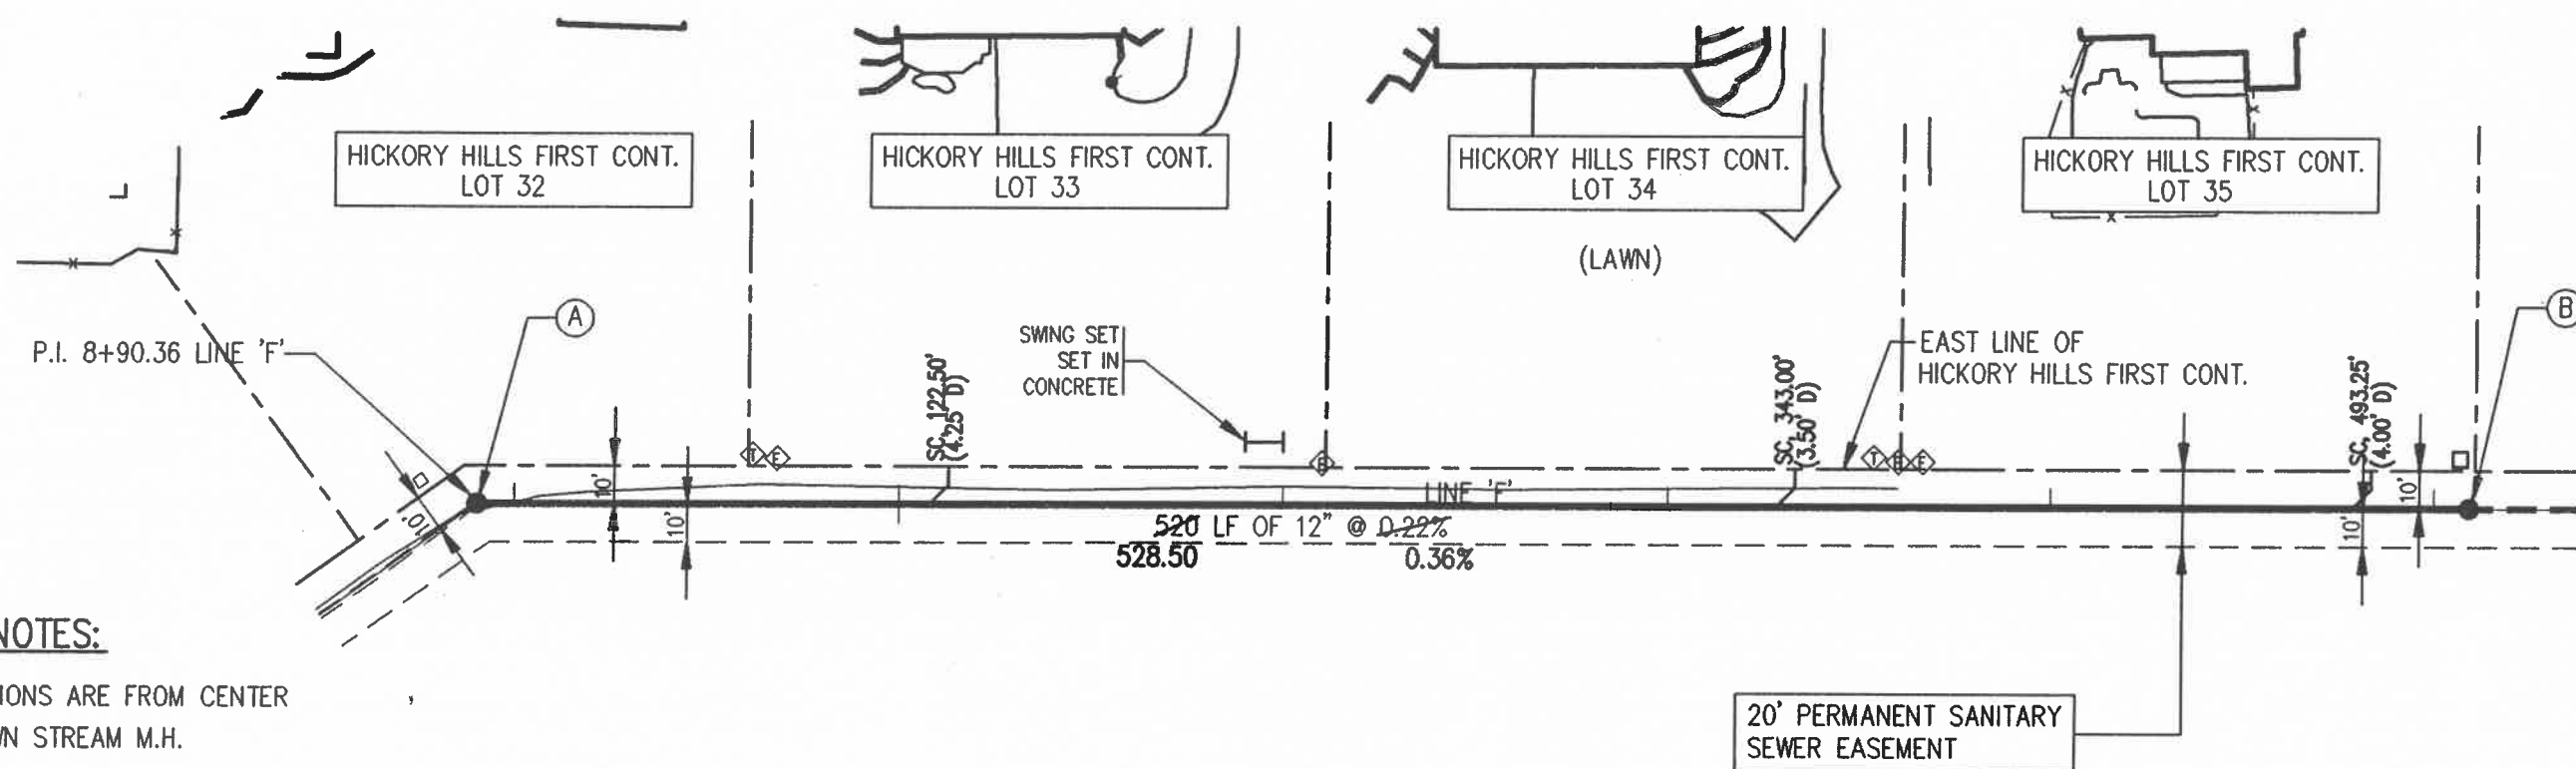

AS-BUILT NOTES:

1. ALL LATERAL LOCATIONS ARE FROM CENTER OF CASTING OF DOWN STREAM M.H.

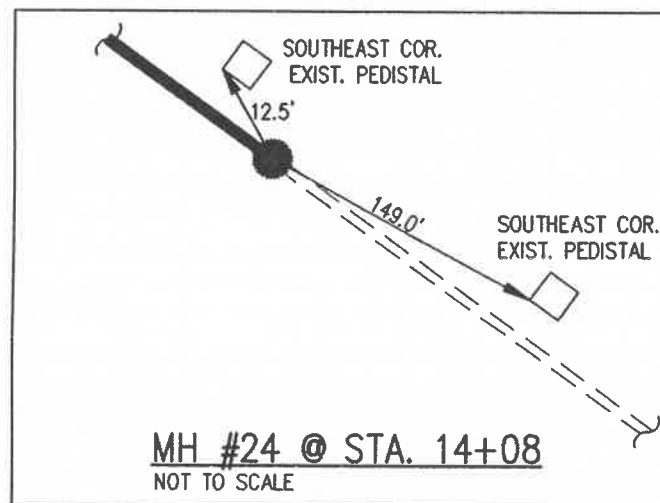

AS-BUILT INFORMATION

SCALE: 1" = 50'



TRIAD
ASSOCIATES
INC.

INDIANAPOLIS, INDIANA



**FALL CREEK REGIONAL
WASTE DISTRICT
HICKORY HILLS SUBDIVISION
CONTRACT 'I'**

SHEET No. 9a OF 13


INDEX SA-1

KEYNOTES

- (A) STRUCTURE No. 24
TC = 865.31
INV. ℓ = 859.96
- (B) STRUCTURE No. 25
TC = 865.67
INV. ℓ = 861.32

LEGEND:


- | | | | |
|-----------|---------------------------|-------------|---|
| --- -- | EXISTING DRAINAGE CULVERT | --- W --- | WATER LINE |
| ● | PROPOSED SANITARY MANHOLE | --- G --- | GAS LINE |
| — — — — — | PROPOSED SANITARY SEWER | ⊙ | EXISTING UTILITY POLE W/GUY |
| ▲ | EXISTING SIGN | ⊙ | EXISTING UTILITY POLE |
| ⊕ | EXISTING MAILBOX | ⊙ | WATER WELL |
| — — — — — | RIGHT OF WAY | ⊙ | EXISTING ELECTRIC TRANSFORMER |
| — — — — — | PROPERTY LINE | SC, 301.50' | AS-BUILT LATERAL LOCATION
(CONTRACT II SEWER LATERALS ARE
4 TO 5 FEET DEEP AT R/W LINE) |
| — x — | EXISTING FENCE LINE | | |

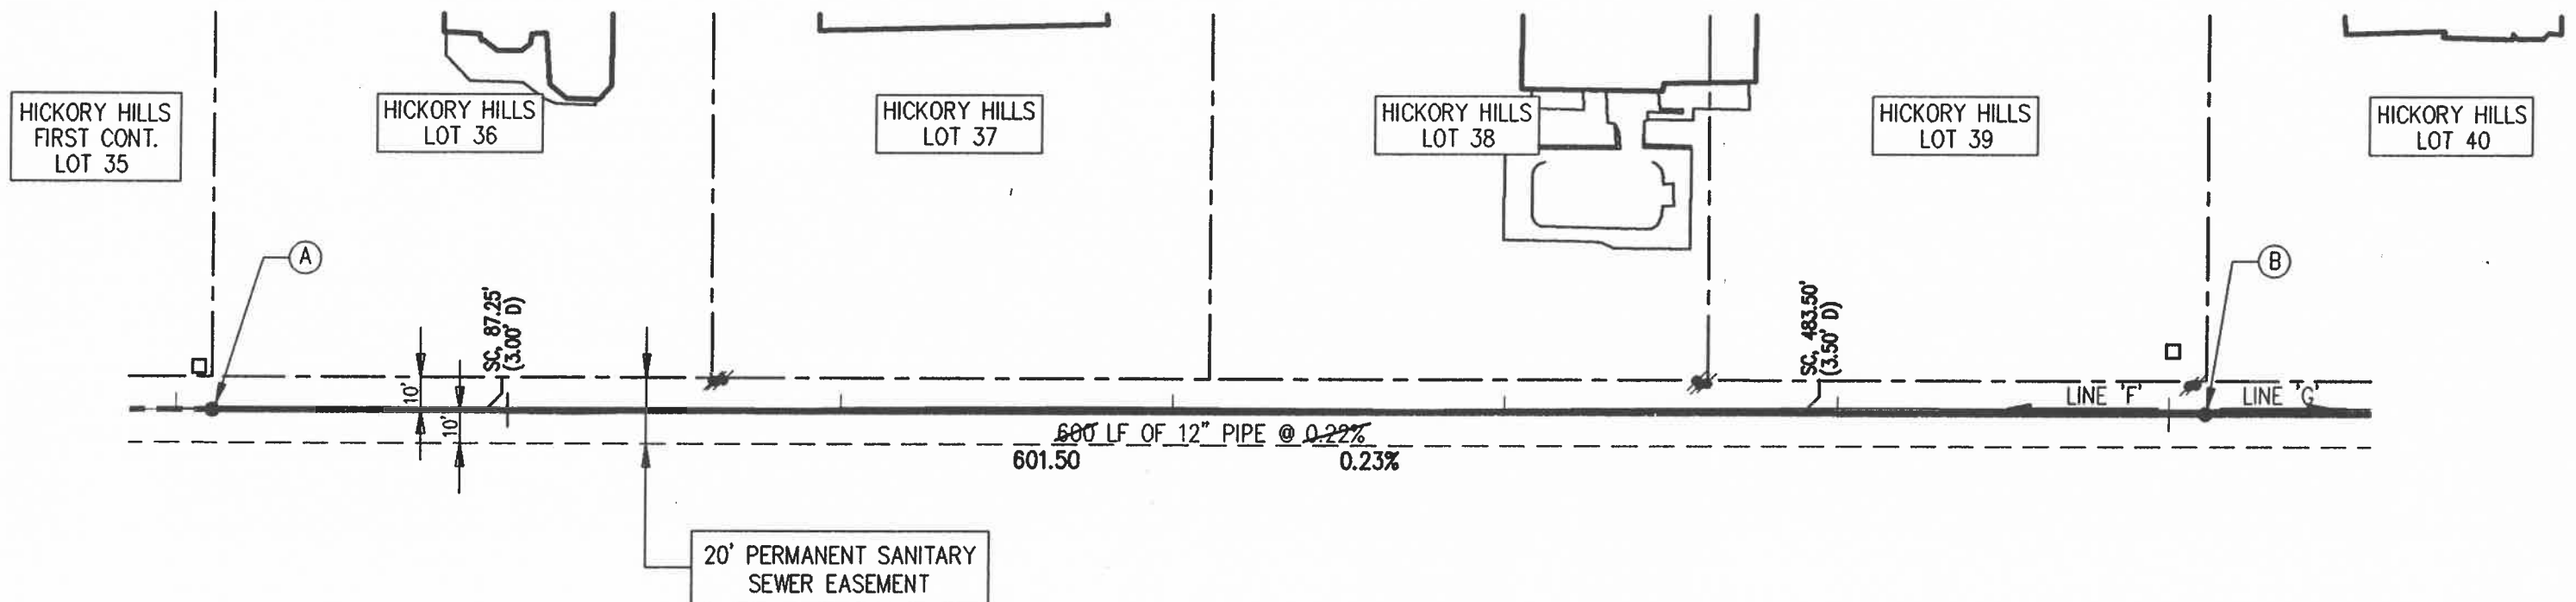

(FARM FIELD)

AS-BUILT NOTES:

- ALL LATERAL LOCATIONS ARE FROM CENTER OF CASTING OF DOWN STREAM M.H.

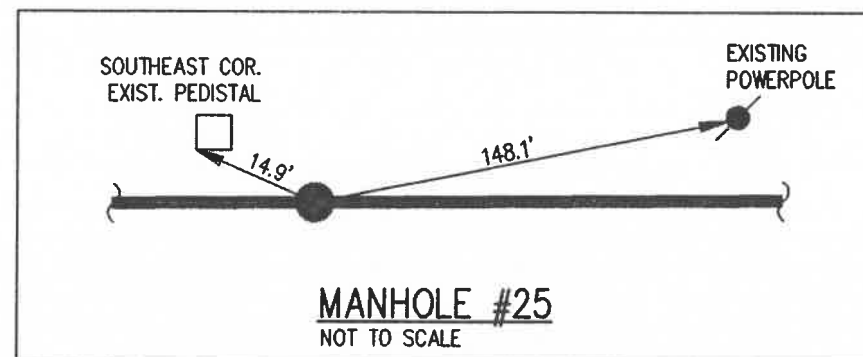

AS-BUILT INFORMATION

SCALE: 1" = 50'




**TRIAD
ASSOCIATES
INC.**
INDIANAPOLIS, INDIANA

FALL CREEK REGIONAL WASTE DISTRICT

HICKORY HILLS SUBDIVISION
CONTRACT 'I'

SHEET No. 9b OF 13

INDEX SA-1

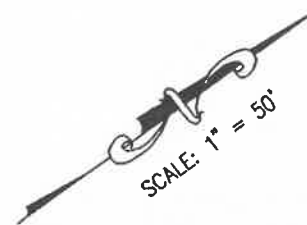


KEYNOTES

- (A) STRUCTURE No. 25
TC = 865.67
INV. ℓ = 861.32
- (B) STRUCTURE No. 26
TC = 866.24
INV. ℓ = 862.63


LEGEND:

- | | | | |
|-------|---------------------------|-------------|---|
| ===== | EXISTING DRAINAGE CULVERT | — W — | WATER LINE |
| ● | PROPOSED SANITARY MANHOLE | — G — | GAS LINE |
| — | PROPOSED SANITARY SEWER | — | EXISTING UTILITY POLE W/GUY |
| ▲ | EXISTING SIGN | — | EXISTING UTILITY POLE |
| ⊕ | EXISTING MAILBOX | ⊙ | WATER WELL |
| --- | RIGHT OF WAY | ⊞ | EXISTING ELECTRIC TRANSFORMER |
| --- | PROPERTY LINE | SC, 301.50' | AS-BUILT LATERAL LOCATION
(CONTRACT II SEWER LATERALS ARE
4 TO 5 FEET DEEP AT R/W LINE) |
| -x- | EXISTING FENCE LINE | | |

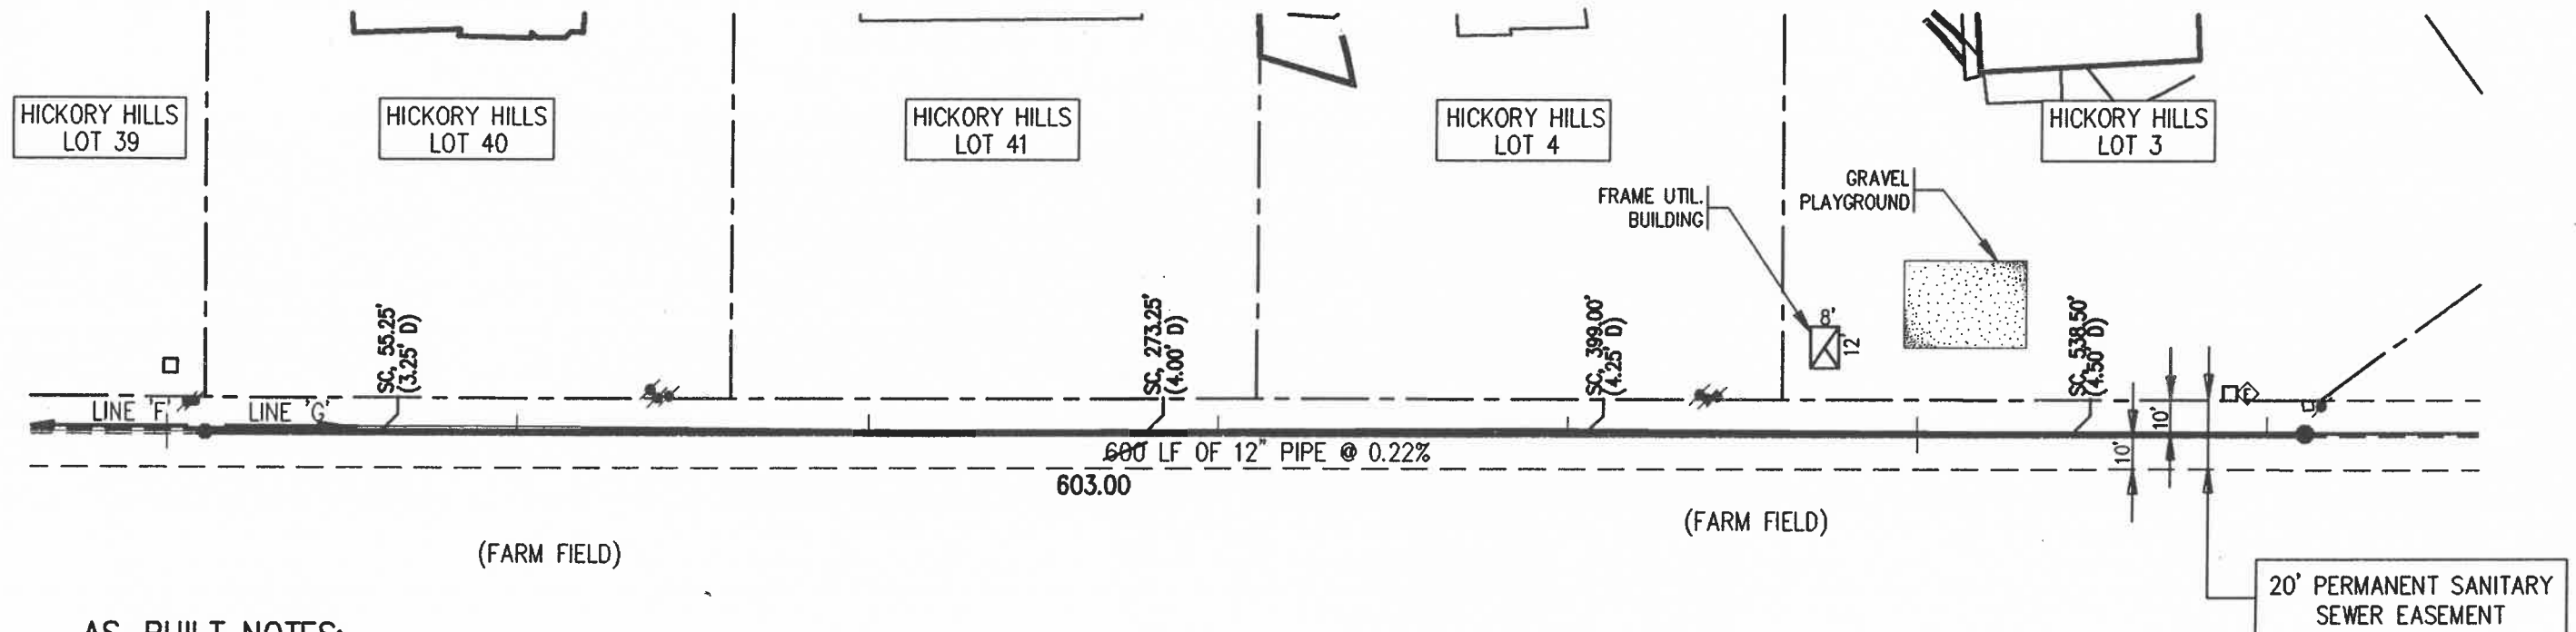

AS-BUILT NOTES:

- ALL LATERAL LOCATIONS ARE FROM CENTER OF CASTING OF DOWN STREAM M.H.

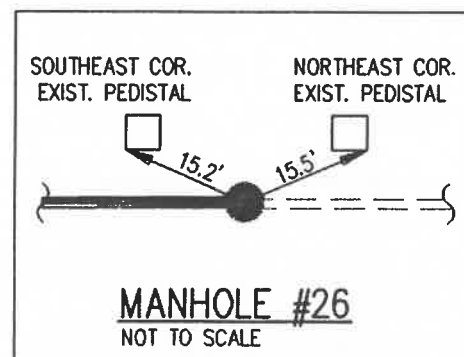

AS-BUILT INFORMATION

SCALE: 1" = 50'



TRIAD
ASSOCIATES
INC.
INDIANAPOLIS, INDIANA

**FALL CREEK REGIONAL
WASTE DISTRICT**
HICKORY HILLS SUBDIVISION
CONTRACT 'I'

SHEET No. 10a OF 13


INDEX SA-1

KEYNOTES

- (A) STRUCTURE No. 26
TC = 866.24
INV. ℓ = 862.63
- (B) STRUCTURE No. 27
TC = 867.40
INV. ℓ = 863.57


LEGEND:

- | | | | |
|-------|---------------------------|-------------|---|
| ===== | EXISTING DRAINAGE CULVERT | — W — | WATER LINE |
| ● | PROPOSED SANITARY MANHOLE | — G — | GAS LINE |
| — | PROPOSED SANITARY SEWER | ⊙ | EXISTING UTILITY POLE W/GUY |
| ▲ | EXISTING SIGN | ⚡ | EXISTING UTILITY POLE |
| ⊕ | EXISTING MAILBOX | ⊙ W | WATER WELL |
| --- | RIGHT OF WAY | ⊞ | EXISTING ELECTRIC TRANSFORMER |
| --- | PROPERTY LINE | SC, 301.50' | AS-BUILT LATERAL LOCATION
(CONTRACT II SEWER LATERALS ARE
4 TO 5 FEET DEEP AT R/W LINE) |
| -x- | EXISTING FENCE LINE | | |

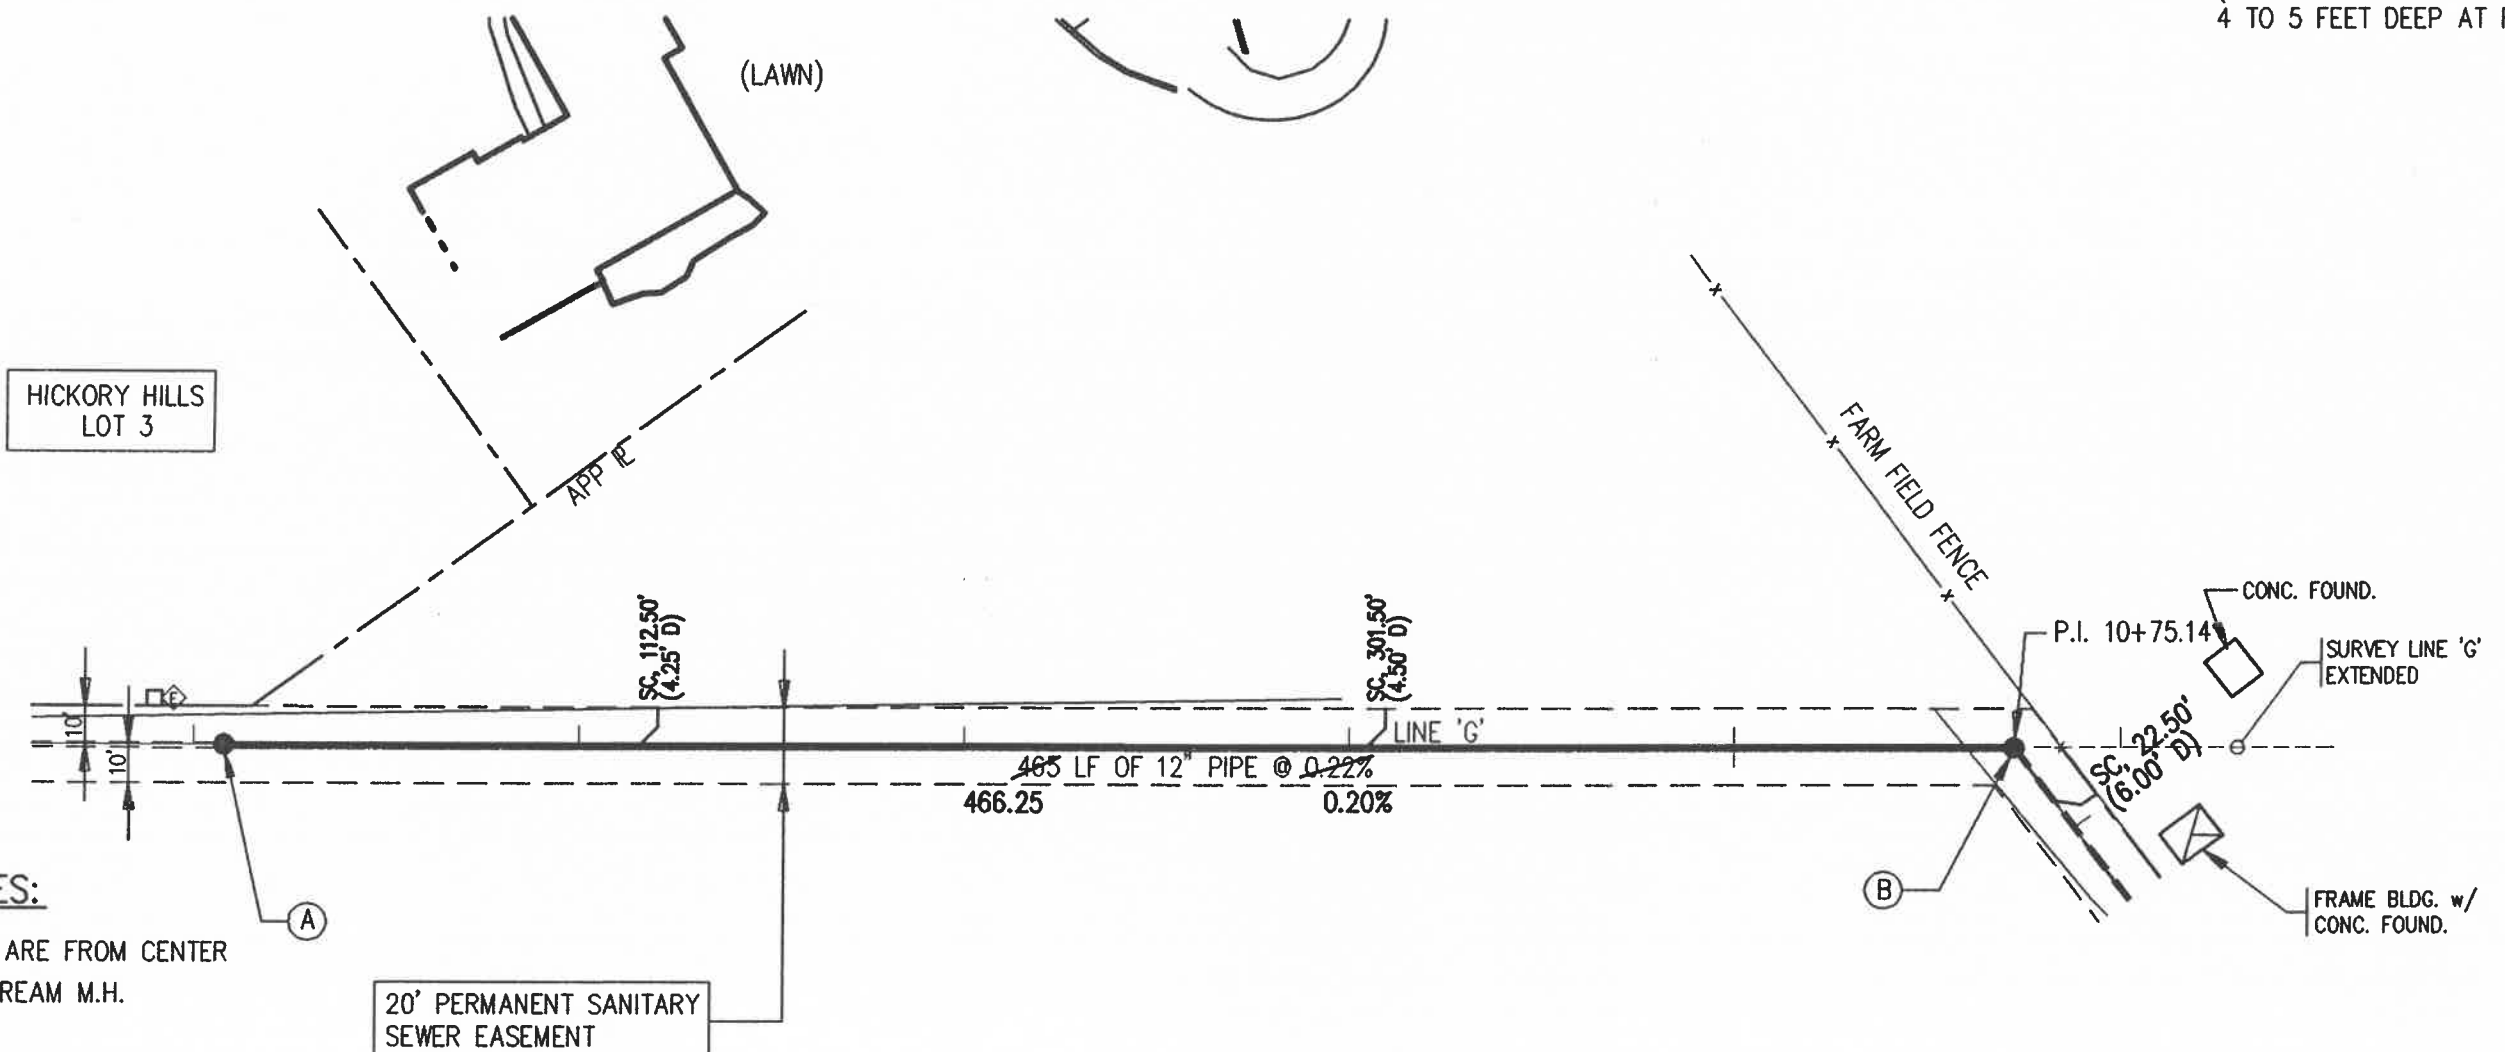

AS-BUILT NOTES:

1. ALL LATERAL LOCATIONS ARE FROM CENTER OF CASTING OF DOWN STREAM M.H.

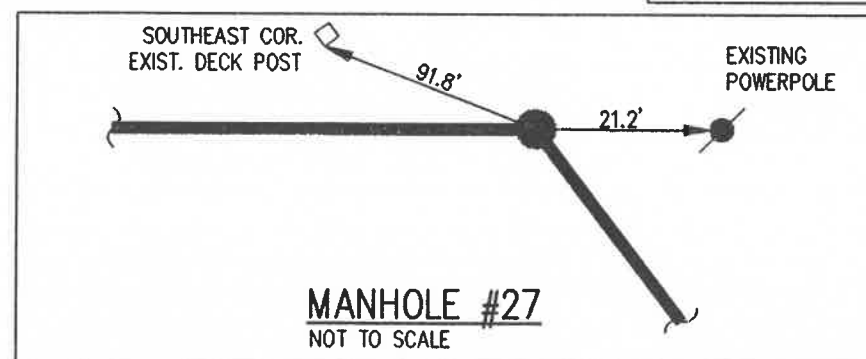

AS-BUILT INFORMATION

SCALE: 1" = 50'



**TRIAD
ASSOCIATES
INC.**
INDIANAPOLIS, INDIANA

FALL CREEK REGIONAL WASTE DISTRICT

HICKORY HILLS SUBDIVISION
CONTRACT 'I'

SHEET No. 10b OF 13


INDEX SA-1

KEYNOTES

- (A) STRUCTURE No. 27
TC = 867.40
INV. ℓ = 863.57
- (B) STRUCTURE No. 28
TC = 867.05
INV. ℓ = 864.08
- (C) STRUCTURE No. 28a
TC = 873.24
INV.(S) = 866.71
INV. ℓ = 866.09
- (D) STRUCTURE No. 30
TC = 887.91
INV. ℓ = 872.95

LEGEND:

- | | | | | |
|-----|---------------------------|-------------|-------|---|
| --- | EXISTING DRAINAGE CULVERT | --- | W --- | WATER LINE |
| ● | PROPOSED SANITARY MANHOLE | --- | G --- | GAS LINE |
| --- | PROPOSED SANITARY SEWER | ●- | | EXISTING UTILITY POLE W/GUY |
| ▲ | EXISTING SIGN | ⚡ | | EXISTING UTILITY POLE |
| ⊕ | EXISTING MAILBOX | (W) | | WATER WELL |
| --- | RIGHT OF WAY | ⊞ | | EXISTING ELECTRIC TRANSFORMER |
| --- | PROPERTY LINE | | | |
| -x- | EXISTING FENCE LINE | | | |
| | | SC, 301.50' | | AS-BUILT LATERAL LOCATION
(CONTRACT II SEWER LATERALS ARE
4 TO 5 FEET DEEP AT R/W LINE) |

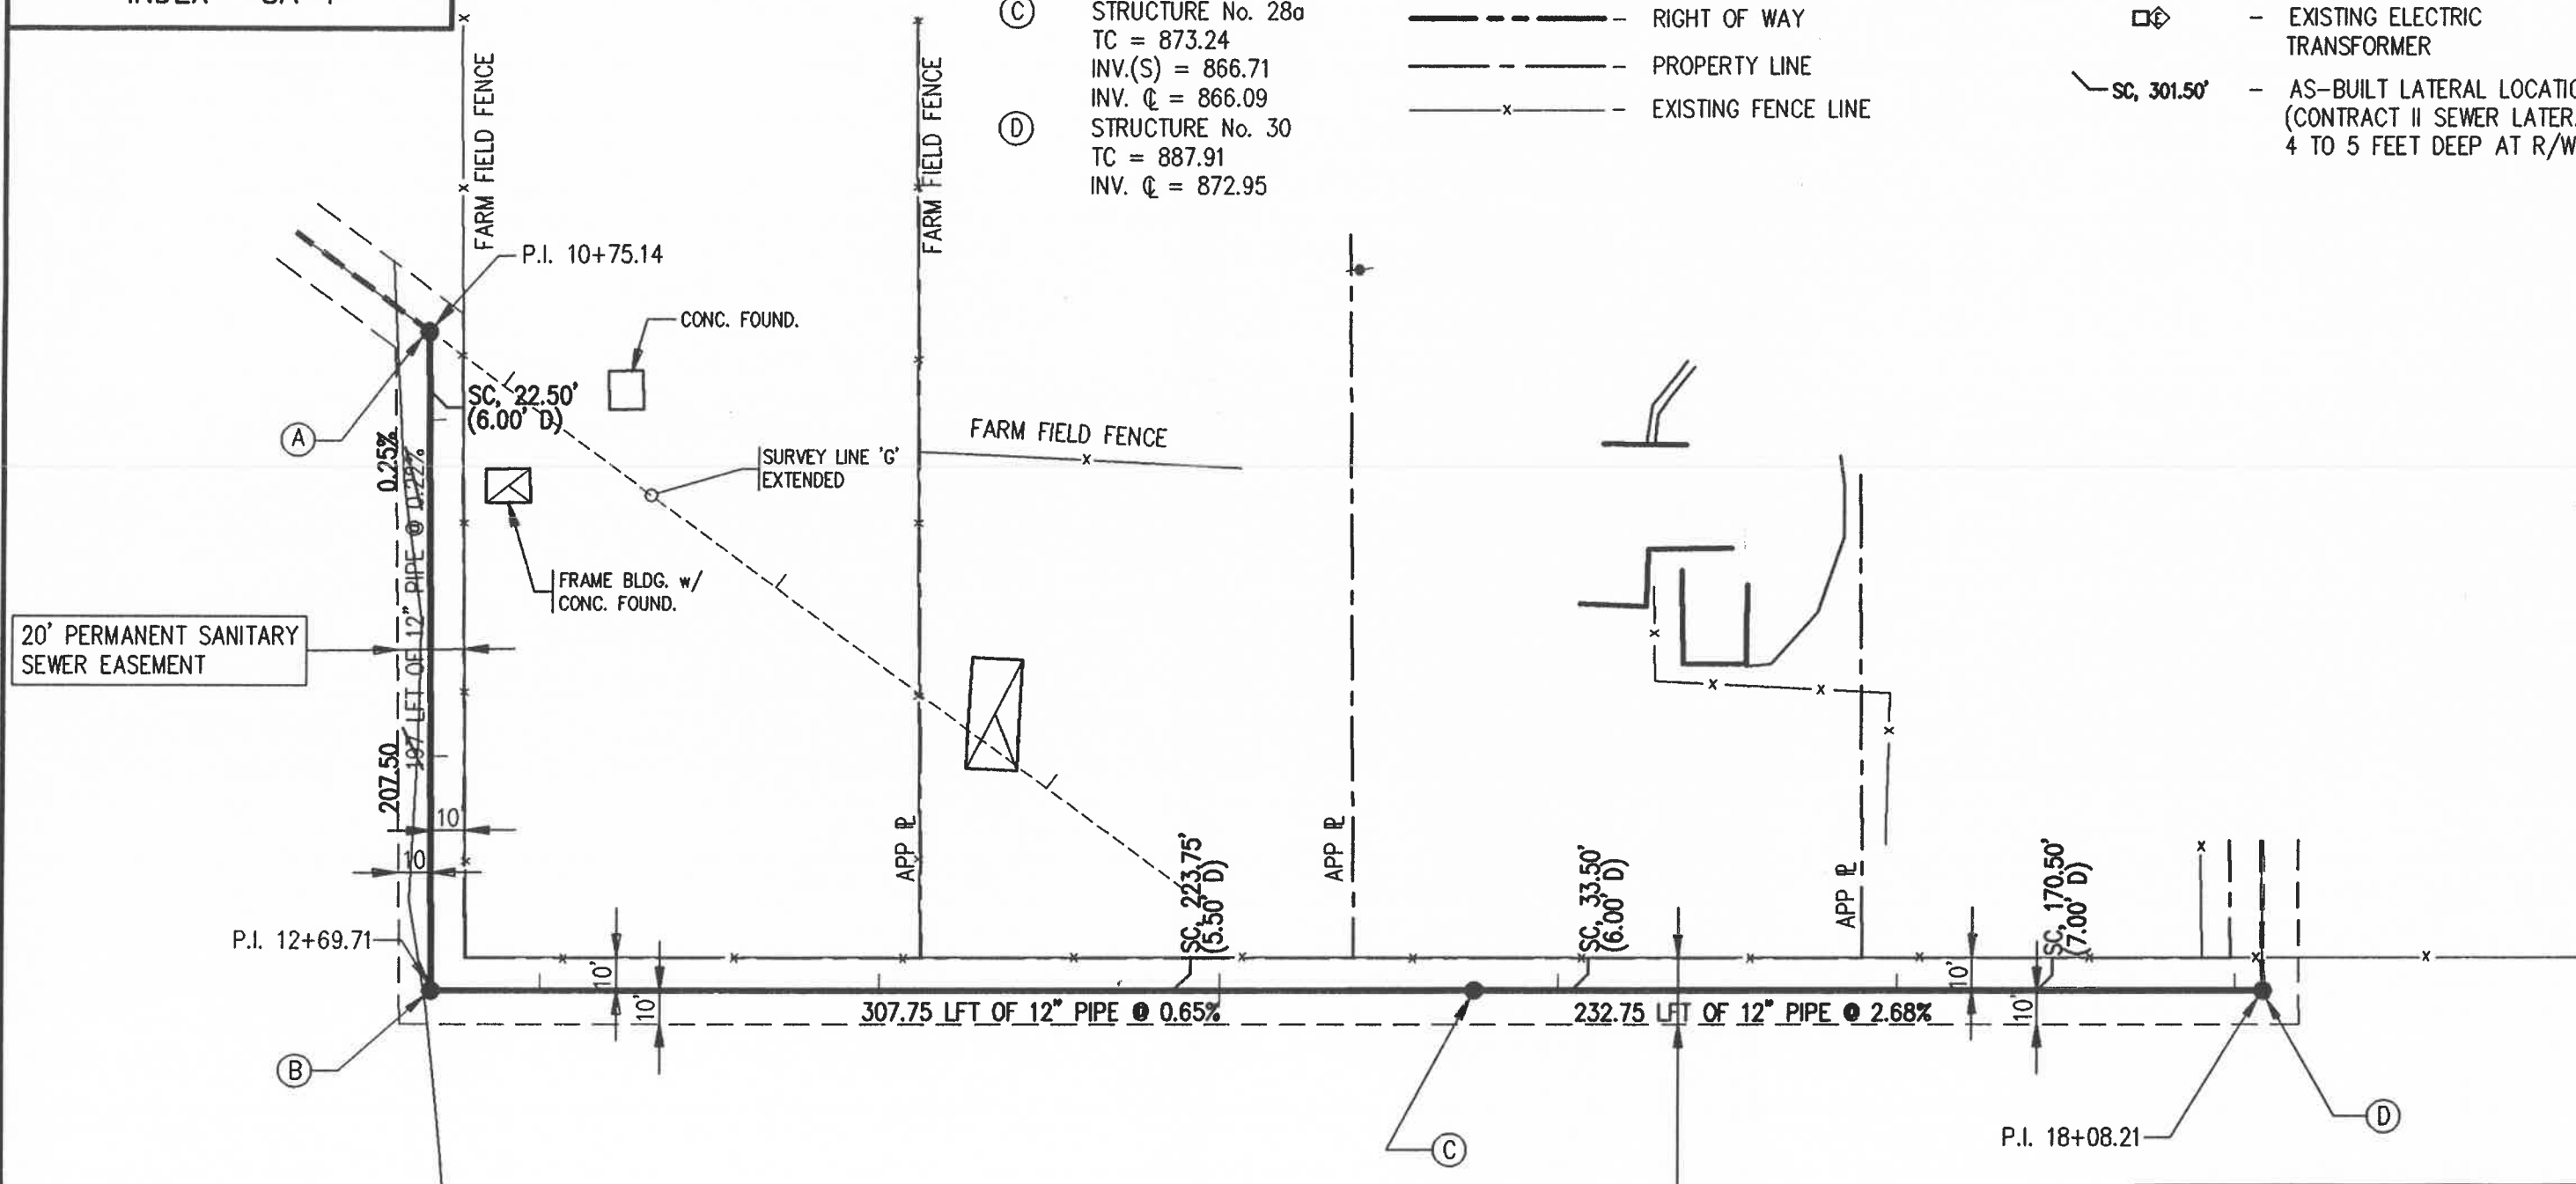

AS-BUILT NOTES:

- ALL LATERAL LOCATIONS ARE FROM CENTER OF CASTING OF DOWN STREAM M.H.

AS-BUILT INFORMATION

SCALE: 1" = 50'



20' PERMANENT SANITARY
SEWER EASEMENT

TRIAD
ASSOCIATES
INC.

INDIANAPOLIS, INDIANA



FALL CREEK REGIONAL WASTE DISTRICT

HICKORY HILLS SUBDIVISION
CONTRACT 'II'

SHEET No. 11 OF 13

INDEX SA-1


SCALE: 1" = 50'

KEYNOTES

- (A) STRUCTURE No. 29
T.C. = 887.91
INV. ℓ = 872.95
- (B) STRUCTURE No. 30
T.C. = 886.11
INV. ℓ = 874.11
- (C) STRUCTURE No. 31
T.C. = 885.50
INV.(N) = 881.44
INV. ℓ = 874.80

LEGEND:

- | | | | |
|-----|---------------------------|-------------|---|
| == | EXISTING DRAINAGE CULVERT | W | WATER LINE |
| ● | PROPOSED SANITARY MANHOLE | G | GAS LINE |
| — | PROPOSED SANITARY SEWER | — | EXISTING UTILITY POLE W/GUY |
| ▲ | EXISTING SIGN | — | EXISTING UTILITY POLE |
| ⊕ | EXISTING MAILBOX | ⊙ | WATER WELL |
| --- | RIGHT OF WAY | ⊞ | EXISTING ELECTRIC TRANSFORMER |
| --- | PROPERTY LINE | SC, 301.50' | AS-BUILT LATERAL LOCATION
(CONTRACT II SEWER LATERALS ARE
4 TO 5 FEET DEEP AT R/W LINE) |
| -x- | EXISTING FENCE LINE | | |

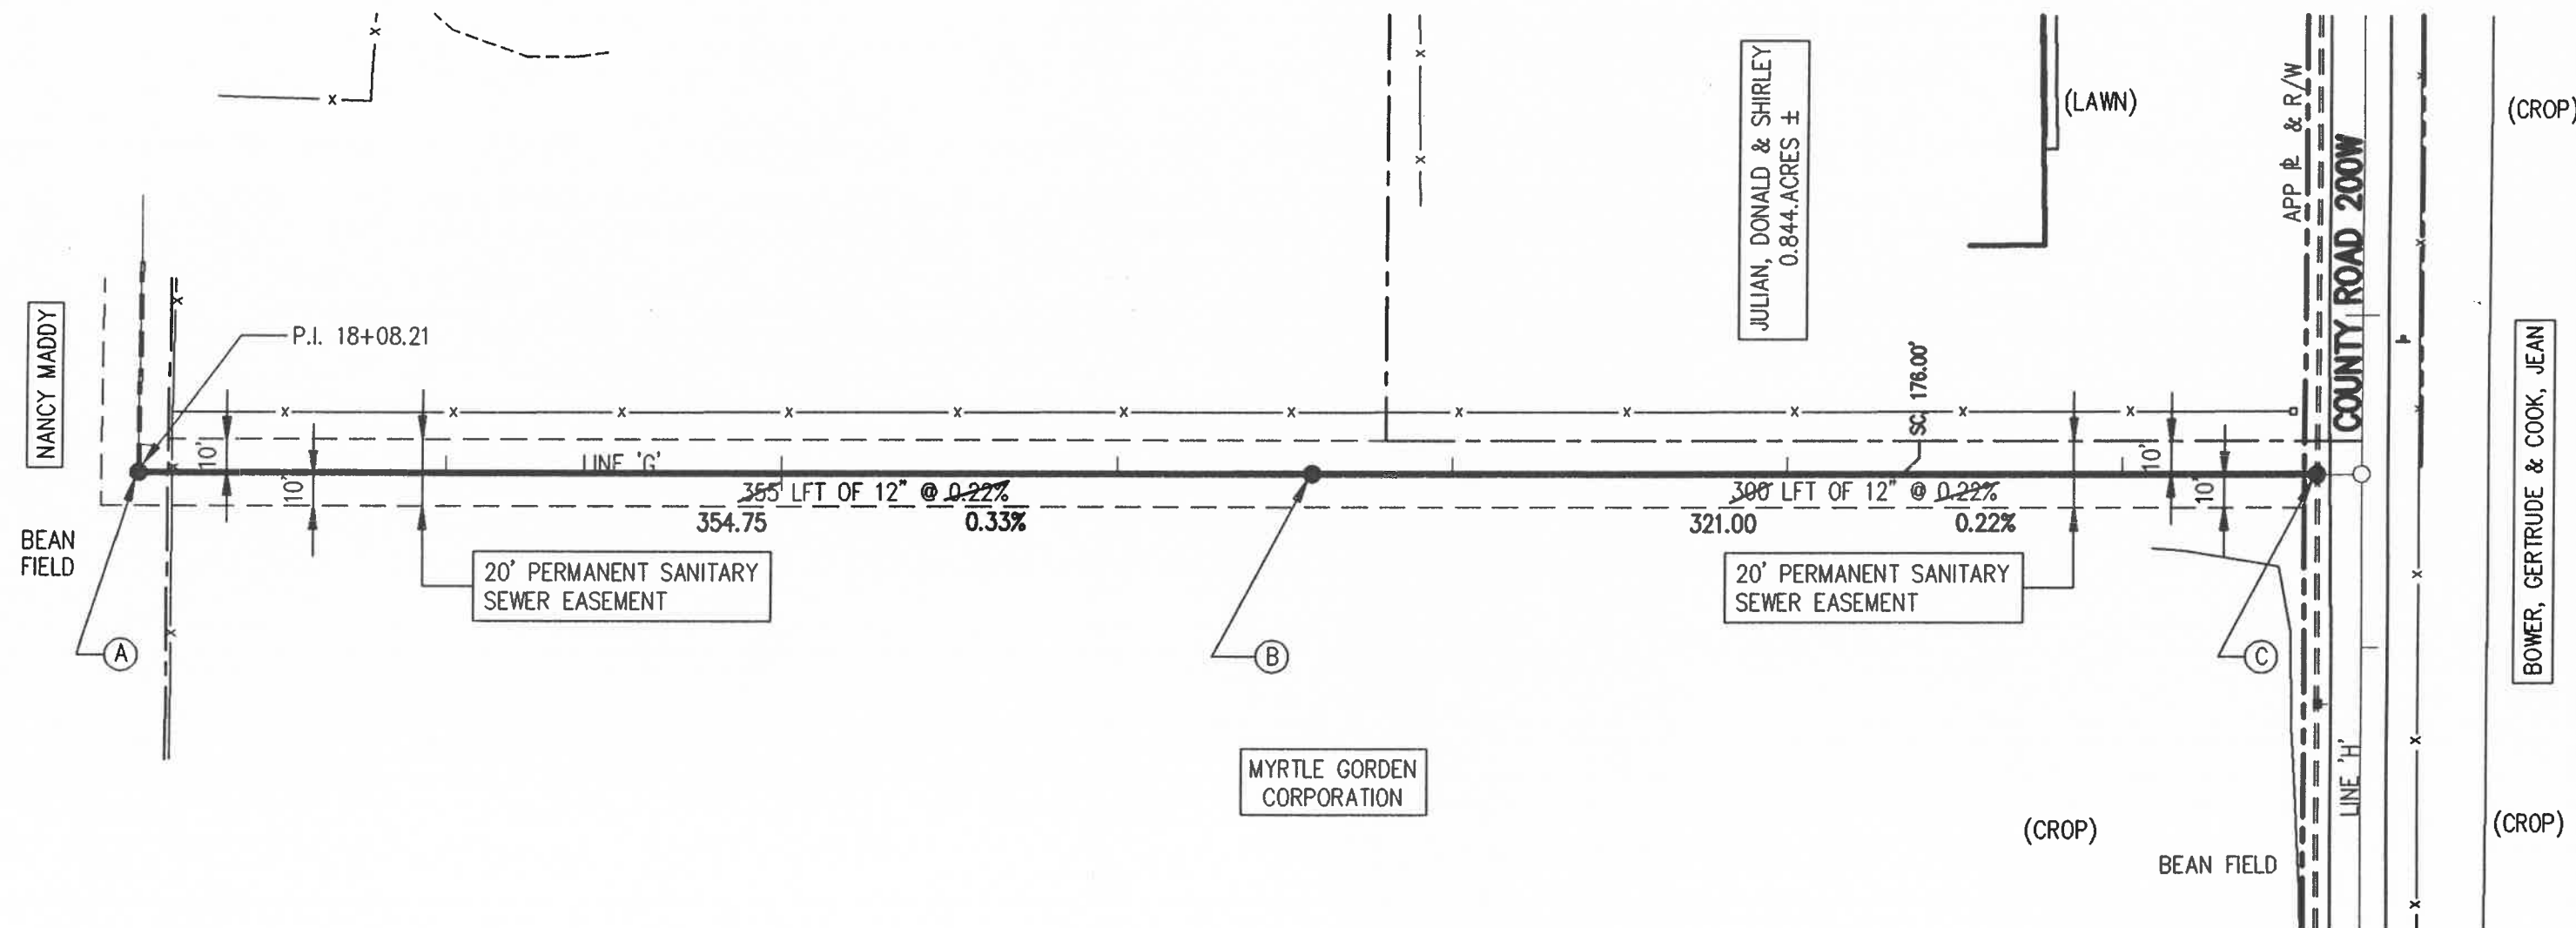

AS-BUILT NOTES:

- ALL LATERAL LOCATIONS ARE FROM CENTER OF CASTING OF DOWN STREAM M.H.

AS-BUILT INFORMATION

SCALE: 1" = 50'



TRIAD
ASSOCIATES
INC.

INDIANAPOLIS, INDIANA



FALL CREEK REGIONAL
WASTE DISTRICT
HICKORY HILLS SUBDIVISION
CONTRACT 'II'
SHEET No. 12a OF 13

INDEX SA-1

KEYNOTES

- (A) STRUCTURE No. 31
T.C. = 885.50
INV.(N) = 881.44
INV. ϕ = 874.80
(B) STRUCTURE No. 31a
T.C. = 889.12
INV. ϕ = 883.02




SCALE: 1" = 50'

LEGEND:

- | | | | | |
|-----|---------------------------|-------------|-------------------------------|---|
| --- | EXISTING DRAINAGE CULVERT | --- | W --- | WATER LINE |
| ● | PROPOSED SANITARY MANHOLE | --- | G --- | GAS LINE |
| --- | PROPOSED SANITARY SEWER | ● | EXISTING UTILITY POLE W/GUY | |
| ▲ | EXISTING SIGN | ▲ | EXISTING UTILITY POLE | |
| ⊕ | EXISTING MAILBOX | (W) | WATER WELL | |
| --- | RIGHT OF WAY | ⊠ | EXISTING ELECTRIC TRANSFORMER | |
| --- | PROPERTY LINE | SC, 301.50' | AS-BUILT LATERAL LOCATION | (CONTRACT II SEWER LATERALS ARE 4 TO 5 FEET DEEP AT R/W LINE) |
| -x- | EXISTING FENCE LINE | | | |

(CROP)

(CROP)

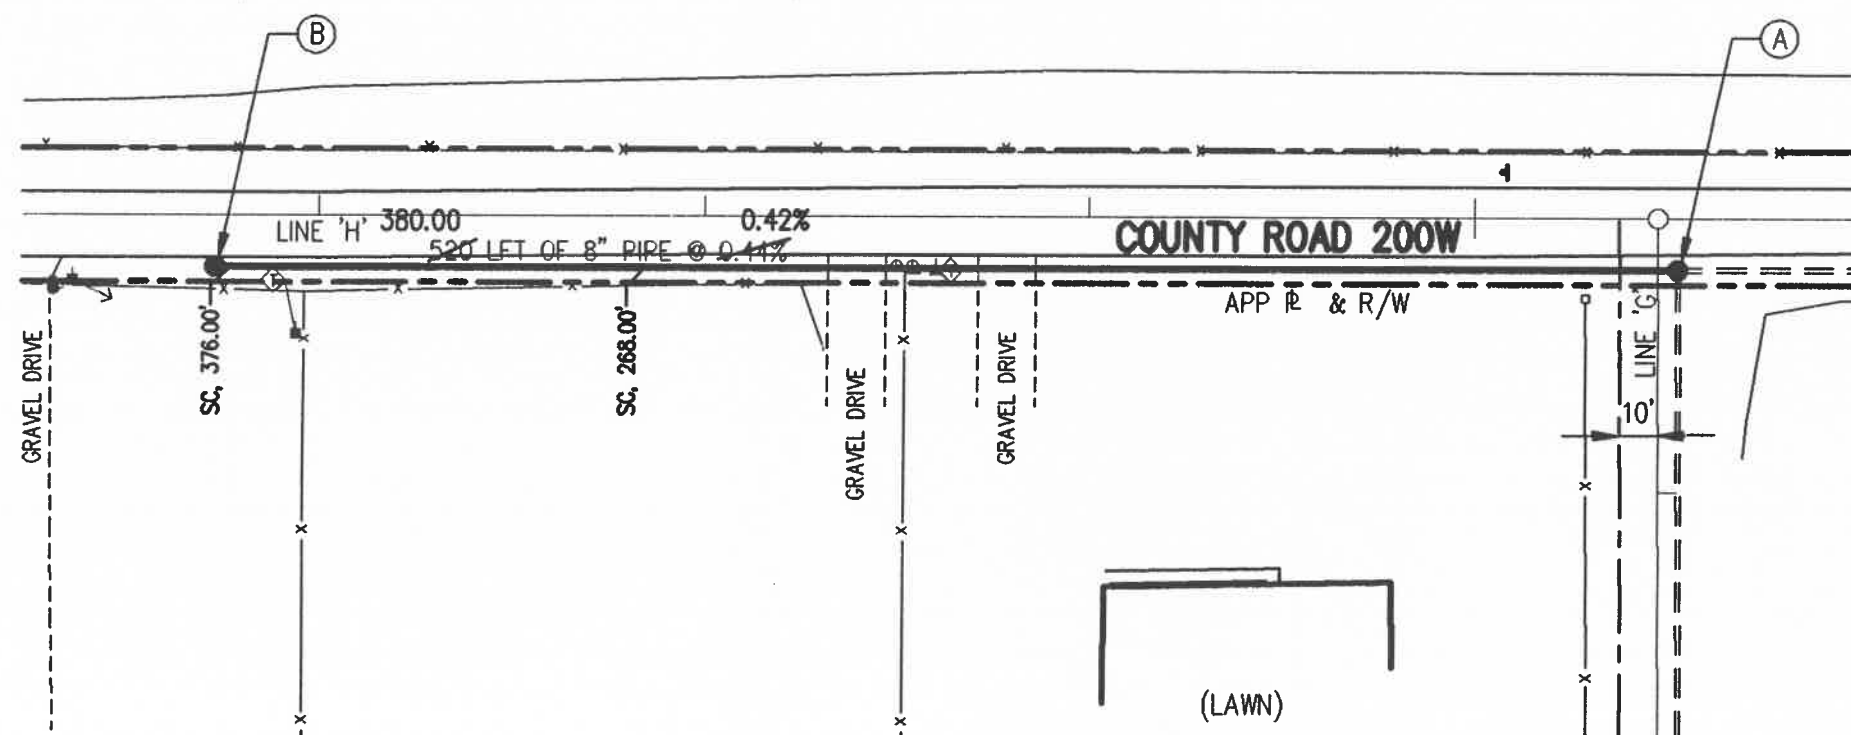

AS-BUILT NOTES:

1. ALL LATERAL LOCATIONS ARE FROM CENTER OF CASTING OF DOWN STREAM M.H.

AS-BUILT INFORMATION

SCALE: 1" = 50'



TRIAD
ASSOCIATES
INC.
INDIANAPOLIS, INDIANA



FALL CREEK REGIONAL
WASTE DISTRICT
HICKORY HILLS SUBDIVISION
CONTRACT 'II'

SHEET No. 12b OF 13


INDEX SA-1

KEYNOTES

- (A) STRUCTURE No. 31
T.C. = 885.50
INV.(N) = 881.44
INV. ϕ = 874.80
- (B) STRUCTURE No. 32
T.C. = 883.62
INV. ϕ = 875.92

LEGEND:

- | | | | |
|-------|---------------------------|-------|-------------------------------|
| ===== | EXISTING DRAINAGE CULVERT | — W — | WATER LINE |
| ● | PROPOSED SANITARY MANHOLE | — G — | GAS LINE |
| ———— | PROPOSED SANITARY SEWER | ⊙ | EXISTING UTILITY POLE W/GUY |
| ▲ | EXISTING SIGN | ⚡ | EXISTING UTILITY POLE |
| ⊕ | EXISTING MAILBOX | ⊙ | WATER WELL |
| ---- | RIGHT OF WAY | ⊞ | EXISTING ELECTRIC TRANSFORMER |
| ---- | PROPERTY LINE | | |
| —x— | EXISTING FENCE LINE | | |
- SC, 301.50' — AS-BUILT LATERAL LOCATION
(CONTRACT II SEWER LATERALS ARE 4 TO 5 FEET DEEP AT R/W LINE)

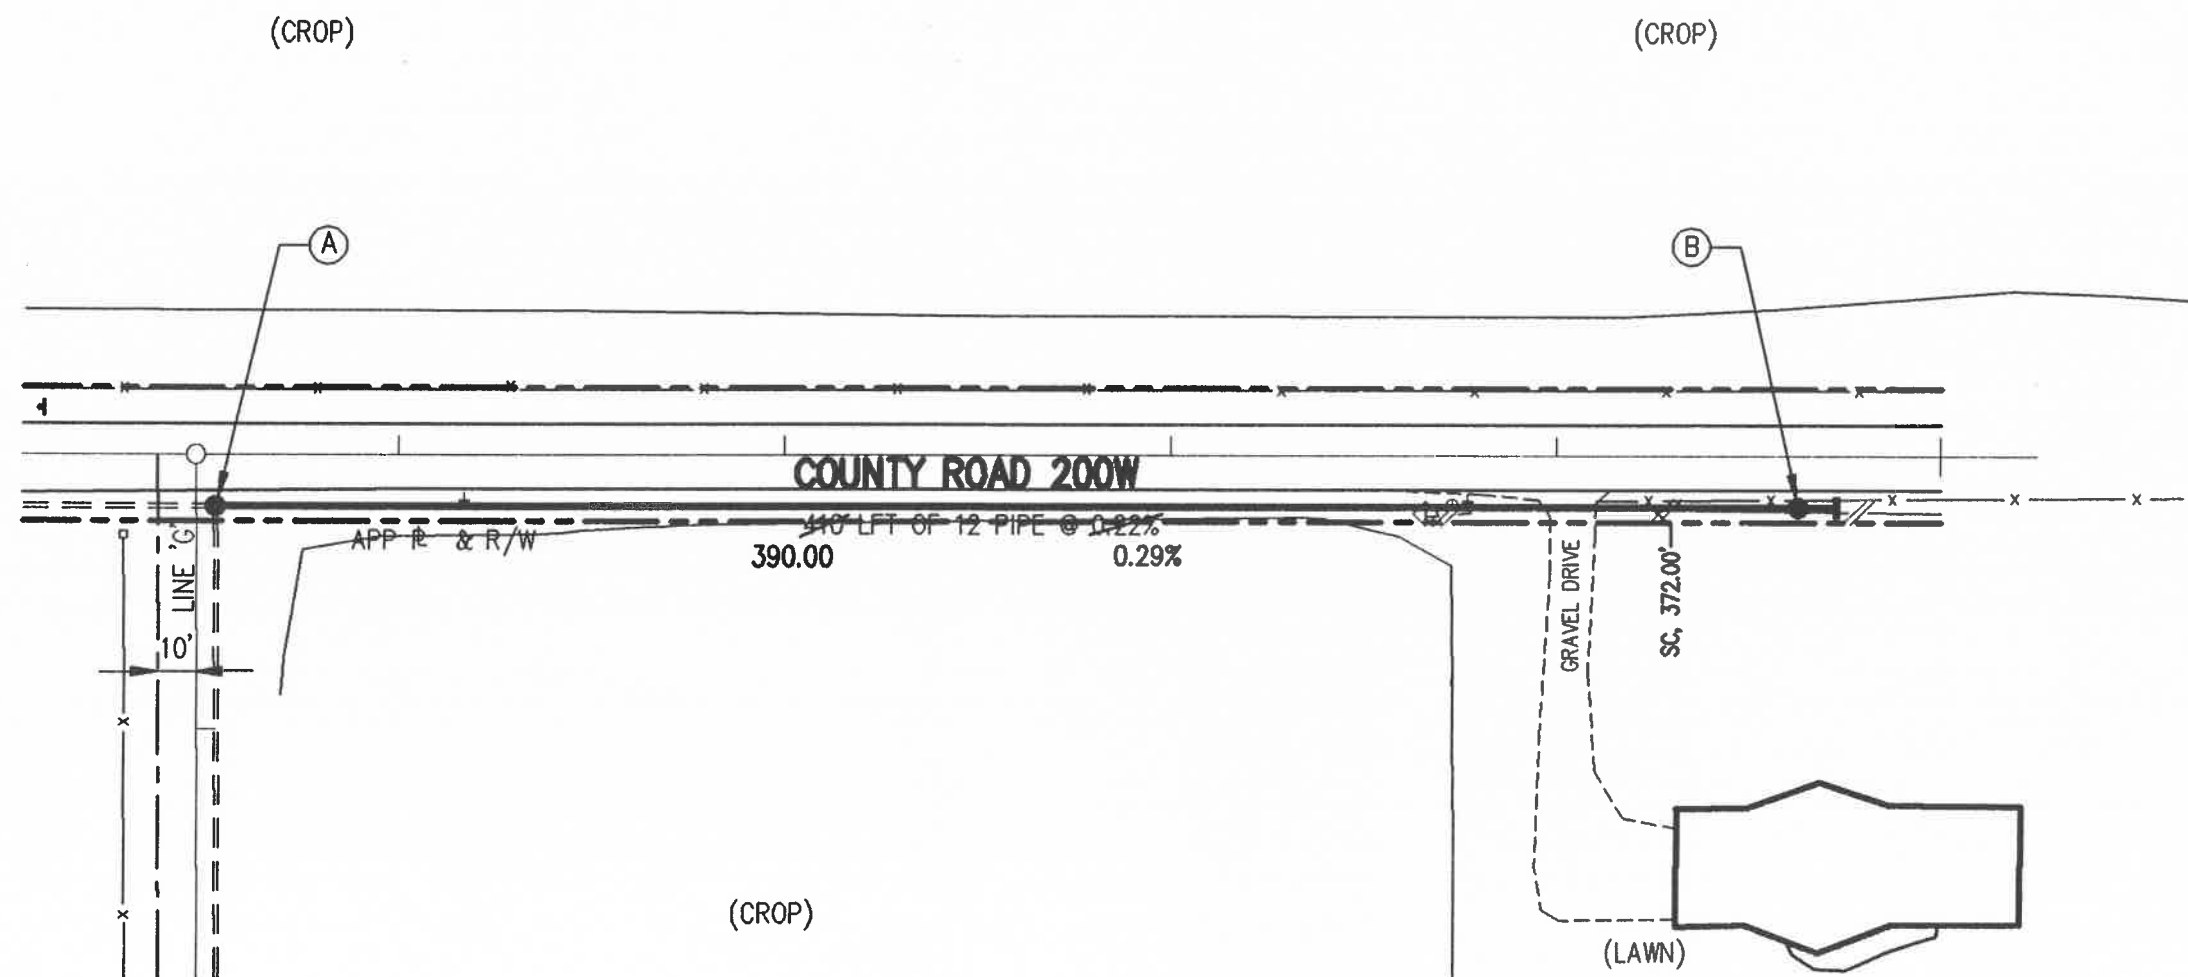

AS-BUILT NOTES:

1. ALL LATERAL LOCATIONS ARE FROM CENTER OF CASTING OF DOWN STREAM M.H.

AS-BUILT INFORMATION

SCALE: 1" = 50'



TRIAD
ASSOCIATES
INC.
INDIANAPOLIS, INDIANA