


FALL CREEK REGIONAL WASTE DISTRICT

HICKORY HILLS SUBDIVISION

CONTRACT 'II'

SHEET No. 7b OF 13

INDEX SA-1

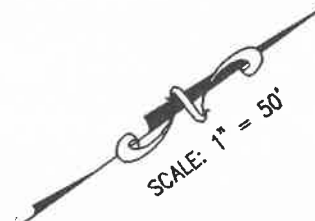


KEYNOTES

- (A) STRUCTURE No. 13a
T.C. = 883.43
INV. ℓ = 876.43
- (B) STRUCTURE No. 13b
T.C. = 887.03
INV. ℓ = 878.23

LEGEND:

- | | | | |
|-------|---------------------------|-------------|---|
| ===== | EXISTING DRAINAGE CULVERT | --- W --- | WATER LINE |
| ● | PROPOSED SANITARY MANHOLE | --- G --- | GAS LINE |
| — | PROPOSED SANITARY SEWER | — | EXISTING UTILITY POLE W/GUY |
| ▲ | EXISTING SIGN | — | EXISTING UTILITY POLE |
| ⊗ | EXISTING MAILBOX | ⊗ | WATER WELL |
| --- | RIGHT OF WAY | ⊞ | EXISTING ELECTRIC TRANSFORMER |
| --- | PROPERTY LINE | SC, 301.50' | AS-BUILT LATERAL LOCATION
(CONTRACT II SEWER LATERALS ARE
4 TO 5 FEET DEEP AT R/W LINE) |
| -x- | EXISTING FENCE LINE | | |

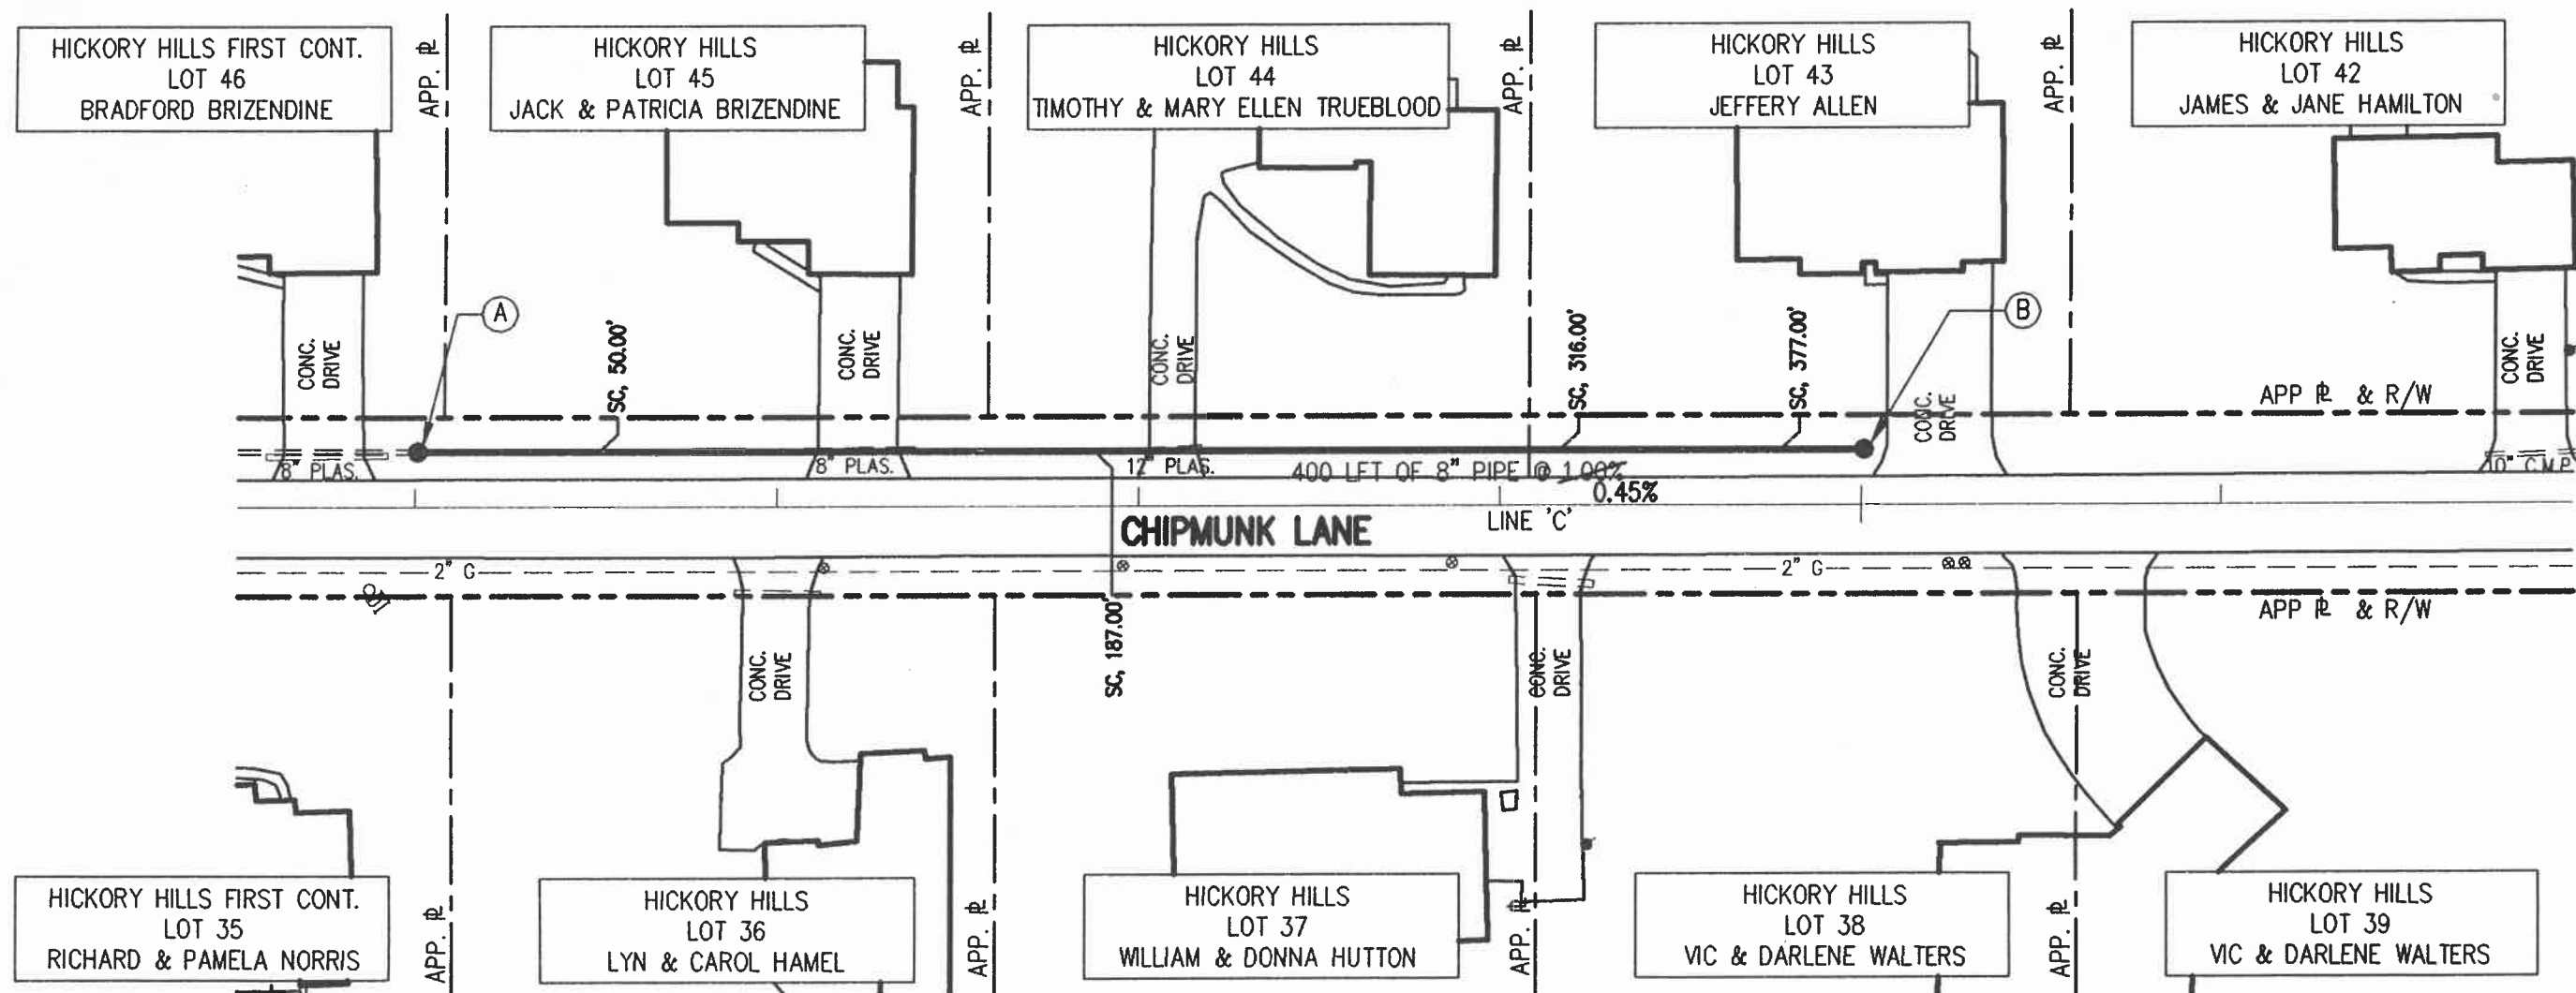

AS-BUILT NOTES:

- ALL LATERAL LOCATIONS ARE FROM CENTER OF CASTING OF DOWN STREAM M.H.

AS-BUILT INFORMATION

SCALE: 1" = 50'



TRIAD
ASSOCIATES
INC.
INDIANAPOLIS, INDIANA