

FALL CREEK REGIONAL WASTE DISTRICT

HICKORY HILLS SUBDIVISION CONTRACT 'I'

SHEET No. 8a OF 13

INDEX SA-1




SCALE: 1" = 50'

KEYNOTES

- (A) STRUCTURE No. 21
TC = 868.75
INV. ℓ = 854.37
- (B) STRUCTURE No. 22
TC = 862.35
INV. ℓ = 855.86


LEGEND:

- | | | | |
|-------|---------------------------|-------------|---|
| ===== | EXISTING DRAINAGE CULVERT | --- W --- | WATER LINE |
| ● | PROPOSED SANITARY MANHOLE | --- G --- | GAS LINE |
| — | PROPOSED SANITARY SEWER | — | EXISTING UTILITY POLE W/GUY |
| ▲ | EXISTING SIGN | — | EXISTING UTILITY POLE |
| ⊗ | EXISTING MAILBOX | ⊗ | WATER WELL |
| --- | RIGHT OF WAY | ⊞ | EXISTING ELECTRIC TRANSFORMER |
| --- | PROPERTY LINE | SC, 301.50' | AS-BUILT LATERAL LOCATION
(CONTRACT II SEWER LATERALS ARE
4 TO 5 FEET DEEP AT R/W LINE) |
| —x— | EXISTING FENCE LINE | | |

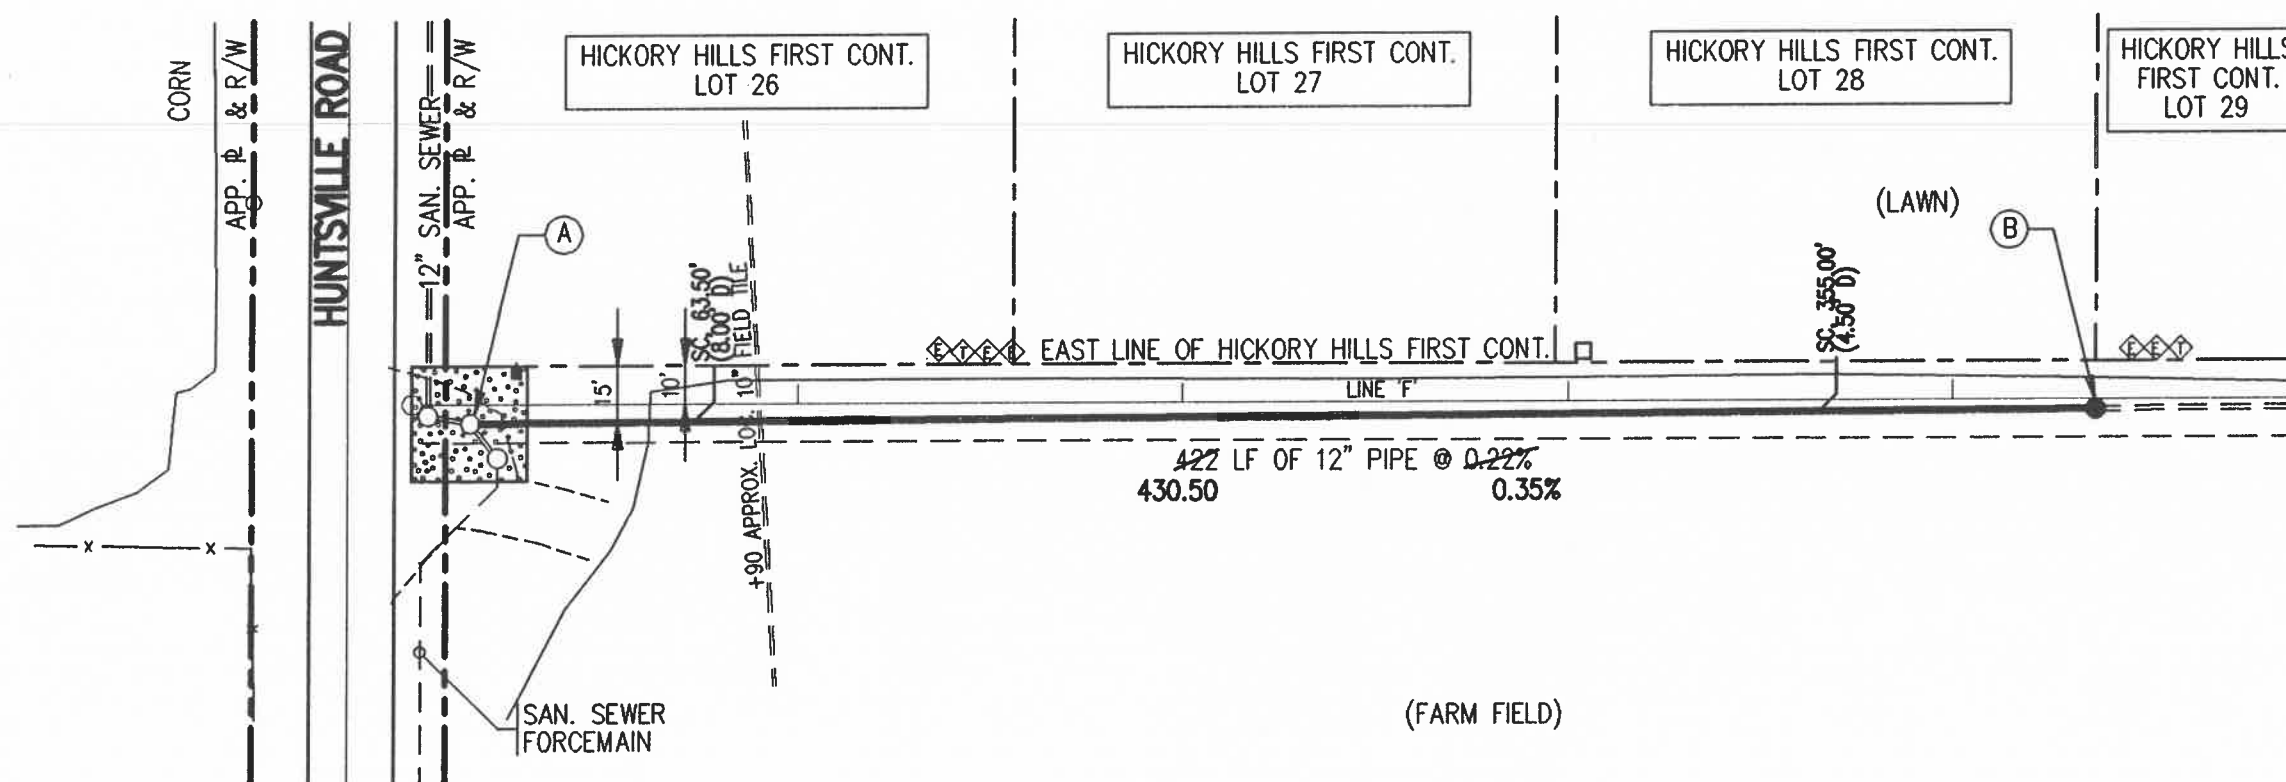

AS-BUILT NOTES:

- ALL LATERAL LOCATIONS ARE FROM CENTER OF CASTING OF DOWN STREAM M.H.

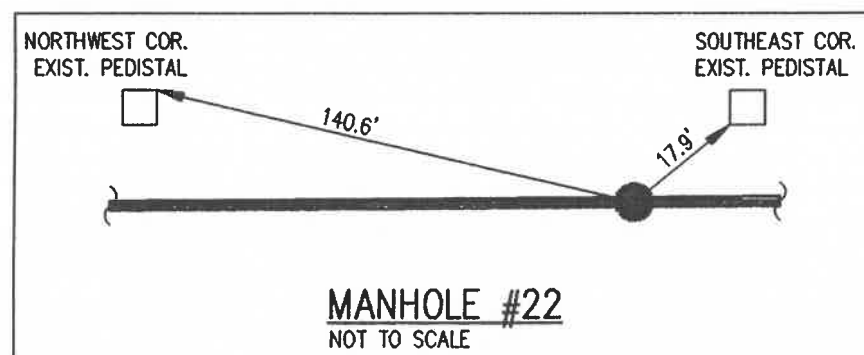

AS-BUILT INFORMATION

SCALE: 1" = 50'



TRIAD
ASSOCIATES
INC.
INDIANAPOLIS, INDIANA