

# FALL CREEK REGIONAL WASTE DISTRICT

HICKORY HILLS SUBDIVISION  
CONTRACT 'I'

SHEET No. 8b OF 13

INDEX SA-1




SCALE: 1" = 50'

## KEYNOTES

- (A) STRUCTURE No. 22  
TC = 862.35  
INV.  $\ell$  = 855.86
- (B) STRUCTURE No. 23  
TC = 864.22  
INV.  $\ell$  = 858.01


## LEGEND:

- |       |                           |             |   |
|-------|---------------------------|-------------|---|
| ===== | EXISTING DRAINAGE CULVERT | --- W ---   | WATER LINE  |
| ●     | PROPOSED SANITARY MANHOLE | --- G ---   | GAS LINE  |
| —     | PROPOSED SANITARY SEWER   | ⊙           | EXISTING UTILITY POLE W/GUY   |
| ▲     | EXISTING SIGN             | ⊙           | EXISTING UTILITY POLE   |
| ⊕     | EXISTING MAILBOX          | ⊙           | WATER WELL  |
| ---   | RIGHT OF WAY              | ⊙           | EXISTING ELECTRIC TRANSFORMER   |
| ---   | PROPERTY LINE             | SC, 301.50' | AS-BUILT LATERAL LOCATION<br>(CONTRACT II SEWER LATERALS ARE<br>4 TO 5 FEET DEEP AT R/W LINE) |
| —x—   | EXISTING FENCE LINE       |             |   |

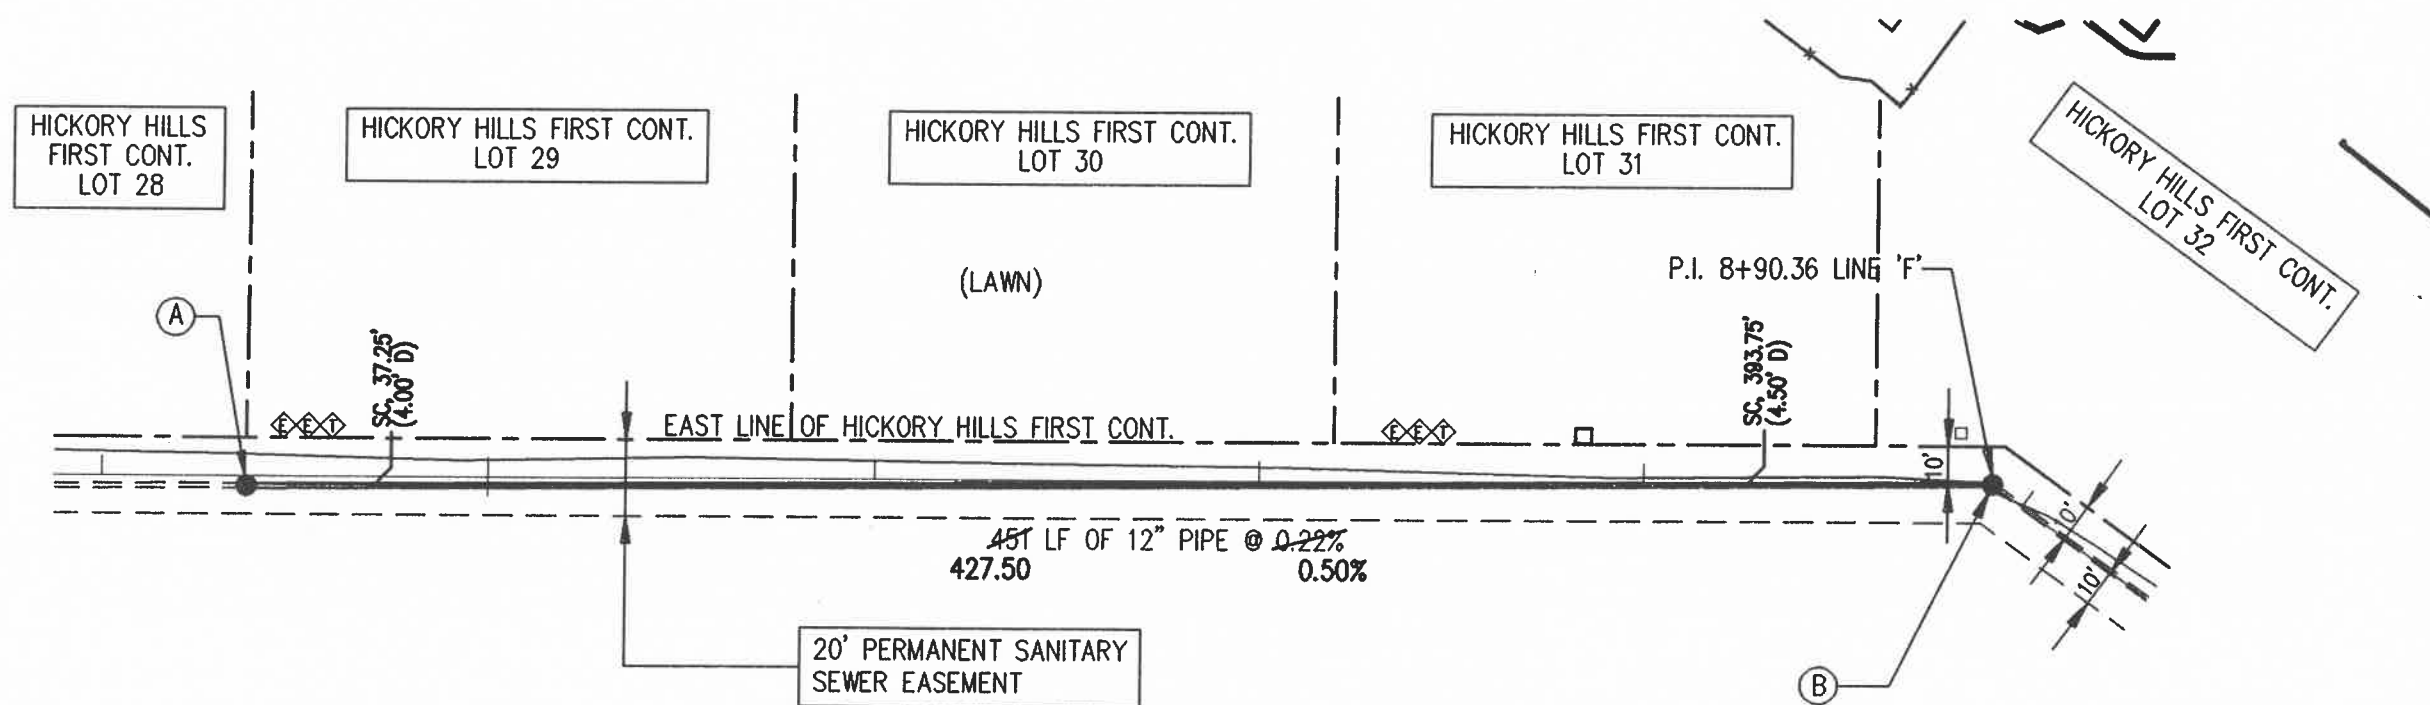

## AS-BUILT NOTES:

- ALL LATERAL LOCATIONS ARE FROM CENTER OF CASTING OF DOWN STREAM M.H.

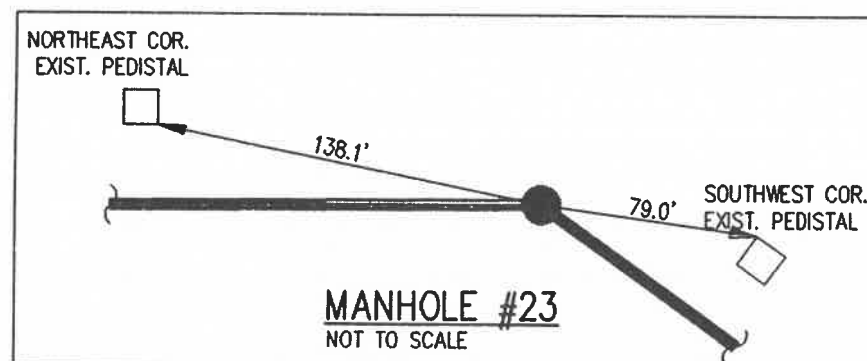

## AS-BUILT INFORMATION

SCALE: 1" = 50'



**TRIAD**  
**ASSOCIATES**  
**INC.**

INDIANAPOLIS, INDIANA

