


FALL CREEK REGIONAL
WASTE DISTRICT
HICKORY HILLS SUBDIVISION
CONTRACT 'I'

SHEET No. 8c OF 13

INDEX SA-1

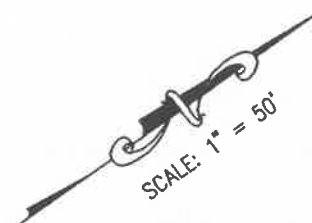


KEYNOTES

- (A) STRUCTURE No. 23
TC = 864.22
INV. ℓ = 858.01
- (B) STRUCTURE No. 24
TC = 865.31
INV. ℓ = 859.96


LEGEND:

- | | | | | | |
|-----|---------------------------|-------------|-----|-----|---|
| --- | EXISTING DRAINAGE CULVERT | --- | W | --- | WATER LINE |
| ● | PROPOSED SANITARY MANHOLE | --- | G | --- | GAS LINE |
| --- | PROPOSED SANITARY SEWER | ● | --- | --- | EXISTING UTILITY POLE W/GUY |
| ▲ | EXISTING SIGN | ▲ | --- | --- | EXISTING UTILITY POLE |
| ⊕ | EXISTING MAILBOX | ⊕ | --- | --- | WATER WELL |
| --- | RIGHT OF WAY | ⊕ | --- | --- | EXISTING ELECTRIC TRANSFORMER |
| --- | PROPERTY LINE | SC, 301.50' | --- | --- | AS-BUILT LATERAL LOCATION
(CONTRACT II SEWER LATERALS ARE
4 TO 5 FEET DEEP AT R/W LINE) |
| --- | EXISTING FENCE LINE | | | | |

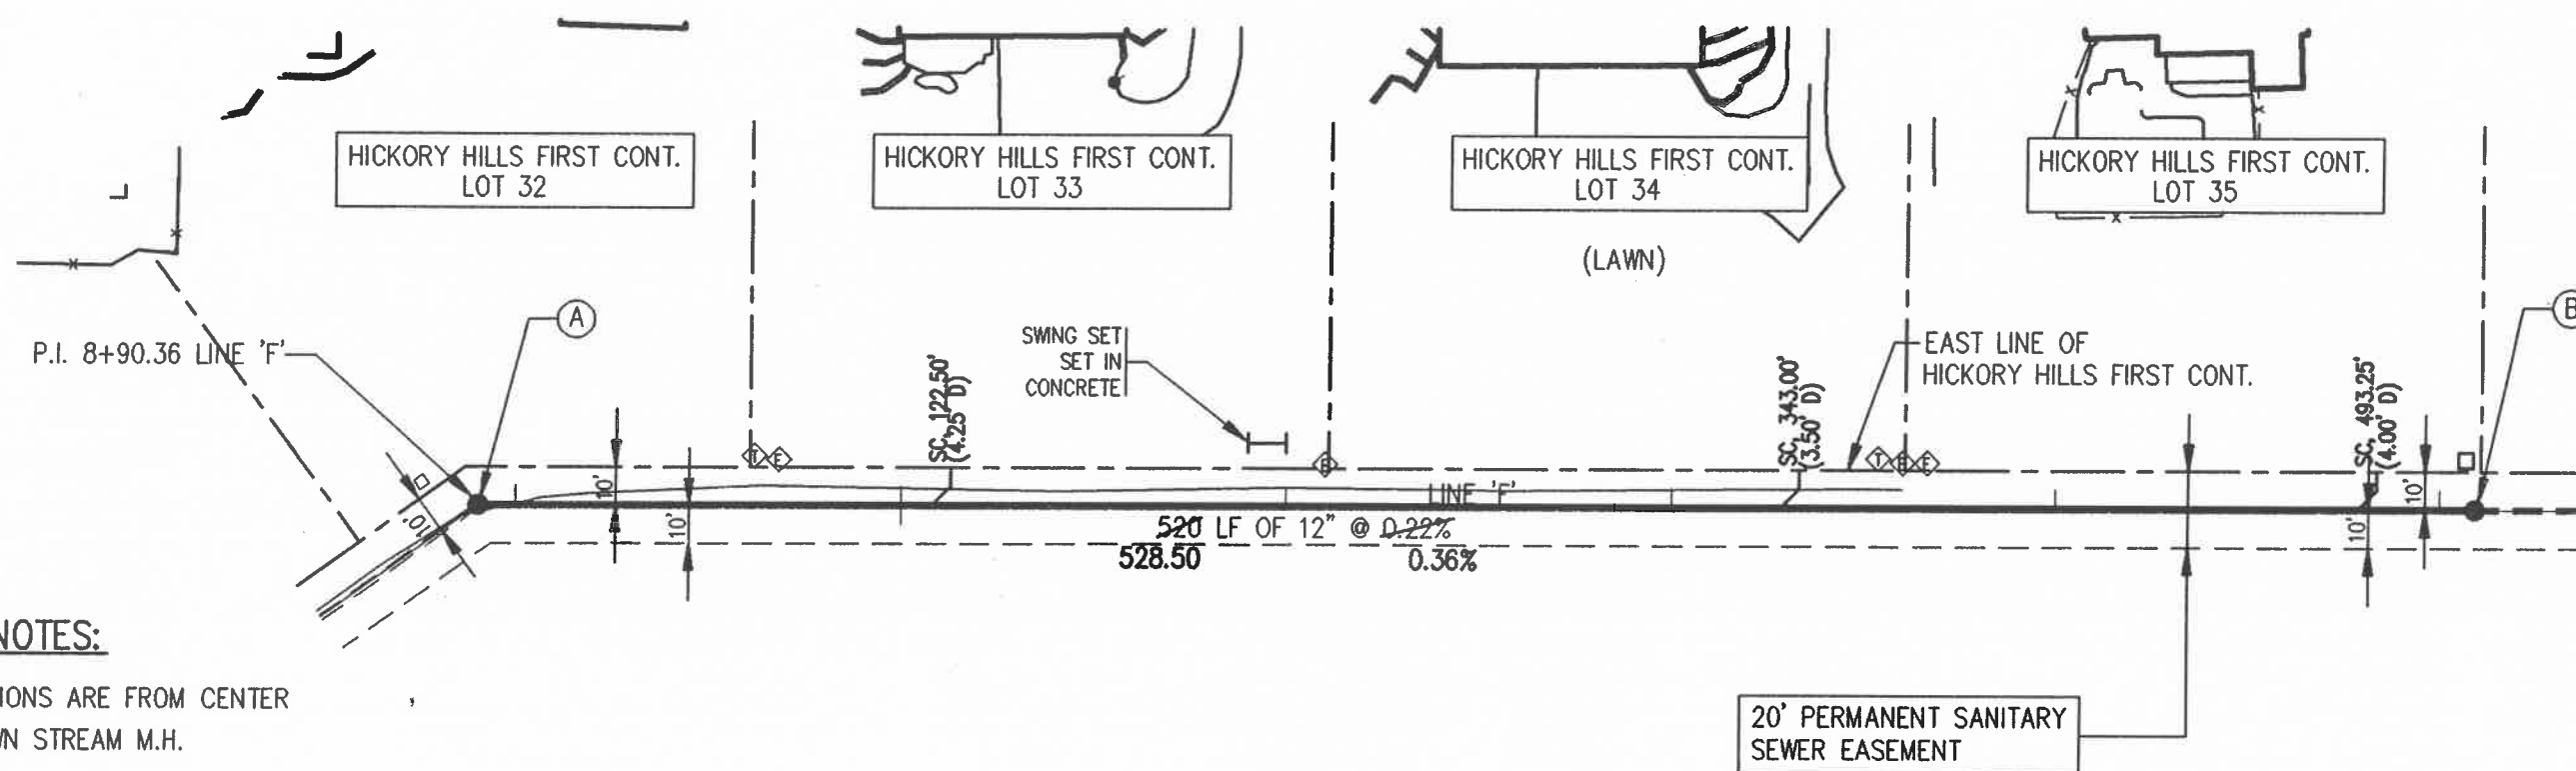

AS-BUILT NOTES:

1. ALL LATERAL LOCATIONS ARE FROM CENTER OF CASTING OF DOWN STREAM M.H.

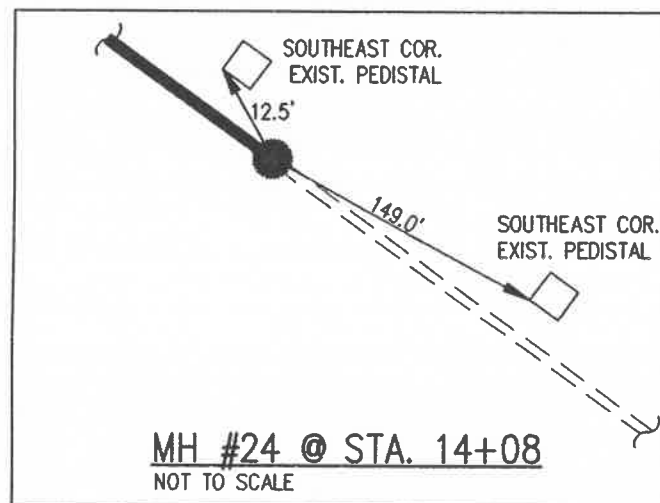

AS-BUILT INFORMATION

SCALE: 1" = 50'



TRIAD
ASSOCIATES
INC.

INDIANAPOLIS, INDIANA

