

FALL CREEK REGIONAL
WASTE DISTRICT
HICKORY HILLS SUBDIVISION
CONTRACT 'I'

SHEET No. 9a OF 13


INDEX SA-1

KEYNOTES

- (A) STRUCTURE No. 24
TC = 865.31
INV. ℓ = 859.96
- (B) STRUCTURE No. 25
TC = 865.67
INV. ℓ = 861.32

LEGEND:


- -- -- -- -- EXISTING DRAINAGE CULVERT
- PROPOSED SANITARY MANHOLE
- -- -- -- -- PROPOSED SANITARY SEWER
- ▲ EXISTING SIGN
- ⊕ EXISTING MAILBOX
- -- -- -- -- RIGHT OF WAY
- -- -- -- -- PROPERTY LINE
- x --- EXISTING FENCE LINE
- W --- WATER LINE
- G --- GAS LINE
- EXISTING UTILITY POLE W/GUY
- EXISTING UTILITY POLE
- ⊙ WATER WELL
- ⊠ EXISTING ELECTRIC TRANSFORMER
- SC, 301.50' AS-BUILT LATERAL LOCATION
(CONTRACT II SEWER LATERALS ARE 4 TO 5 FEET DEEP AT R/W LINE)

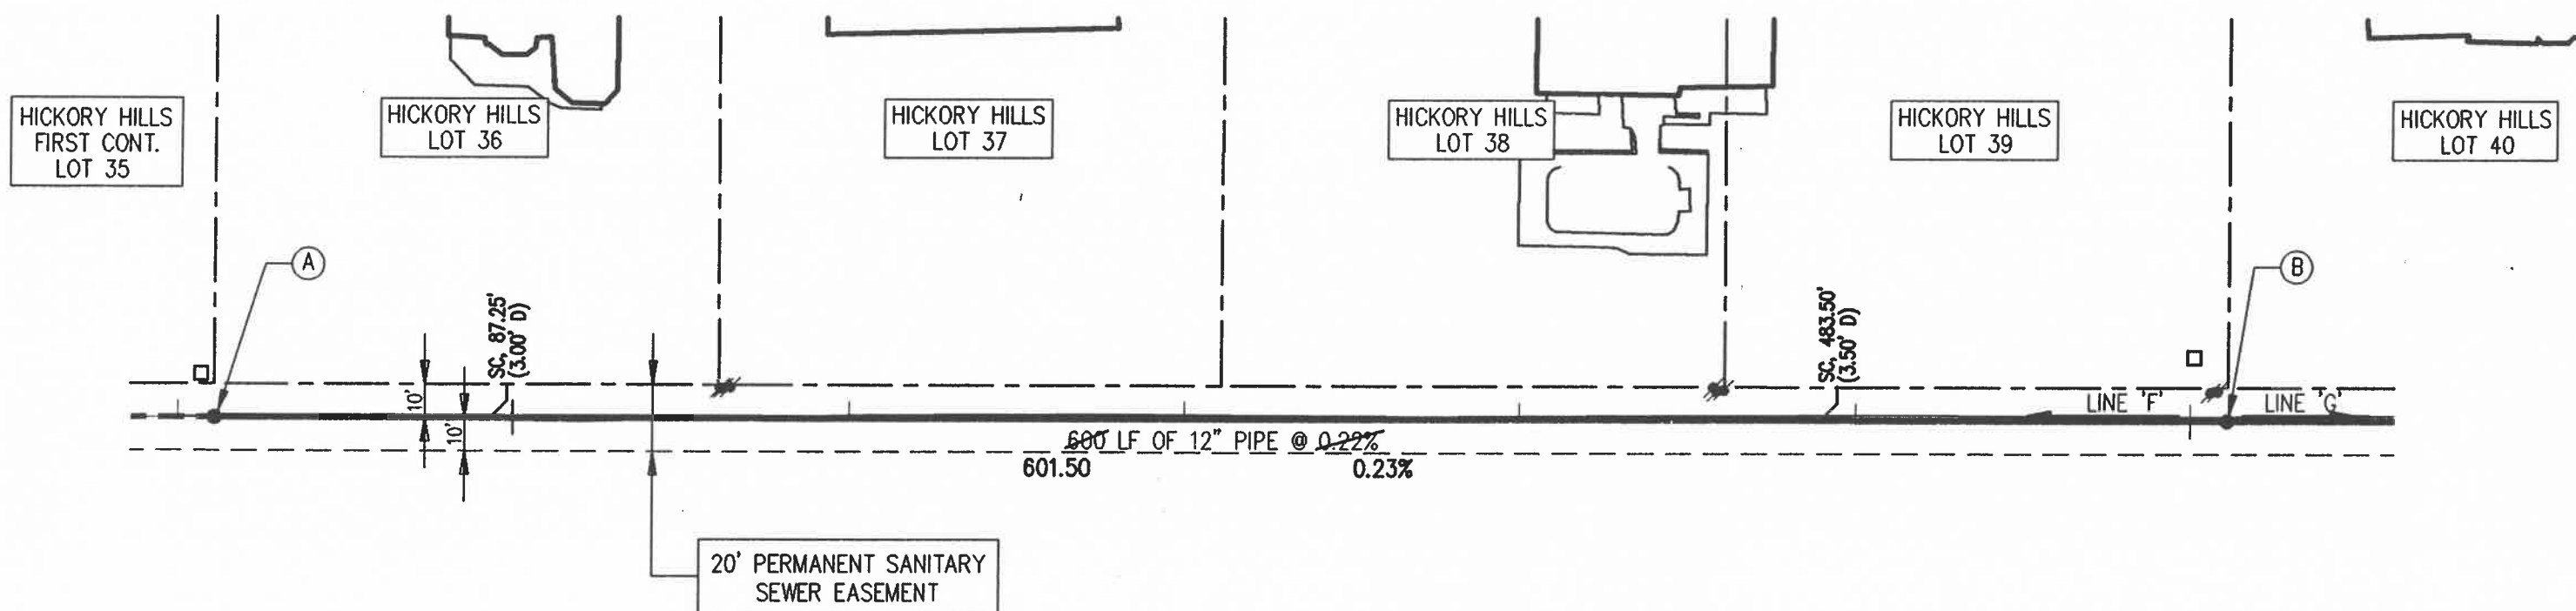

(FARM FIELD)

AS-BUILT NOTES:

1. ALL LATERAL LOCATIONS ARE FROM CENTER OF CASTING OF DOWN STREAM M.H.

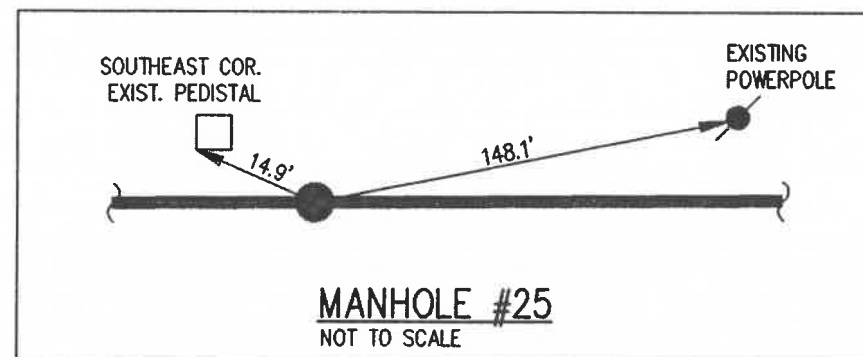

AS-BUILT INFORMATION

SCALE: 1" = 50'



TRIAD
ASSOCIATES
INC.

INDIANAPOLIS, INDIANA

