


FALL CREEK REGIONAL
WASTE DISTRICT
HICKORY HILLS SUBDIVISION
CONTRACT 'I'

SHEET No. 9b OF 13

INDEX SA-1

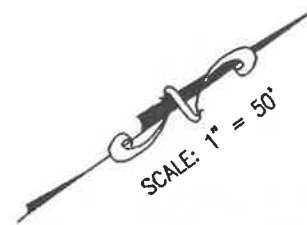


KEYNOTES

- (A) STRUCTURE No. 25
TC = 865.67
INV. ℓ = 861.32
- (B) STRUCTURE No. 26
TC = 866.24
INV. ℓ = 862.63


LEGEND:

- | | | | |
|-----|---------------------------|-------------|---|
| == | EXISTING DRAINAGE CULVERT | — W — | WATER LINE |
| ● | PROPOSED SANITARY MANHOLE | — G — | GAS LINE |
| — | PROPOSED SANITARY SEWER | — | EXISTING UTILITY POLE W/GUY |
| ▲ | EXISTING SIGN | — | EXISTING UTILITY POLE |
| ⊕ | EXISTING MAILBOX | ⊙ | WATER WELL |
| --- | RIGHT OF WAY | ⊠ | EXISTING ELECTRIC TRANSFORMER |
| --- | PROPERTY LINE | SC, 301.50' | AS-BUILT LATERAL LOCATION
(CONTRACT II SEWER LATERALS ARE
4 TO 5 FEET DEEP AT R/W LINE) |
| —x— | EXISTING FENCE LINE | | |

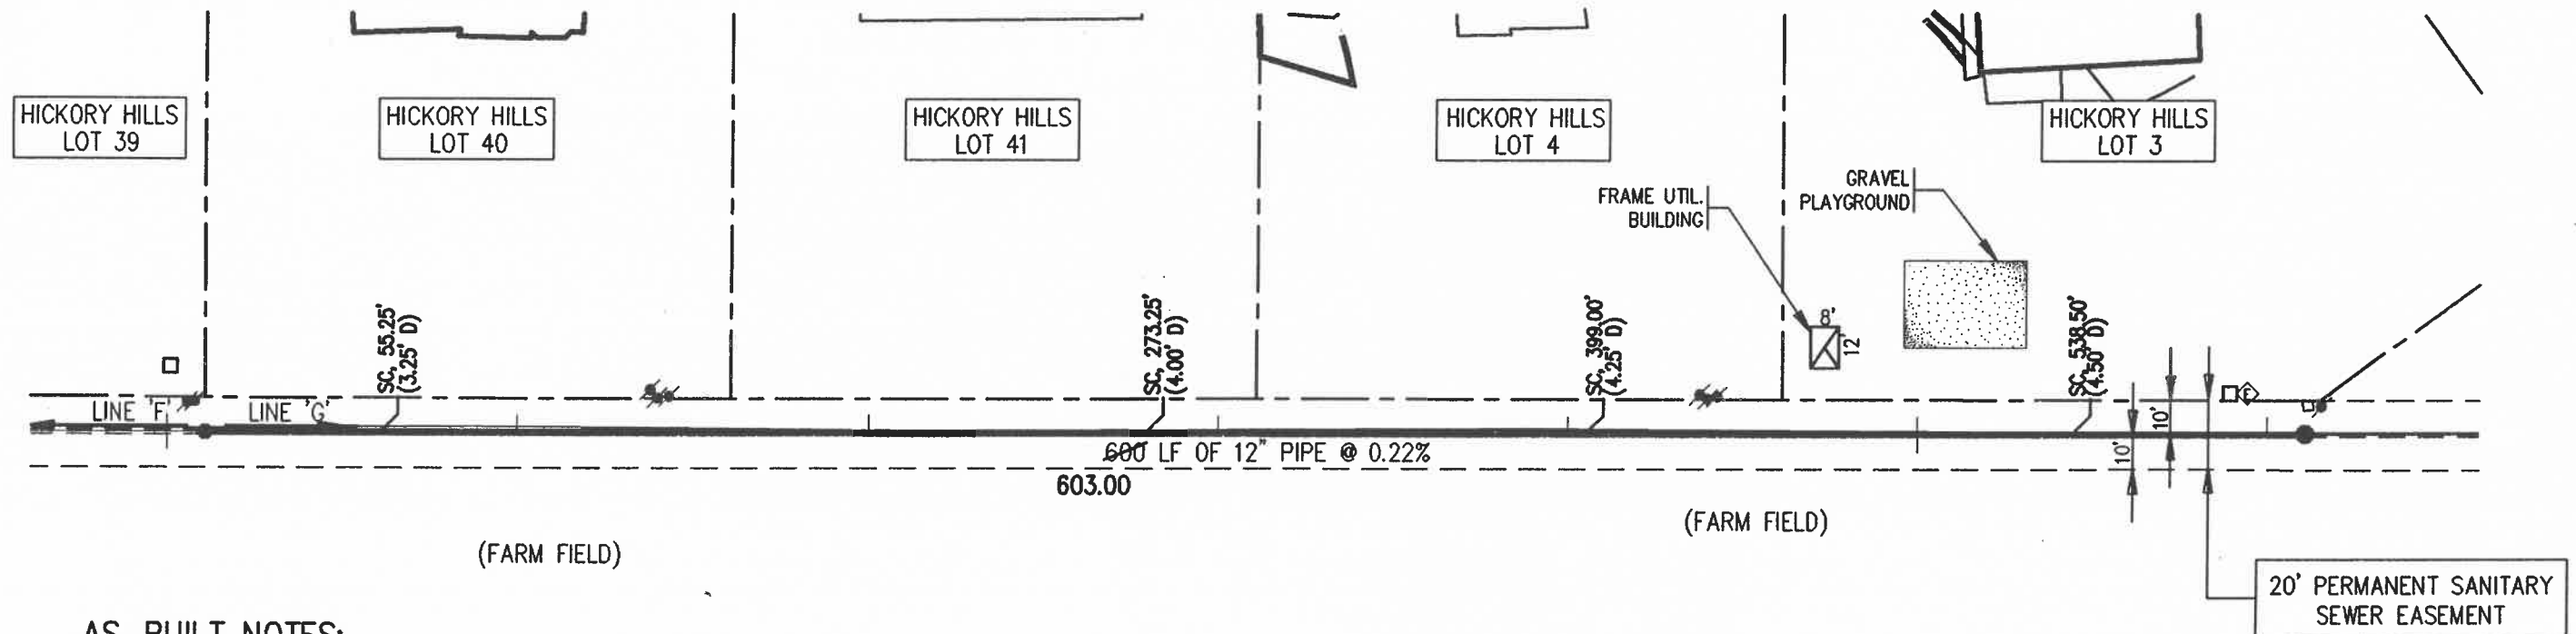

AS-BUILT NOTES:

- ALL LATERAL LOCATIONS ARE FROM CENTER OF CASTING OF DOWN STREAM M.H.

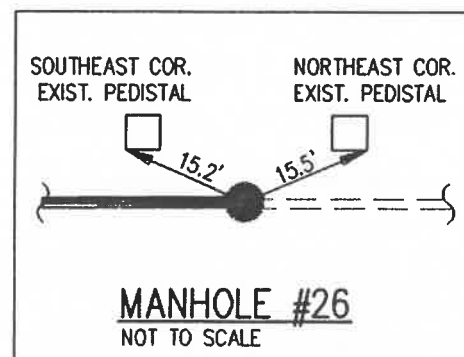

AS-BUILT INFORMATION

SCALE: 1" = 50'



TRIAD
ASSOCIATES
INC.
INDIANAPOLIS, INDIANA