

**FALL CREEK REGIONAL
WASTE DISTRICT
HICKORY HILLS SUBDIVISION
CONTRACT 'I'**

SHEET No. 10a OF 13


INDEX SA-1

KEYNOTES

- (A) STRUCTURE No. 26
TC = 866.24
INV. ℓ = 862.63
- (B) STRUCTURE No. 27
TC = 867.40
INV. ℓ = 863.57


LEGEND:

- | | | | |
|-------|---------------------------|-------------|---|
| ===== | EXISTING DRAINAGE CULVERT | — W — | WATER LINE |
| ● | PROPOSED SANITARY MANHOLE | — G — | GAS LINE |
| — | PROPOSED SANITARY SEWER | ⊙ | EXISTING UTILITY POLE W/GUY |
| ▲ | EXISTING SIGN | ⚡ | EXISTING UTILITY POLE |
| ⊕ | EXISTING MAILBOX | ⊙ W | WATER WELL |
| --- | RIGHT OF WAY | ⊞ | EXISTING ELECTRIC TRANSFORMER |
| --- | PROPERTY LINE | SC, 301.50' | AS-BUILT LATERAL LOCATION
(CONTRACT II SEWER LATERALS ARE
4 TO 5 FEET DEEP AT R/W LINE) |
| -x- | EXISTING FENCE LINE | | |

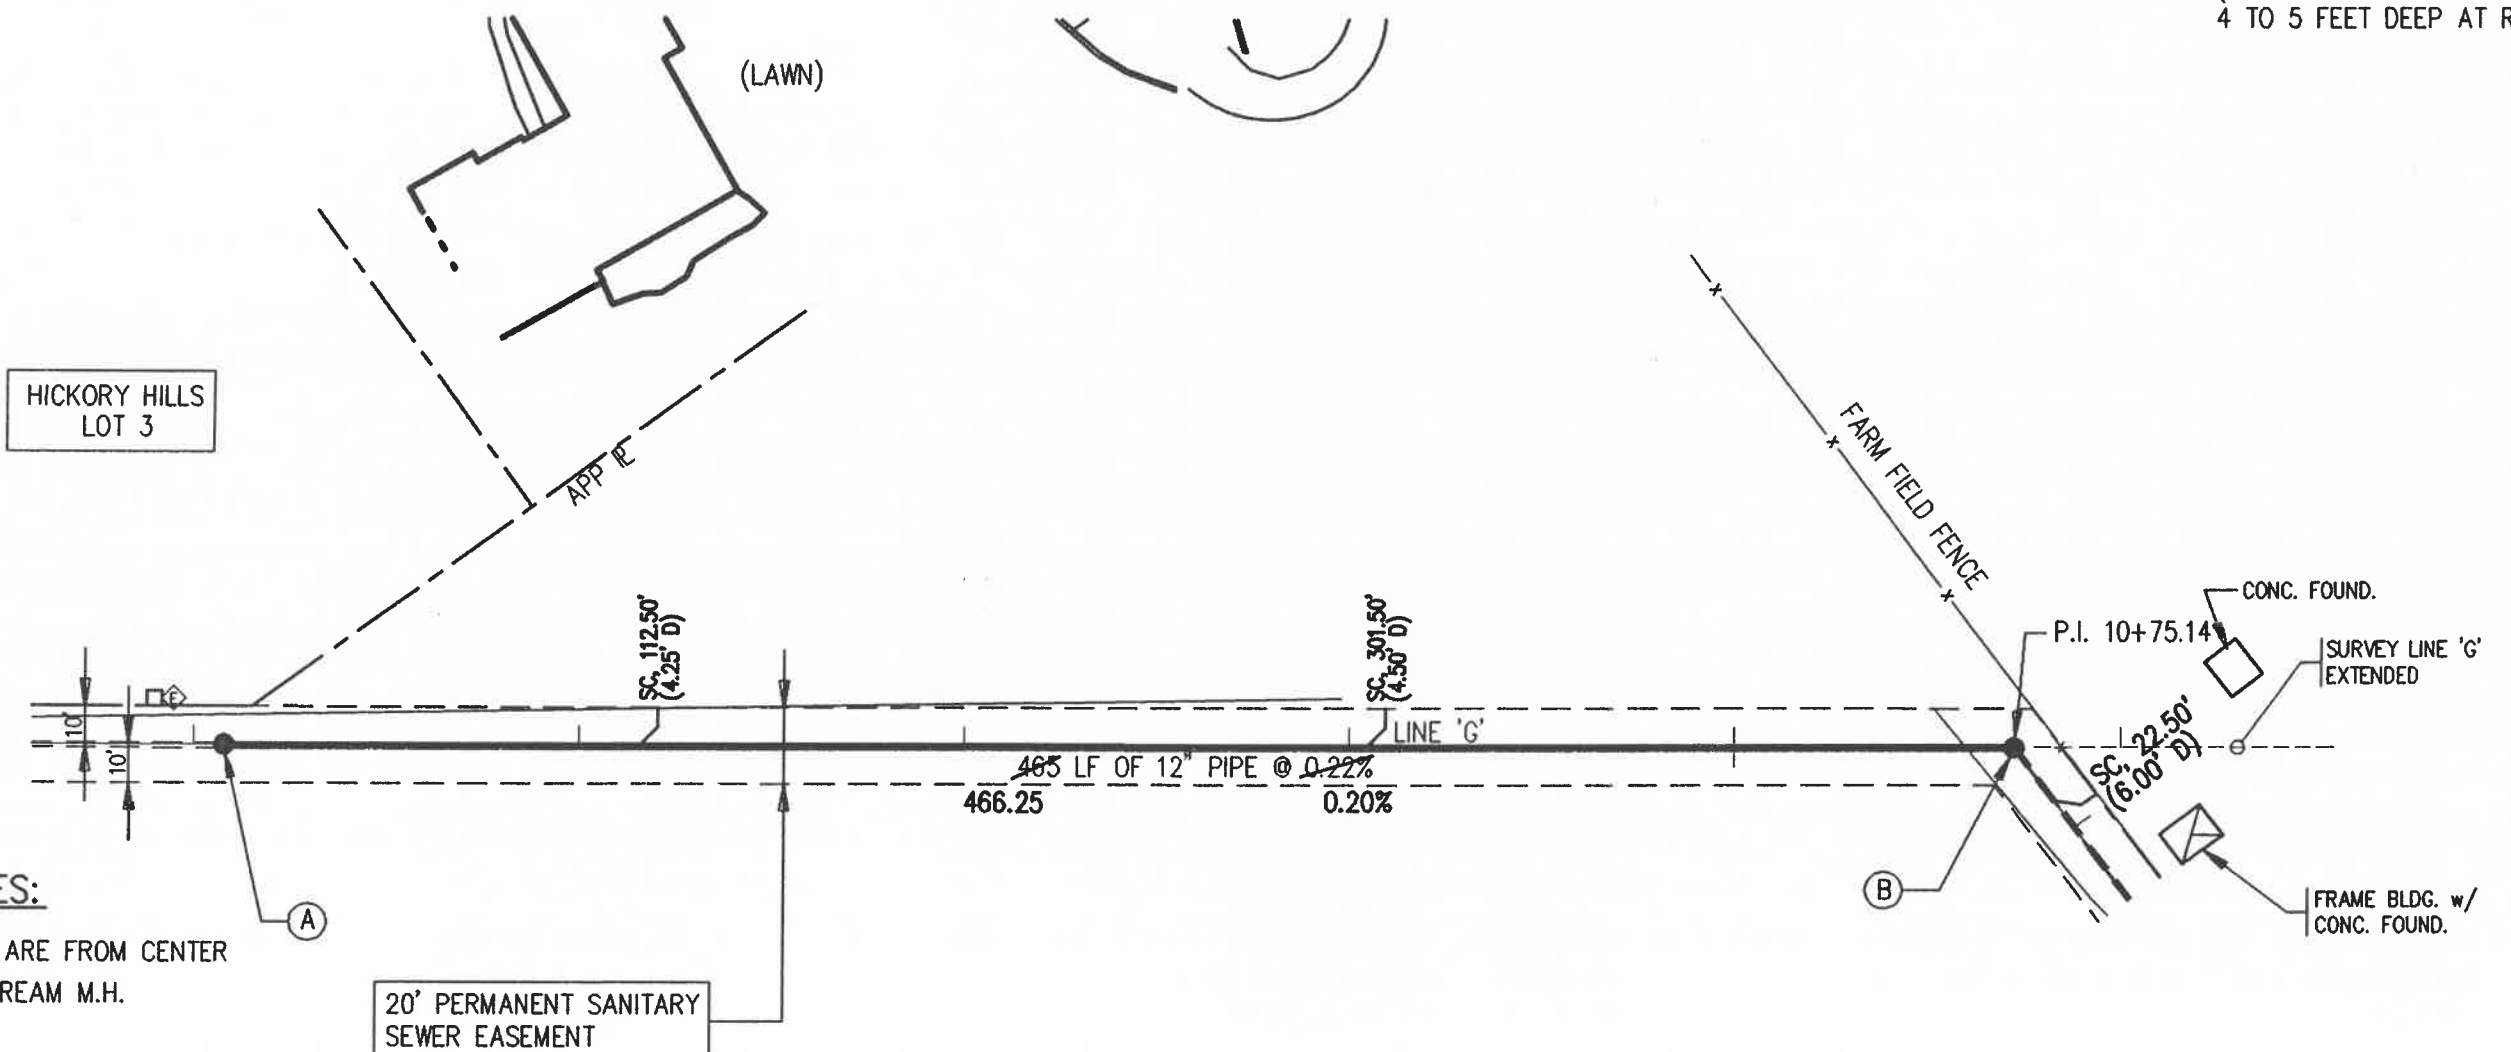

AS-BUILT NOTES:

1. ALL LATERAL LOCATIONS ARE FROM CENTER OF CASTING OF DOWN STREAM M.H.

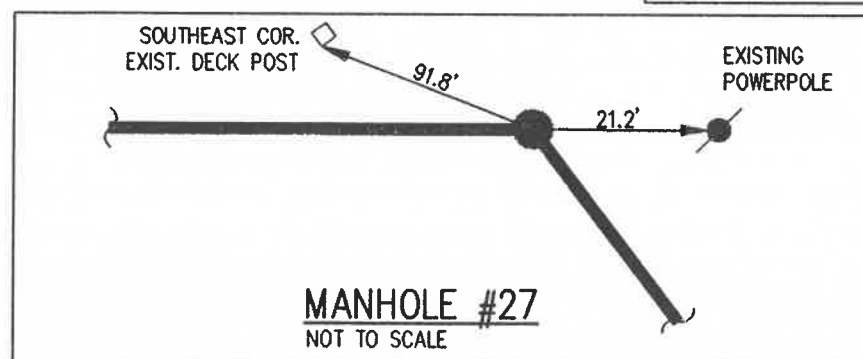

AS-BUILT INFORMATION

SCALE: 1" = 50'



**TRIAD
ASSOCIATES
INC.**
INDIANAPOLIS, INDIANA