

FALL CREEK REGIONAL WASTE DISTRICT

HICKORY HILLS SUBDIVISION
CONTRACT 'I'

SHEET No. 10b OF 13


INDEX SA-1

KEYNOTES

- (A) STRUCTURE No. 27
TC = 867.40
INV. ℓ = 863.57
- (B) STRUCTURE No. 28
TC = 867.05
INV. ℓ = 864.08
- (C) STRUCTURE No. 28a
TC = 873.24
INV.(S) = 866.71
INV. ℓ = 866.09
- (D) STRUCTURE No. 30
TC = 887.91
INV. ℓ = 872.95

LEGEND:

- | | | | | | |
|-----|---------------------------|-------------|-----|-----|---|
| --- | EXISTING DRAINAGE CULVERT | --- | W | --- | WATER LINE |
| ● | PROPOSED SANITARY MANHOLE | --- | G | --- | GAS LINE |
| --- | PROPOSED SANITARY SEWER | ● | --- | --- | EXISTING UTILITY POLE W/GUY |
| ▲ | EXISTING SIGN | ▲ | --- | --- | EXISTING UTILITY POLE |
| ⊕ | EXISTING MAILBOX | ⊕ | --- | --- | WATER WELL |
| --- | RIGHT OF WAY | ⊕ | --- | --- | EXISTING ELECTRIC TRANSFORMER |
| --- | PROPERTY LINE | SC, 301.50' | --- | --- | AS-BUILT LATERAL LOCATION
(CONTRACT II SEWER LATERALS ARE
4 TO 5 FEET DEEP AT R/W LINE) |
| --- | EXISTING FENCE LINE | | | | |

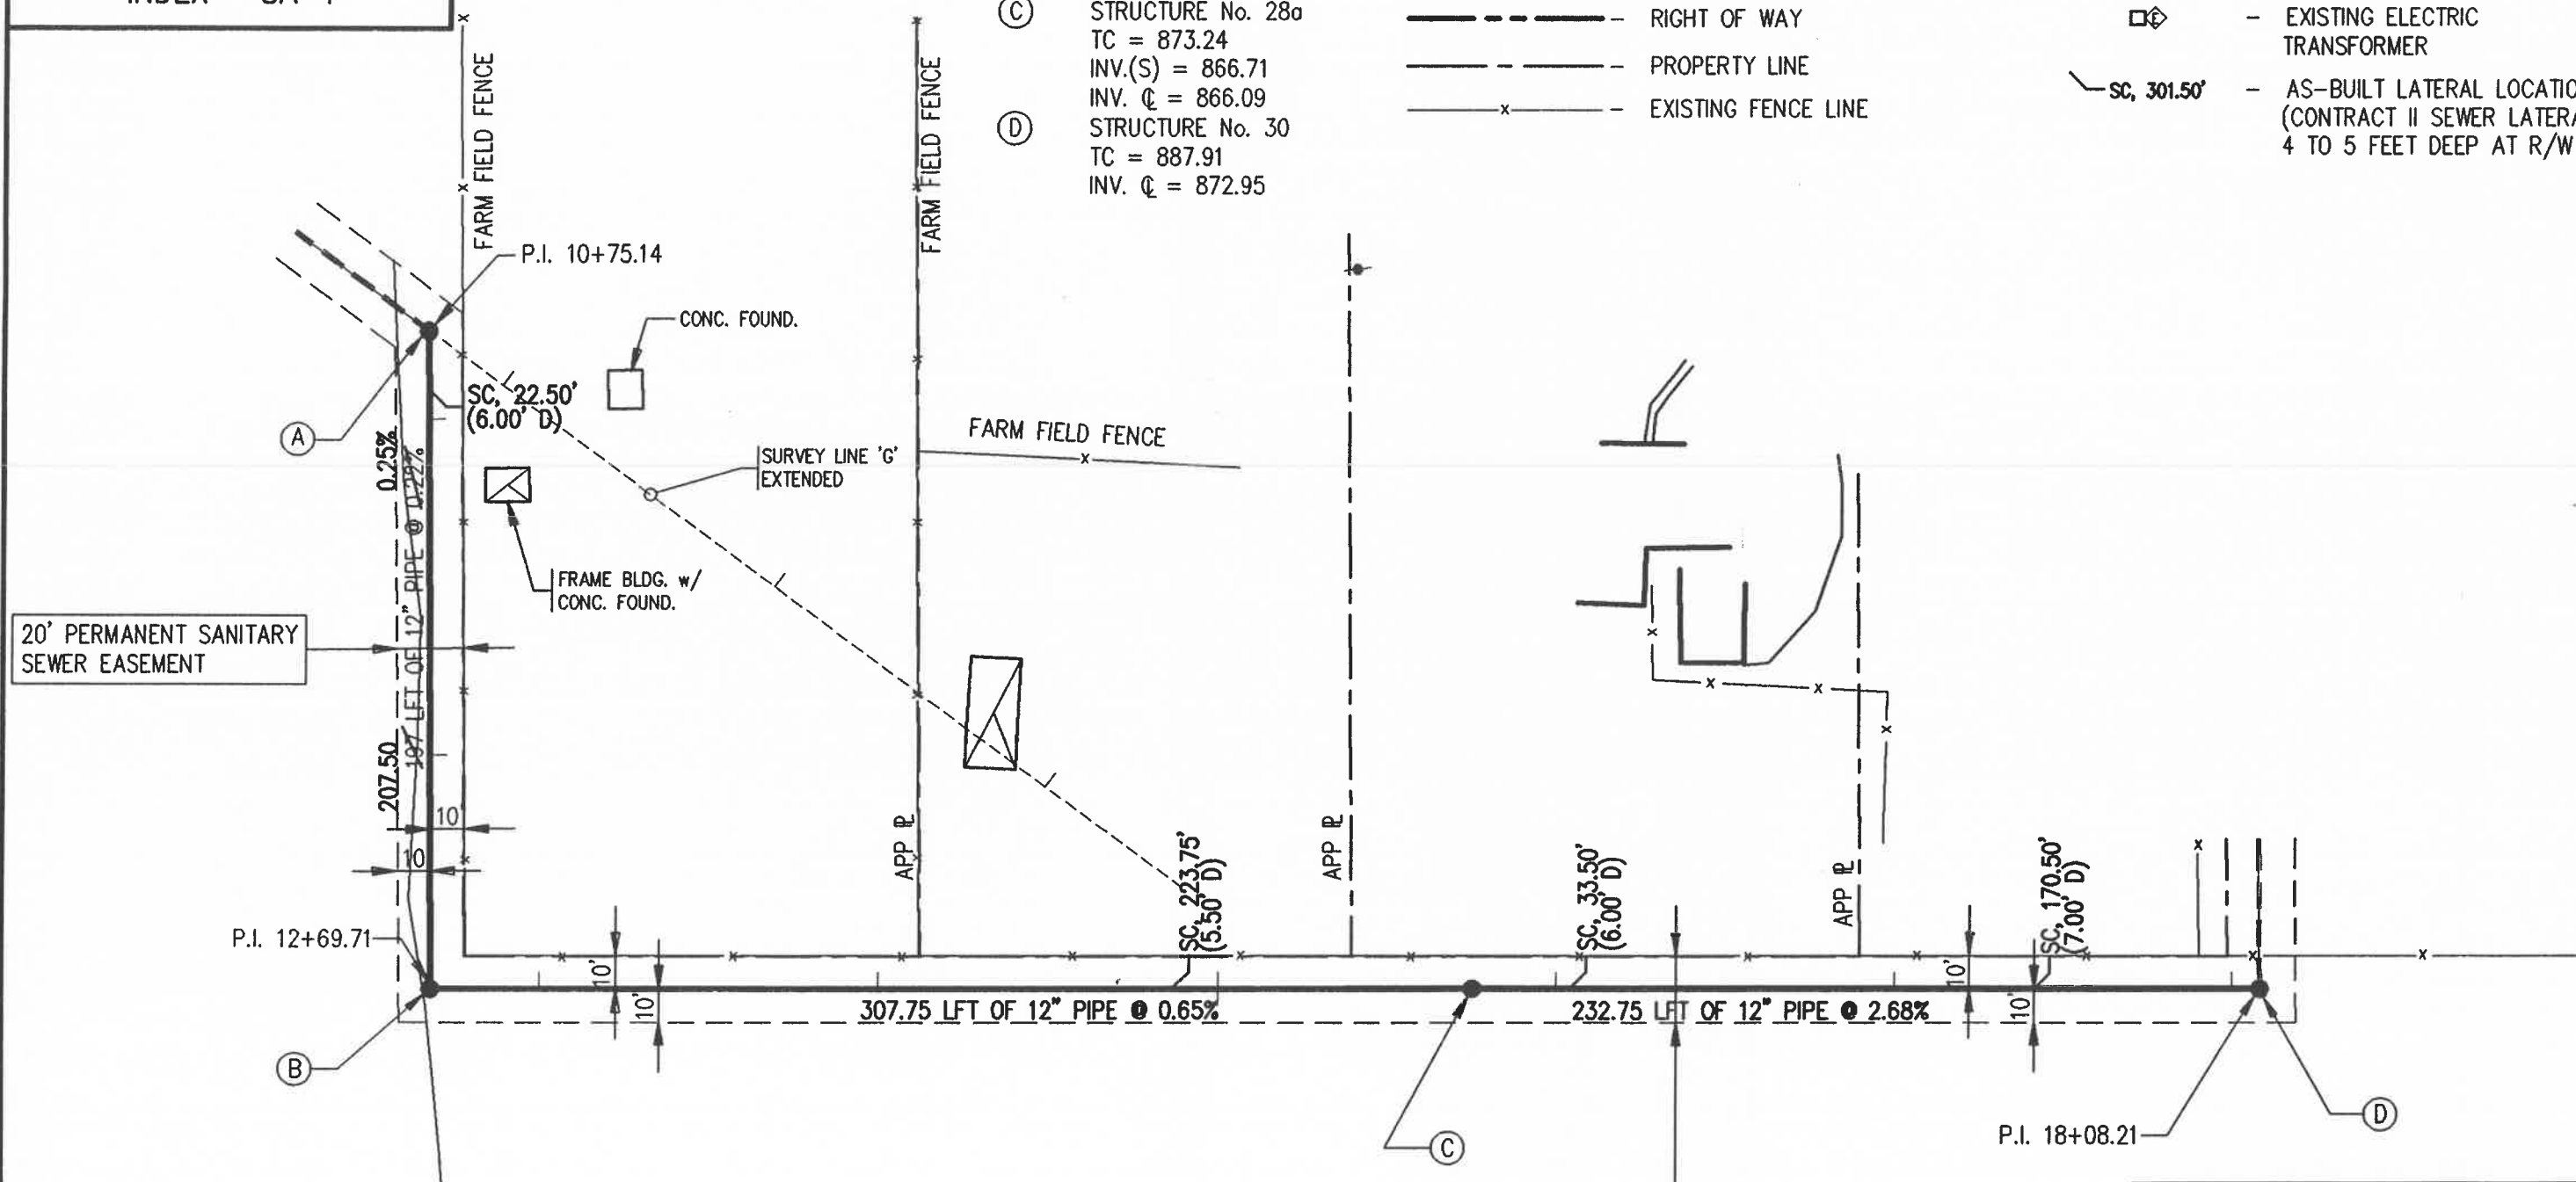

AS-BUILT NOTES:

- ALL LATERAL LOCATIONS ARE FROM CENTER OF CASTING OF DOWN STREAM M.H.

AS-BUILT INFORMATION

SCALE: 1" = 50'



20' PERMANENT SANITARY
SEWER EASEMENT

TRIAD
ASSOCIATES
INC.

INDIANAPOLIS, INDIANA

