

FALL CREEK REGIONAL WASTE DISTRICT

HICKORY HILLS SUBDIVISION
CONTRACT 'II'

SHEET No. 11 OF 13

INDEX SA-1


SCALE: 1" = 50'

KEYNOTES

- (A) STRUCTURE No. 29
T.C. = 887.91
INV. ℓ = 872.95
- (B) STRUCTURE No. 30
T.C. = 886.11
INV. ℓ = 874.11
- (C) STRUCTURE No. 31
T.C. = 885.50
INV.(N) = 881.44
INV. ℓ = 874.80

LEGEND:

- | | | | |
|-----|---------------------------|-------------|---|
| == | EXISTING DRAINAGE CULVERT | W | WATER LINE |
| ● | PROPOSED SANITARY MANHOLE | G | GAS LINE |
| — | PROPOSED SANITARY SEWER | — | EXISTING UTILITY POLE W/GUY |
| ▲ | EXISTING SIGN | — | EXISTING UTILITY POLE |
| ⊕ | EXISTING MAILBOX | (W) | WATER WELL |
| --- | RIGHT OF WAY | ⊞ | EXISTING ELECTRIC TRANSFORMER |
| --- | PROPERTY LINE | SC, 301.50' | AS-BUILT LATERAL LOCATION
(CONTRACT II SEWER LATERALS ARE
4 TO 5 FEET DEEP AT R/W LINE) |
| -x- | EXISTING FENCE LINE | | |

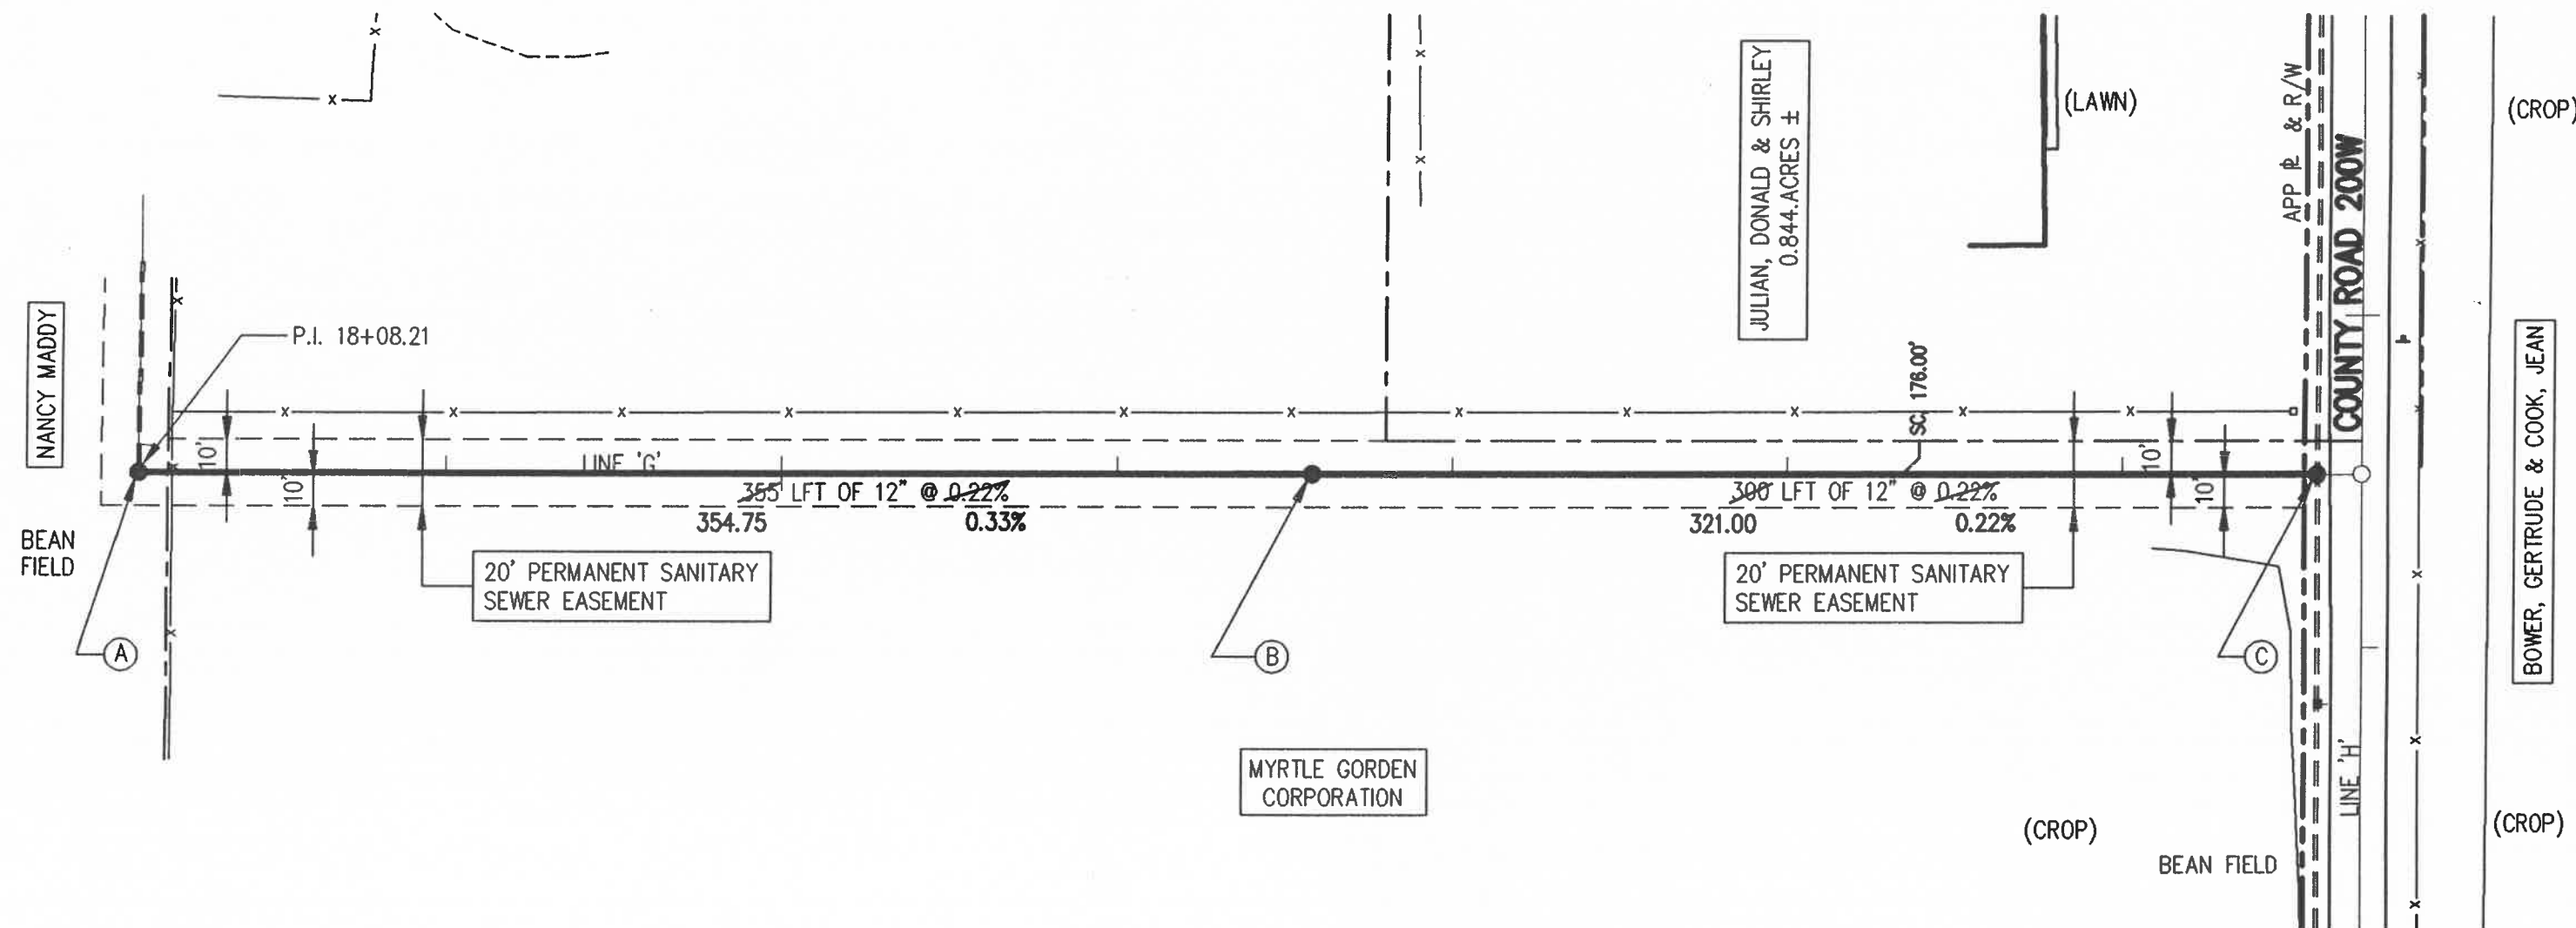

AS-BUILT NOTES:

- ALL LATERAL LOCATIONS ARE FROM CENTER OF CASTING OF DOWN STREAM M.H.

AS-BUILT INFORMATION

SCALE: 1" = 50'



TRIAD
ASSOCIATES
INC.

INDIANAPOLIS, INDIANA

