

FALL CREEK REGIONAL
WASTE DISTRICT
HICKORY HILLS SUBDIVISION
CONTRACT 'II'
SHEET No. 12a OF 13

INDEX SA-1

KEYNOTES


- (A) STRUCTURE No. 31
T.C. = 885.50
INV.(N) = 881.44
INV. ϕ = 874.80
(B) STRUCTURE No. 31a
T.C. = 889.12
INV. ϕ = 883.02



SCALE: 1" = 50'

LEGEND:

- | | | | | |
|-----|---------------------------|-------------|-------------------------------|---|
| --- | EXISTING DRAINAGE CULVERT | --- | W --- | WATER LINE |
| ● | PROPOSED SANITARY MANHOLE | --- | G --- | GAS LINE |
| --- | PROPOSED SANITARY SEWER | ● | EXISTING UTILITY POLE W/GUY | |
| ▲ | EXISTING SIGN | ▲ | EXISTING UTILITY POLE | |
| ⊕ | EXISTING MAILBOX | (W) | WATER WELL | |
| --- | RIGHT OF WAY | ⊠ | EXISTING ELECTRIC TRANSFORMER | |
| --- | PROPERTY LINE | SC, 301.50' | AS-BUILT LATERAL LOCATION | (CONTRACT II SEWER LATERALS ARE 4 TO 5 FEET DEEP AT R/W LINE) |
| -x- | EXISTING FENCE LINE | | | |

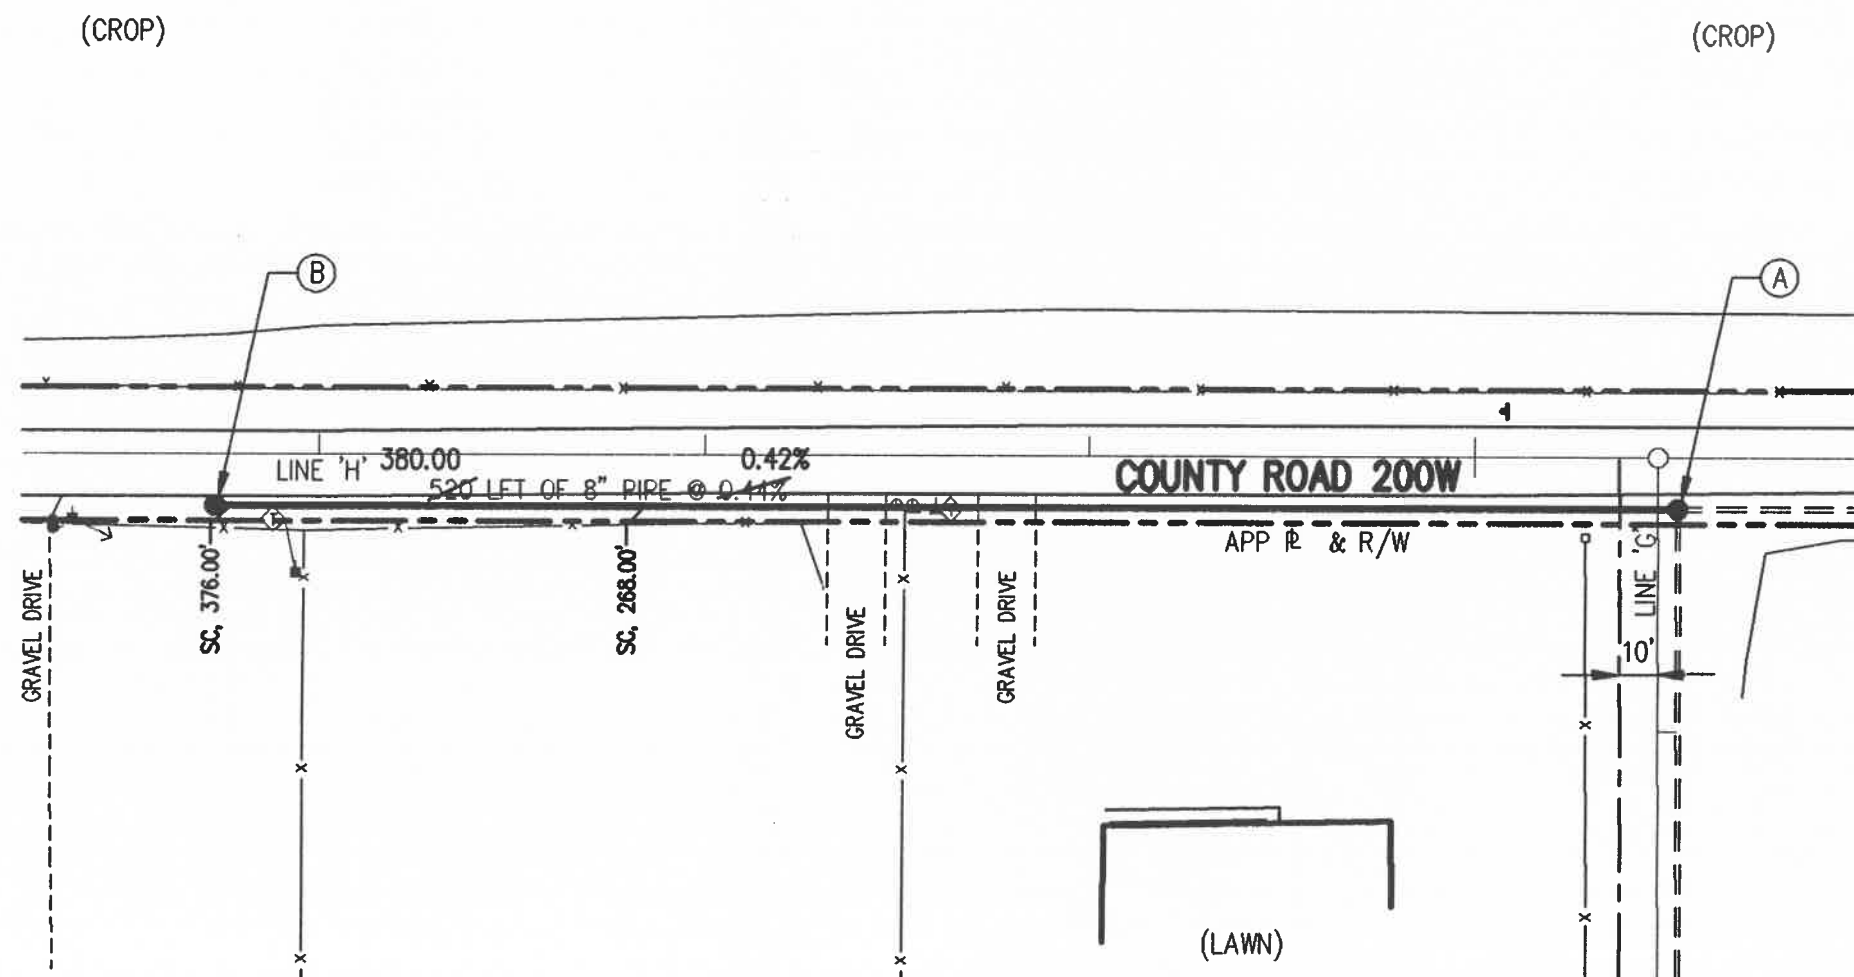

AS-BUILT NOTES:

1. ALL LATERAL LOCATIONS ARE FROM CENTER OF CASTING OF DOWN STREAM M.H.

AS-BUILT INFORMATION

SCALE: 1" = 50'



TRIAD
ASSOCIATES
INC.
INDIANAPOLIS, INDIANA

