

FALL CREEK REGIONAL
WASTE DISTRICT
HICKORY HILLS SUBDIVISION
CONTRACT 'II'

SHEET No. 12b OF 13


INDEX SA-1

KEYNOTES

- (A) STRUCTURE No. 31
T.C. = 885.50
INV.(N) = 881.44
INV. ϕ = 874.80
- (B) STRUCTURE No. 32
T.C. = 883.62
INV. ϕ = 875.92

LEGEND:

- | | | | |
|-------|---------------------------|-------|-------------------------------|
| ===== | EXISTING DRAINAGE CULVERT | — W — | WATER LINE |
| ● | PROPOSED SANITARY MANHOLE | — G — | GAS LINE |
| ———— | PROPOSED SANITARY SEWER | ⊙ | EXISTING UTILITY POLE W/GUY |
| ▲ | EXISTING SIGN | ⚡ | EXISTING UTILITY POLE |
| ⊕ | EXISTING MAILBOX | ⊙ | WATER WELL |
| ---- | RIGHT OF WAY | ⊞ | EXISTING ELECTRIC TRANSFORMER |
| ---- | PROPERTY LINE | | |
| —x— | EXISTING FENCE LINE | | |
- SC, 301.50' — AS-BUILT LATERAL LOCATION
(CONTRACT II SEWER LATERALS ARE 4 TO 5 FEET DEEP AT R/W LINE)

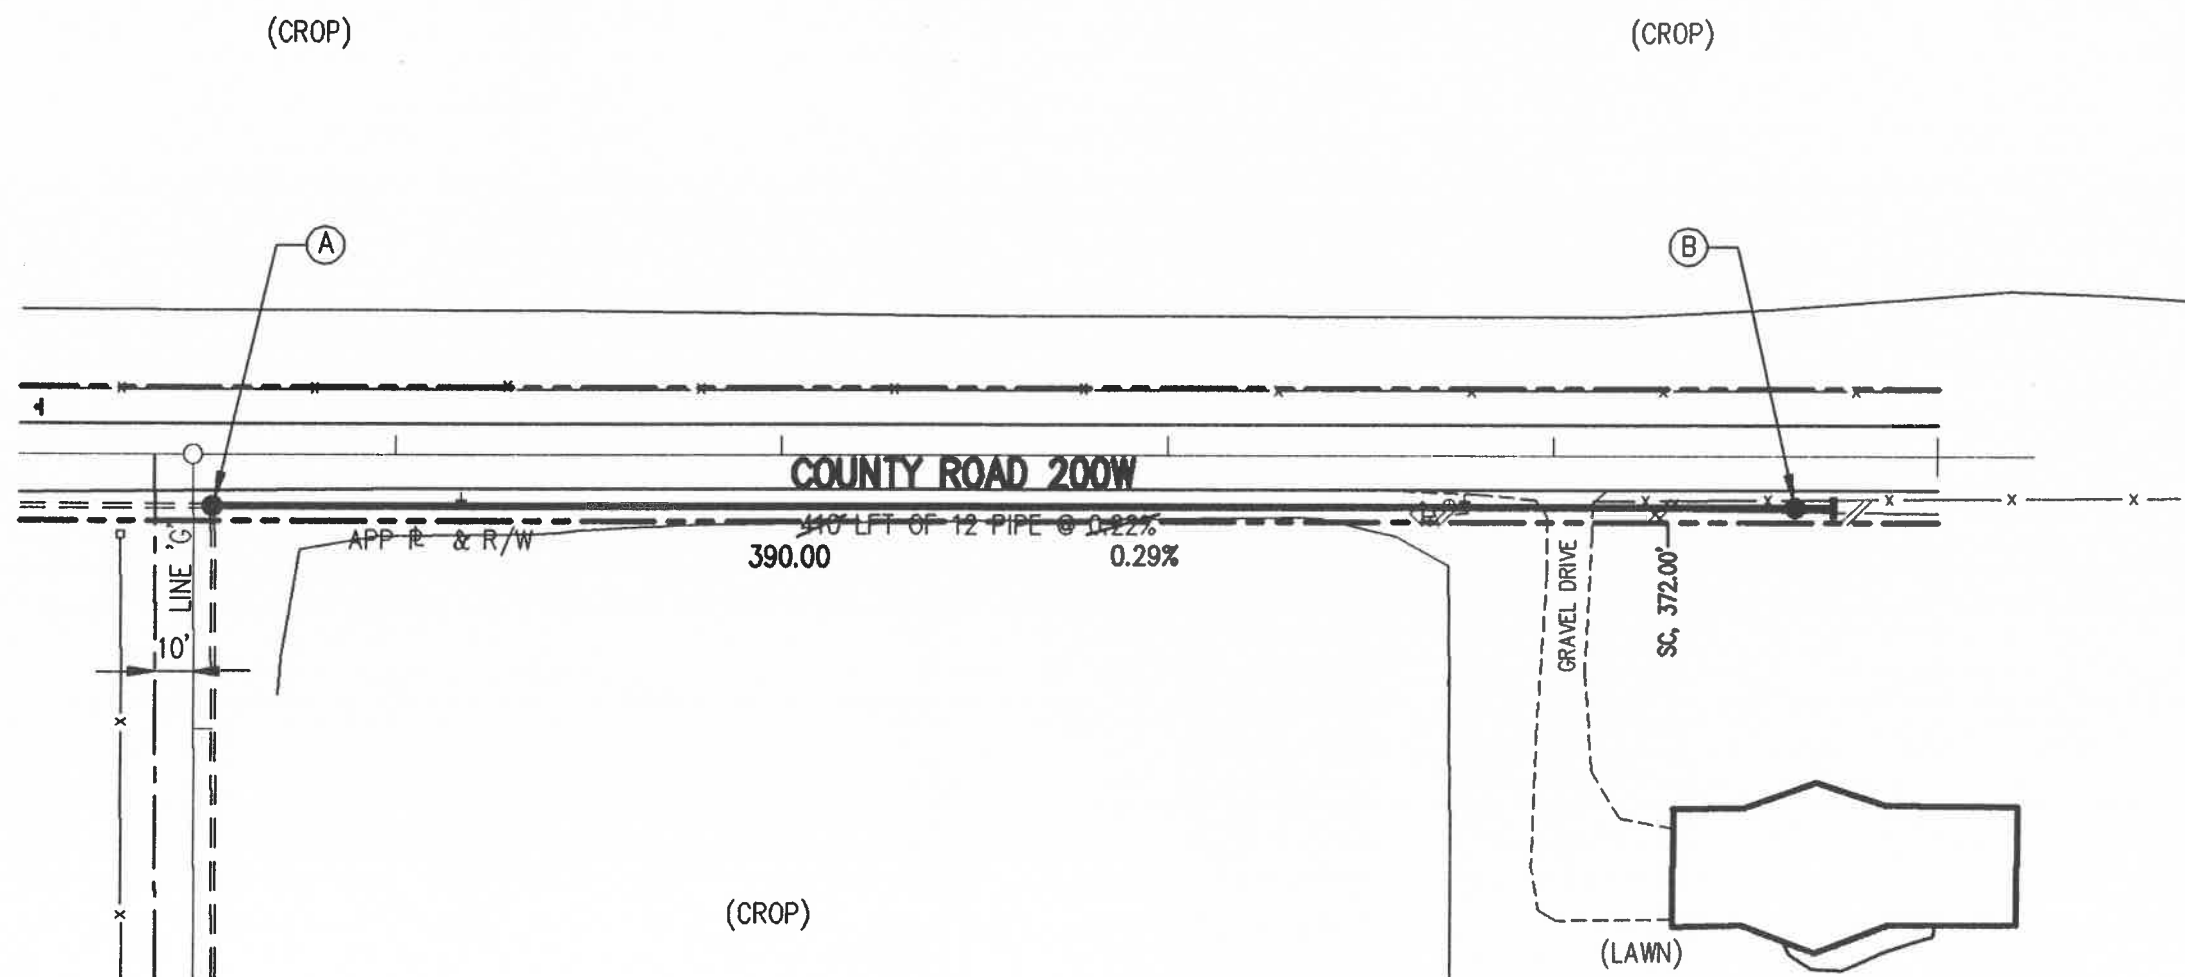

AS-BUILT NOTES:

- ALL LATERAL LOCATIONS ARE FROM CENTER OF CASTING OF DOWN STREAM M.H.

AS-BUILT INFORMATION

SCALE: 1" = 50'



TRIAD
ASSOCIATES
INC.
INDIANAPOLIS, INDIANA