

FALL CREEK REGIONAL WASTE DISTRICT

HICKORY HILLS SUBDIVISION
CONTRACT 'II'

SHEET No. 3a OF 13

INDEX SA-1




SCALE: 1" = 50'

KEYNOTES

- (A) STRUCTURE No. 10
INV.(N) = 857.60
- (B) STRUCTURE No. 11
T.C. = 865.10
INV. ϕ = 859.00
- (C) STRUCTURE No. 12
T.C. = 866.92
INV. ϕ = 860.42

LEGEND:

- == == == == EXISTING DRAINAGE CULVERT
- PROPOSED SANITARY MANHOLE
- PROPOSED SANITARY SEWER
- ▲ EXISTING SIGN
- ⊕ EXISTING MAILBOX
- RIGHT OF WAY
- PROPERTY LINE
- x- EXISTING FENCE LINE
- W WATER LINE
- G GAS LINE
- EXISTING UTILITY POLE W/GUY
- EXISTING UTILITY POLE
- ⊙ WATER WELL
- ⊞ EXISTING ELECTRIC TRANSFORMER
- SC, 301.50' AS-BUILT LATERAL LOCATION
(CONTRACT II SEWER LATERALS ARE
4 TO 5 FEET DEEP AT R/W LINE)

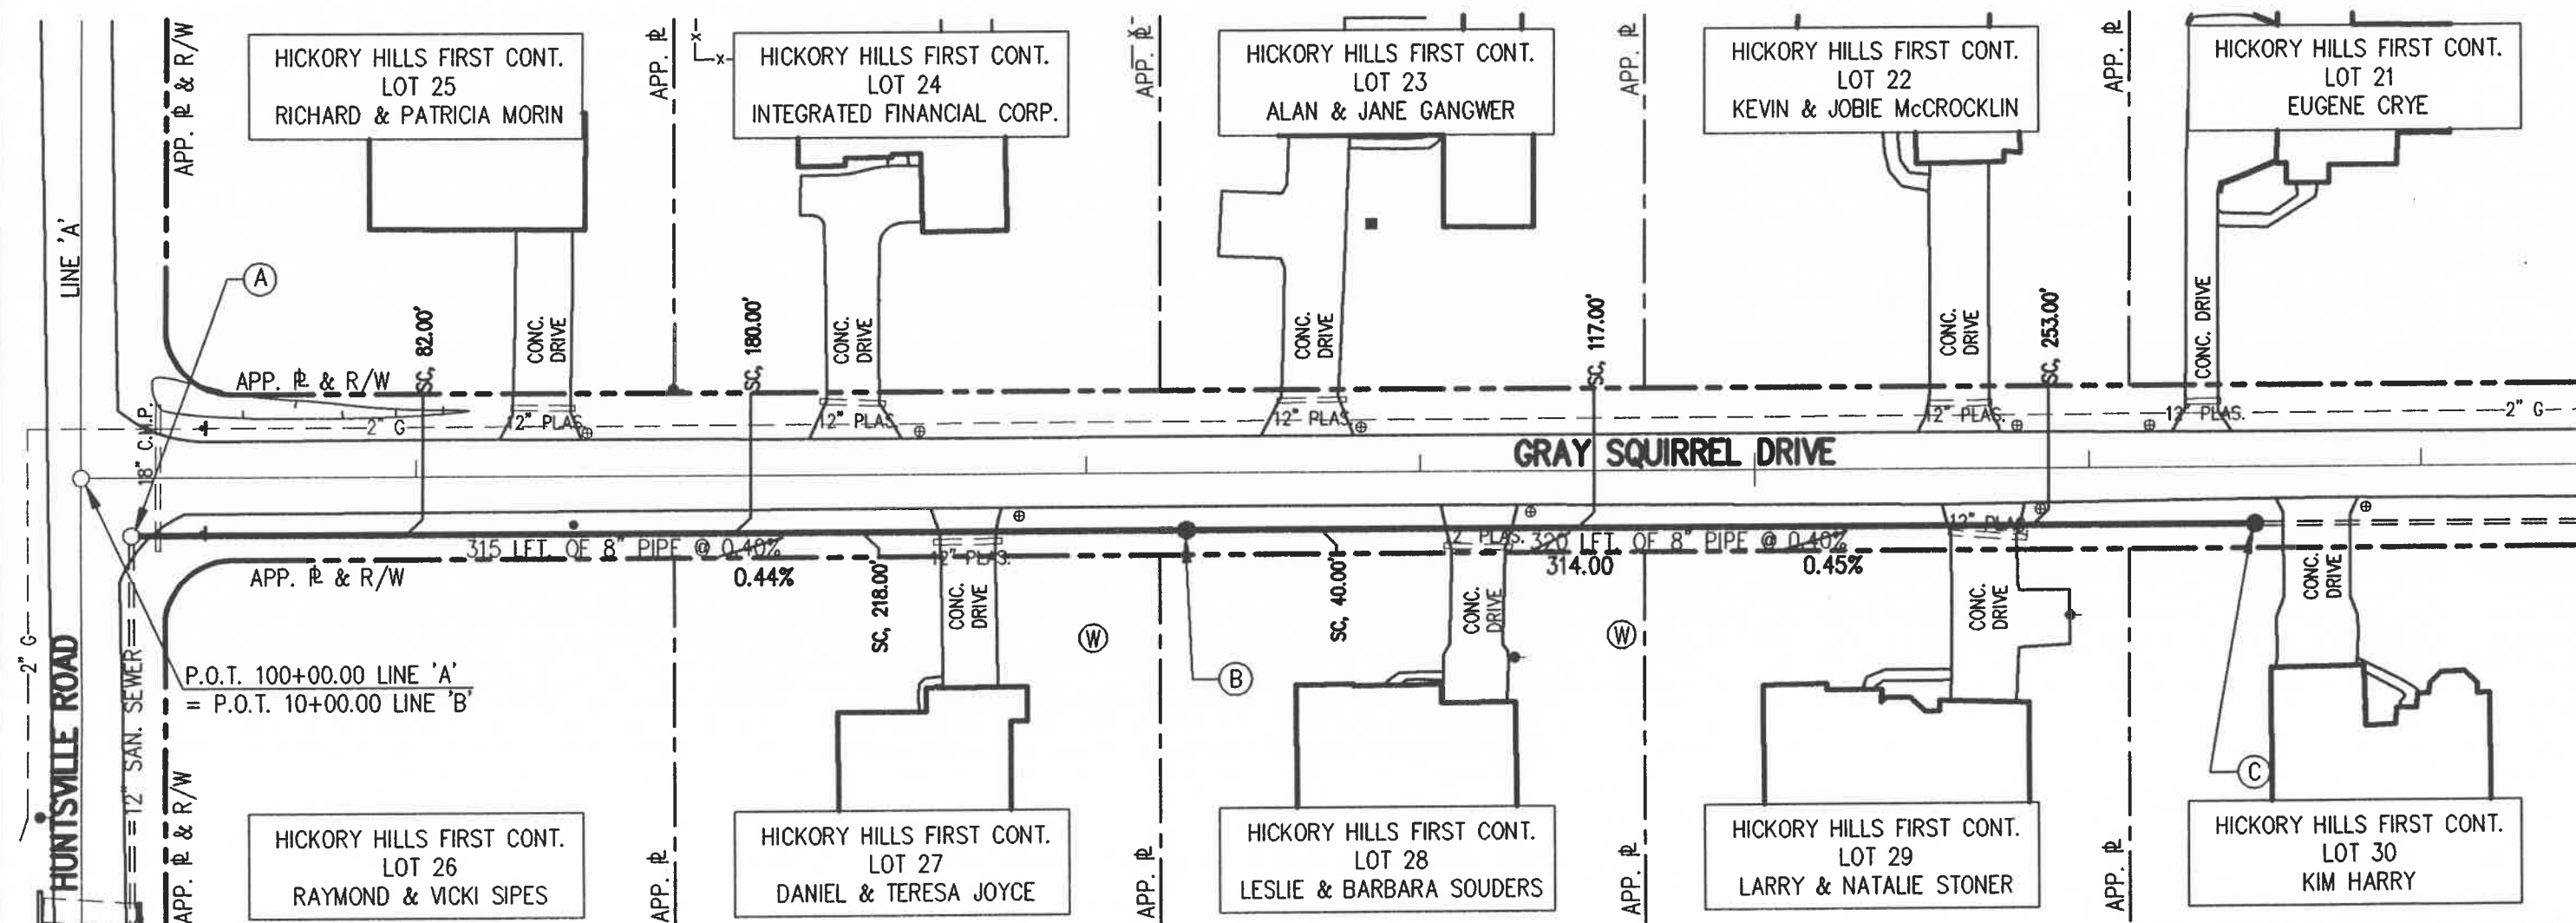

AS-BUILT INFORMATION

SCALE: 1" = 50'



NORTH

TRIAD
ASSOCIATES
INC.

INDIANAPOLIS, INDIANA

