

FALL CREEK REGIONAL WASTE DISTRICT

HICKORY HILLS SUBDIVISION
CONTRACT 'II'

SHEET No. 3b OF 13

INDEX SA-1




SCALE: 1" = 50'

KEYNOTES

- (A) STRUCTURE No. 12
T.C. = 866.92
INV. ϕ = 860.42
- (B) STRUCTURE No. 13
T.C. = 882.13
INV.(NE) = 874.03
INV. ϕ = 870.41
- (C) STRUCTURE No. 14
T.C. = 884.15
INV. ϕ = 871.75

==	EXISTING DRAINAGE CULVERT	---	W	---	WATER LINE
●	PROPOSED SANITARY MANHOLE	---	G	---	GAS LINE
---	PROPOSED SANITARY SEWER	⊙			EXISTING UTILITY POLE W/GUY
▲	EXISTING SIGN	⚡			EXISTING UTILITY POLE
⊕	EXISTING MAILBOX	(W)			WATER WELL
---	RIGHT OF WAY	⊞			EXISTING ELECTRIC TRANSFORMER
---	PROPERTY LINE	SC, 301.50'			AS-BUILT LATERAL LOCATION (CONTRACT II SEWER LATERALS ARE 4 TO 5 FEET DEEP AT R/W LINE)
-x-	EXISTING FENCE LINE				

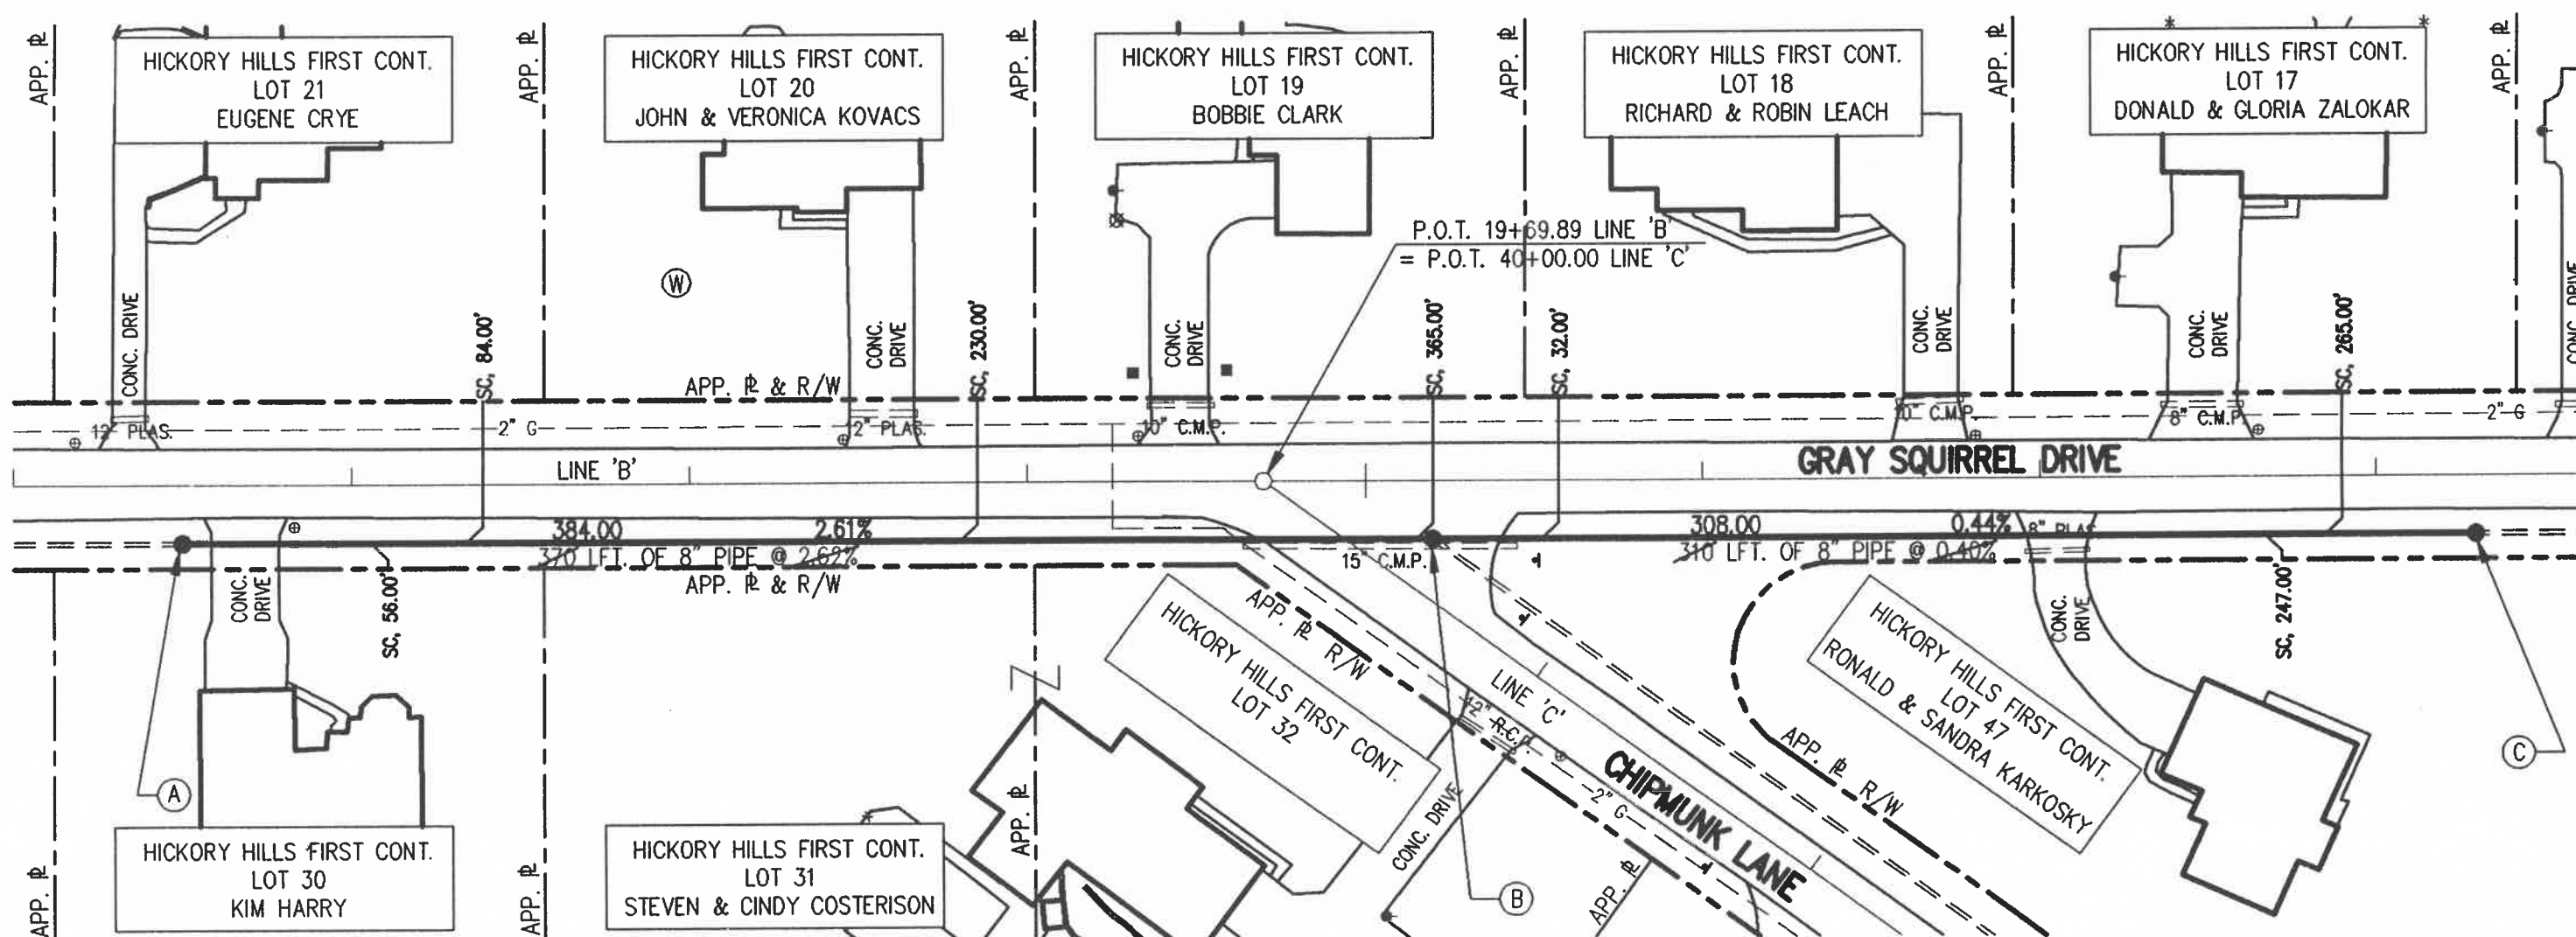

AS-BUILT INFORMATION

SCALE: 1" = 50'



NORTH

TRIAD
ASSOCIATES
INC.

INDIANAPOLIS, INDIANA

