

**FALL CREEK REGIONAL
WASTE DISTRICT**
HICKORY HILLS SUBDIVISION
CONTRACT 'II'
SHEET No. 4a OF 13

INDEX SA-1




KEYNOTES

- (A) STRUCTURE No. 14
T.C. = 884.15
INV. ℓ = 871.75
- (B) STRUCTURE No. 15
T.C. = 885.62
INV. ℓ = 873.32
- (C) STRUCTURE No. 16
T.C. = 886.95
INV. ℓ = 874.85

LEGEND:

- EXISTING DRAINAGE CULVERT
- PROPOSED SANITARY MANHOLE
- PROPOSED SANITARY SEWER
- ▲ EXISTING SIGN
- ⊕ EXISTING MAILBOX
- RIGHT OF WAY
- PROPERTY LINE
- EXISTING FENCE LINE
- W --- WATER LINE
- G --- GAS LINE
- EXISTING UTILITY POLE W/GUY
- EXISTING UTILITY POLE
- ⊙ WATER WELL
- ⊠ EXISTING ELECTRIC TRANSFORMER
- SC, 301.50' AS-BUILT LATERAL LOCATION
(CONTRACT II SEWER LATERALS ARE
4 TO 5 FEET DEEP AT R/W LINE)

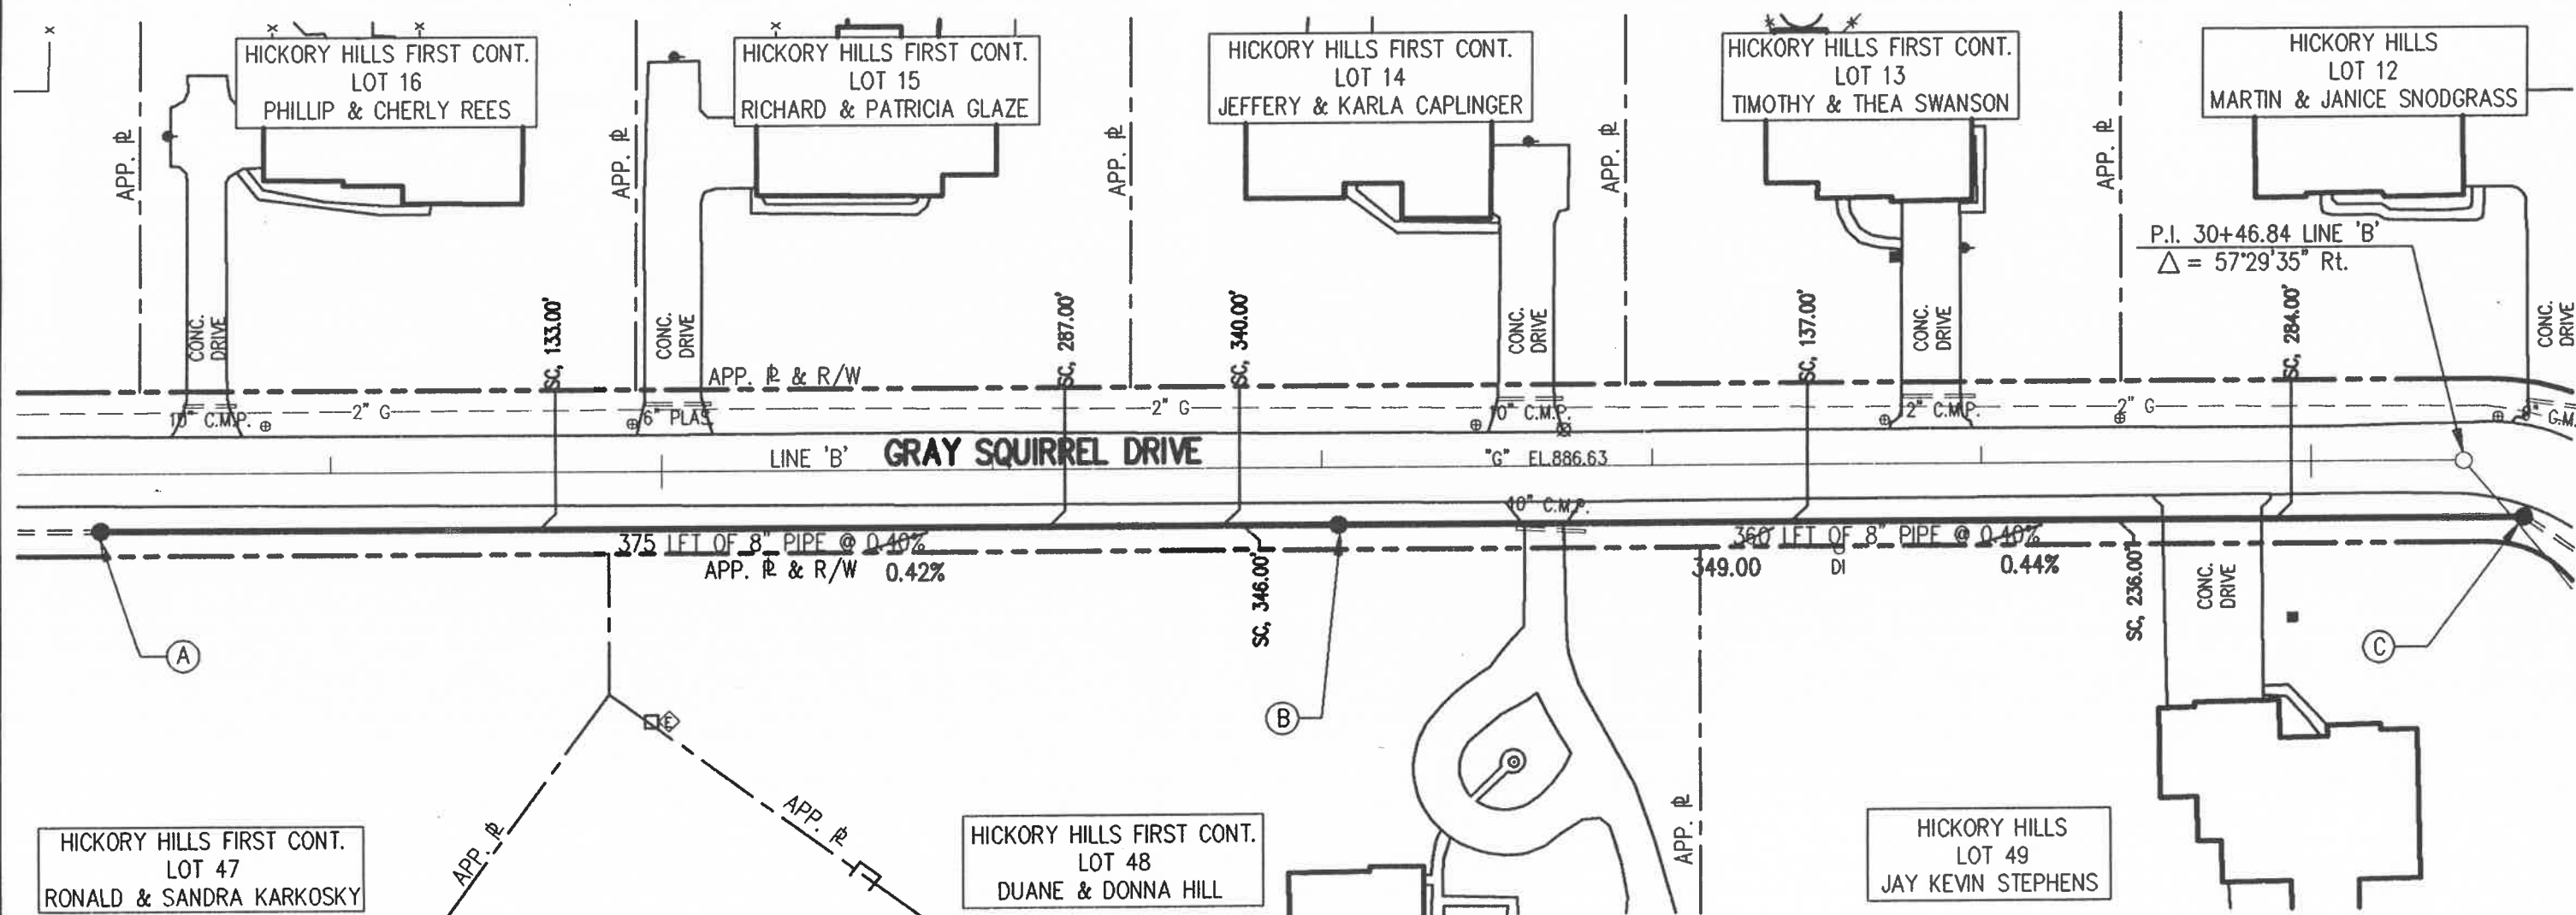

AS-BUILT INFORMATION

SCALE: 1" = 50'



**TRIAD
ASSOCIATES
INC.**
INDIANAPOLIS, INDIANA