

**FALL CREEK REGIONAL
WASTE DISTRICT
HICKORY HILLS SUBDIVISION
CONTRACT 'II'**

SHEET No. 4b OF 13

INDEX SA-1




KEYNOTES

- (A) STRUCTURE No. 16
T.C. = 886.95
INV. ℓ = 874.85
- (B) STRUCTURE No. 17
T.C. = 887.77
INV. ℓ = 875.27
- (C) STRUCTURE No. 18
T.C. = 886.96
INV. ℓ = 876.46
- (D) STRUCTURE No. 19
T.C. = 883.53
INV. ℓ = 877.63

LEGEND:

- == == == == EXISTING DRAINAGE CULVERT
- PROPOSED SANITARY MANHOLE
- PROPOSED SANITARY SEWER
- ▲ EXISTING SIGN
- ⊕ EXISTING MAILBOX
- RIGHT OF WAY
- PROPERTY LINE
- x- EXISTING FENCE LINE
- W — WATER LINE
- G — GAS LINE
- EXISTING UTILITY POLE W/GUY
- EXISTING UTILITY POLE
- ⊙ WATER WELL
- ⊠ EXISTING ELECTRIC TRANSFORMER
- SC, 301.50' AS-BUILT LATERAL LOCATION
(CONTRACT II SEWER LATERALS ARE
4 TO 5 FEET DEEP AT R/W LINE)

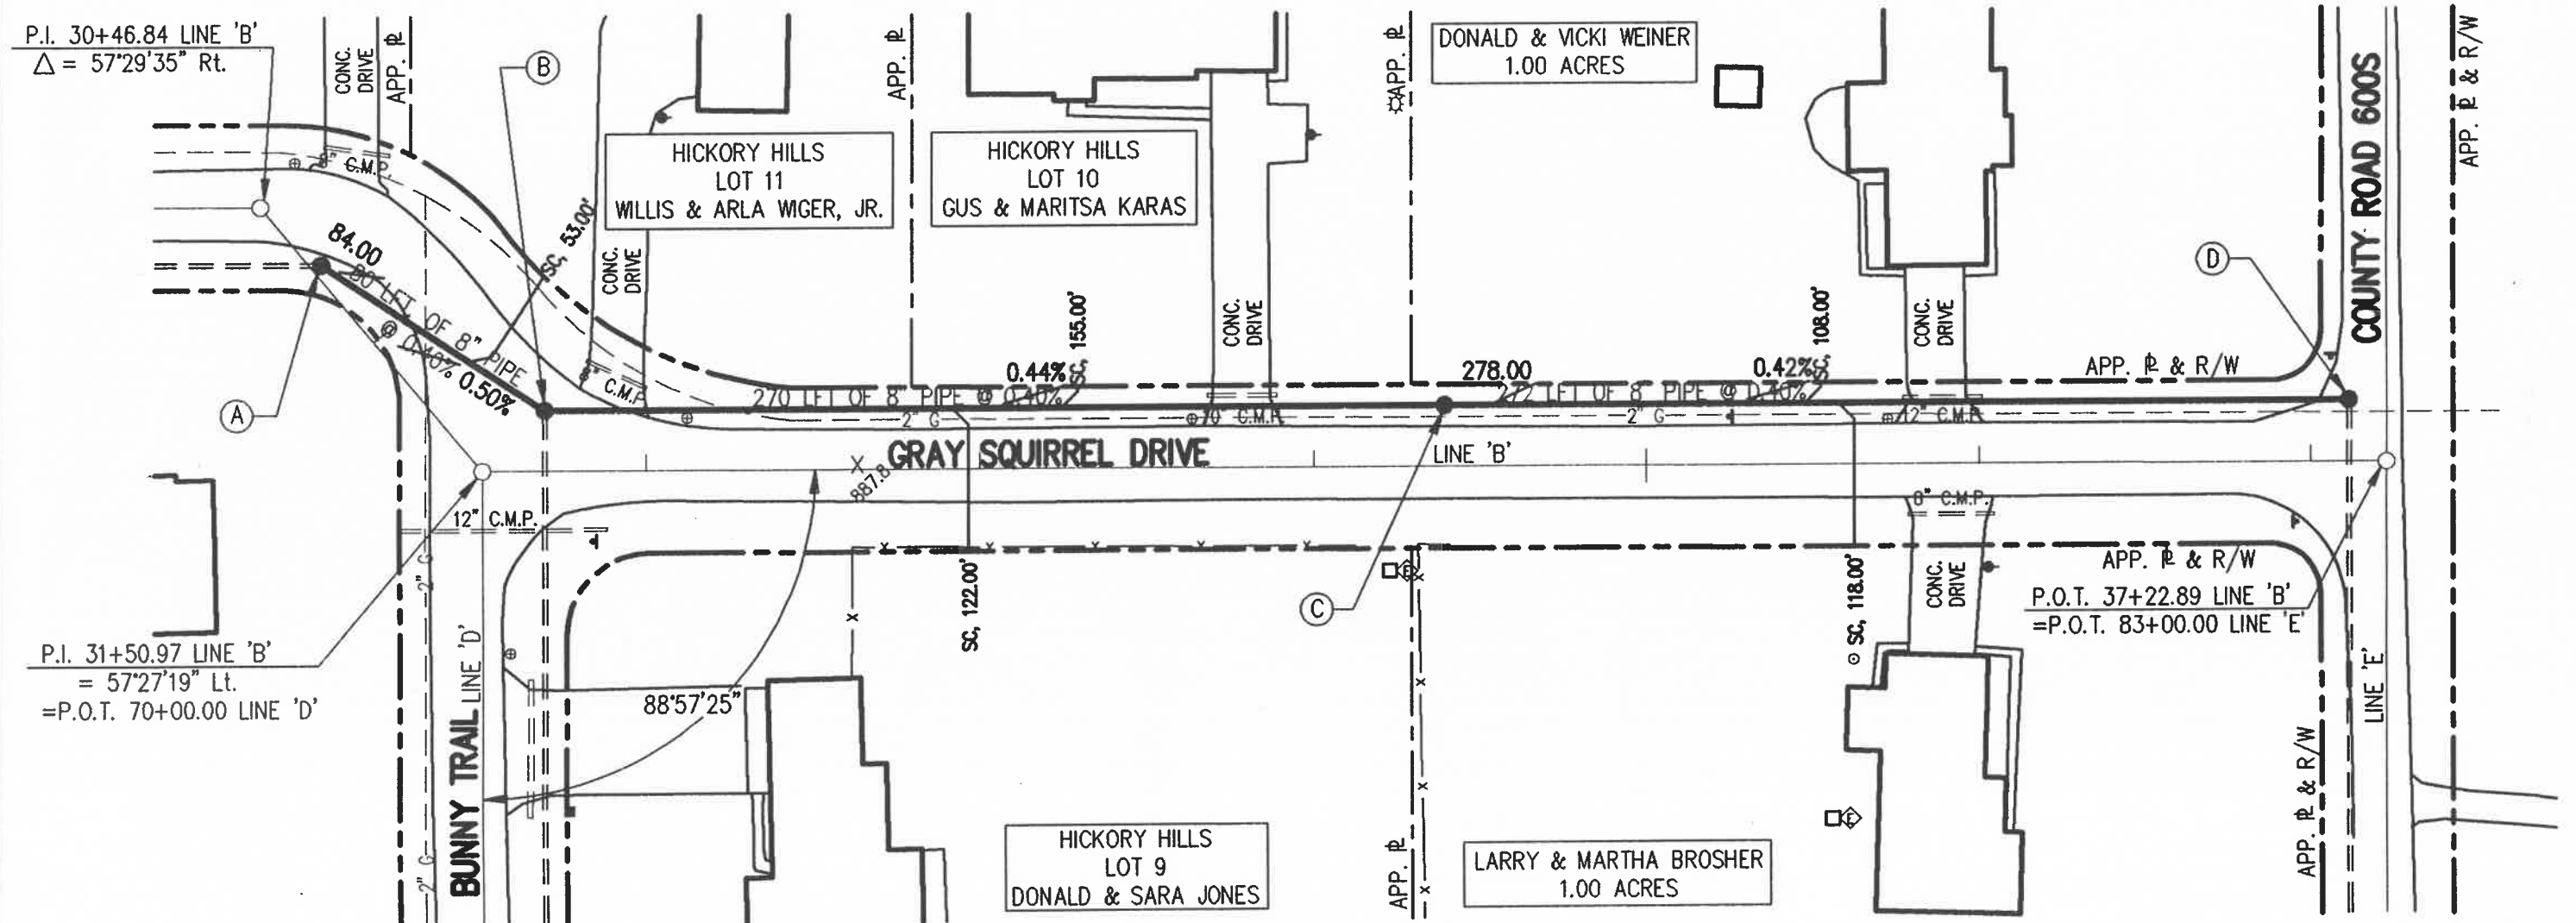

AS-BUILT INFORMATION

SCALE: 1" = 50'



**TRIAD
ASSOCIATES
INC.**
INDIANAPOLIS, INDIANA