


SHEET No. 5b OF 13

INDEX SA-1

(A) STRUCTURE No. 19a
T.C. = 888.78
INV. ¢ = 881.98

(B) STRUCTURE No. 19b
T.C. = 889.95
INV. ¢ = 883.25

==	EXISTING DRAINAGE CULVERT	— W —	WATER LINE
●	PROPOSED SANITARY MANHOLE	— G —	GAS LINE
—	PROPOSED SANITARY SEWER	●	EXISTING UTILITY POLE W/GUY
⌒	EXISTING SIGN	⌒	EXISTING UTILITY POLE
⊕	EXISTING MAILBOX	⊕	WATER WELL
— · — · —	RIGHT OF WAY	⊞	EXISTING ELECTRIC TRANSFORMER
— — —	PROPERTY LINE	SC, 301.50'	AS-BUILT LATERAL LOCATION (CONTRACT II SEWER LATERALS ARE 4 TO 5 FEET DEEP AT R/W LINE)
— x —	EXISTING FENCE LINE		

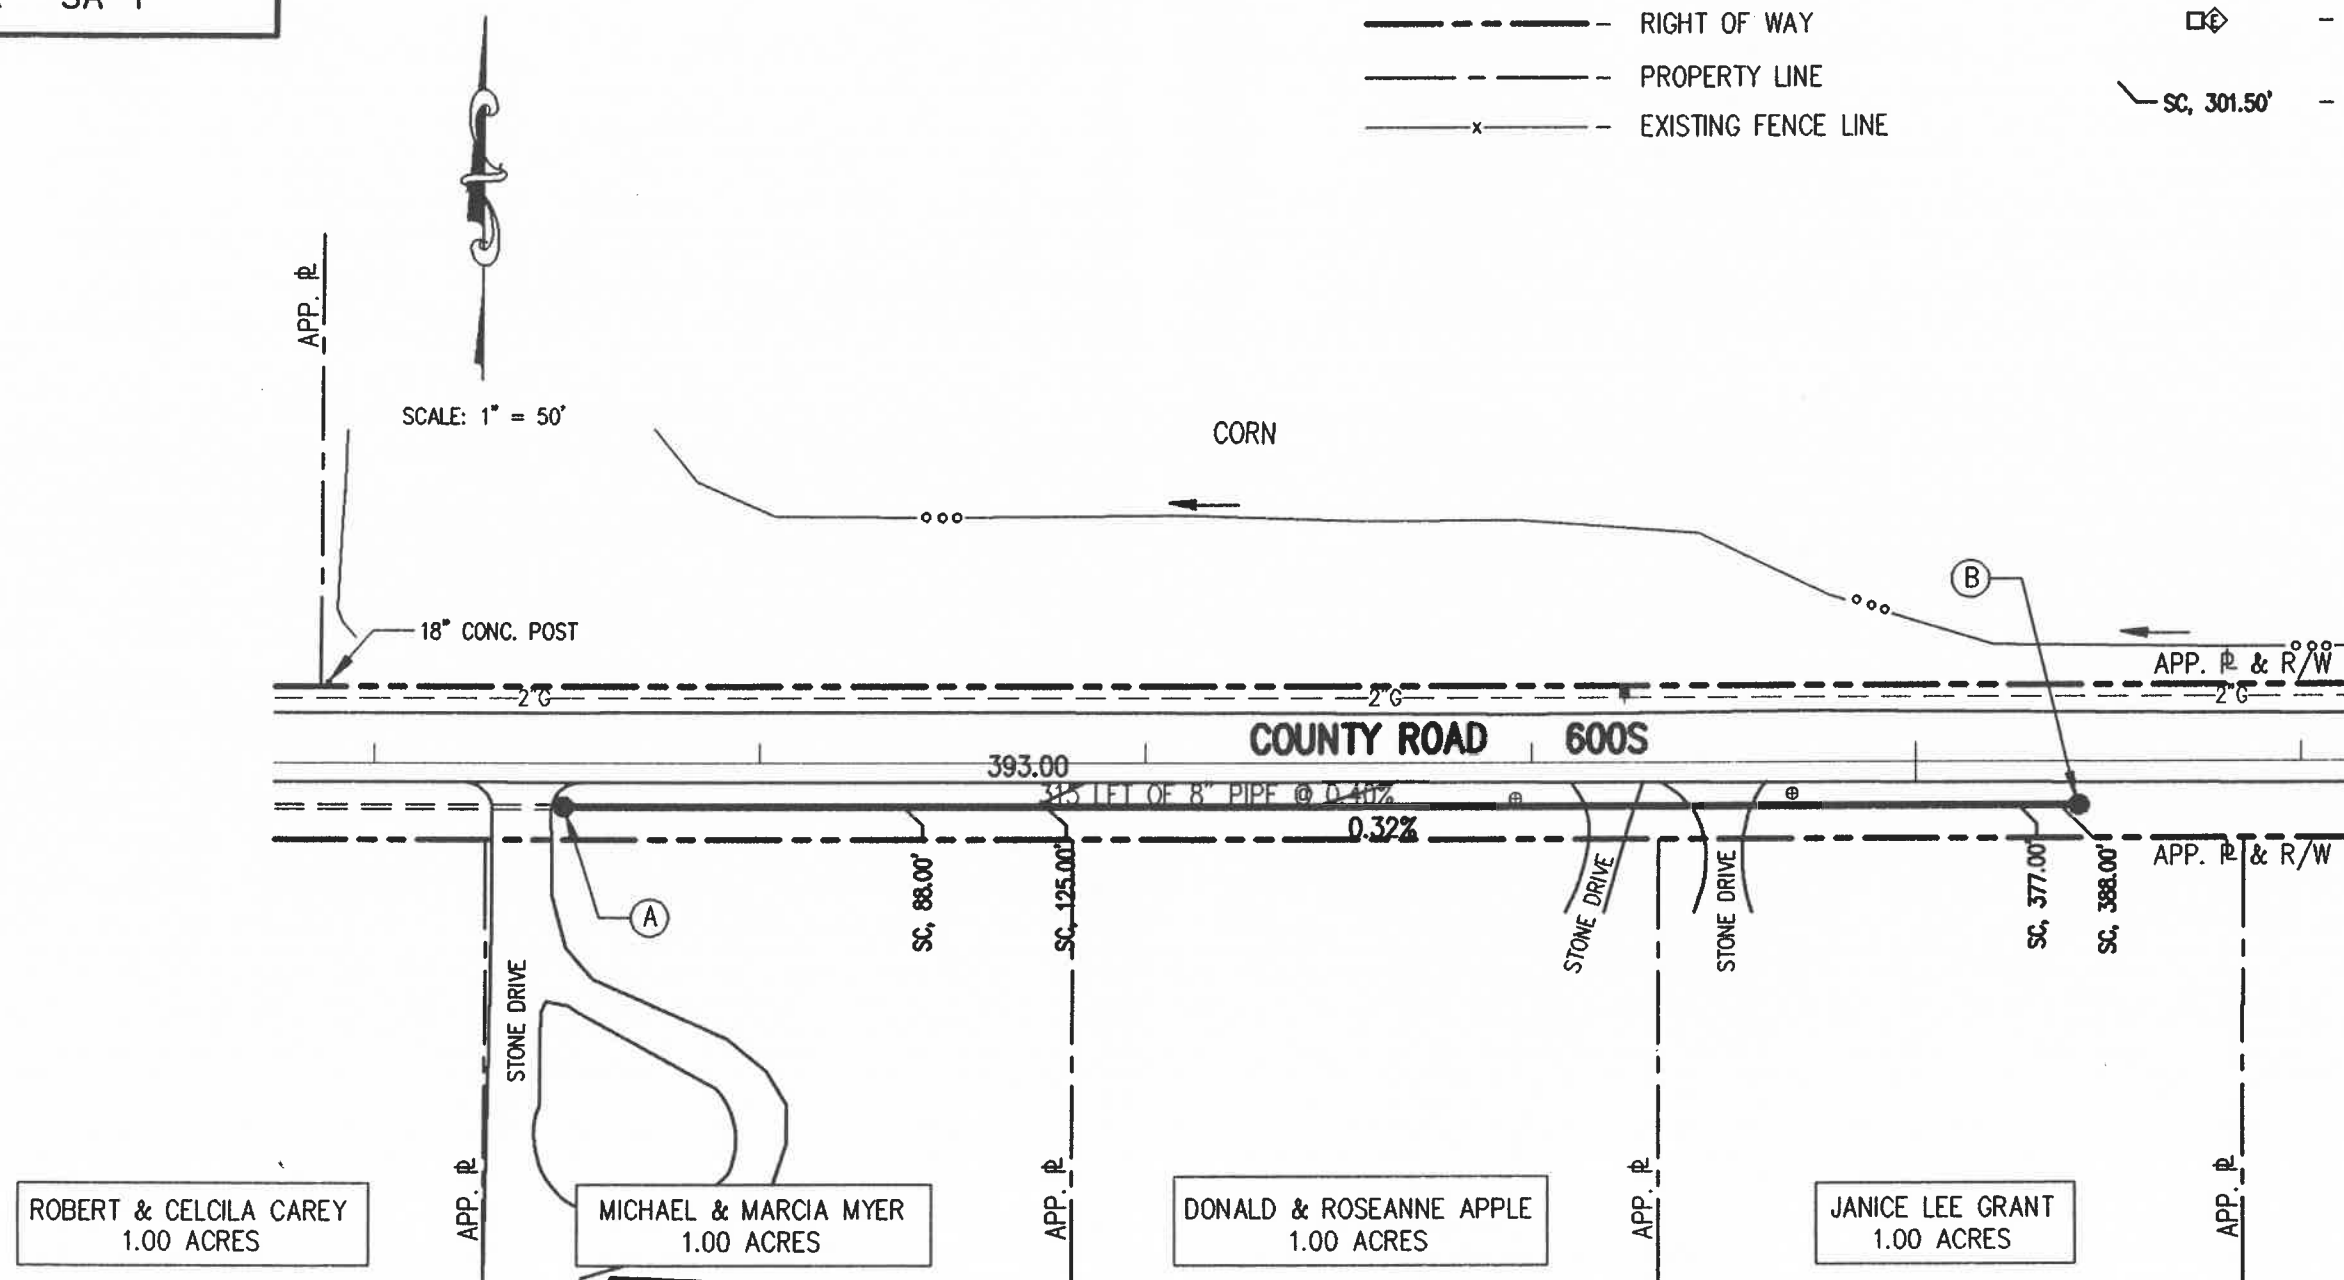

1. ALL LATERAL LOCATIONS ARE FROM CENTER OF CASTING OF DOWN STREAM M.H.

SCALE: 1" = 50'



**TRIAD
ASSOCIATES
INC.**

INDIANAPOLIS, INDIANA

