

HICKORY HILLS SUBDIVISION
CONTRACT 'II'

INDEX SA-1




(A) STRUCTURE No. 17
T.C. = 887.77
INV. Q = 875.27

(B) STRUCTURE No. 17a
T.C. = 887.41
INV. Q = 876.71

(C) STRUCTURE No. 17b
T.C. = 887.15
INV. Q = 878.05

=====	-	EXISTING DRAINAGE CULVERT	--- W ---	-	WATER LINE
●	-	PROPOSED SANITARY MANHOLE	--- G ---	-	GAS LINE
=====	-	PROPOSED SANITARY SEWER	●-	-	EXISTING UTILITY POLE W/GUY
▲	-	EXISTING SIGN	⚡	-	EXISTING UTILITY POLE
⊕	-	EXISTING MAILBOX	⊙(W)	-	WATER WELL
-----	-	RIGHT OF WAY	□⬡	-	EXISTING ELECTRIC TRANSFORMER
-----	-	PROPERTY LINE	SC, 301.50'	-	AS-BUILT LATERAL LOCATION (CONTRACT II SEWER LATERALS ARE 4 TO 5 FEET DEEP AT R/W LINE)
-----x-----	-	EXISTING FENCE LINE			

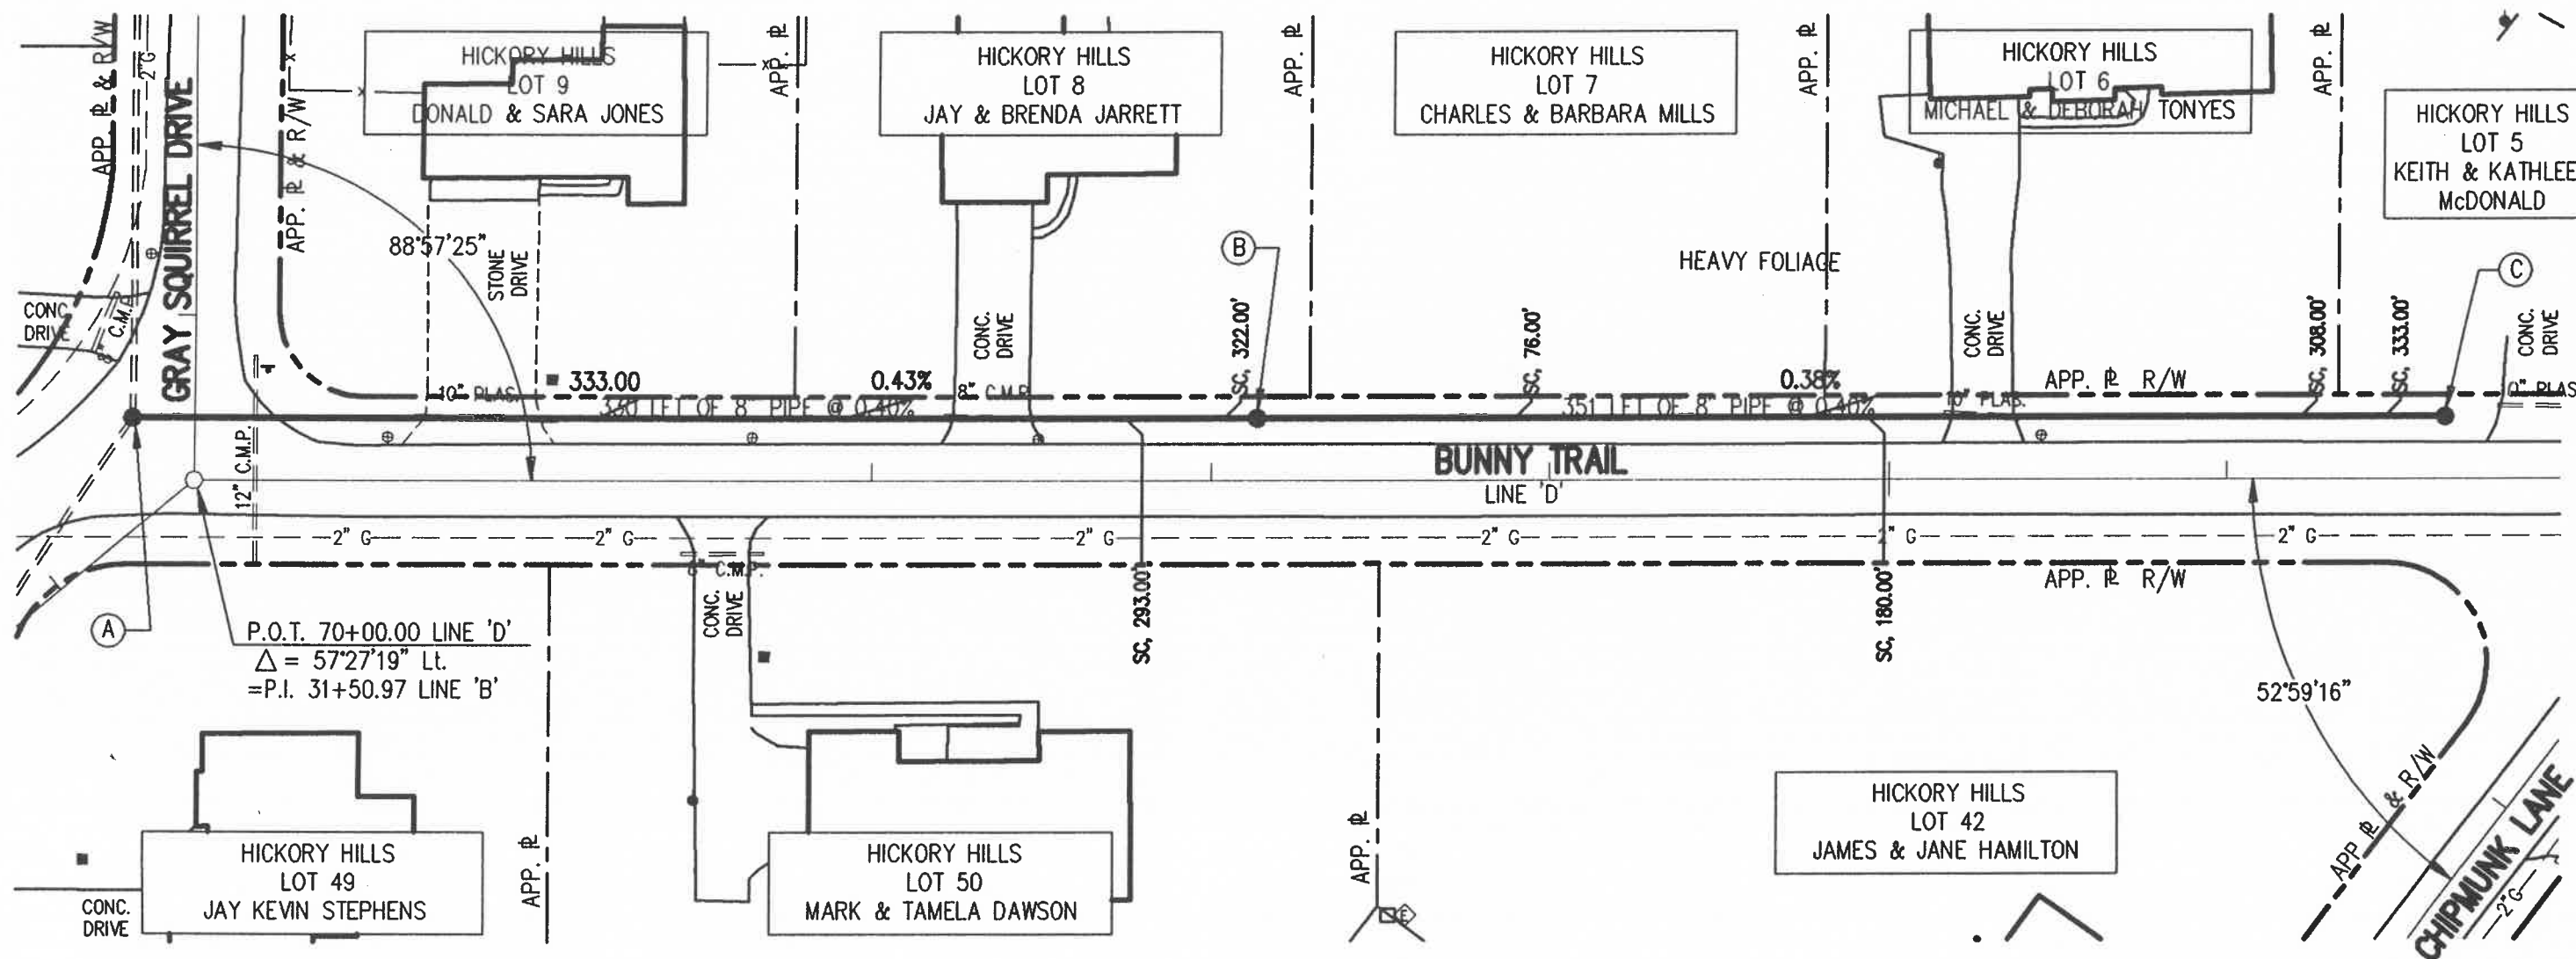

1. ALL LATERAL LOCATIONS ARE FROM CENTER OF CASTING OF DOWN STREAM M.H.

SCALE: 1" = 50'



TRIAD
ASSOCIATES
INC.

INDIANAPOLIS, INDIANA

