

**FALL CREEK REGIONAL  
WASTE DISTRICT**  
HICKORY HILLS SUBDIVISION  
CONTRACT 'II'  
SHEET No. 7a OF 13


INDEX SA-1

**KEYNOTES**

- (A) STRUCTURE No. 13  
T.C. = 882.13  
INV.(NE) = 874.03  
INV.  $\phi$  = 870.41
- (B) STRUCTURE No. 13a  
T.C. = 883.43  
INV.  $\phi$  = 876.43

**LEGEND:**

- |       |                           |             |                                                                                               |
|-------|---------------------------|-------------|-----------------------------------------------------------------------------------------------|
| ===== | EXISTING DRAINAGE CULVERT | --- W ---   | WATER LINE                                                                                    |
| ●     | PROPOSED SANITARY MANHOLE | --- G ---   | GAS LINE                                                                                      |
| ---   | PROPOSED SANITARY SEWER   | ⊙           | EXISTING UTILITY POLE W/GUY                                                                   |
| ▲     | EXISTING SIGN             | ⊙           | EXISTING UTILITY POLE                                                                         |
| ⊕     | EXISTING MAILBOX          | ⊙ W         | WATER WELL                                                                                    |
| ---   | RIGHT OF WAY              | ⊙           | EXISTING ELECTRIC TRANSFORMER                                                                 |
| ---   | PROPERTY LINE             | SC, 301.50' | AS-BUILT LATERAL LOCATION<br>(CONTRACT II SEWER LATERALS ARE<br>4 TO 5 FEET DEEP AT R/W LINE) |
| -x-   | EXISTING FENCE LINE       |             |                                                                                               |

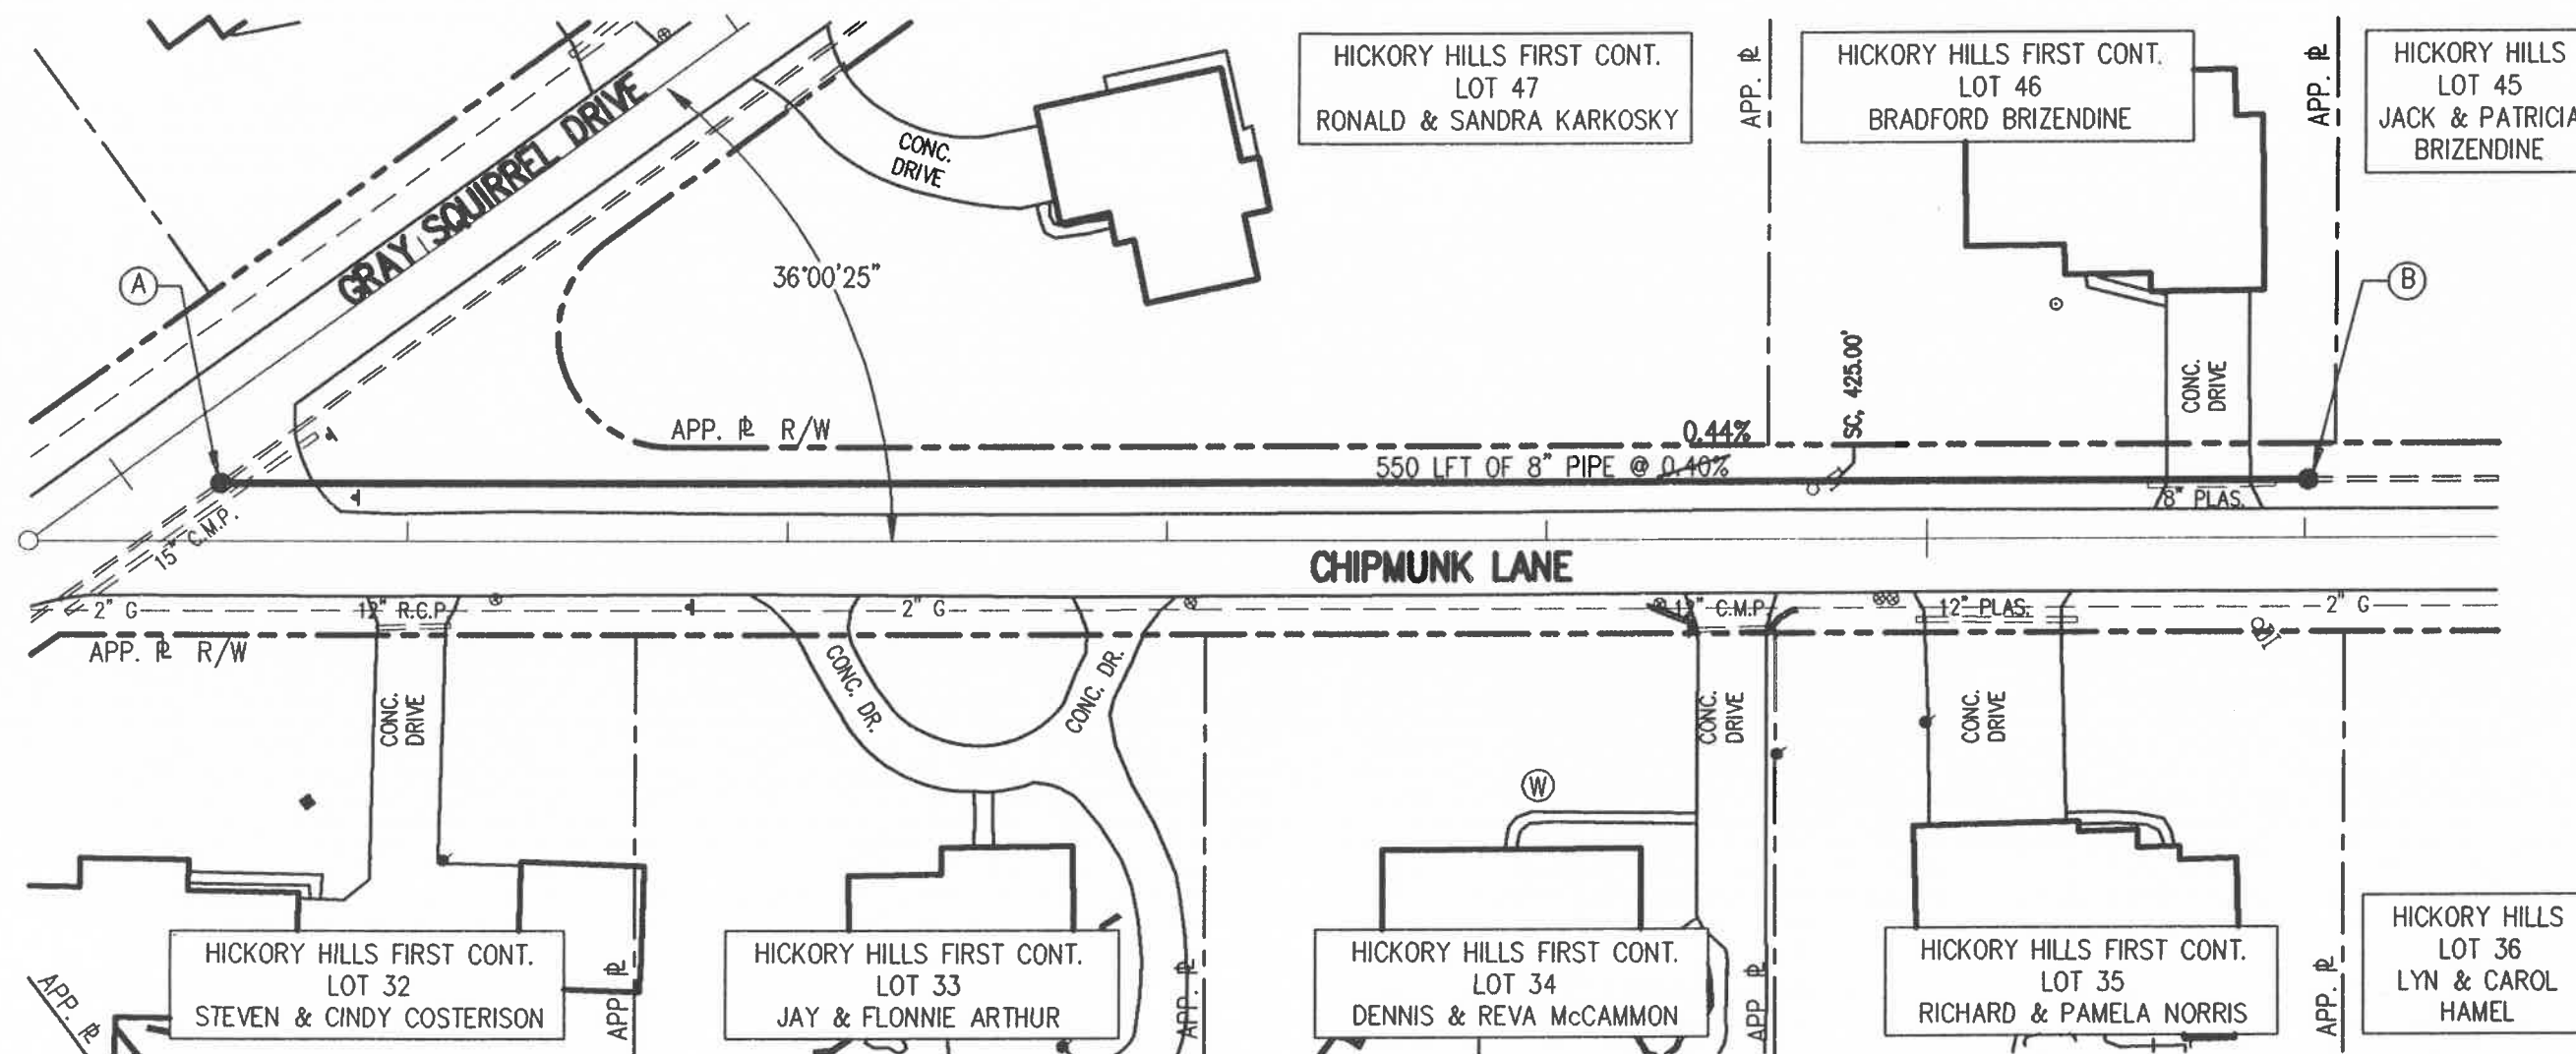

**AS-BUILT NOTES:**

- ALL LATERAL LOCATIONS ARE FROM CENTER OF CASTING OF DOWN STREAM M.H.

**AS-BUILT INFORMATION**

SCALE: 1" = 50'



**TRIAD  
ASSOCIATES  
INC.**  
INDIANAPOLIS, INDIANA