
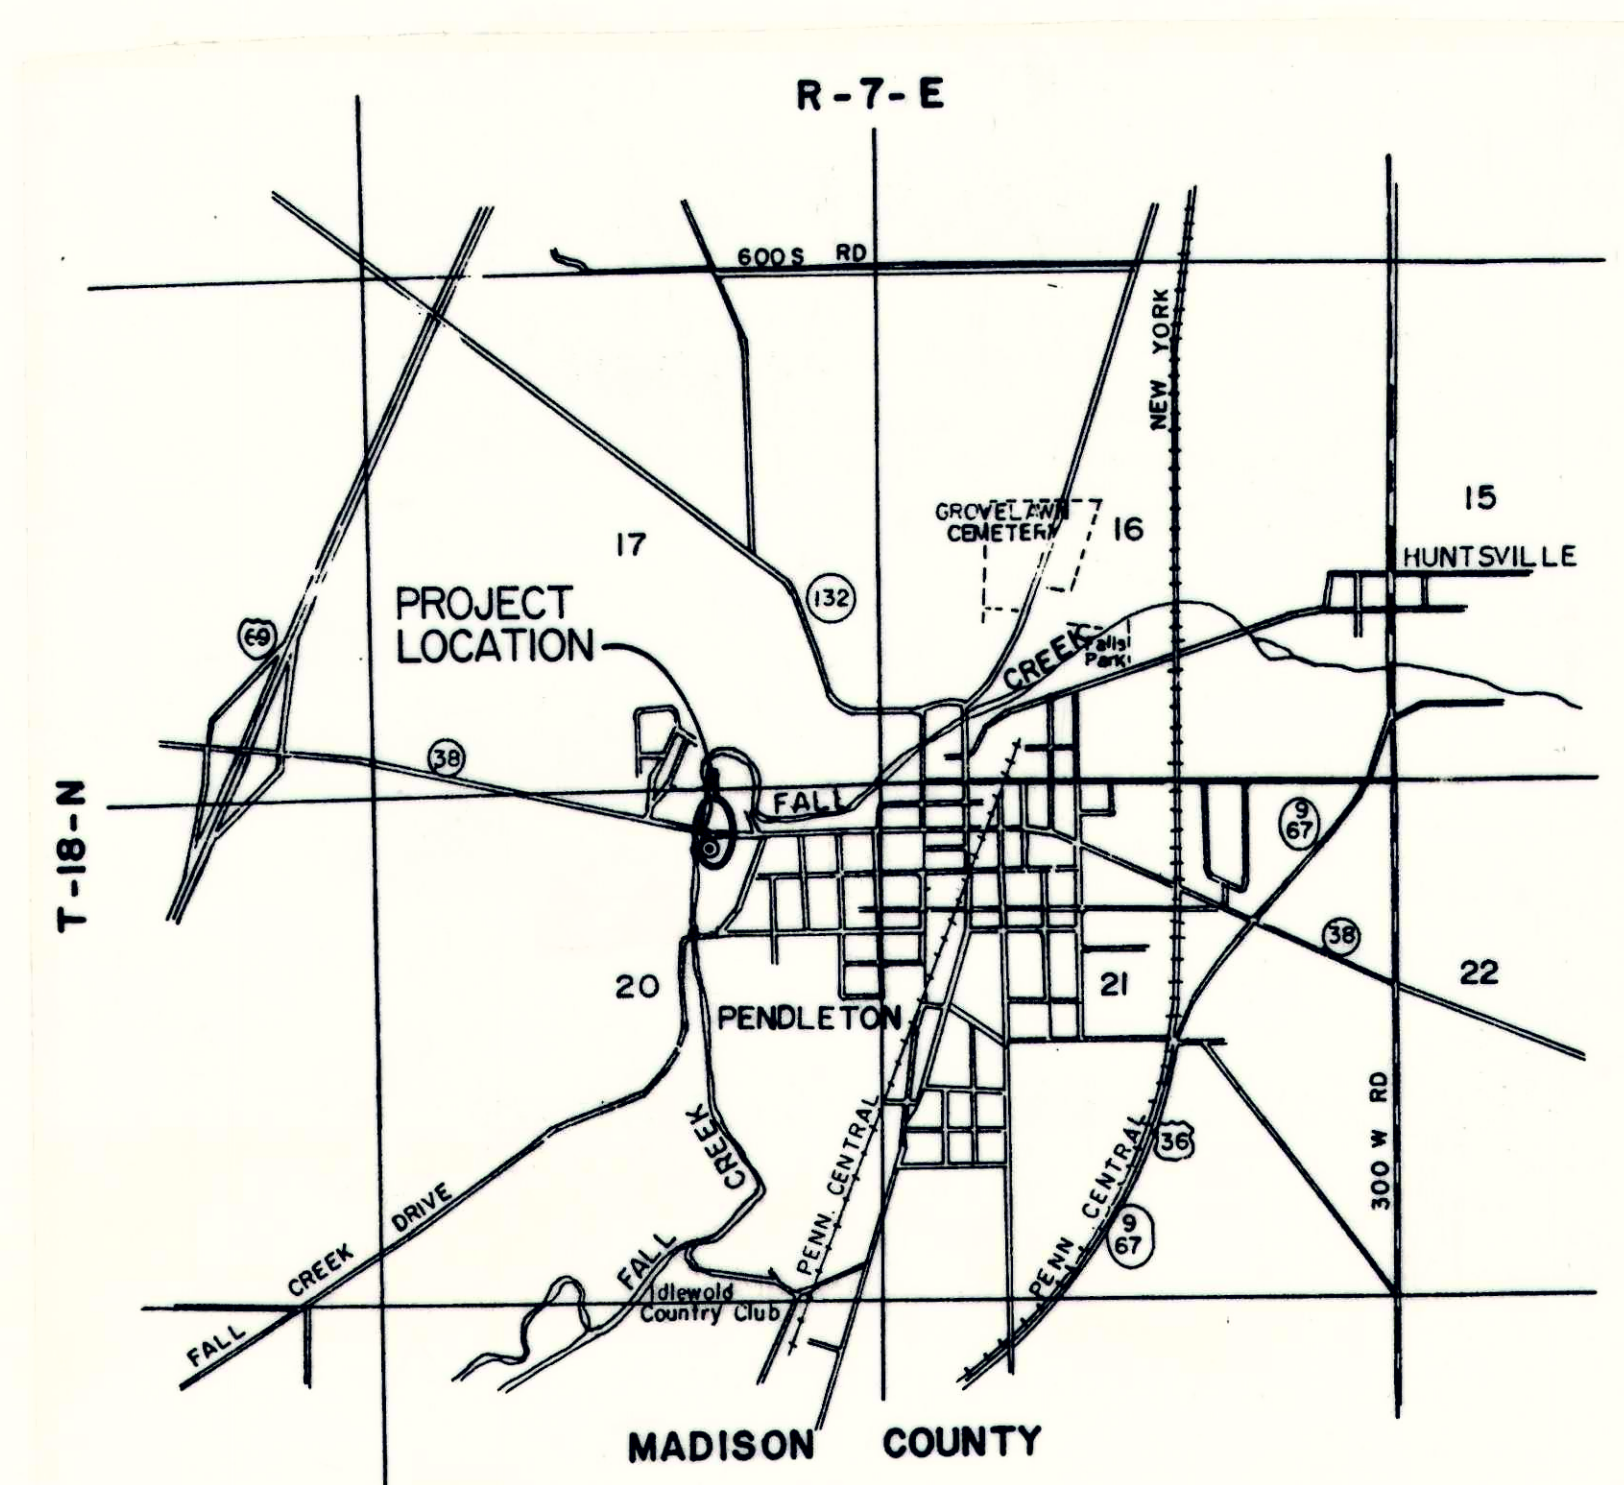


FALL CREEK REGIONAL WASTE DISTRICT PENDLETON SEWER & LIFT STATION RELOCATION

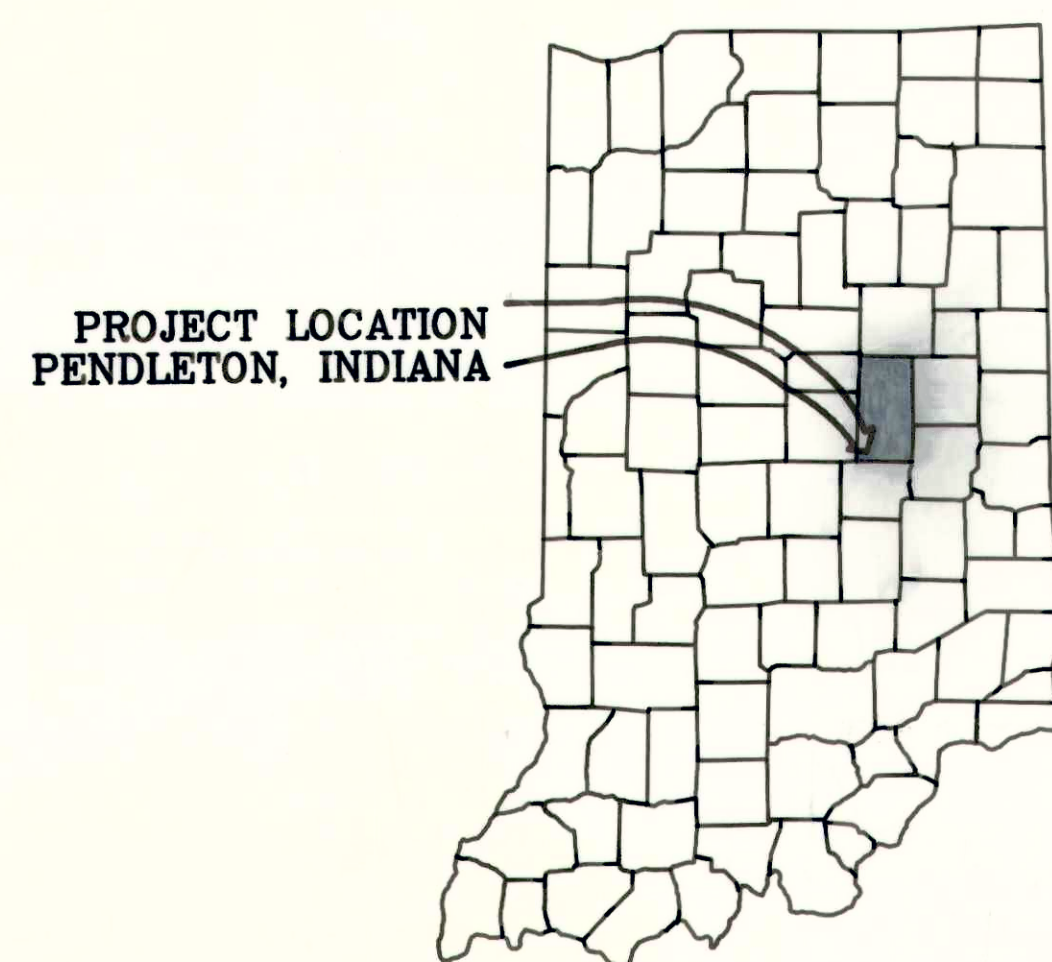

FALL CREEK REGIONAL DISTRICT BOARD

Bill Clark
Bill Clark - President

Morris McCurdy
Morris McCurdy - Member

Charles Hennis
Charles Hennis - Member

Mark Jablonski
Mark Jablonski - Member

Agon Tolbert
Agon Tolbert - Member

Marvin Kelly
Marvin Kelly - Member

Dan Walters
Dan Walters - Member

Marion Morris
Marion Morris - Member

John Ellingwood - Member

Joe Rowlett
Joe Rowlett - General Manager

Date 12/18/91



BEAM, LONGEST & NEFF, INC.
CONSULTING ENGINEERS
INDIANAPOLIS, INDIANA



Gary D. Ladd
CERTIFIED

JAN. 11, 1990
DATE

Eric Reske
CERTIFIED

RECORD DRAWING