



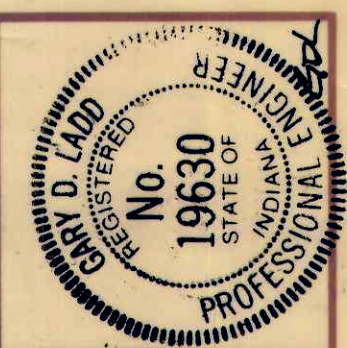

SEWER PLAN & PROFILE
FALL CREEK REGIONAL WASTE DISTRICT



SCALE: As Noted
DRAWN: S.B.S.
DESIGNED: D.R.H.
CHECKED: G.D.L.
DATE: Aug. 1989

BEAM, LONGEST & NEFF, INC.
CONSULTING ENGINEERS
8136 CASTLETON ROAD
INDIANAPOLIS, INDIANA 46250

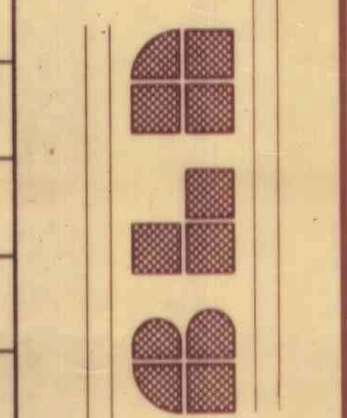

DATE	REVISIONS	DESCRIPTION	BY
5/12/93	1	AS-BUILT	HMP

2
5

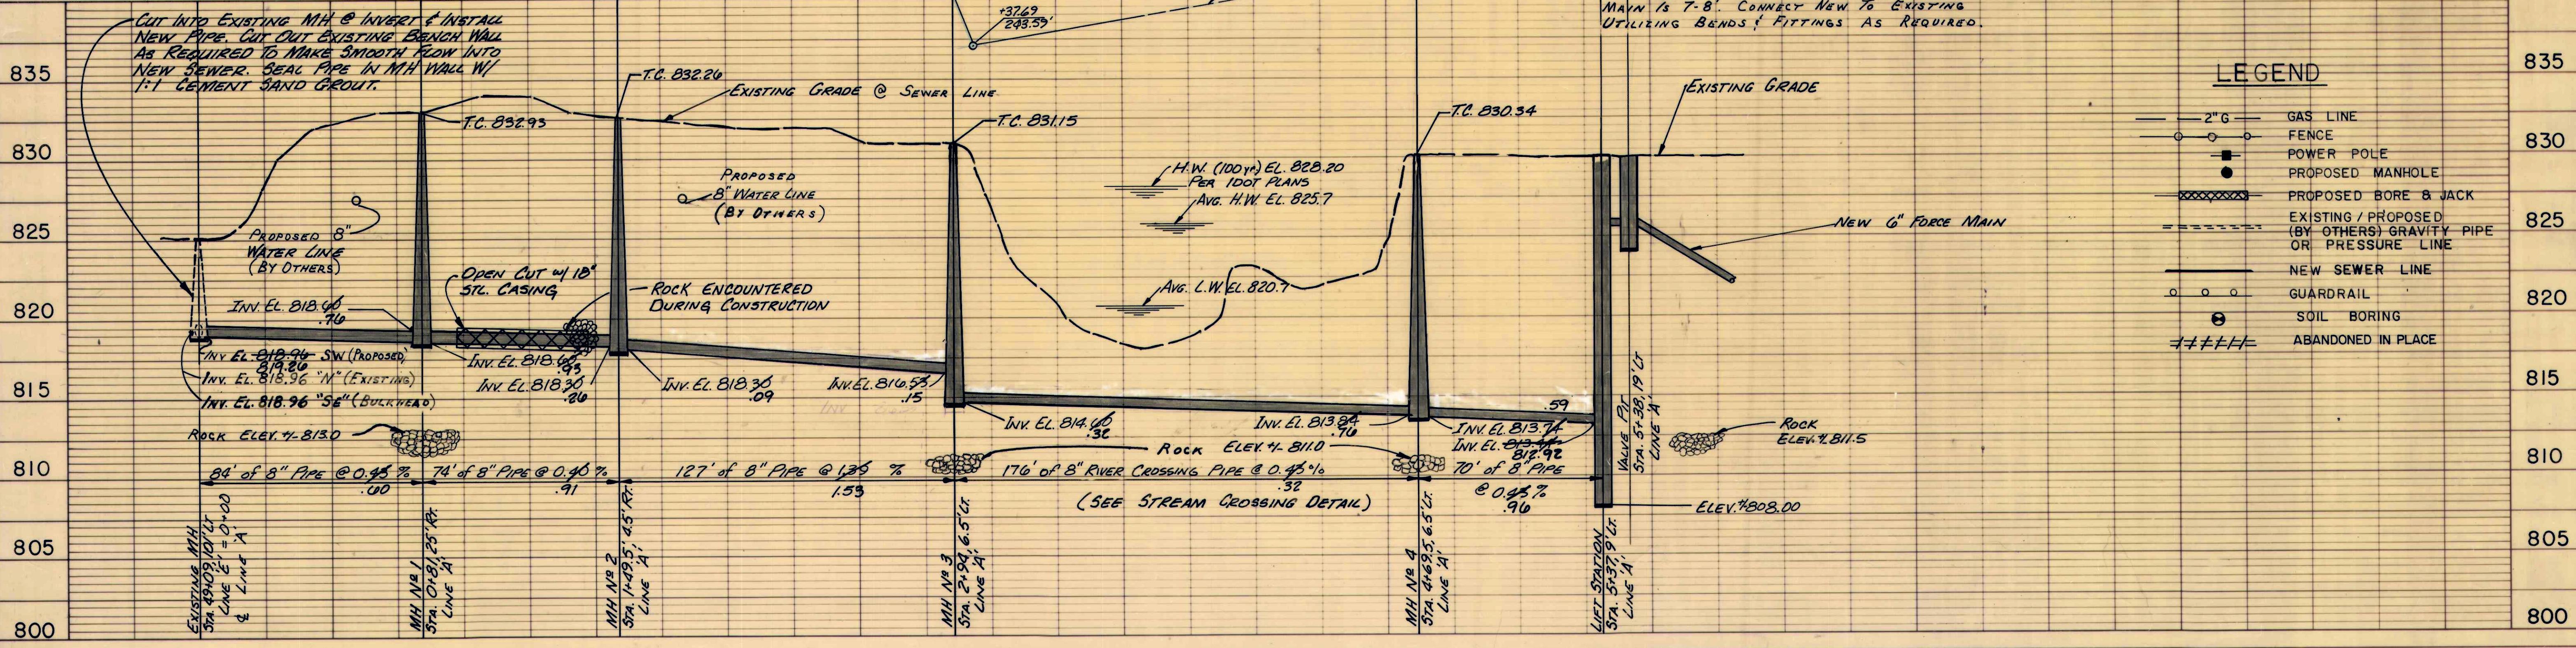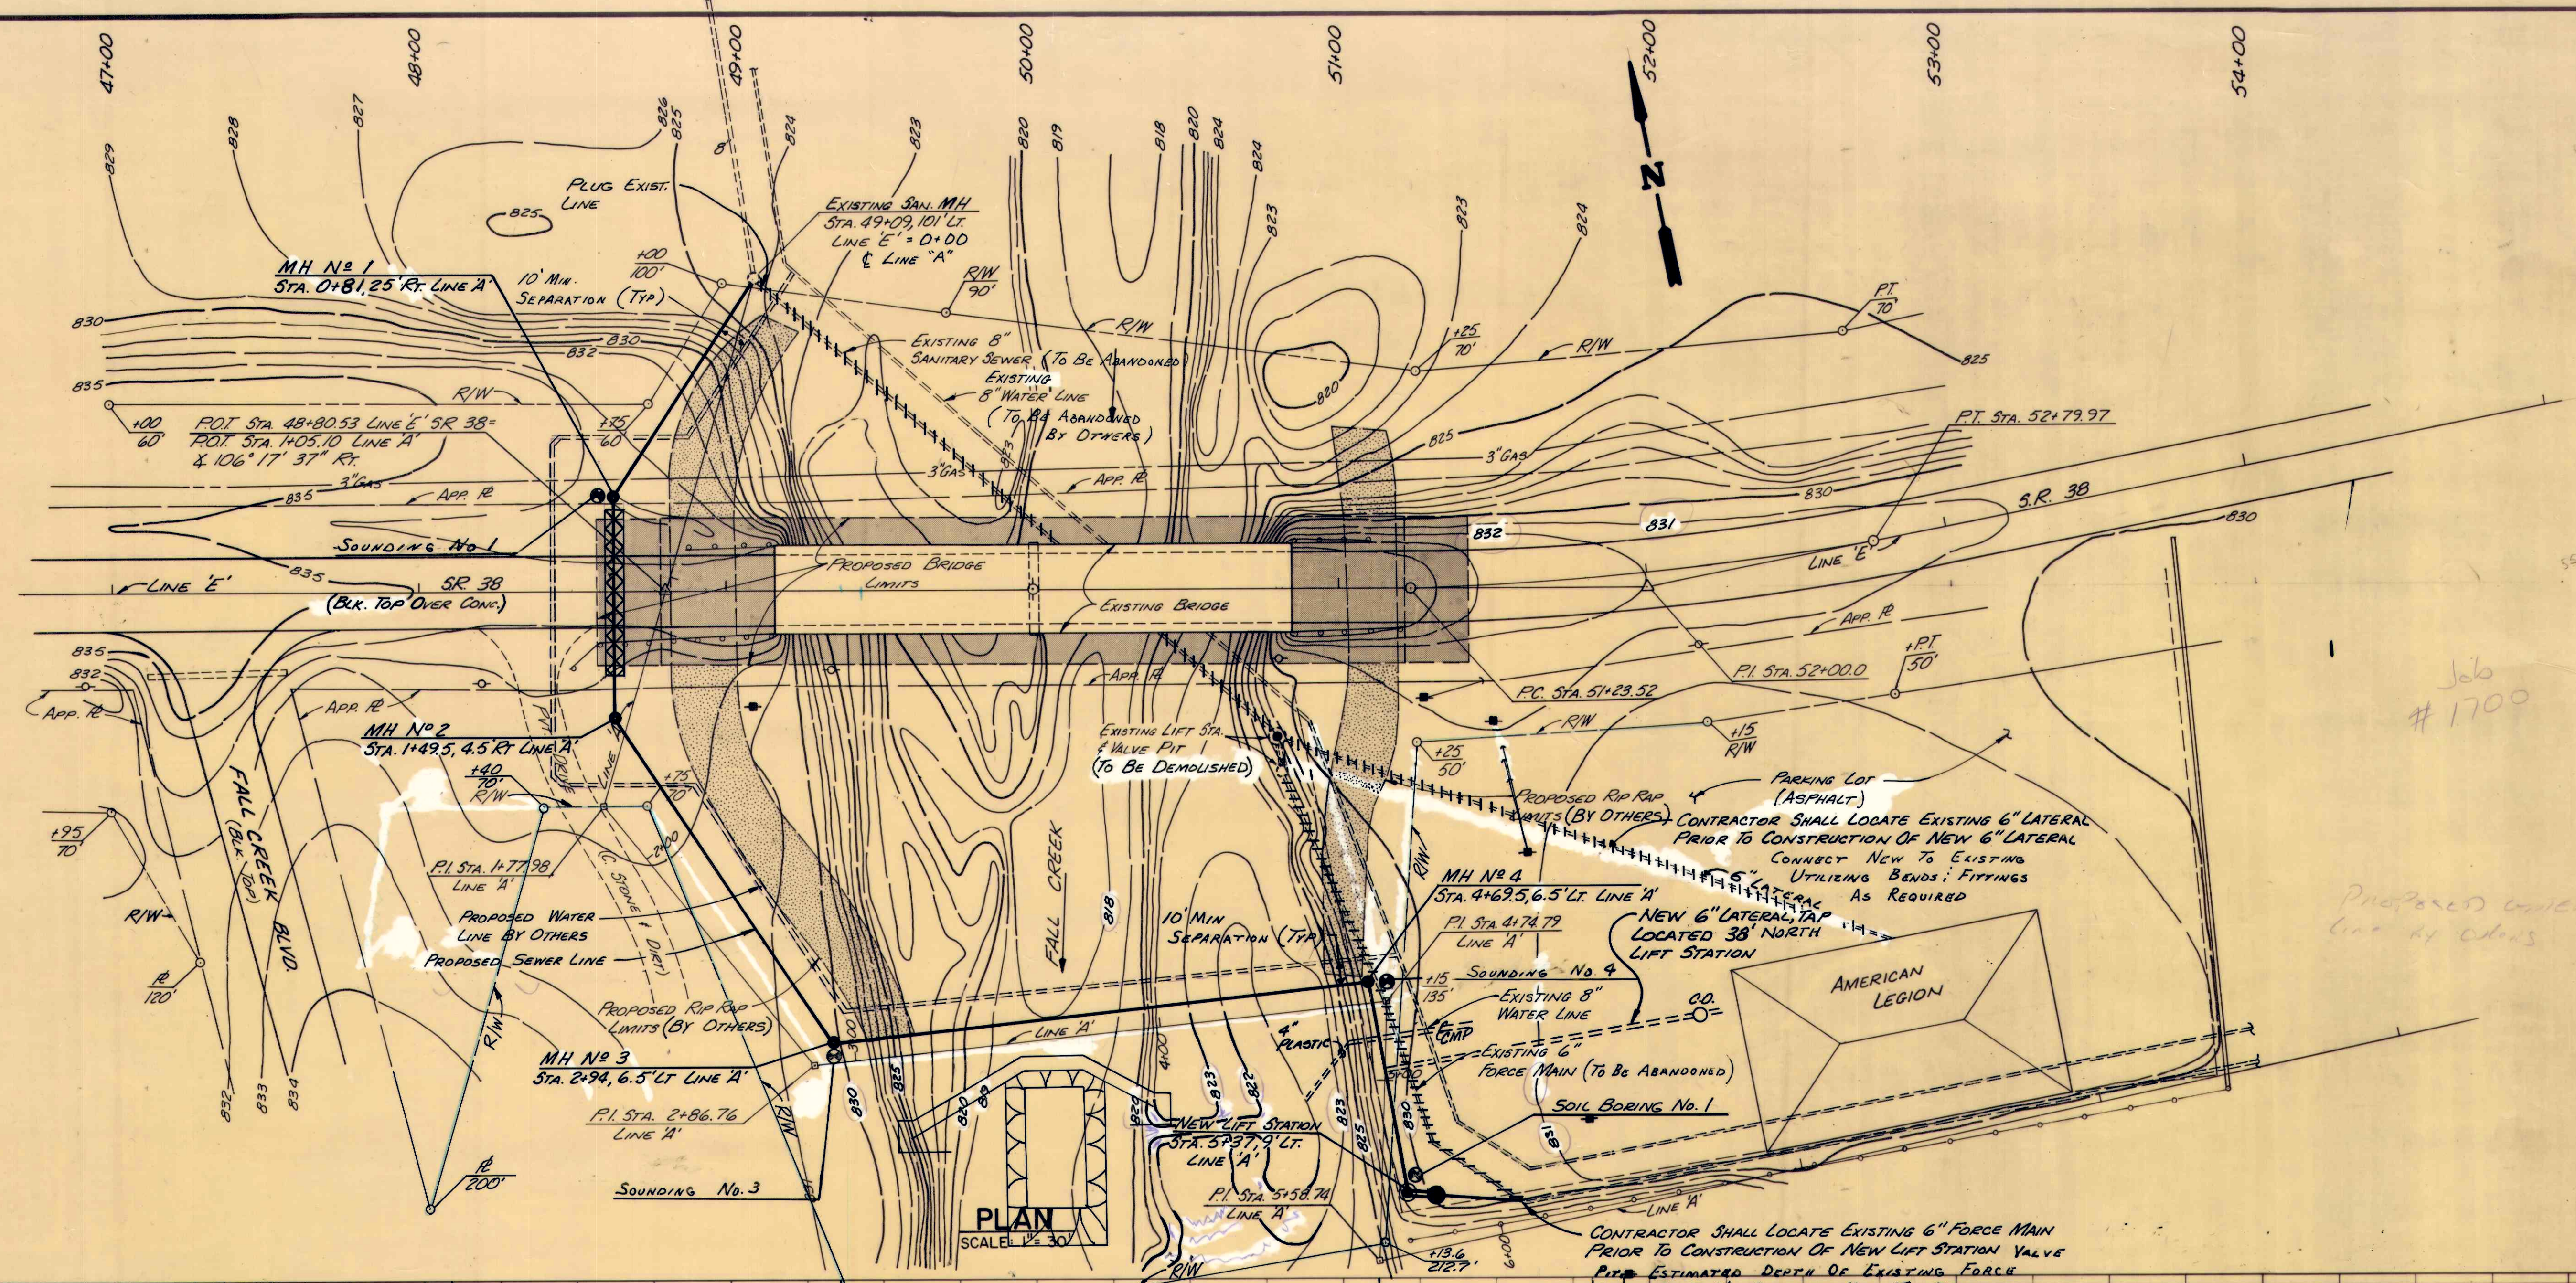

PROFILE
SCALE: 1" = 30' HORIZ.
1" = 5' VERT.

RECORD DRAWING