

FALL CREEK REGIONAL WASTE DISTRICT SANITARY SEWER REHABILITATION PROJECT PHASE II

PENDLETON, INDIANA



FCRWD MEMBERS

MARK A. JABLONSKI	- PRESIDENT
MICHELLE W. PATISHALL	- VICE PRESIDENT
GREGORY L. VALENTINE	- TREASURER
DAVID K. PADGETT	- SECRETARY
STEPHEN J. BILL	- DEPUTY SECRETARY/TREASURER
TIMOTHY E. GREEN	- BOARD MEMBER
KURT L. KAHL	- BOARD MEMBER
JACK C. WEIST	- BOARD MEMBER
ALBERT B. STEWART	- BOARD MEMBER
TERESA HUTTON	- GENERAL MANAGER
STEVE UNGER	- ATTORNEY




engineering | architecture | geospatial

www.grwinc.com


This document, originally issued, sealed, and signed by Joseph P. Tierney, Indiana Professional Engineer, No. 19300407, on November 2017, shall not be used in lieu of a certified document.

MARCH 2017

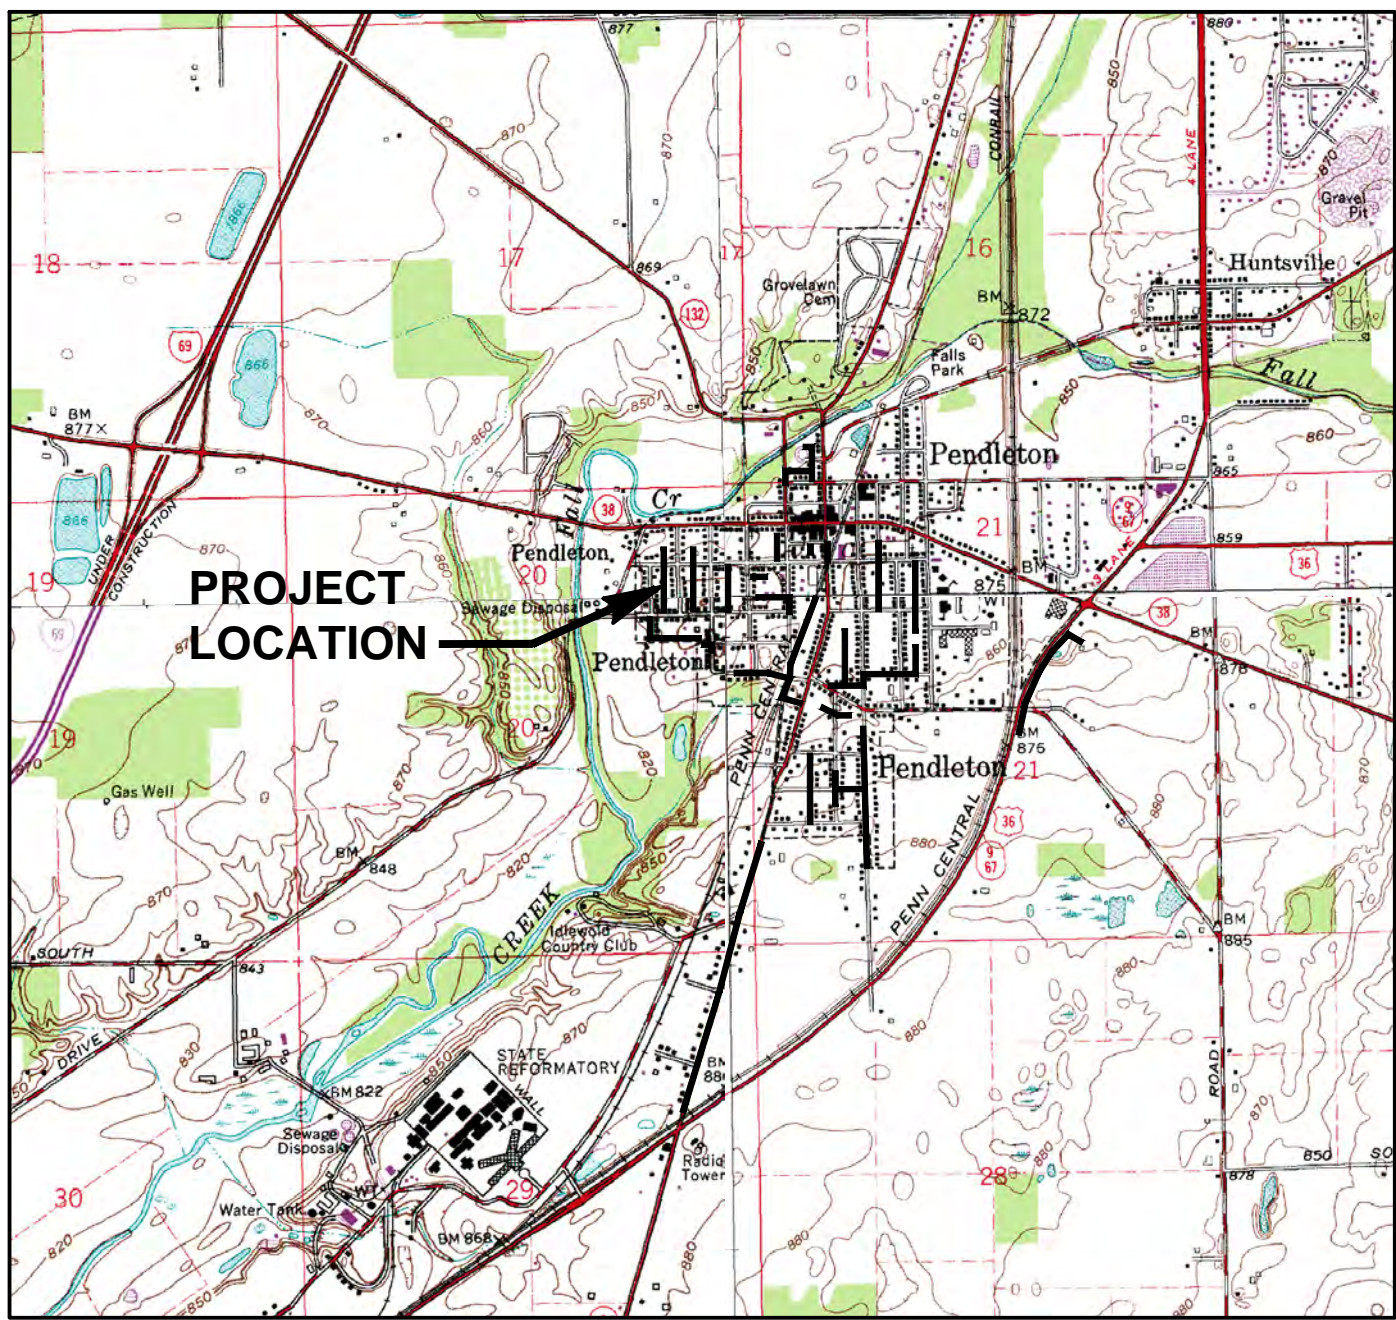

SCALE: 1" = 2000'

PLAN SET IS FULL SCALE ON 24"x36"
AND HALF SCALE ON 12"x18"

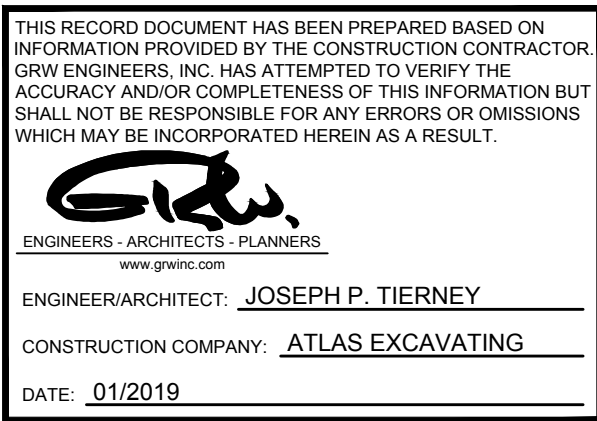

SRF NO. WW16074803
GRW PROJECT NO. 4447-24