


PRINTED: 3/11/2017 @ 2:08PM

FILE NAME: G:\4447-FORWD-2015\Working Drawings\AutoCAD\REHABILITATION PHASE II\4447-24-G-02.dwg

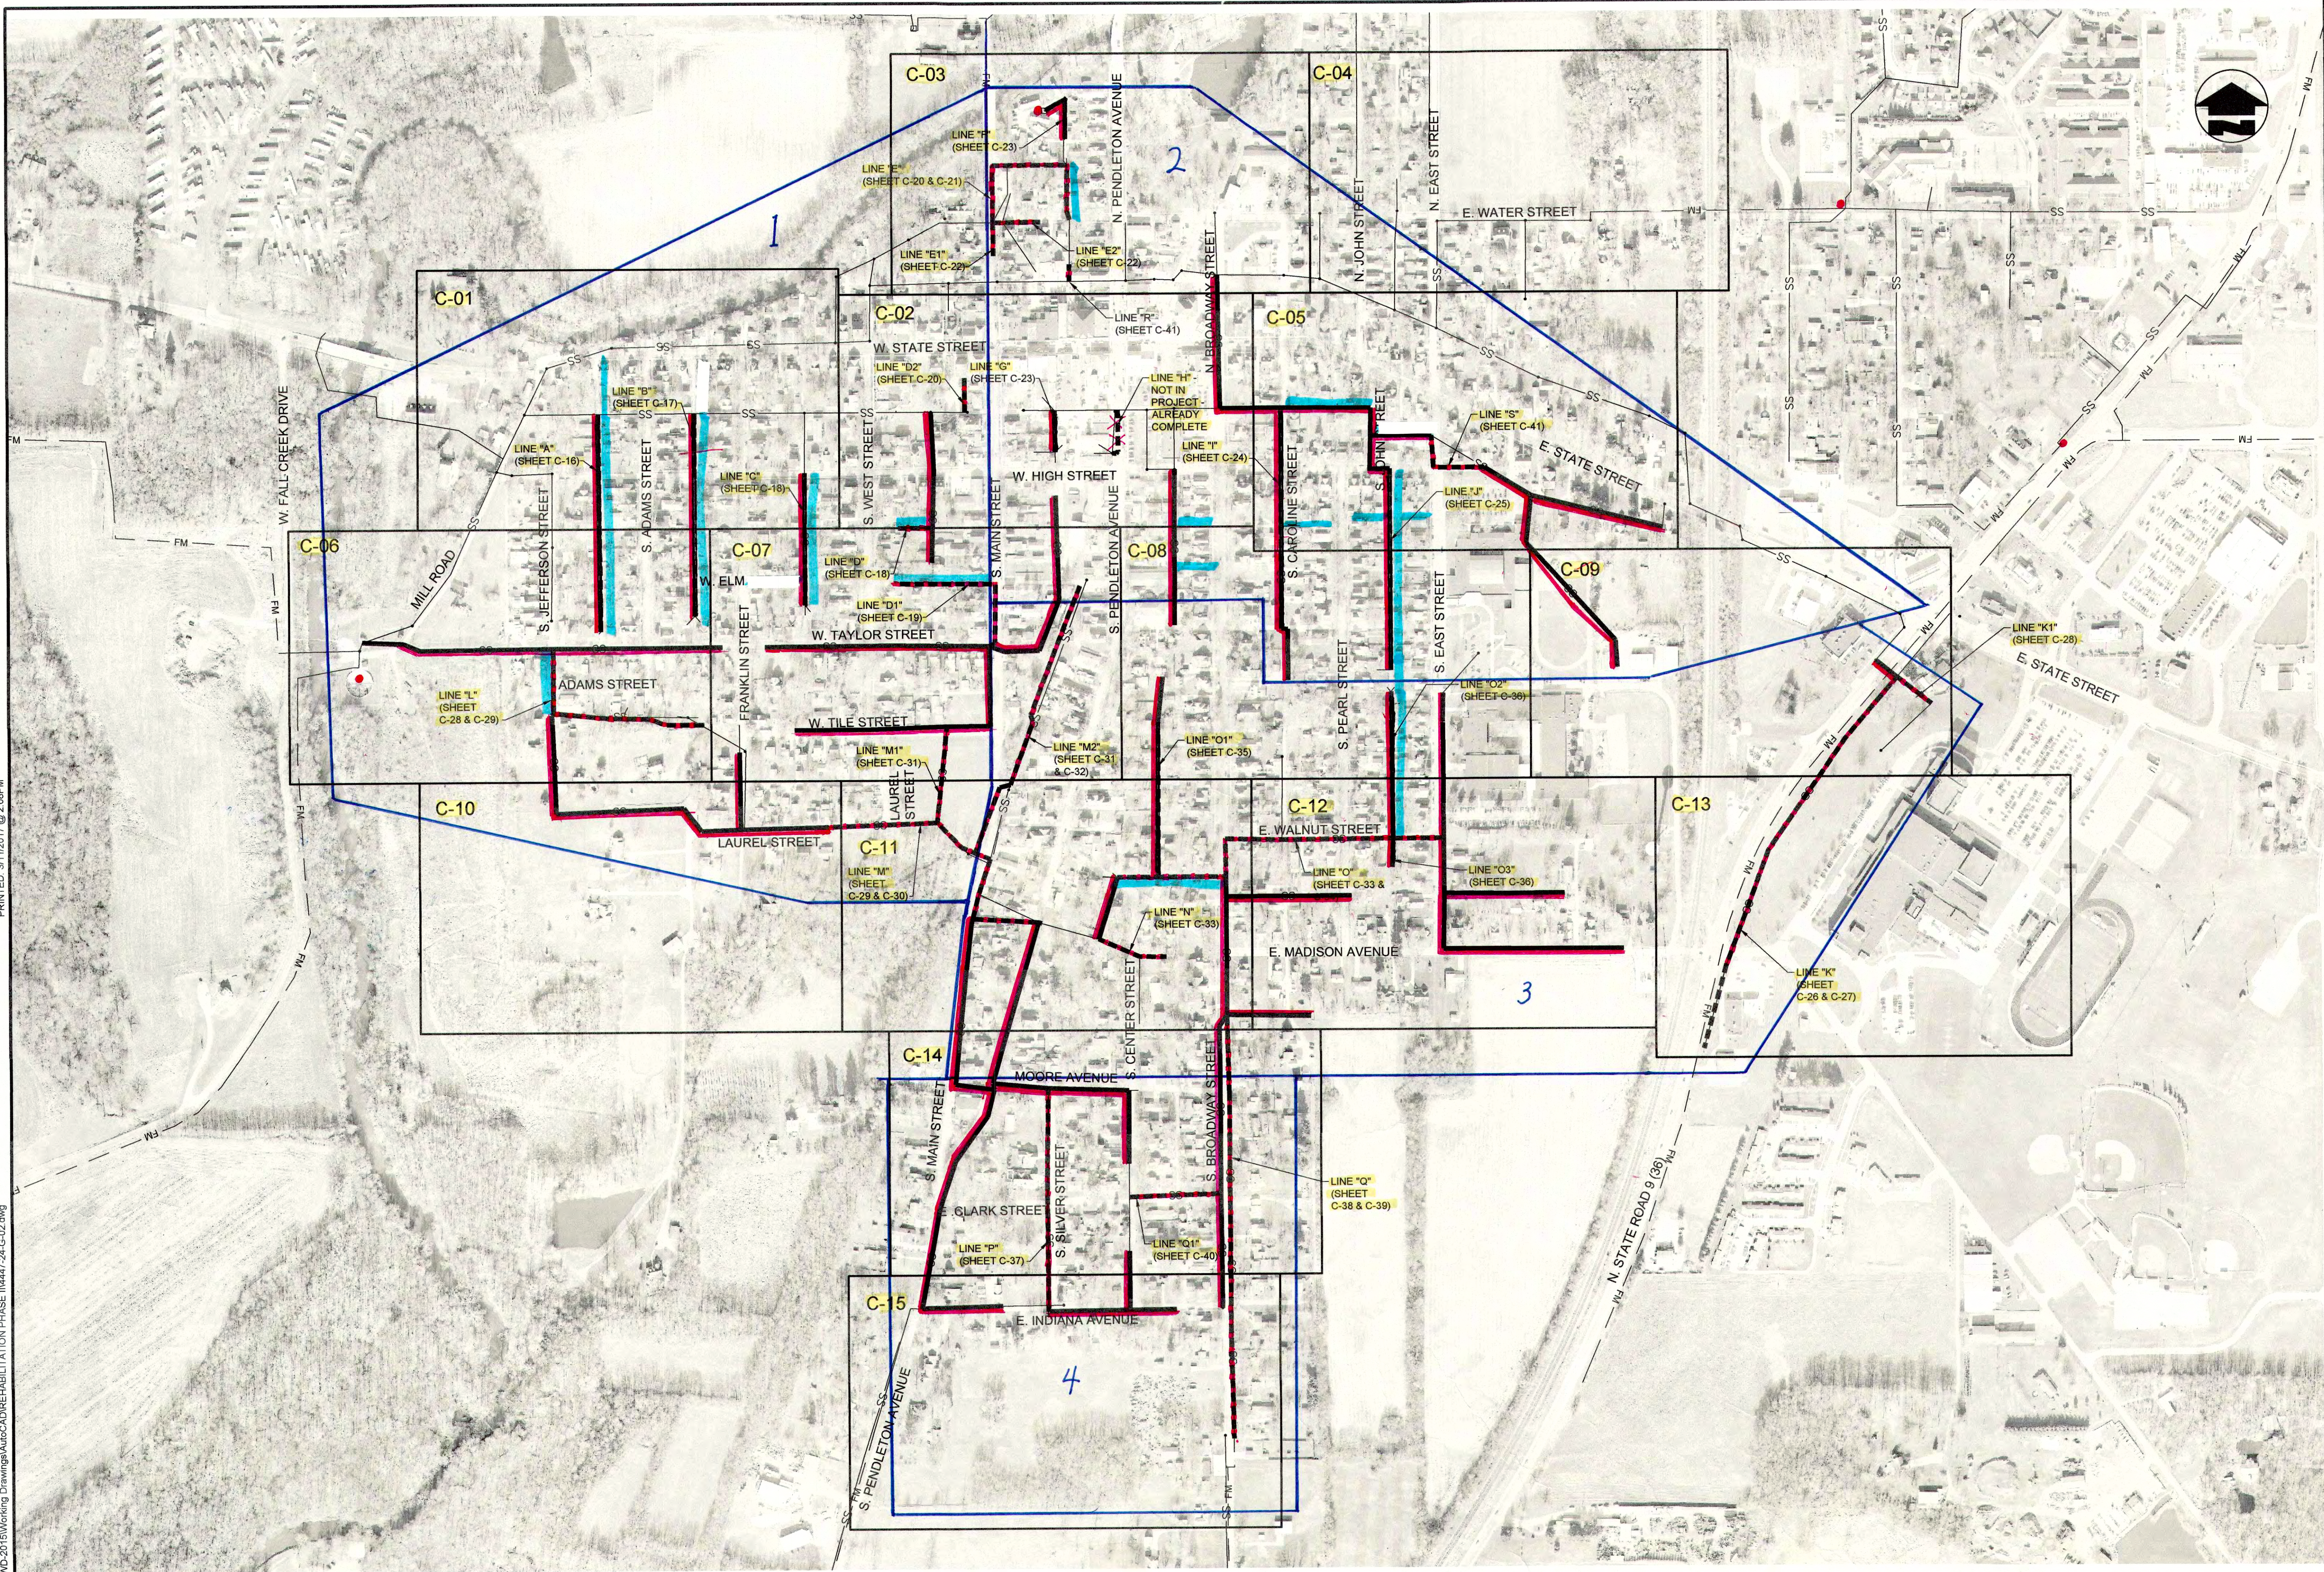

- SANITARY SEWER MAIN TO BE CIPP LINED
- MAIN LINES COMPLETED
- SANITARY SEWER MAIN TO BE DIG AND REPLACED (SEE SCHEDULE ON SHEET C-46)
- ALLEYS RESURFACED
- CONSTRUCTION WORK ZONES

DRAWING INDEX

JOSEPH P. TIERNEY
No. 19300407
STATE OF INDIANA
PROFESSIONAL ENGINEER

GRW PROJECT NO. 4447-24

SRF NO. WW6074803

ALL RIGHTS RESERVED. NO PART OF THIS DOCUMENT MAY BE REPRODUCED OR TRANSMITTED IN ANY FORM OR BY ANY MEANS, ELECTRONIC OR MECHANICAL, WITHOUT PERMISSION FROM THE ENGINEER.



engineering | architecture | geospatial

www.g2inc.com

DRAWING INDEX

SEWER REHABILITATION PROJECT PHASE II
TOWN OF PENDLETON, INDIANA

DESIGNED	GWL	CAB	JPT	JPT
BY				
DATE				

REVISIONS

NO.	DESCRIPTION	DATE	BY

DATE: MARCH 2017

SCALE: N.T.S.

SHEET NO. G-02

THIS MARK SHOULD MEASURE EXACTLY 1" WHEN PLOTTED

SCALE CHECK