



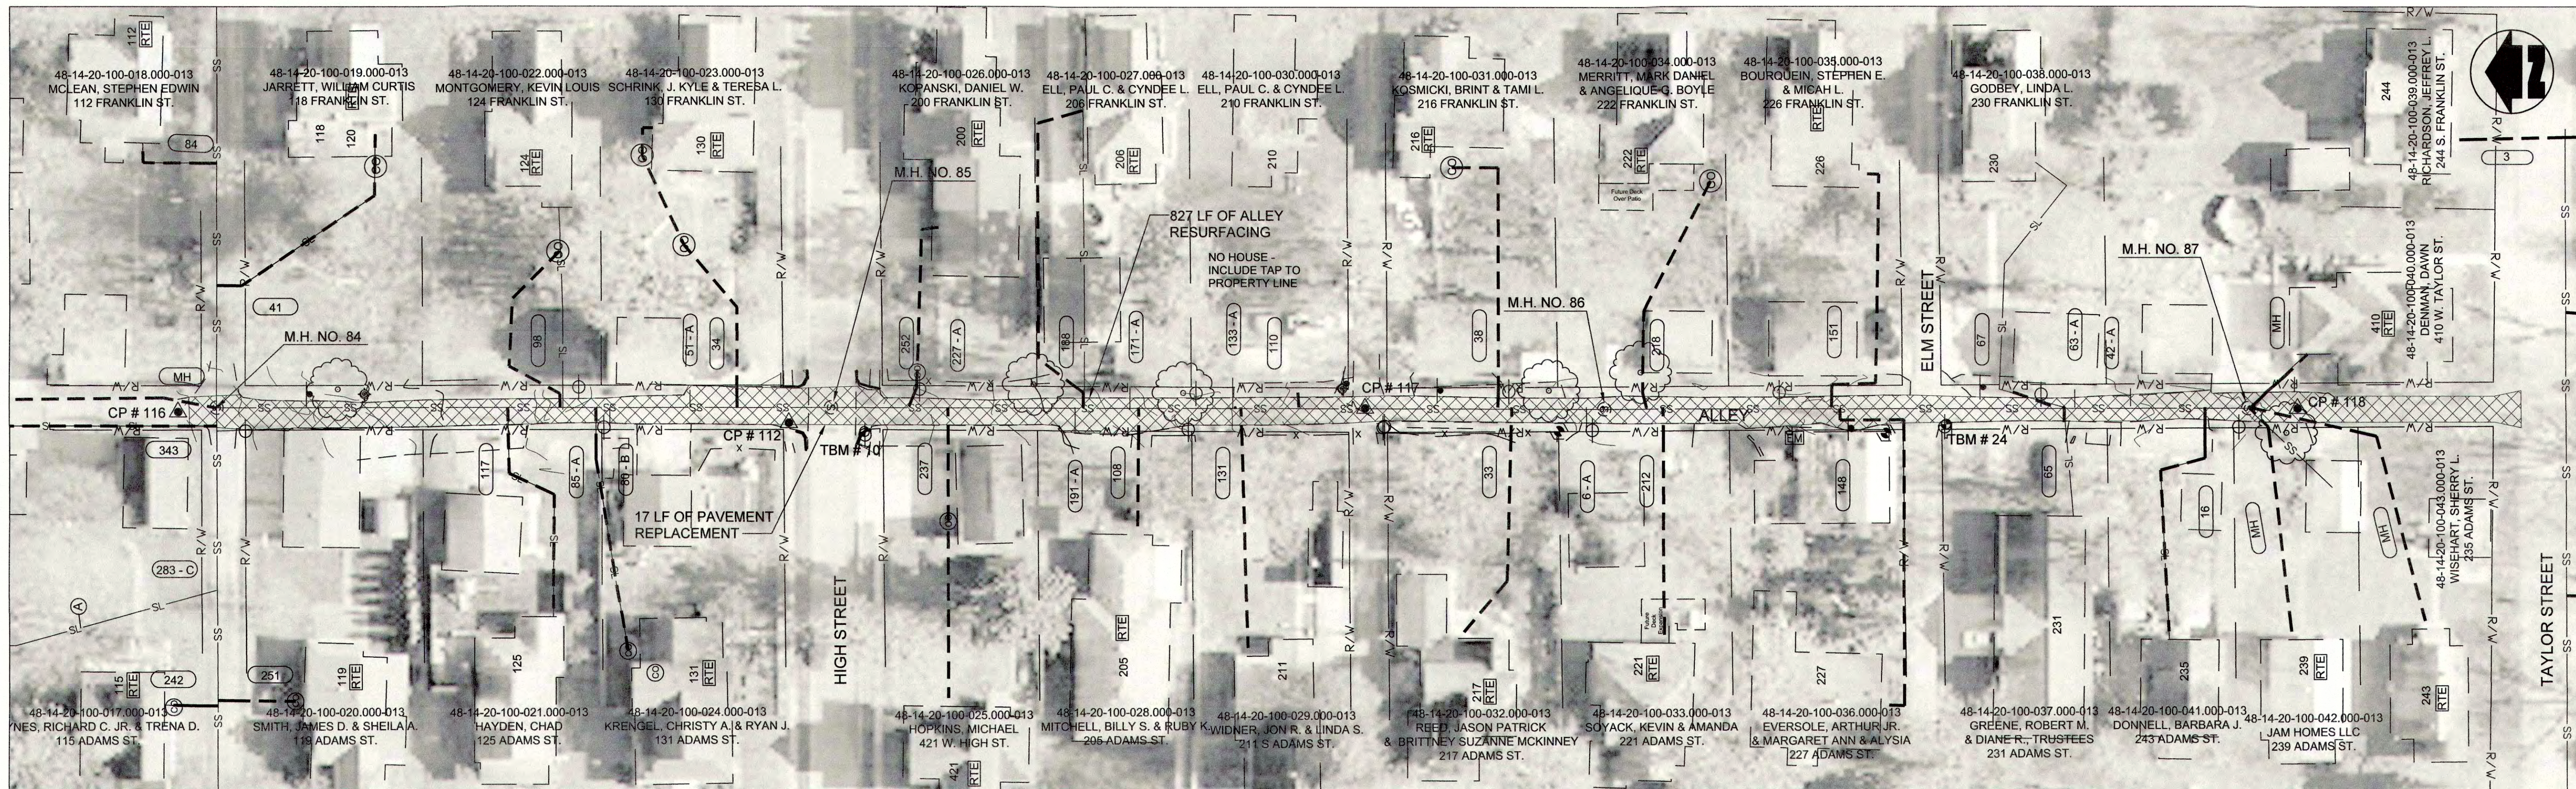

PLAN VIEW - STA. 0+00 TO STA. 7+50 LINE "B" CIPP LINED PER BID ALTERNATE

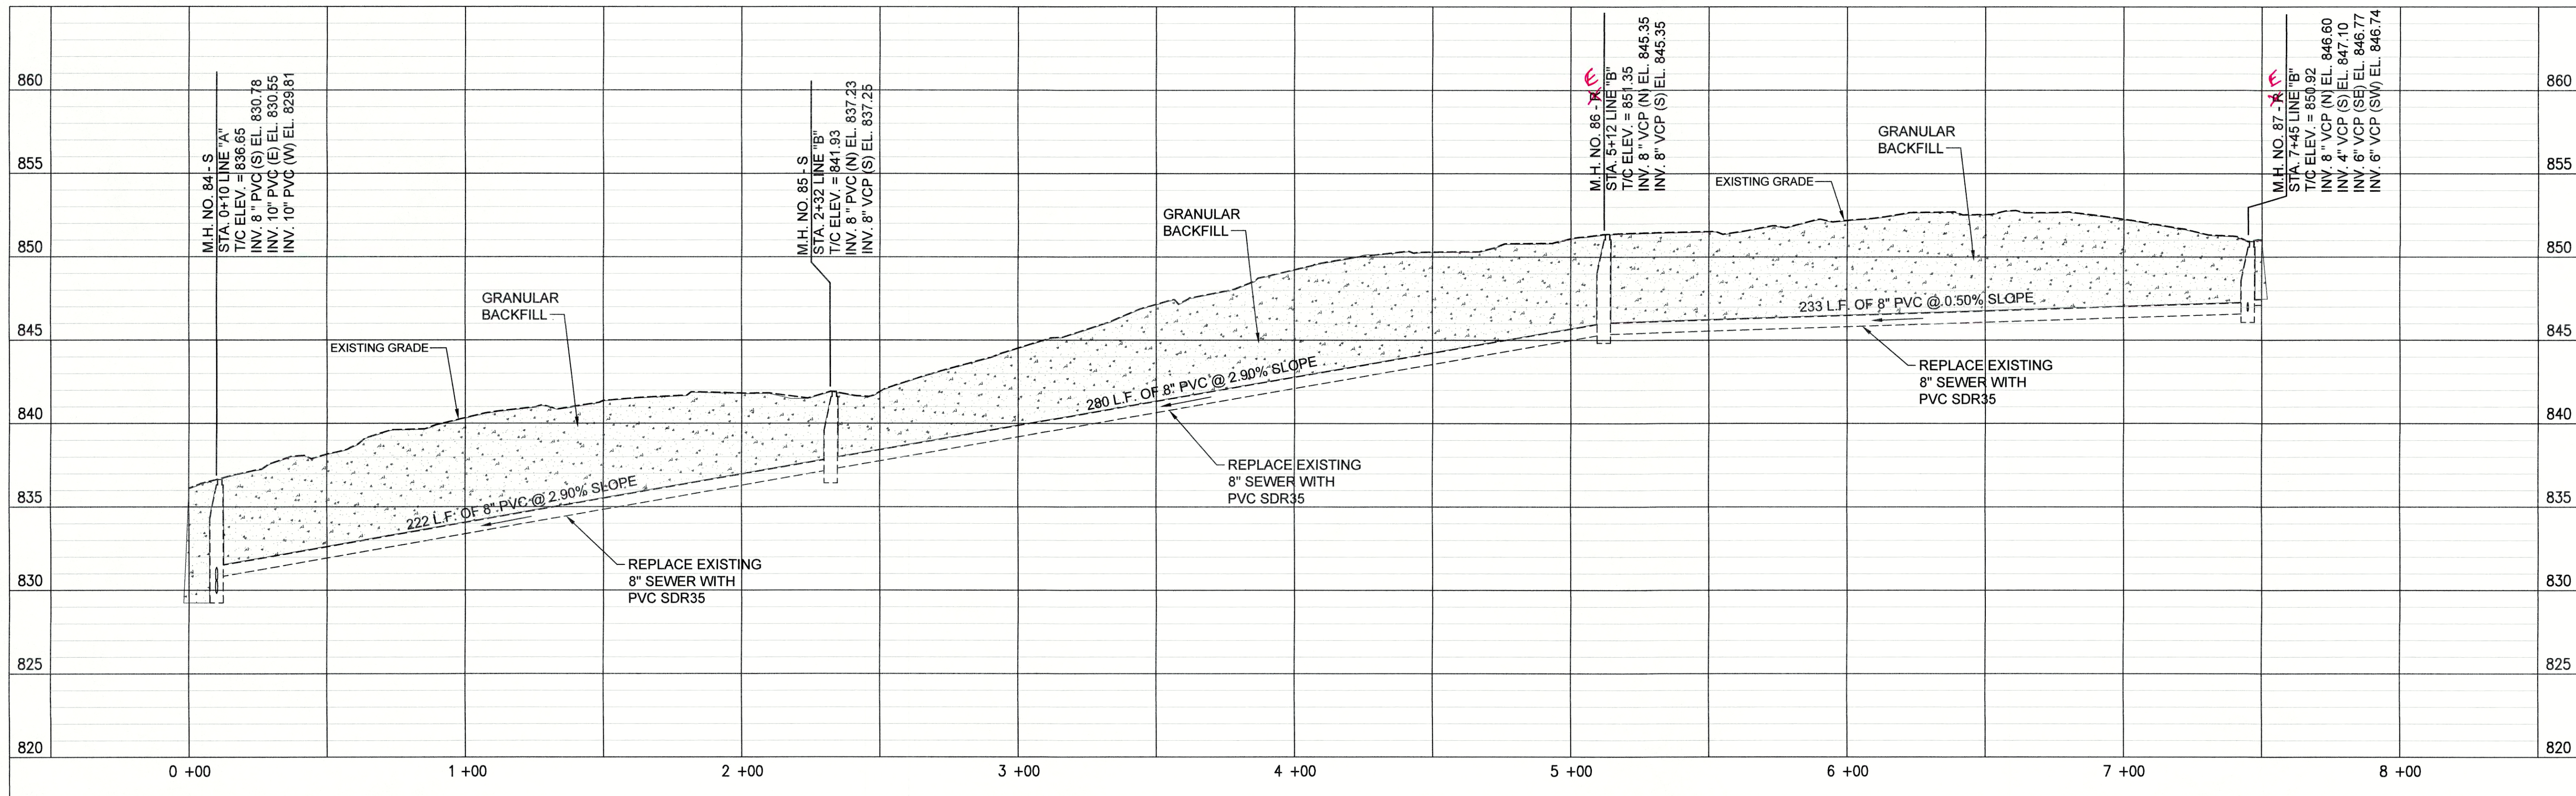


PROFILE - STA. 0+00 TO STA. 7+50 LINE "B"

PROPOSED LEGEND

- | | | | |
|---|-----------------------------|---|----------------------------------|
| — | PROPOSED PERMANENT EASEMENT | — | PROPOSED SANITARY LATERAL |
| — | PROPOSED RIGHT-OF-WAY | — | SURFACE RESTORATION AND BACKFILL |
| — | PROPOSED SANITARY SEWER | | |

NOTES:

- LETTERS SHOWN NEXT TO MANHOLE NUMBERS IN THE PROFILE CORRESPOND TO REHABILITATION SCHEDULE ON SHEET C-42.
- SEE SHEETS C-01 THROUGH C-15 FOR NOTES ON LATERAL REHABILITATION WORK.

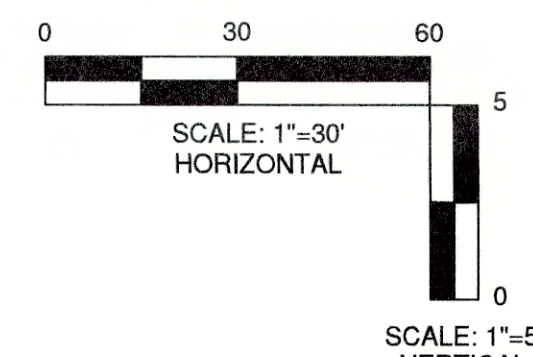

JOSEPH P. TIERNY
REGISTERED
No. 19300407
STATE OF INDIANA
PROFESSIONAL ENGINEER

GRW PROJECT NO. 4447-24
SRF NO. WW16074803

engineering | architecture | geospatial
www.grwinc.com

PLAN AND PROFILE
LINE "B"
SEWER REHABILITATION PROJECT PHASE II
TOWN OF PENDLETON, INDIANA

DESIGNED	GWL
BY	PRW

DATE	DESCRIPTION

REVIEWED	GCR

APPROVED	JPT

DATE: MARCH 2017
SCALE: H.-1"=30'; V.-1"=5'
SHEET NO. C-17