



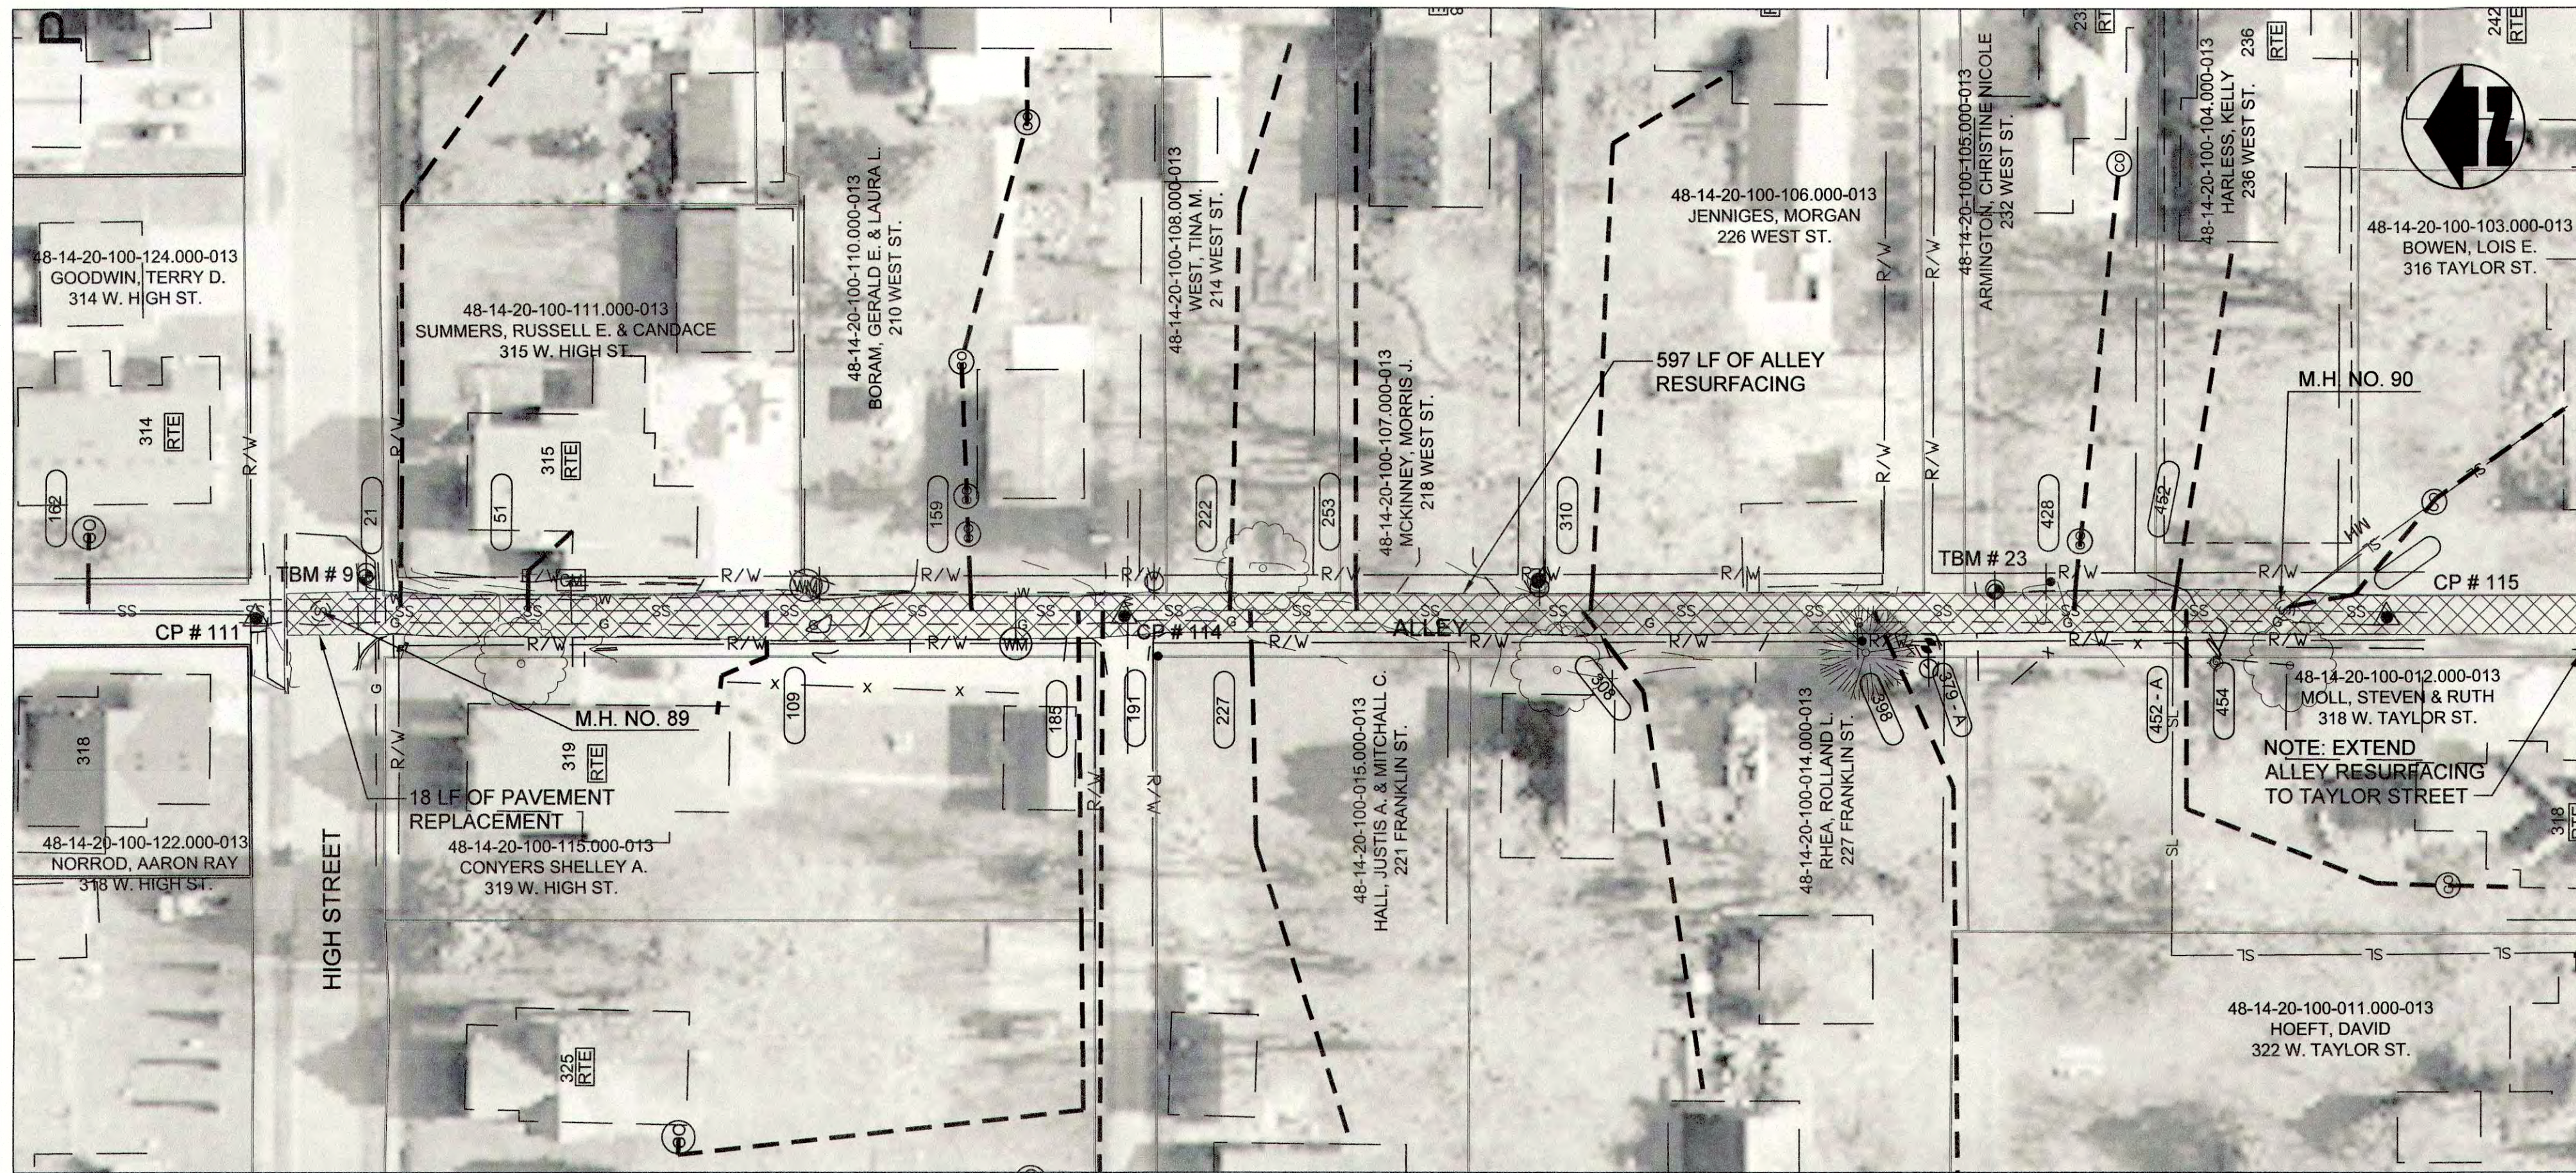

PLAN VIEW - STA. 0+00 TO STA. 4+95 LINE "C" CIPP LINED PER BID ALTERNATE

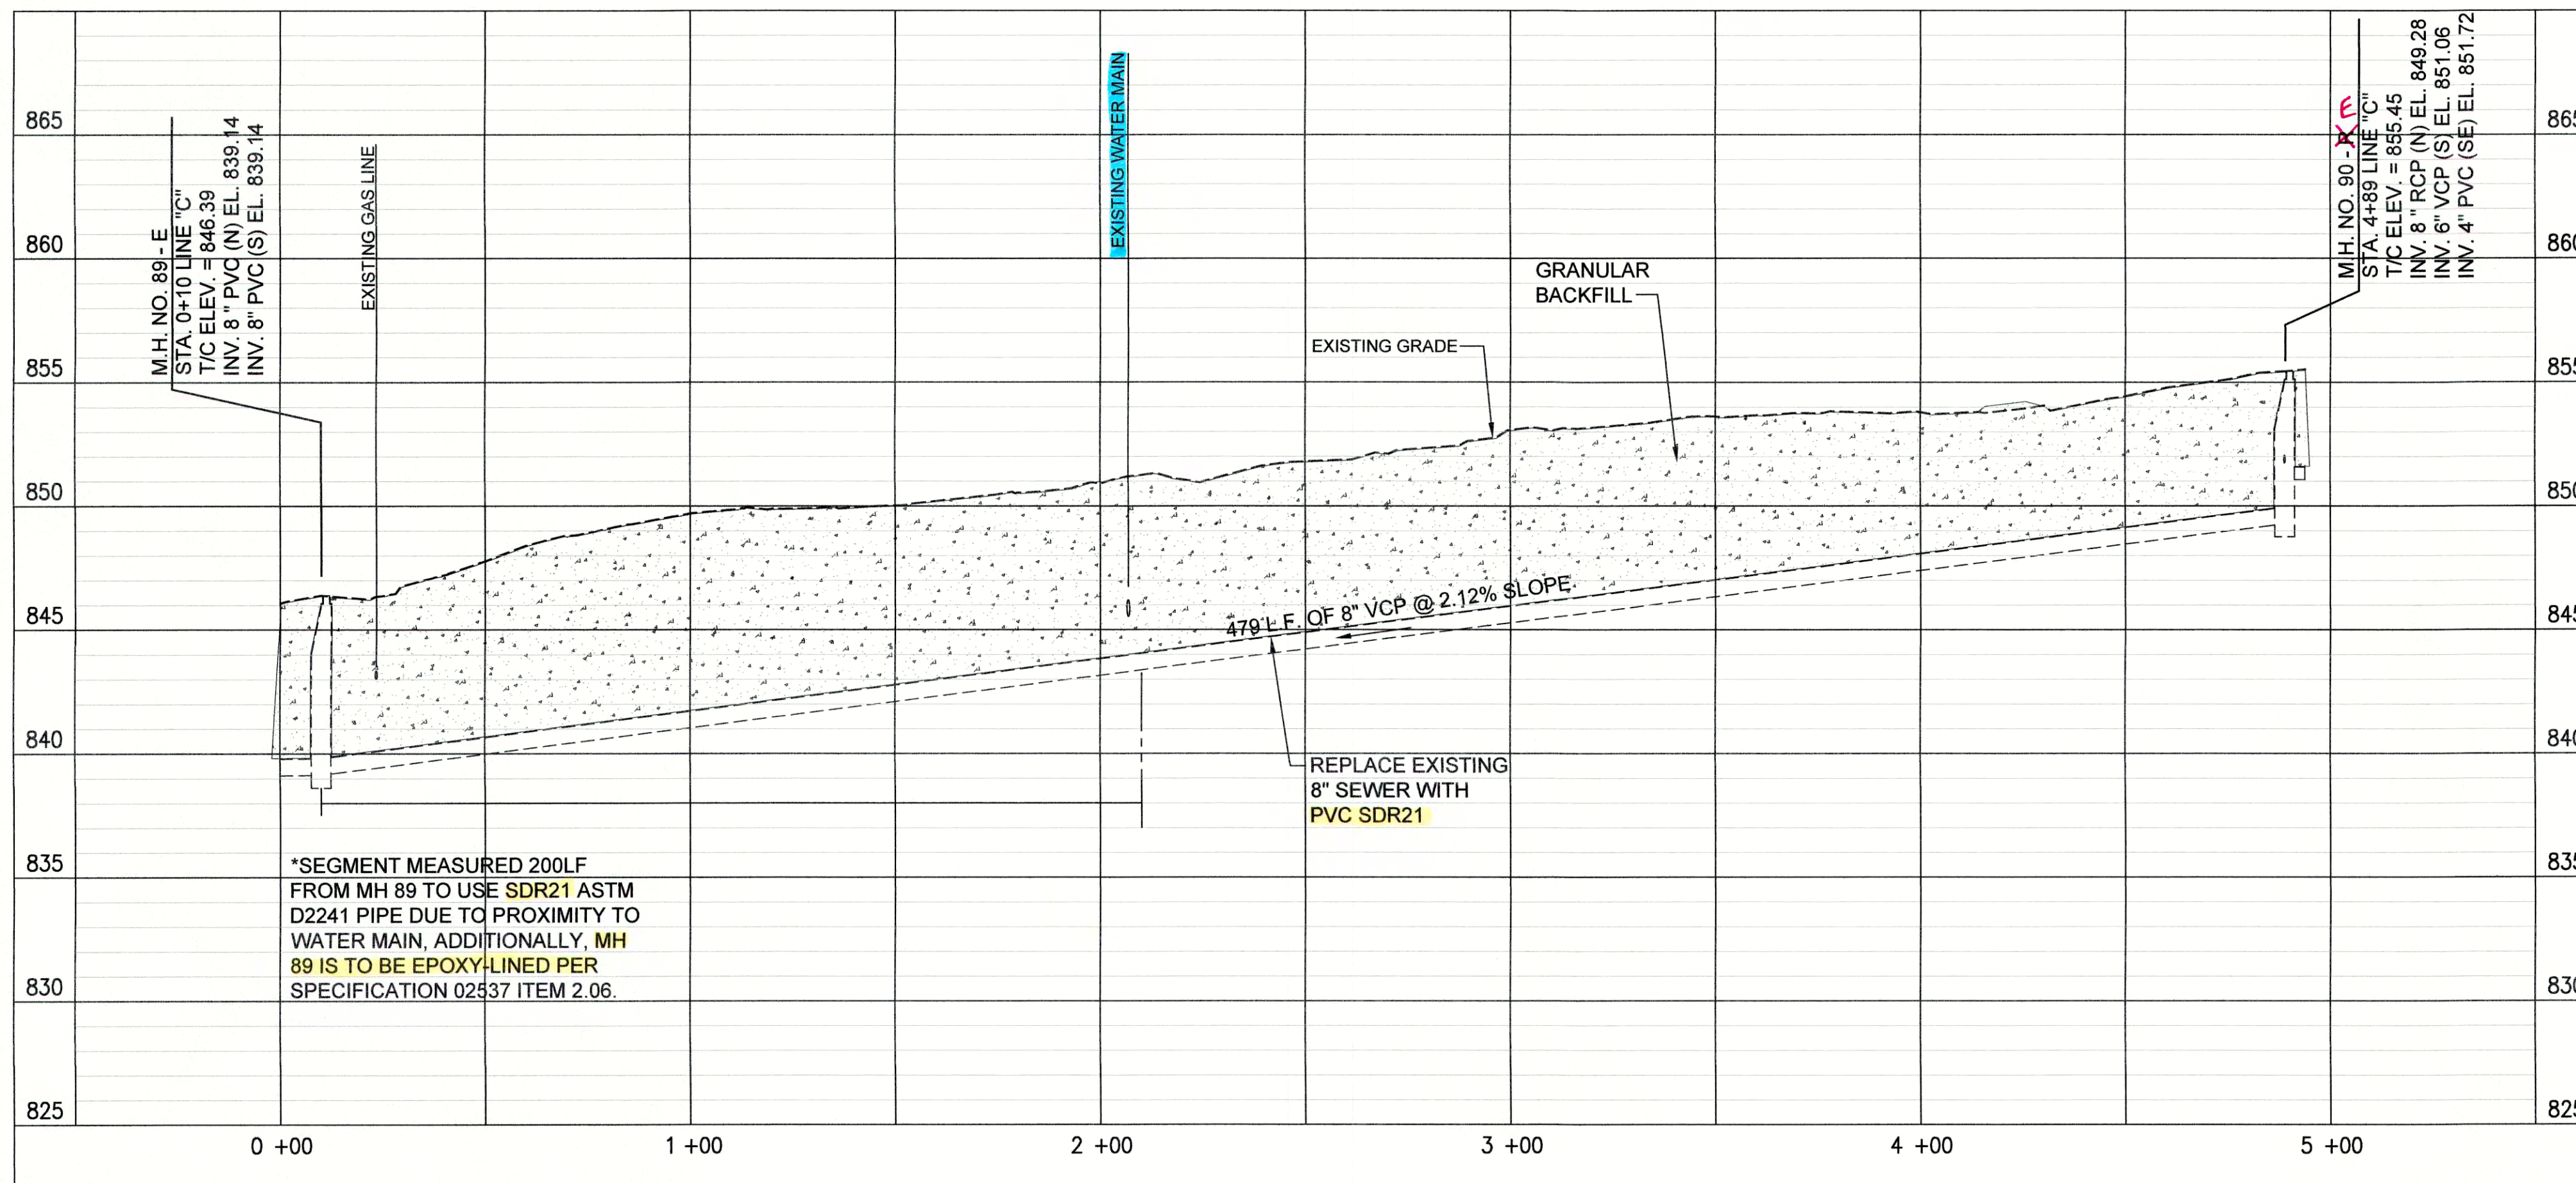


PROFILE - STA. 0+00 TO STA. 4+95 LINE "C"

(A) PIPE SEGMENT TO BE ABANDONED


- NOTES:
- LETTERS SHOWN NEXT TO MANHOLE NUMBERS IN THE PROFILE CORRESPOND TO REHABILITATION SCHEDULE ON SHEET C-42.
 - SEE SHEETS C-01 THROUGH C-15 FOR NOTES ON LATERAL REHABILITATION WORK.

PROPOSED LEGEND


- | | | | |
|---|-----------------------------|---|----------------------------------|
| — | PROPOSED PERMANENT EASEMENT | — | PROPOSED SANITARY LATERAL |
| — | PROPOSED RIGHT-OF-WAY | — | SURFACE RESTORATION AND BACKFILL |
| — | PROPOSED SANITARY SEWER | | |

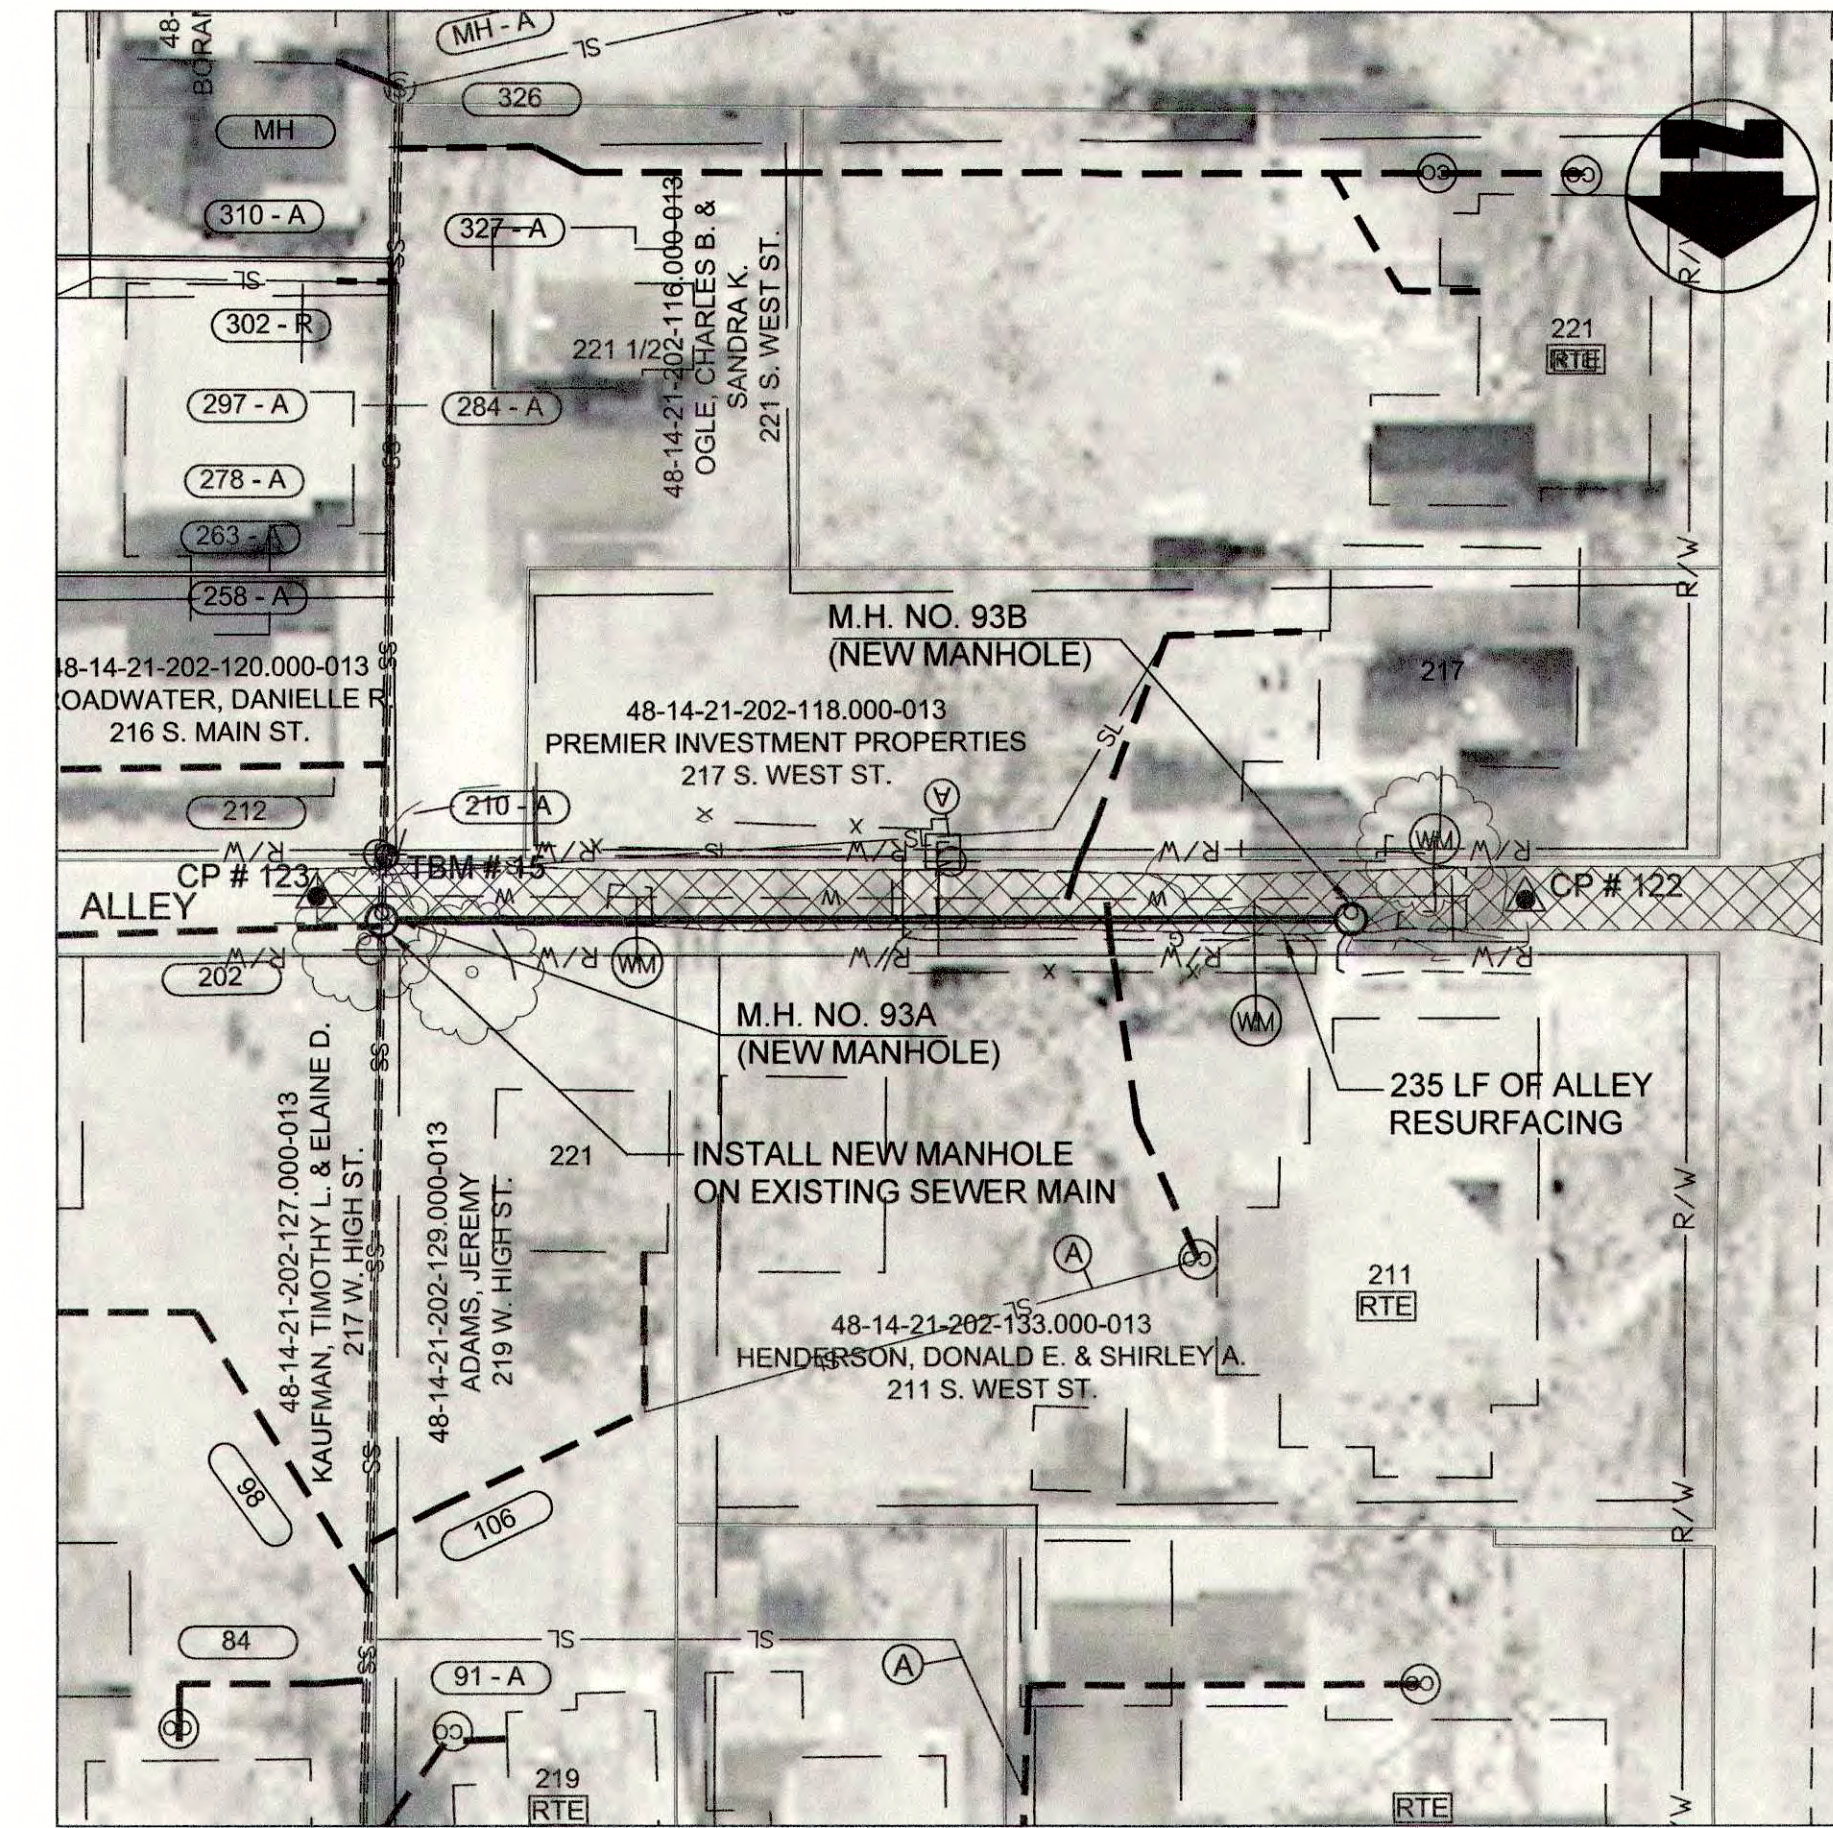

PLAN VIEW - STA. 0+00 TO STA. 1+70 LINE "D"

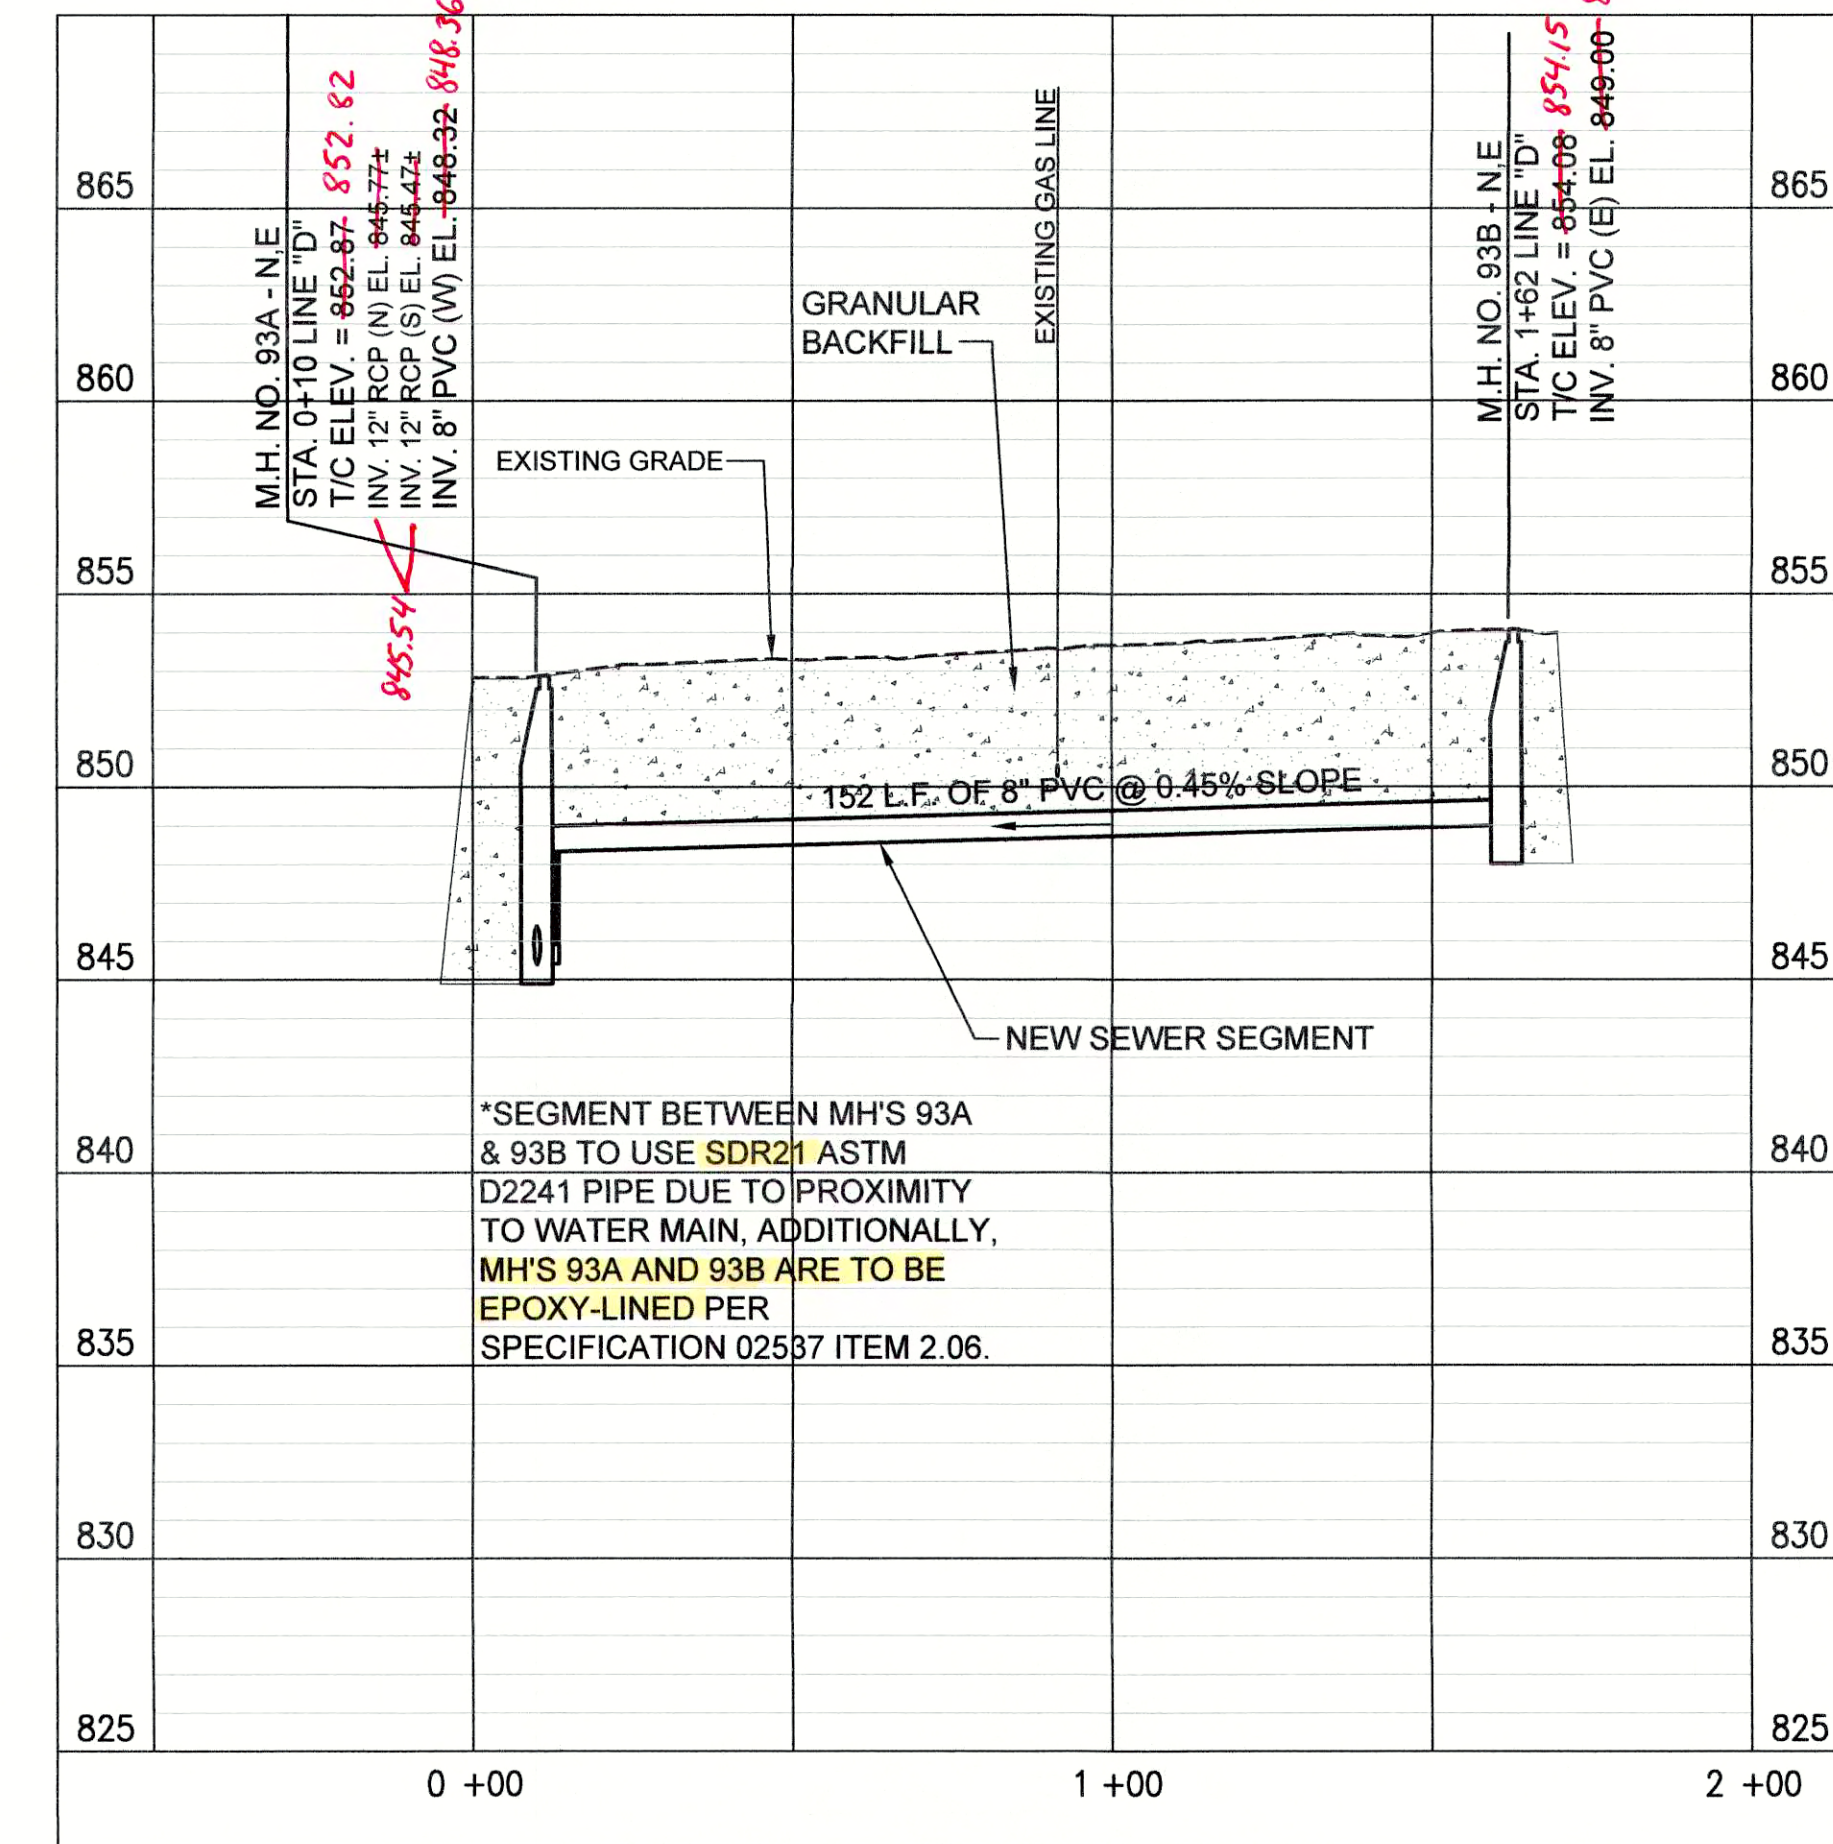

PROFILE - STA. 0+00 TO STA. 1+70 LINE "D"

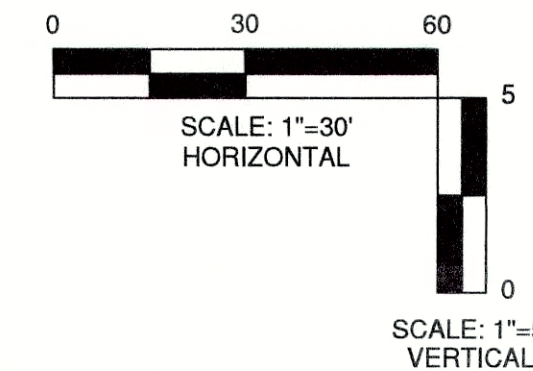

JOSEPH P. TIENY
REGISTERED
No. 19300407
STATE OF INDIANA
PROFESSIONAL ENGINEER

GRW PROJECT NO. 4447-24
SRF NO. WW16074803 --

engineering | architecture | geospatial
www.grwinc.com

PLAN AND PROFILE
LINE "C" AND LINE "D"
SEWER REHABILITATION PROJECT PHASE II
TOWN OF PENDLETON, INDIANA

DESIGNED		GWL		GCR		GWL		JPT	
NO.	DATE	BY	DATE	BY	DATE	BY	DATE	BY	DATE

DATE: MARCH 2017
SCALE: H.-1"=30', V.-1"=5'
SHEET NO.

C-18