



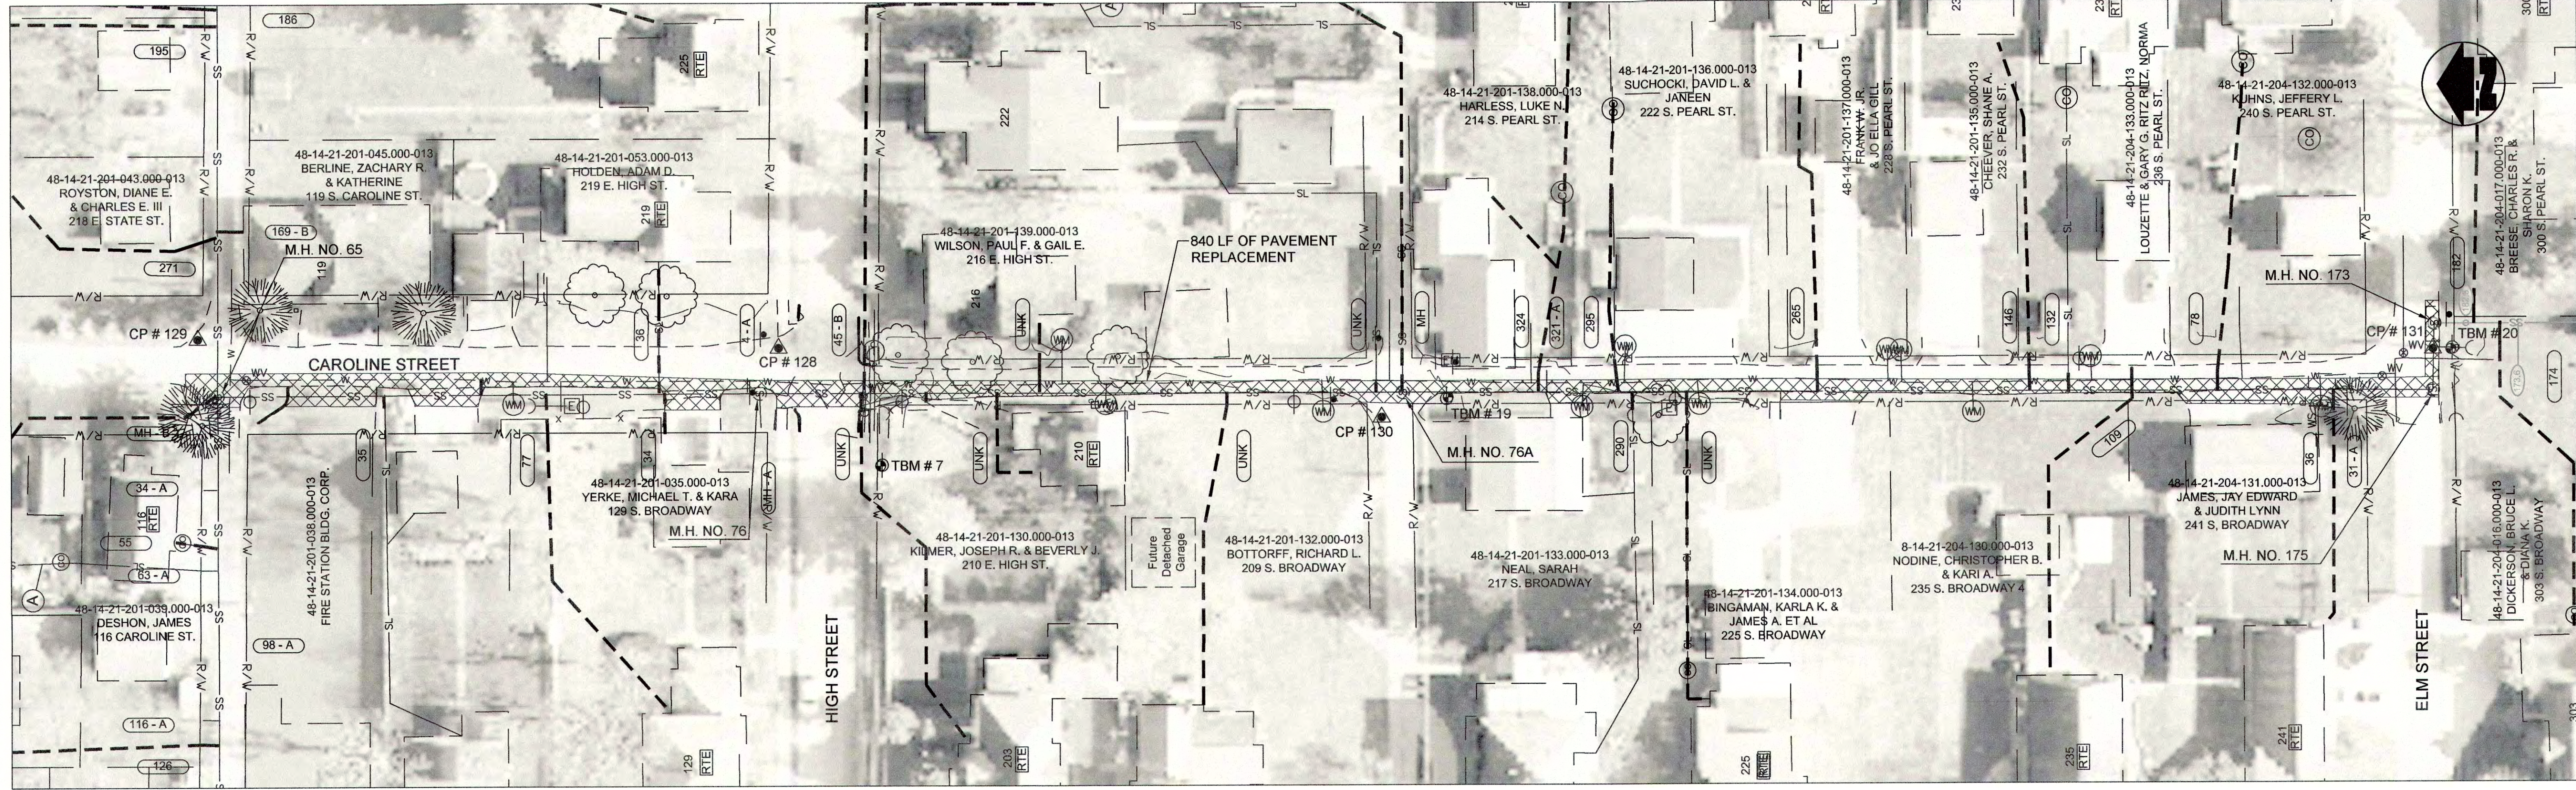

PLAN VIEW - STA. 0+00 TO STA. 8+20 LINE "I" CIPP LINED PER BID ALTERNATE

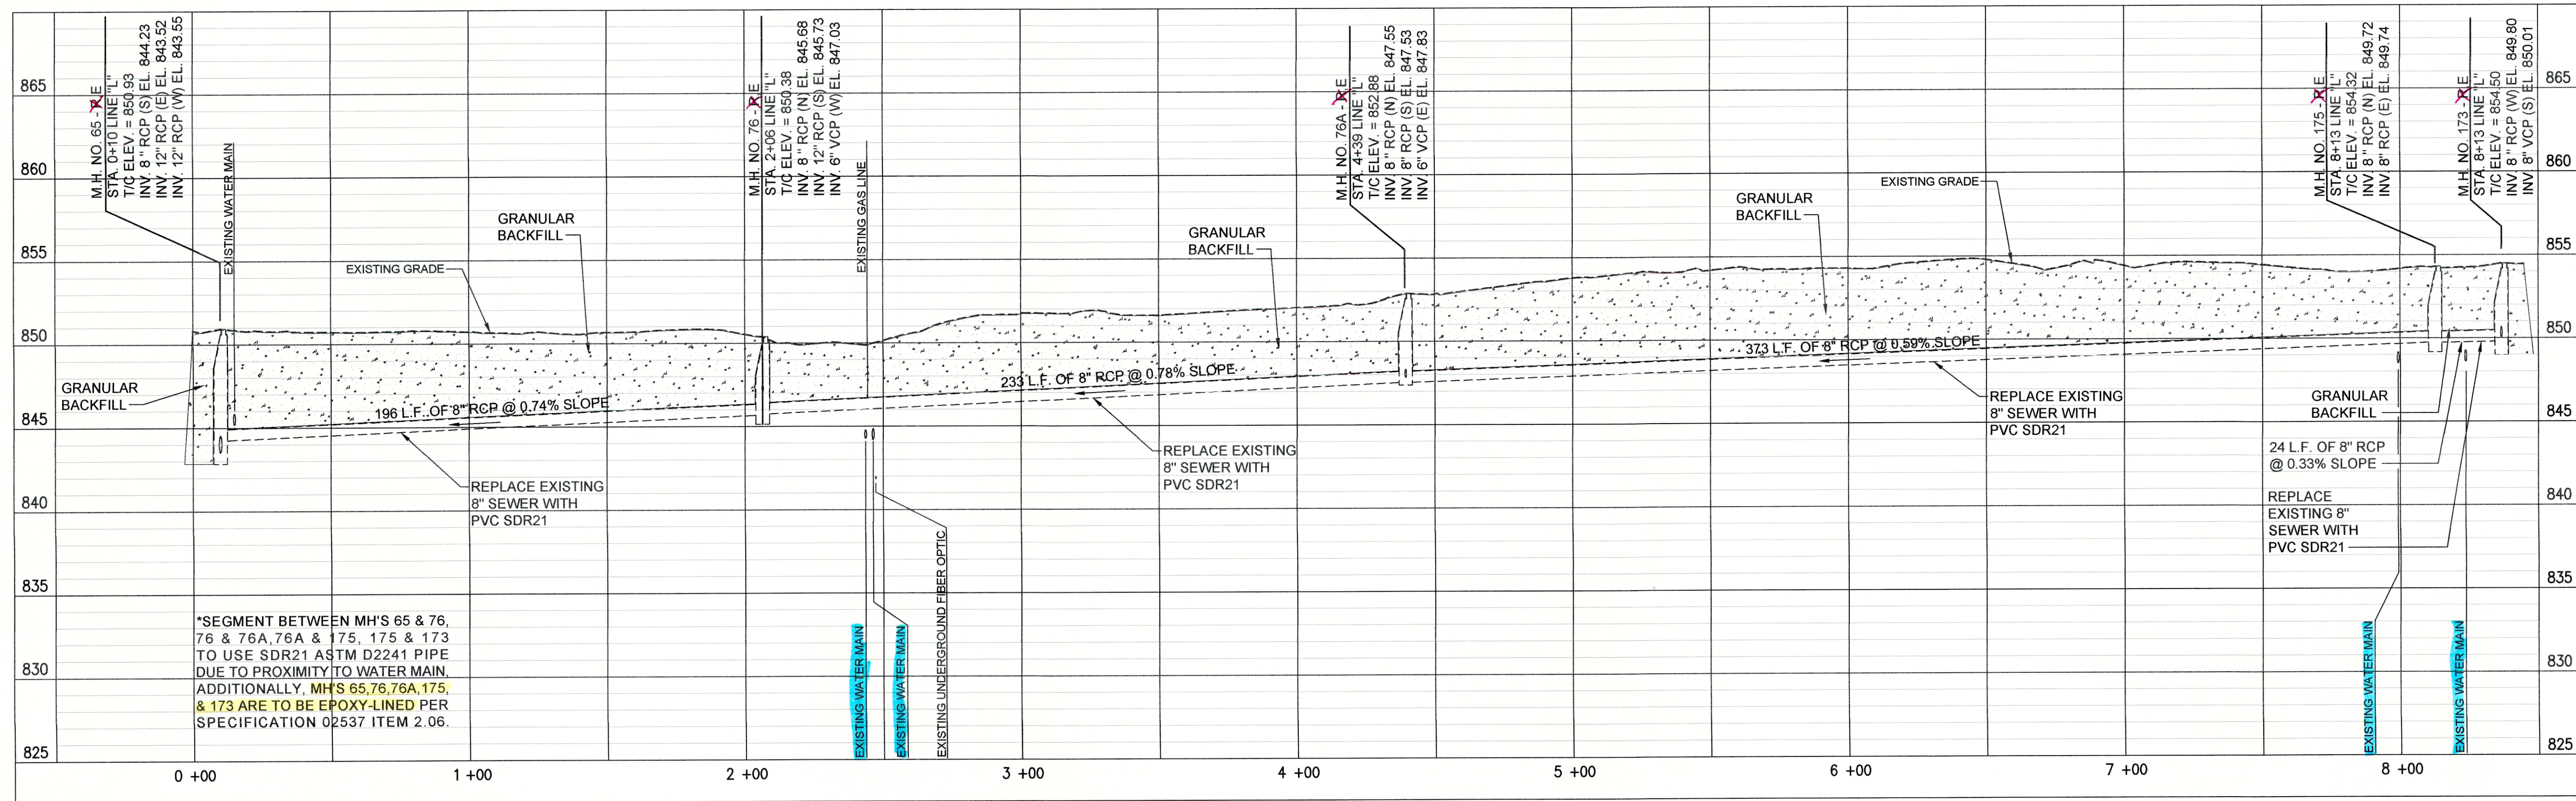


PROFILE - STA. 0+00 TO STA. 8+20 LINE "I"

(A) PIPE SEGMENT TO BE ABANDONED

- NOTES:
- LETTERS SHOWN NEXT TO MANHOLE NUMBERS IN THE PROFILE CORRESPOND TO REHABILITATION SCHEDULE ON SHEET C-42.
 - SEE SHEETS C-01 THROUGH C-15 FOR NOTES ON LATERAL REHABILITATION WORK.

PROPOSED LEGEND

- | | | | |
|--|-----------------------------|--|----------------------------------|
| | PROPOSED PERMANENT EASEMENT | | PROPOSED SANITARY LATERAL |
| | PROPOSED RIGHT-OF-WAY | | SURFACE RESTORATION AND BACKFILL |
| | PROPOSED SANITARY SEWER | | |

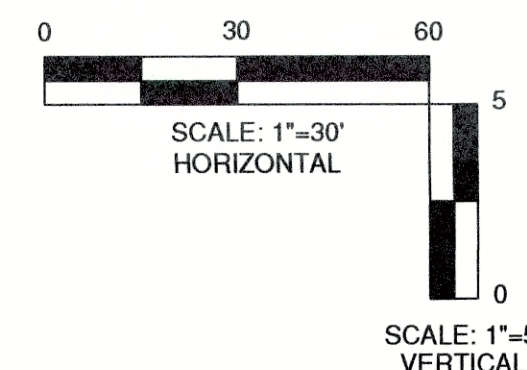

JOSEPH P. TIERNEY
REGISTERED
No. 19300407
STATE OF INDIANA
PROFESSIONAL ENGINEER

GR3
engineering | architecture | geospatial
www.gr3inc.com

GRW PROJECT NO. 4447-24

SRF NO. WW16074803 --

ALL RIGHTS RESERVED. NO PART OF THIS DOCUMENT SHALL BE REPRODUCED OR TRANSMITTED IN ANY FORM OR BY ANY MEANS, ELECTRONIC OR MECHANICAL, INCLUDING PHOTOCOPYING, RECORDING, OR BY ANY INFORMATION STORAGE AND RETRIEVAL SYSTEM, WITHOUT THE WRITTEN PERMISSION OF GR3 INC.

PLAN AND PROFILE

LINE "I"

SEWER REHABILITATION PROJECT PHASE II

TOWN OF PENDELTON, INDIANA

REVISIONS		DESIGNED	DRAWN	REVIEWED	APPROVED
NO.	DESCRIPTION	DATE	BY	DATE	BY

DATE: MARCH 2017

SCALE: H.-1"=30', V.-1"=5'

SHEET NO.

C-24