


PRINTED: 3/14/2017 @ 1:00PM

FILE NAME: G:\4447-FCR\WD-2015\Working Drawings\AutoCAD\REHABILITATION PHASE II\4447-24-C-25.dwg


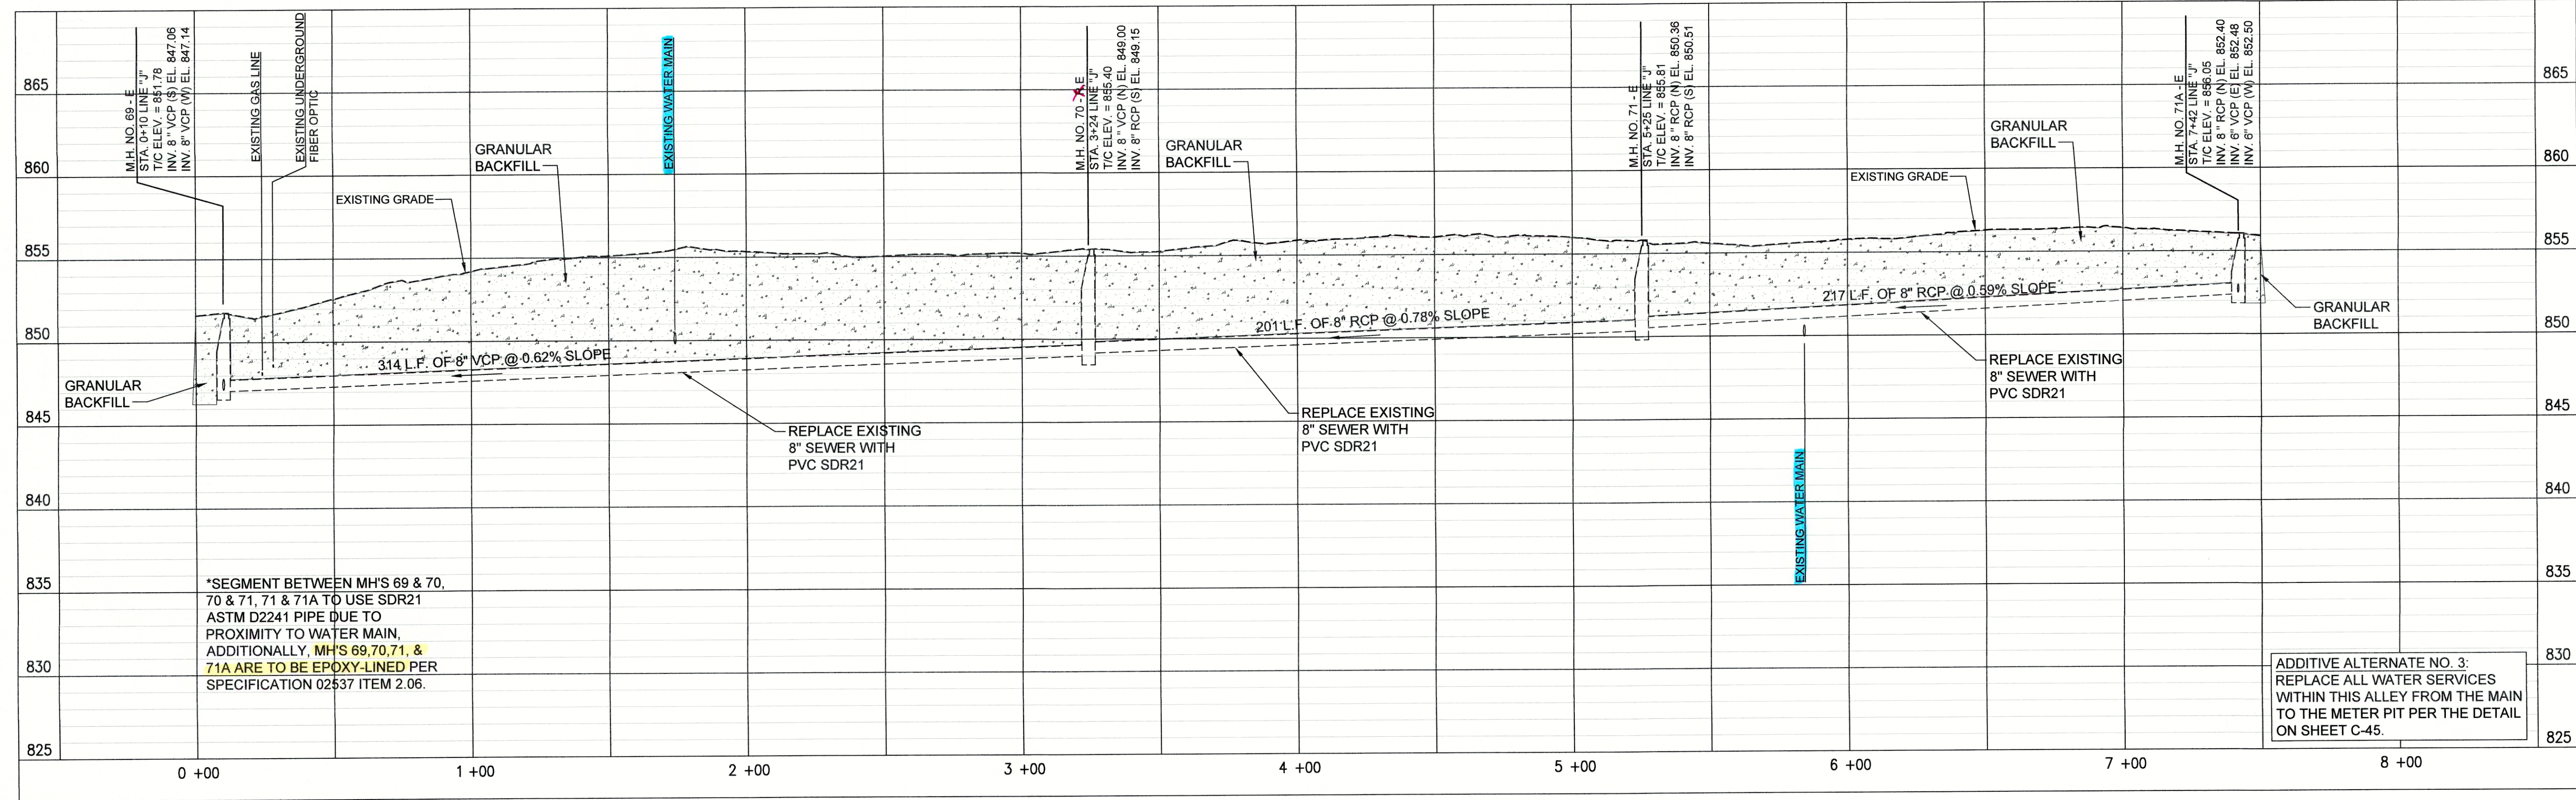


PROFILE - STA. 0+00 TO STA. 7+50 LINE "J"

PROPOSED LEGEND

- PROPOSED PERMANENT EASEMENT
- PROPOSED RIGHT-OF-WAY
- PROPOSED SANITARY SEWER
- PROPOSED SANITARY LATERAL
- SURFACE RESTORATION AND BACKFILL

- NOTES:
- LETTERS SHOWN NEXT TO MANHOLE NUMBERS IN THE PROFILE CORRESPOND TO REHABILITATION SCHEDULE ON SHEET C-42.
 - SEE SHEETS C-01 THROUGH C-15 FOR NOTES ON LATERAL REHABILITATION WORK.

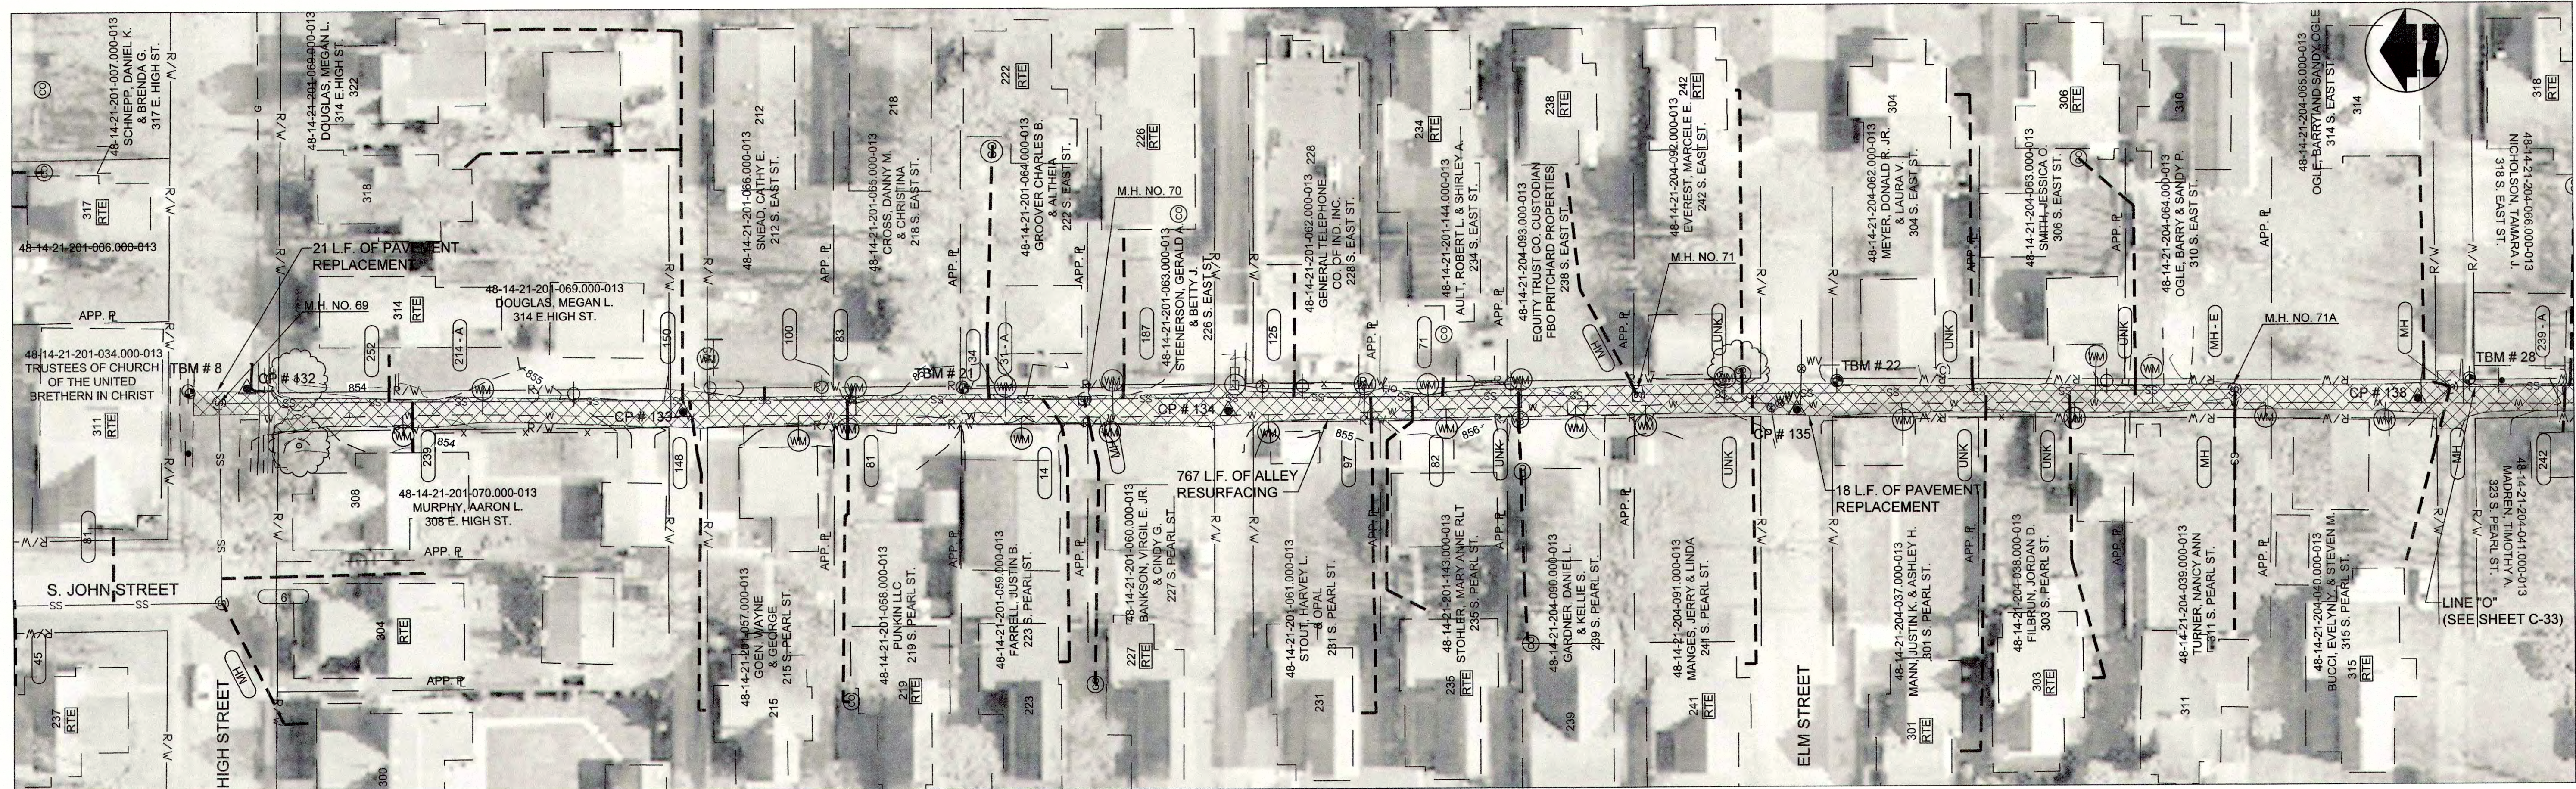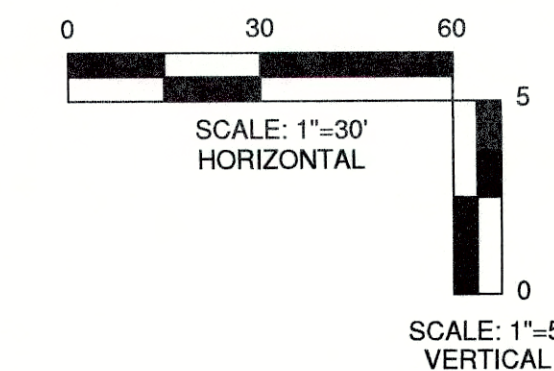

PLAN VIEW - STA. 0+00 TO STA. 7+50 LINE "J" CIPP LINED PER BID ALTERNATE

JOSEPH P. TIERNEY
REGISTERED
No. 19300407
STATE OF INDIANA
PROFESSIONAL ENGINEER

GRW PROJECT NO. 4447-24
SRF NO. WW16074803

engineering | architecture | geospatial
www.gwinc.com

PLAN AND PROFILE
LINE "J"
SEWER REHABILITATION PROJECT PHASE II
TOWN OF PENDELTON, INDIANA

DESIGNER	BY	DATE
GWL	---	---
GCR	---	---
GWL	---	---
JPT	---	---

REVISIONS
NO. DESCRIPTION
1. THIS MARK SHOULD MEASURE EXACTLY WHEN PLOTTED

DATE: MARCH 2017
SCALE: H.-1"=30', V.-1"=5'
SHEET NO.

C-25