



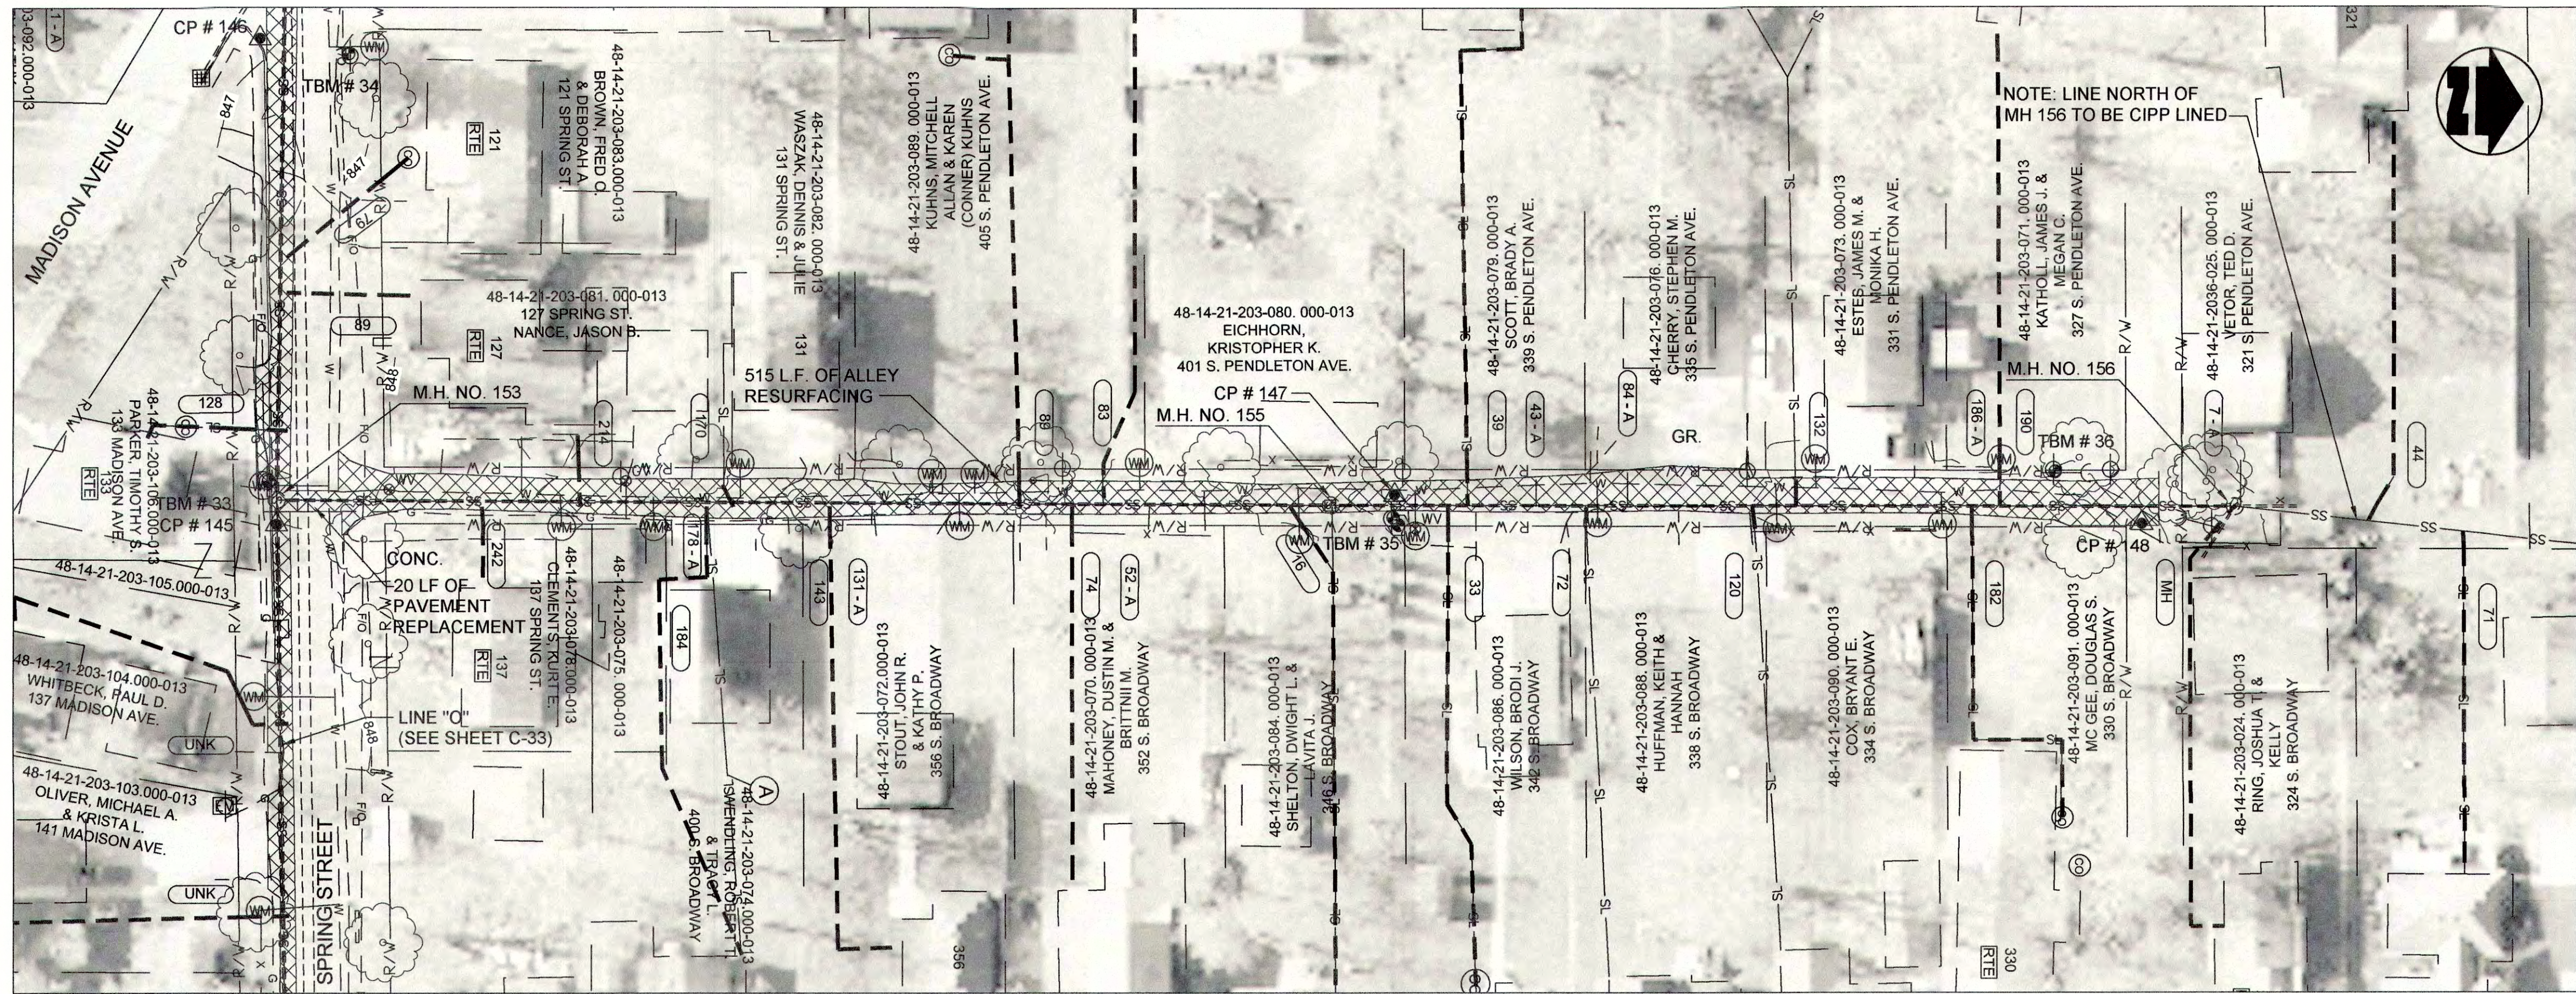

PLAN VIEW - STA. 0+00 TO STA. 5+75 LINE "O1" CIPP LINED PER BID ALTERNATE

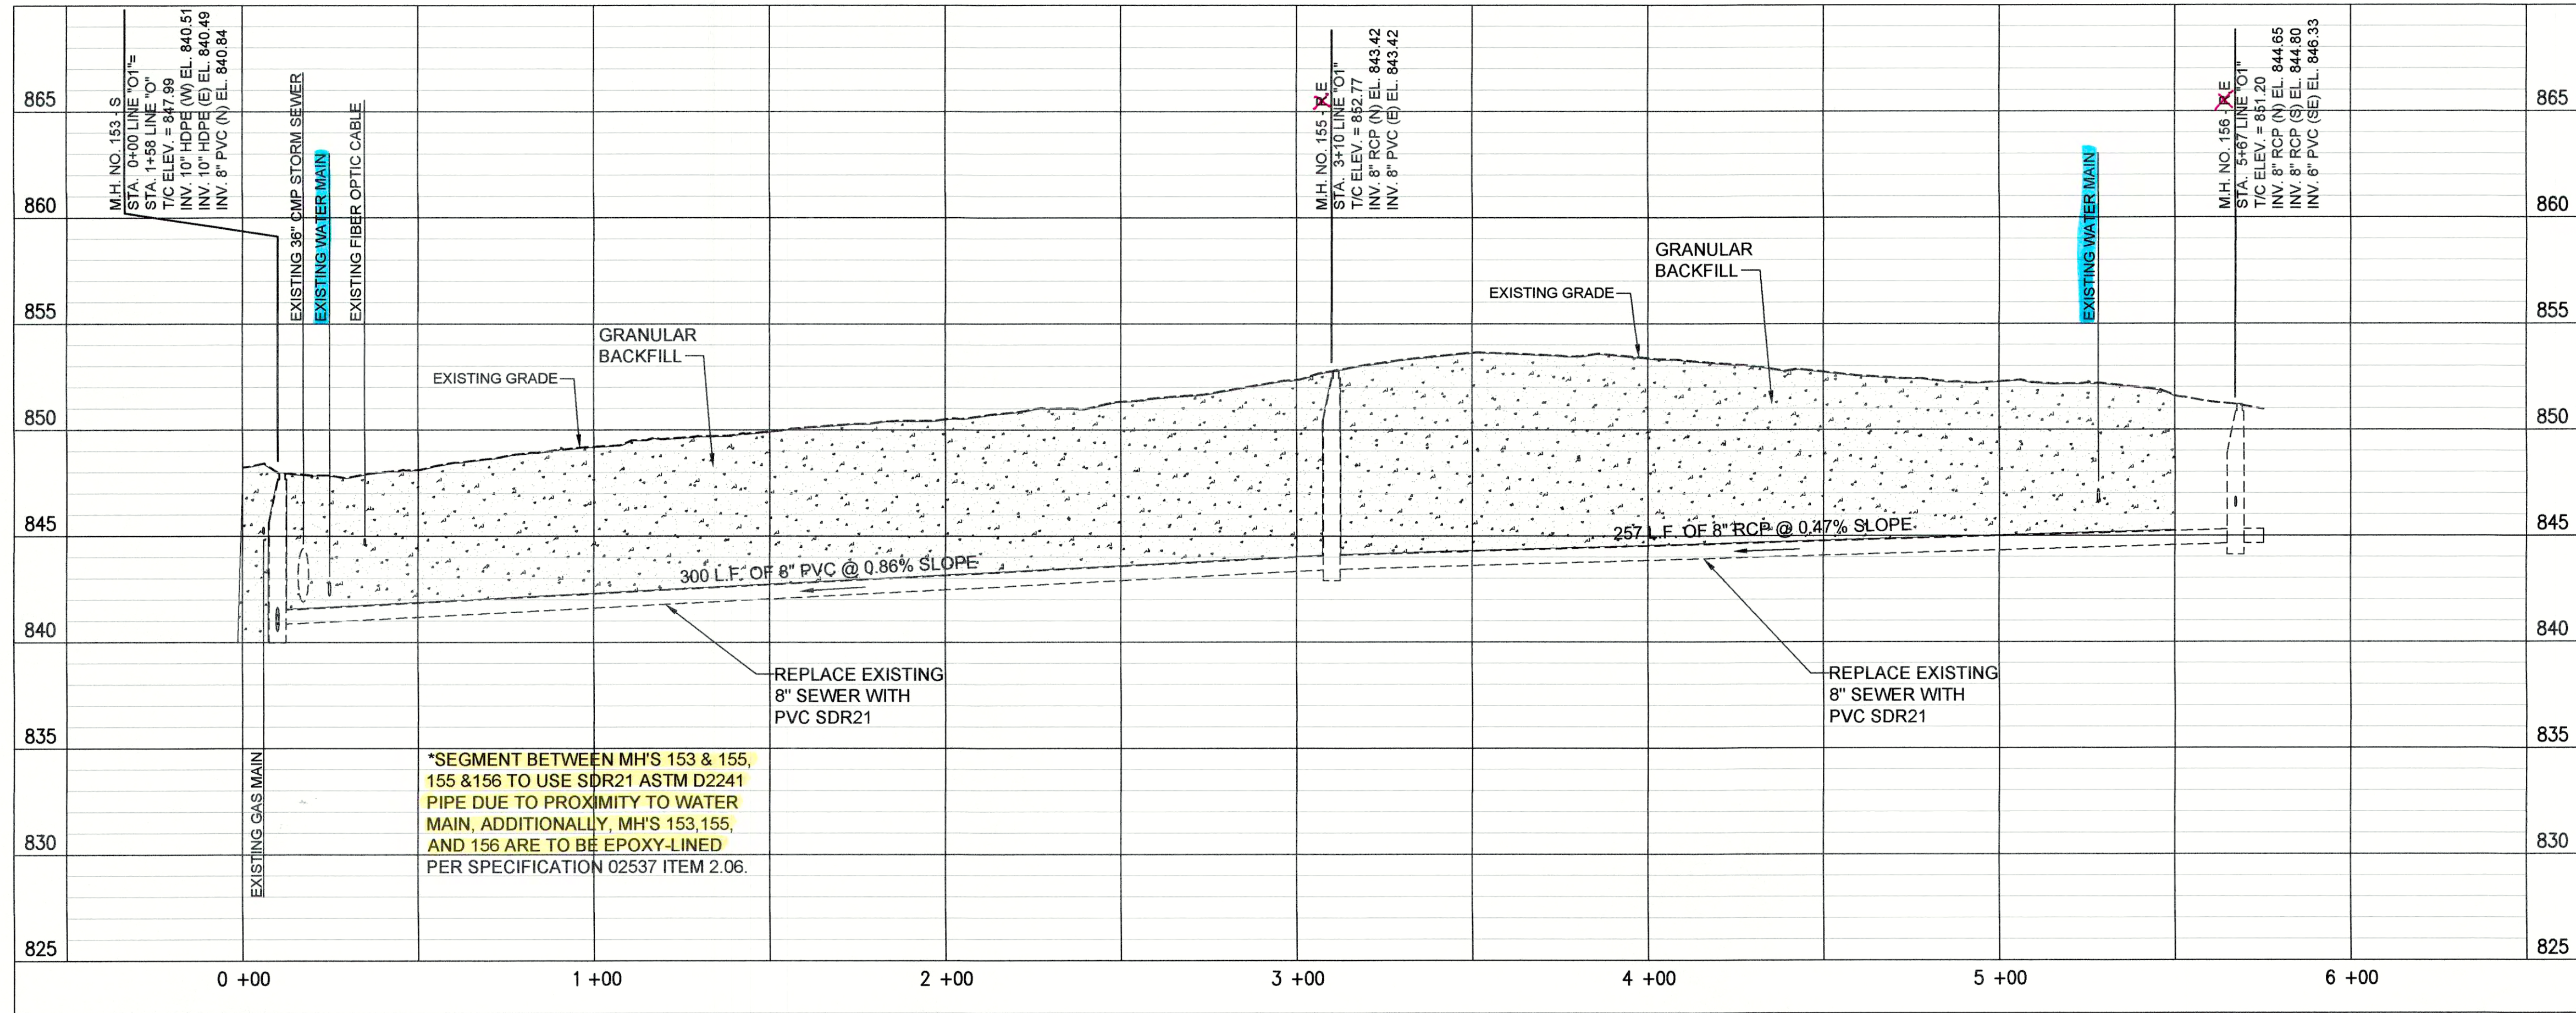


PROFILE - STA. 0+00 TO STA. 5+75 LINE "O1"

PROPOSED LEGEND

- PROPOSED PERMANENT EASEMENT
- PROPOSED RIGHT-OF-WAY
- PROPOSED SANITARY SEWER
- PROPOSED SANITARY LATERAL
- SURFACE RESTORATION AND BACKFILL

(A) PIPE SEGMENT TO BE ABANDONED

- NOTES:
- LETTERS SHOWN NEXT TO MANHOLE NUMBERS IN THE PROFILE CORRESPOND TO REHABILITATION SCHEDULE ON SHEET C-42.
 - SEE SHEETS C-01 THROUGH C-15 FOR NOTES ON LATERAL REHABILITATION WORK.

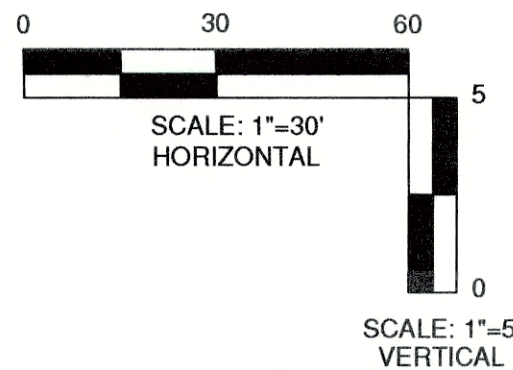

JOSEPH P. TIERNEY
REGISTERED
No. 19300407
STATE OF INDIANA
Professional Engineer

GRW PROJECT NO. 4447-24
SRF NO. WW18074803 --

engineering | architecture | geospatial
www.gwinc.com

PLAN AND PROFILE
LINE "O1"
SEWER REHABILITATION PROJECT PHASE II
TOWN OF PENDLETON, INDIANA

DESIGNED	BY	DATE	DESCRIPTION

GWL	GCR	GWL	JPT

DATE: MARCH 2017
SCALE: H.-1"=30', V.-1"=5'
SHEET NO. C-35

THIS MARK SHOULD MEASURE EXACTLY WHEN NOTED
SCALE CHECK