


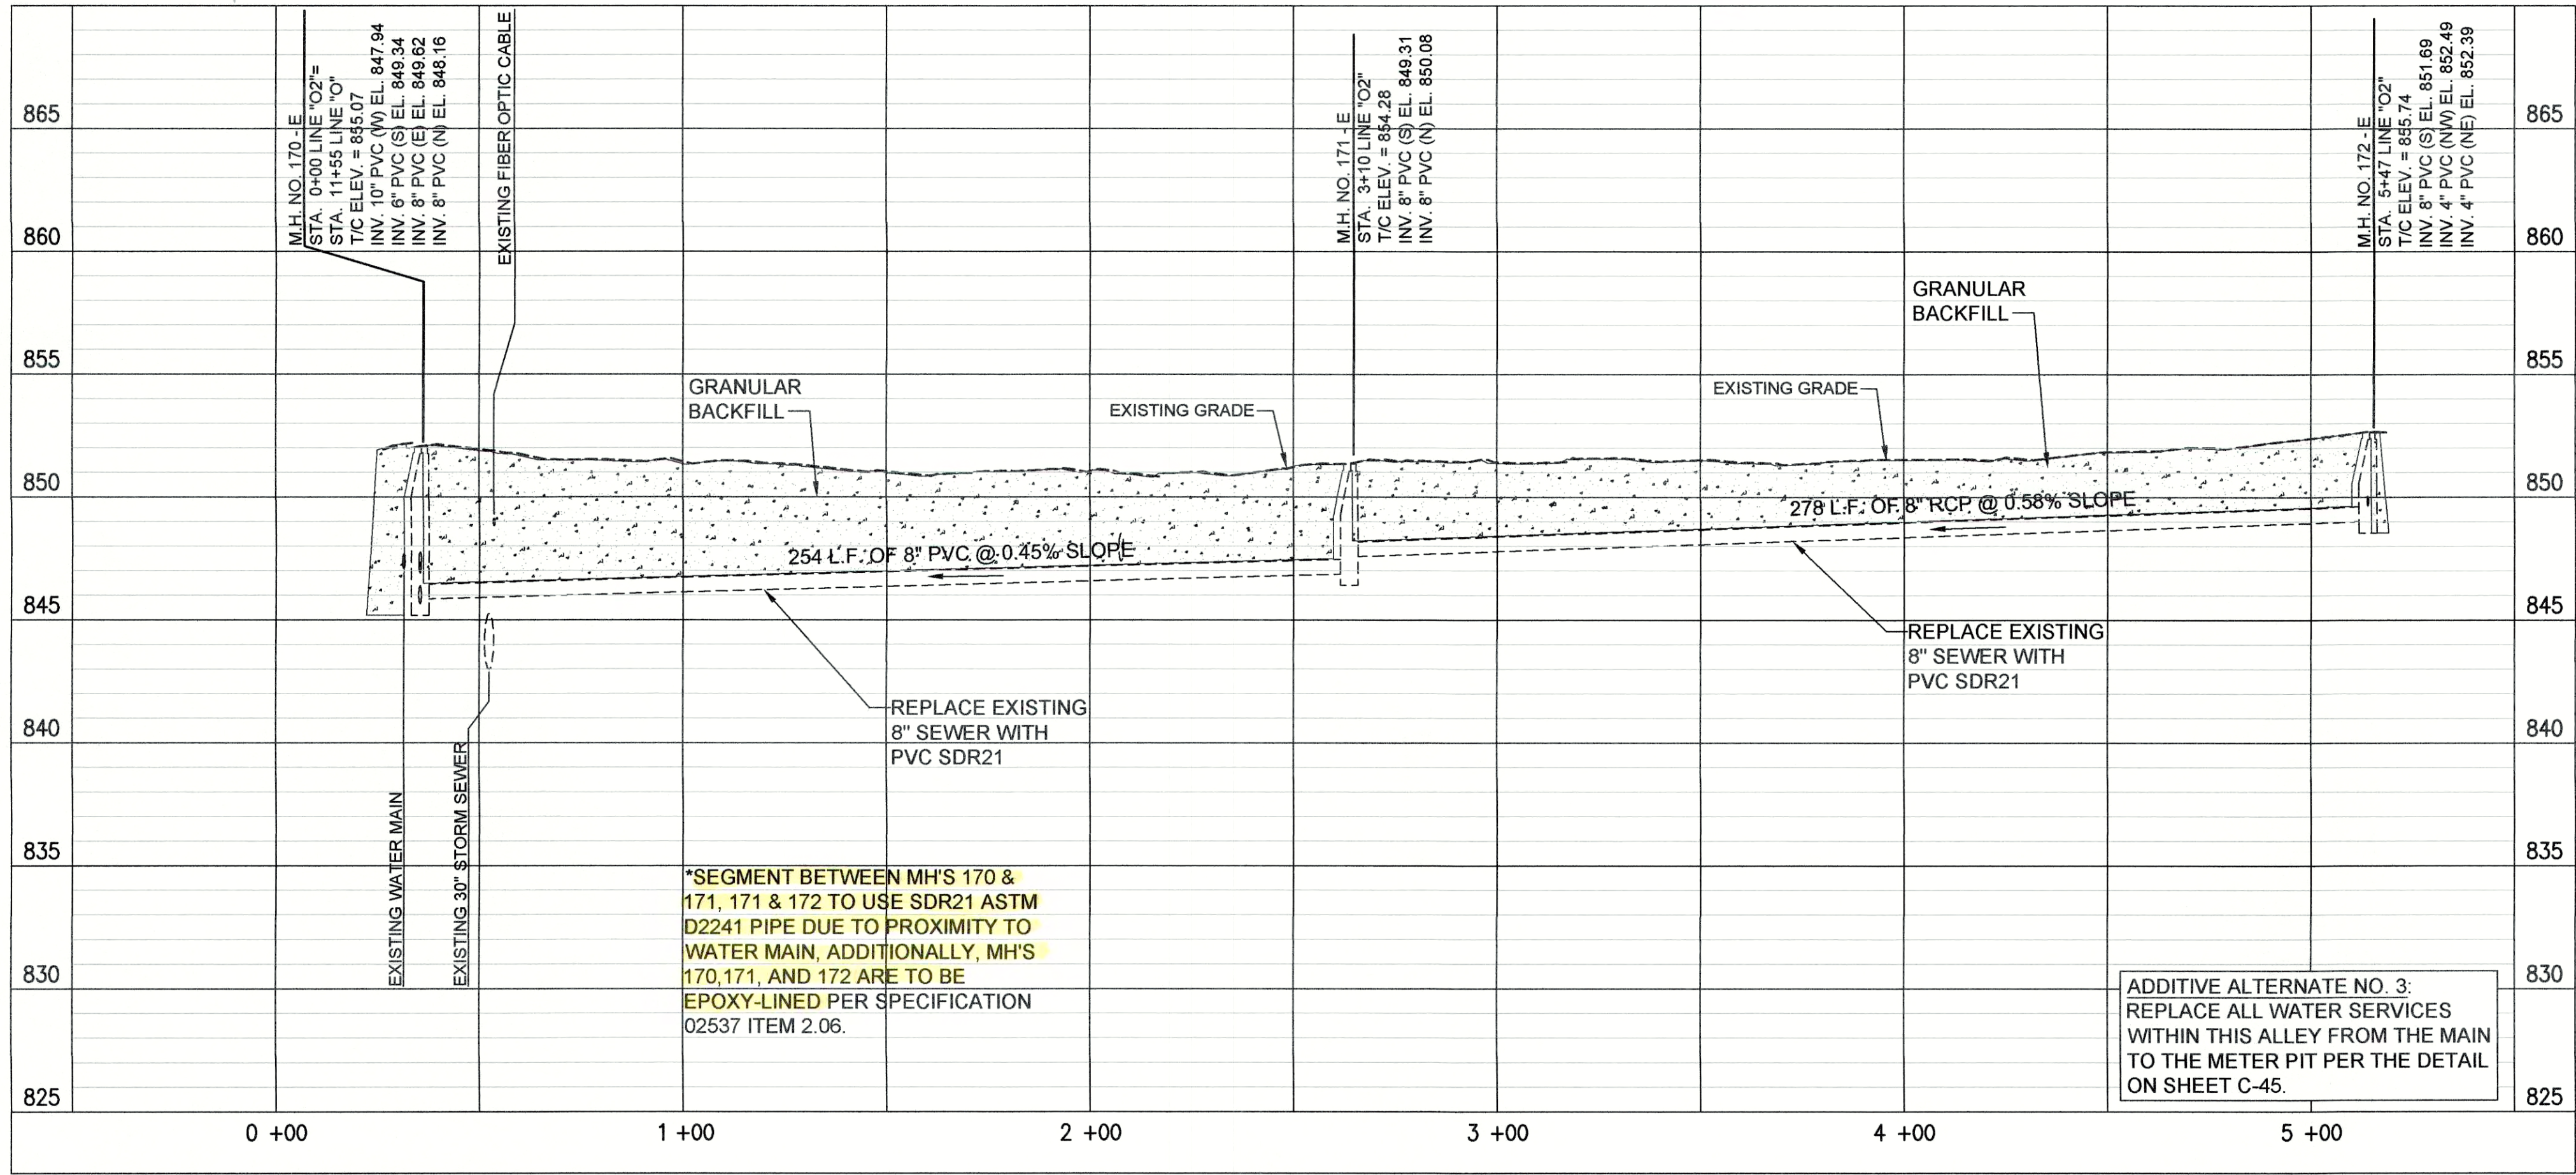


PROFILE - STA. 0+00 TO STA. 5+50 LINE "O2"

PROPOSED LEGEND


- | | | | |
|---|-----------------------------|---|----------------------------------|
| — | PROPOSED PERMANENT EASEMENT | — | PROPOSED SANITARY LATERAL |
| — | PROPOSED RIGHT-OF-WAY | — | SURFACE RESTORATION AND BACKFILL |
| — | PROPOSED SANITARY SEWER | | |

(A) PIPE SEGMENT TO BE ABANDONED


- NOTES:
- LETTERS SHOWN NEXT TO MANHOLE NUMBERS IN THE PROFILE CORRESPOND TO REHABILITATION SCHEDULE ON SHEET C-42.
 - SEE SHEETS C-01 THROUGH C-15 FOR NOTES ON LATERAL REHABILITATION WORK.

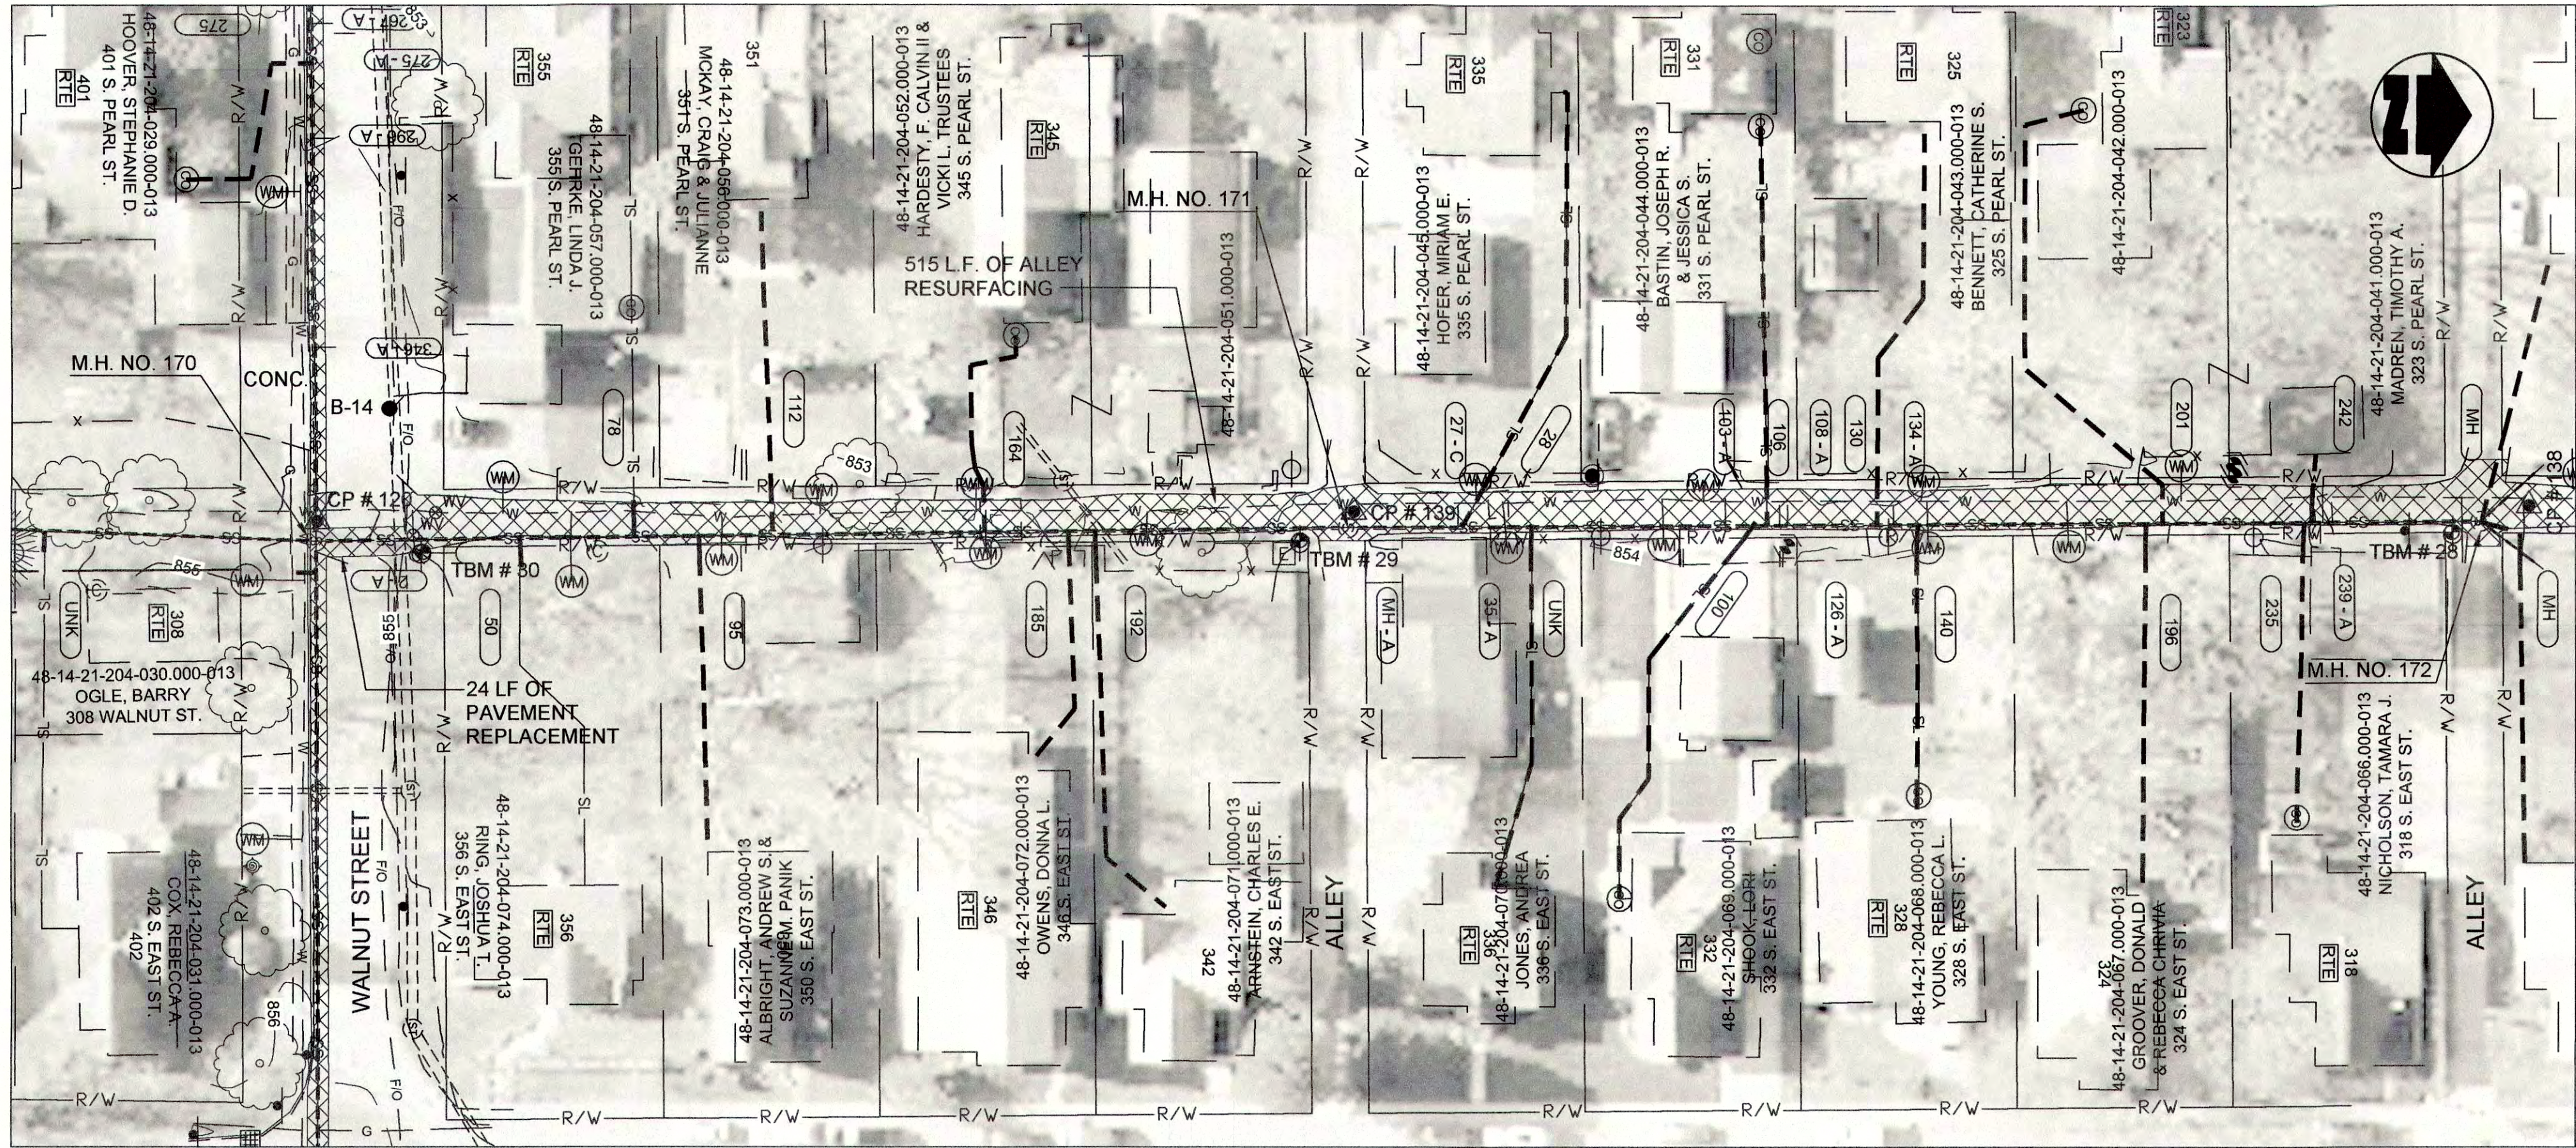


PLAN VIEW - STA. 0+00 TO STA. 5+50 LINE "O2" CIPP LINED PER BID ALTERNATE

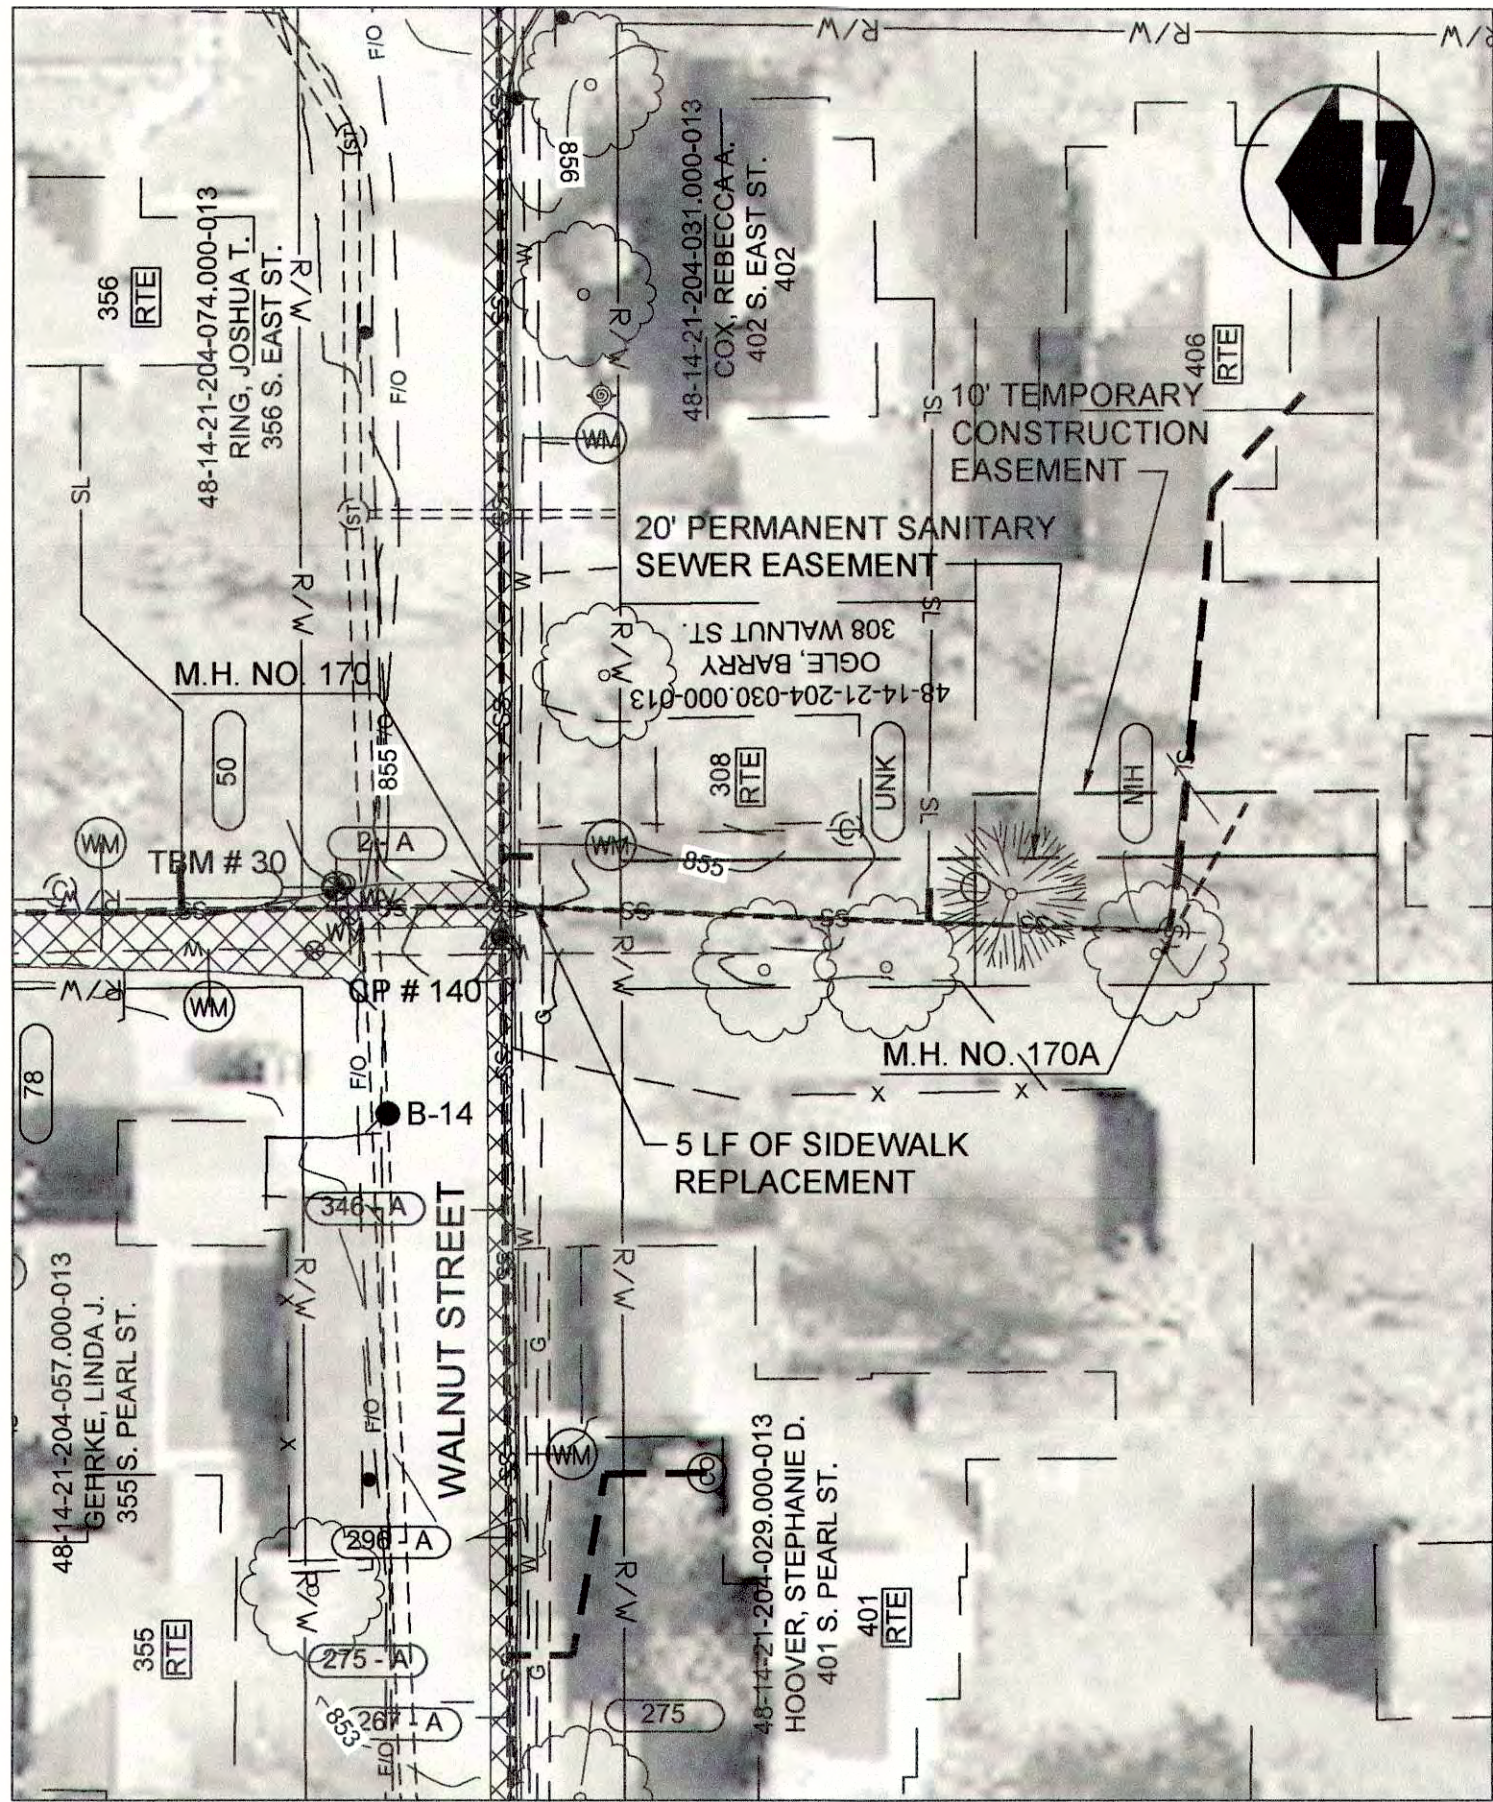

PLAN VIEW - STA. 0+00 TO STA. 1+20 LINE "O3" CIPP LINED PER BID ALTERNATE

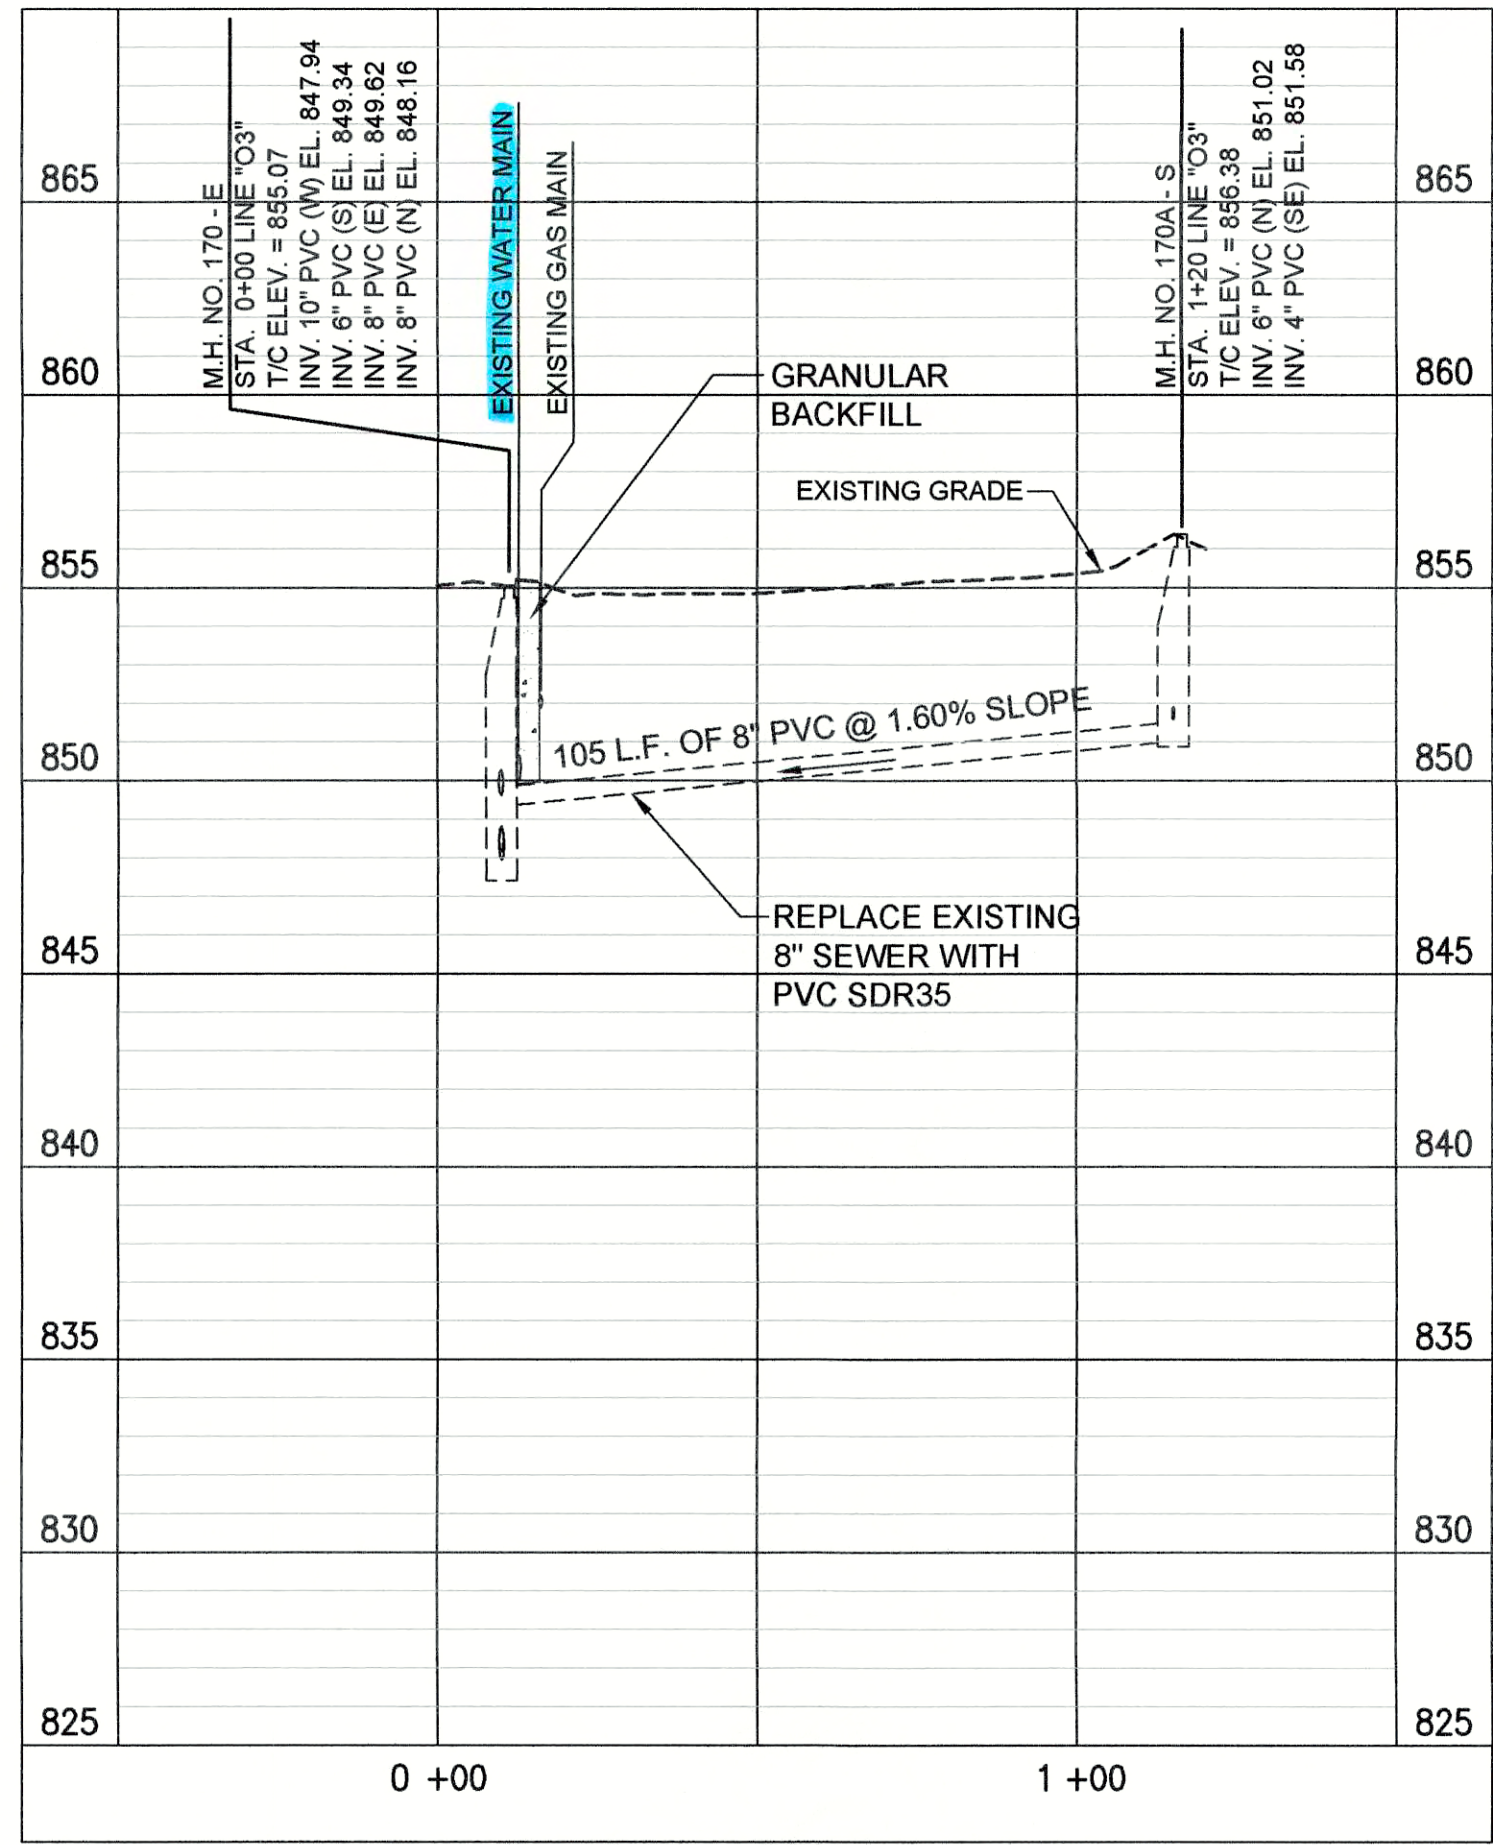

PROFILE - STA. 0+00 TO STA. 1+20 LINE "O3"

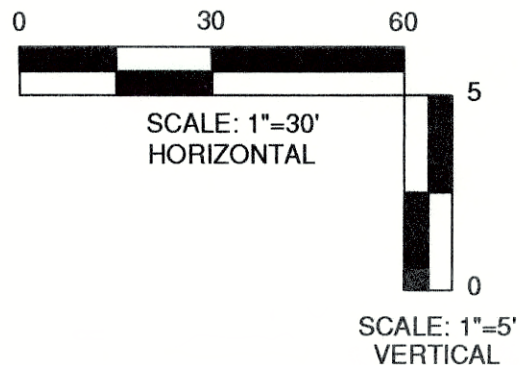

JOSEPH P. TIENEY
REGISTERED
No. 19300407
STATE OF INDIANA
PROFESSIONAL ENGINEER

GRW PROJECT NO. 4447-24
SRF NO. WW6074803

engineering | architecture | geospatial
www.gwinc.com

PLAN AND PROFILE
LINE "O2" AND LINE "O3"
SEWER REHABILITATION PROJECT PHASE II
TOWN OF PENDLETON, INDIANA

DESIGNED	BY	DATE	DESCRIPTION

GWL	GCR	GWL	JPT

NO.	DATE	DESCRIPTION

SCALE CHECK: THIS MARK SHOULD MEASURE EXACTLY 1" WHEN PLOTTED

DATE: MARCH 2017
SCALE: H.-1"=30', V.-1"=5'
SHEET NO. C-36